



BM 155.90 "a" cut top East curb of Westfield 10' South of S.L. Wood Drive
 BM 172.48 City Std. at Tyler & 17th St. North 36' East of 31' South of
 NE corner SE 1/4 Sec. 8-27-1W.

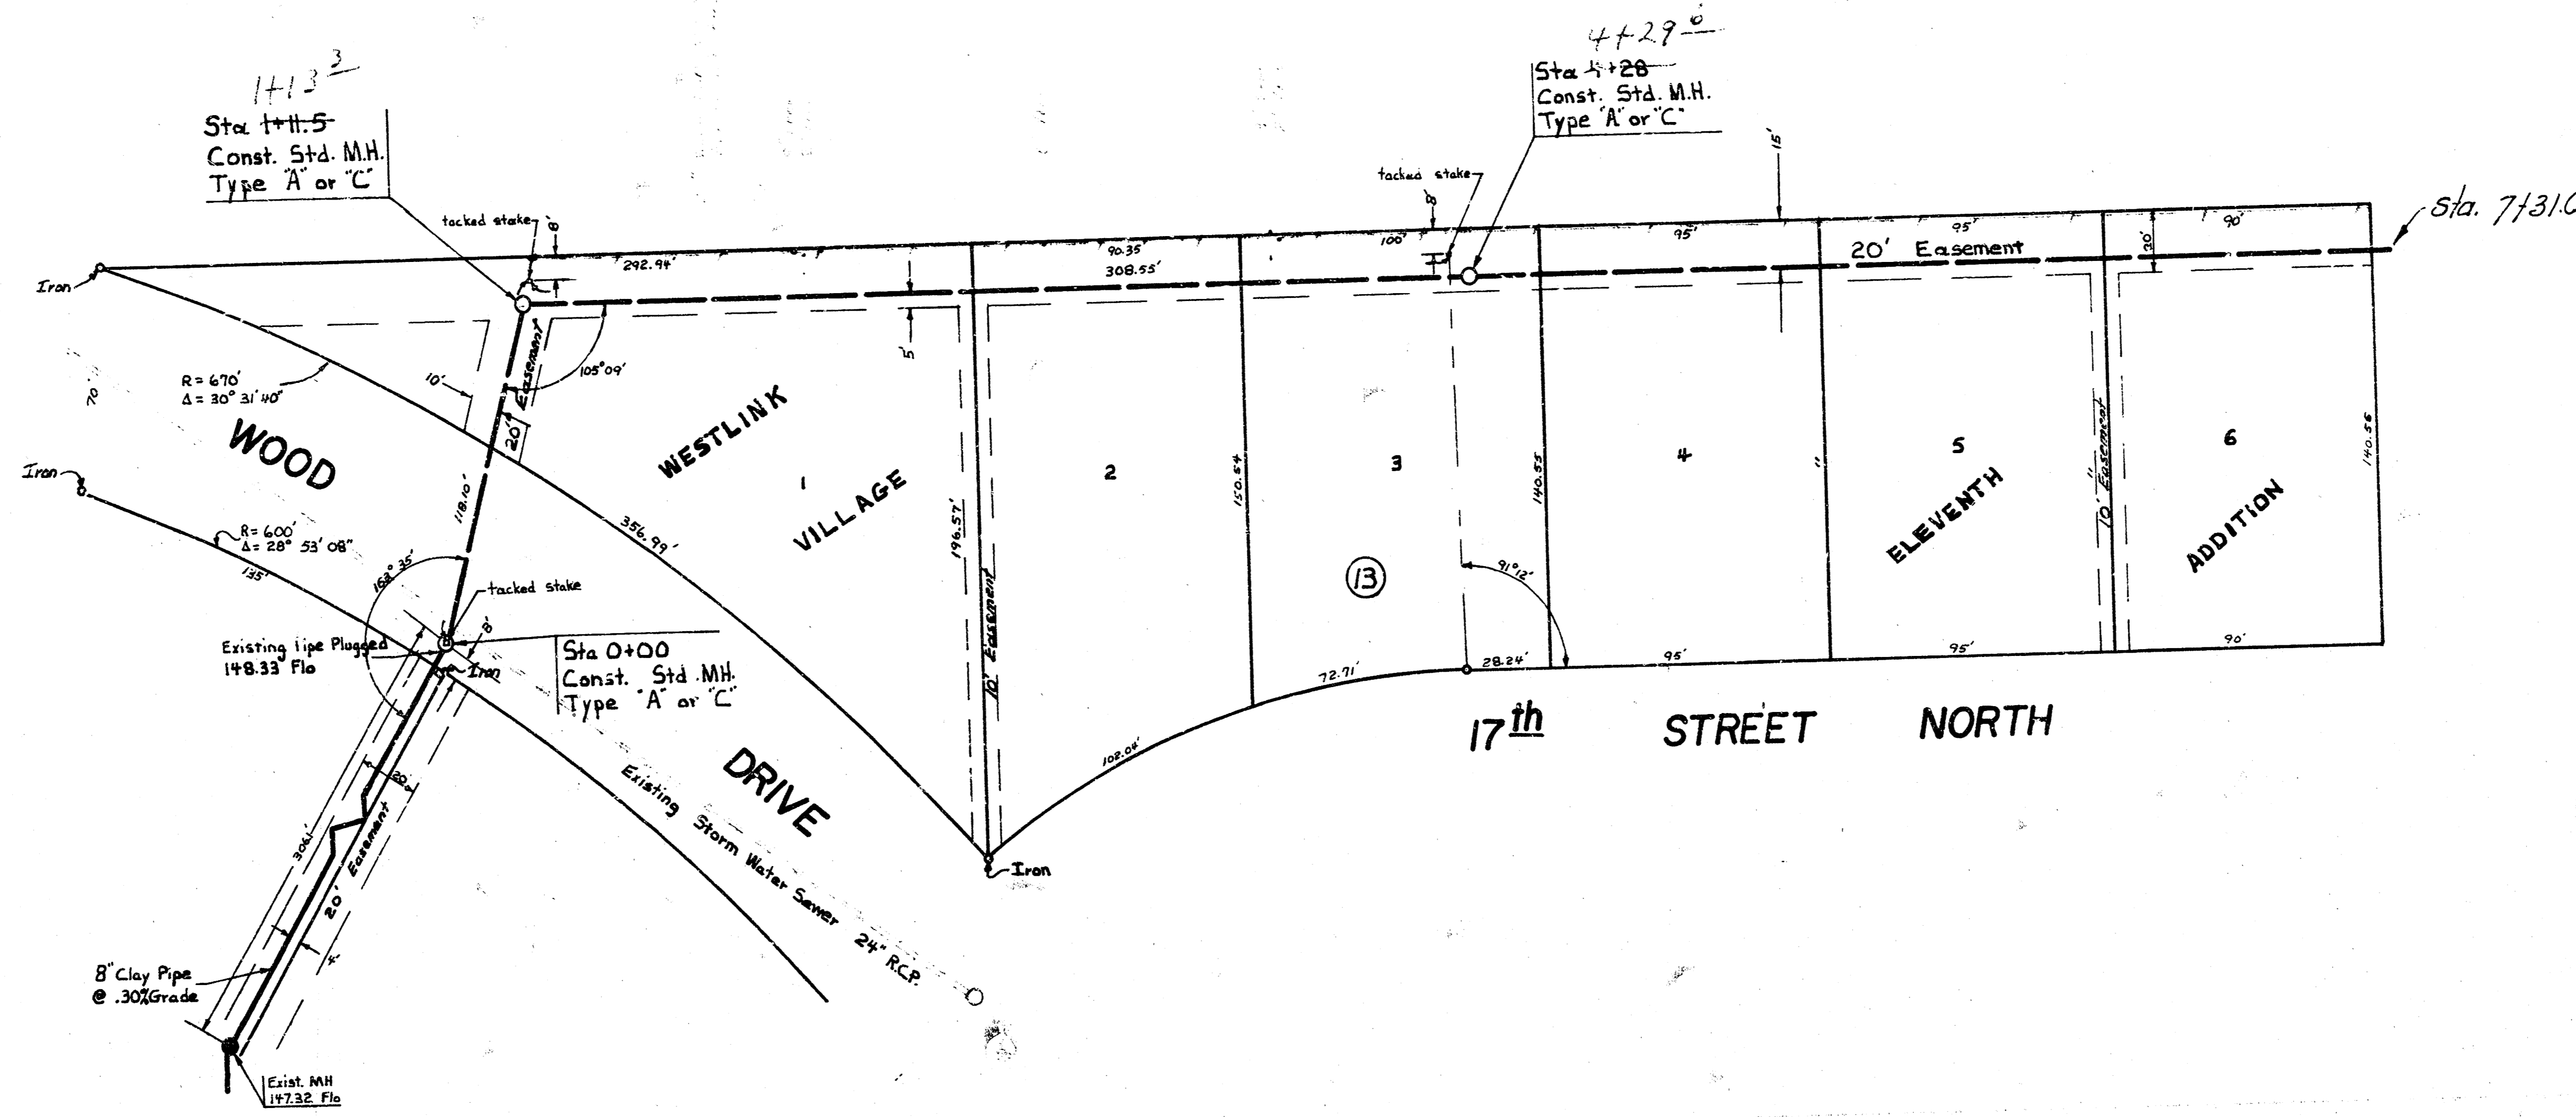


Plan Scale 1" = 40'
 Profile Scale 1" = 40' Horz.
 1" = 5' Vert.

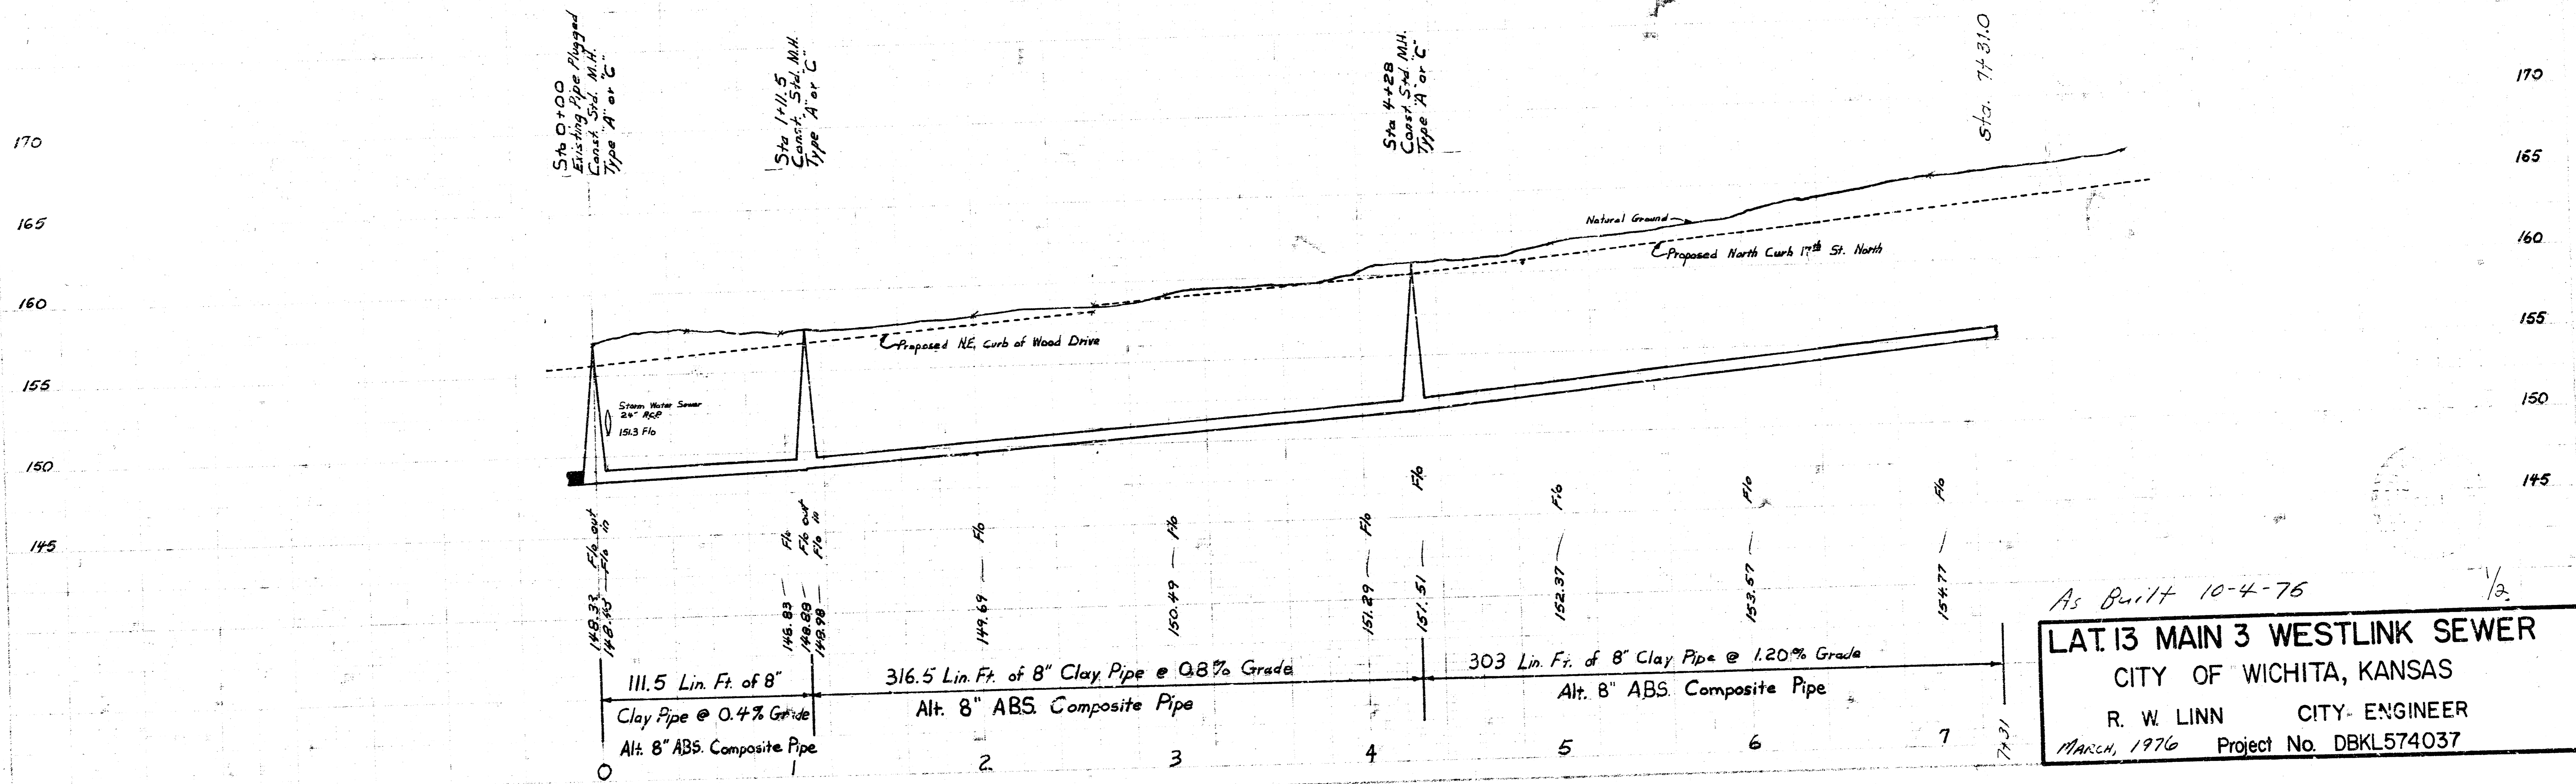


As Built 10-4-76
LAT. 13 MAIN 3 WESTLINK SEWER
 CITY OF WICHITA, KANSAS
 R. W. LINN CITY ENGINEER
 MARCH, 1976 Project No. DBKL574037

BM 155.90 "a" cut top East curb of Westfield 10' South of S.L. Wood Drive

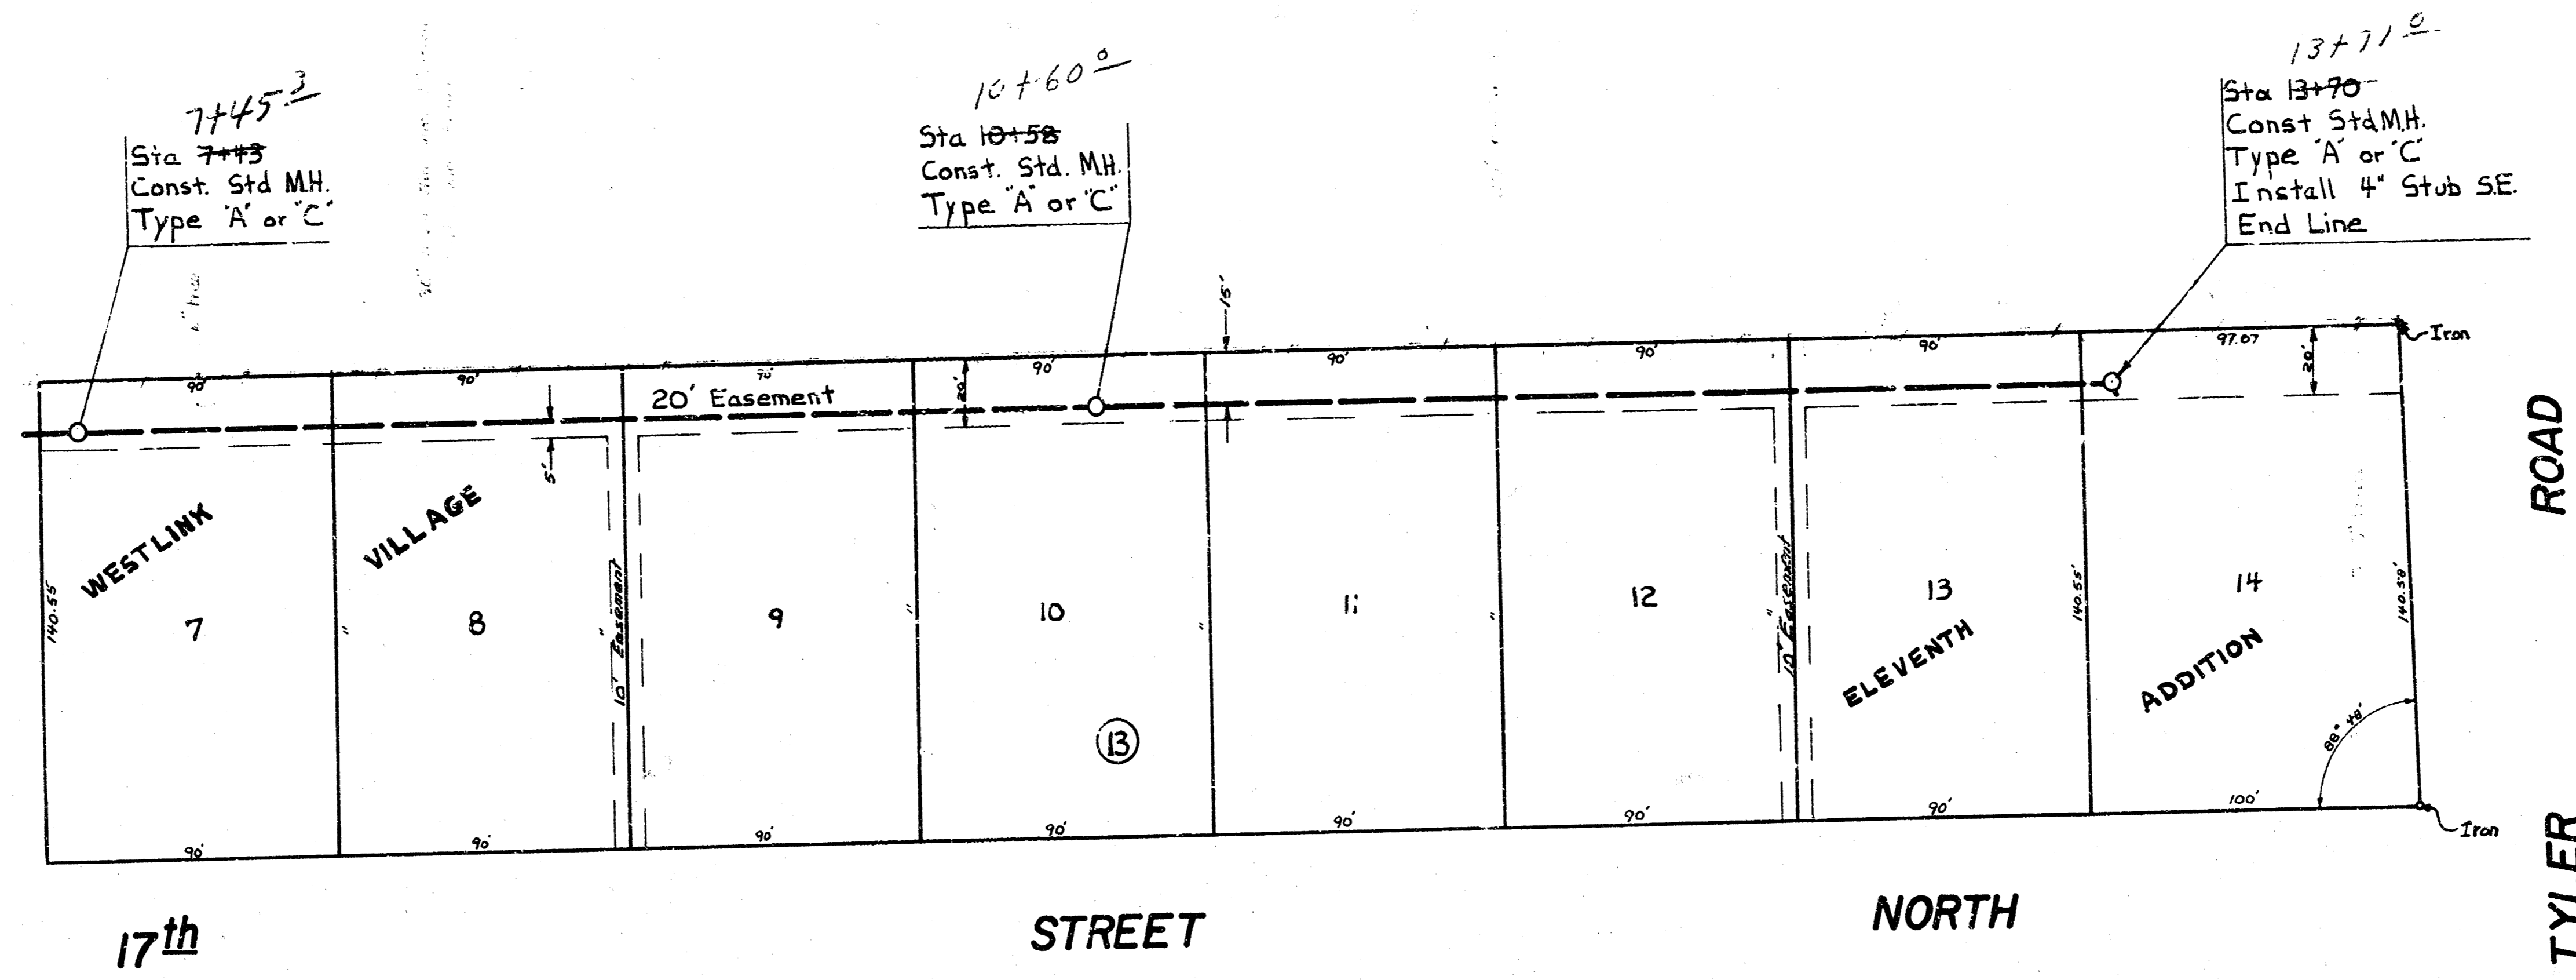

Plan Scale 1" = 40'
 Profile Scale 1" = 40' Horz.
 1" = 5' Vert.

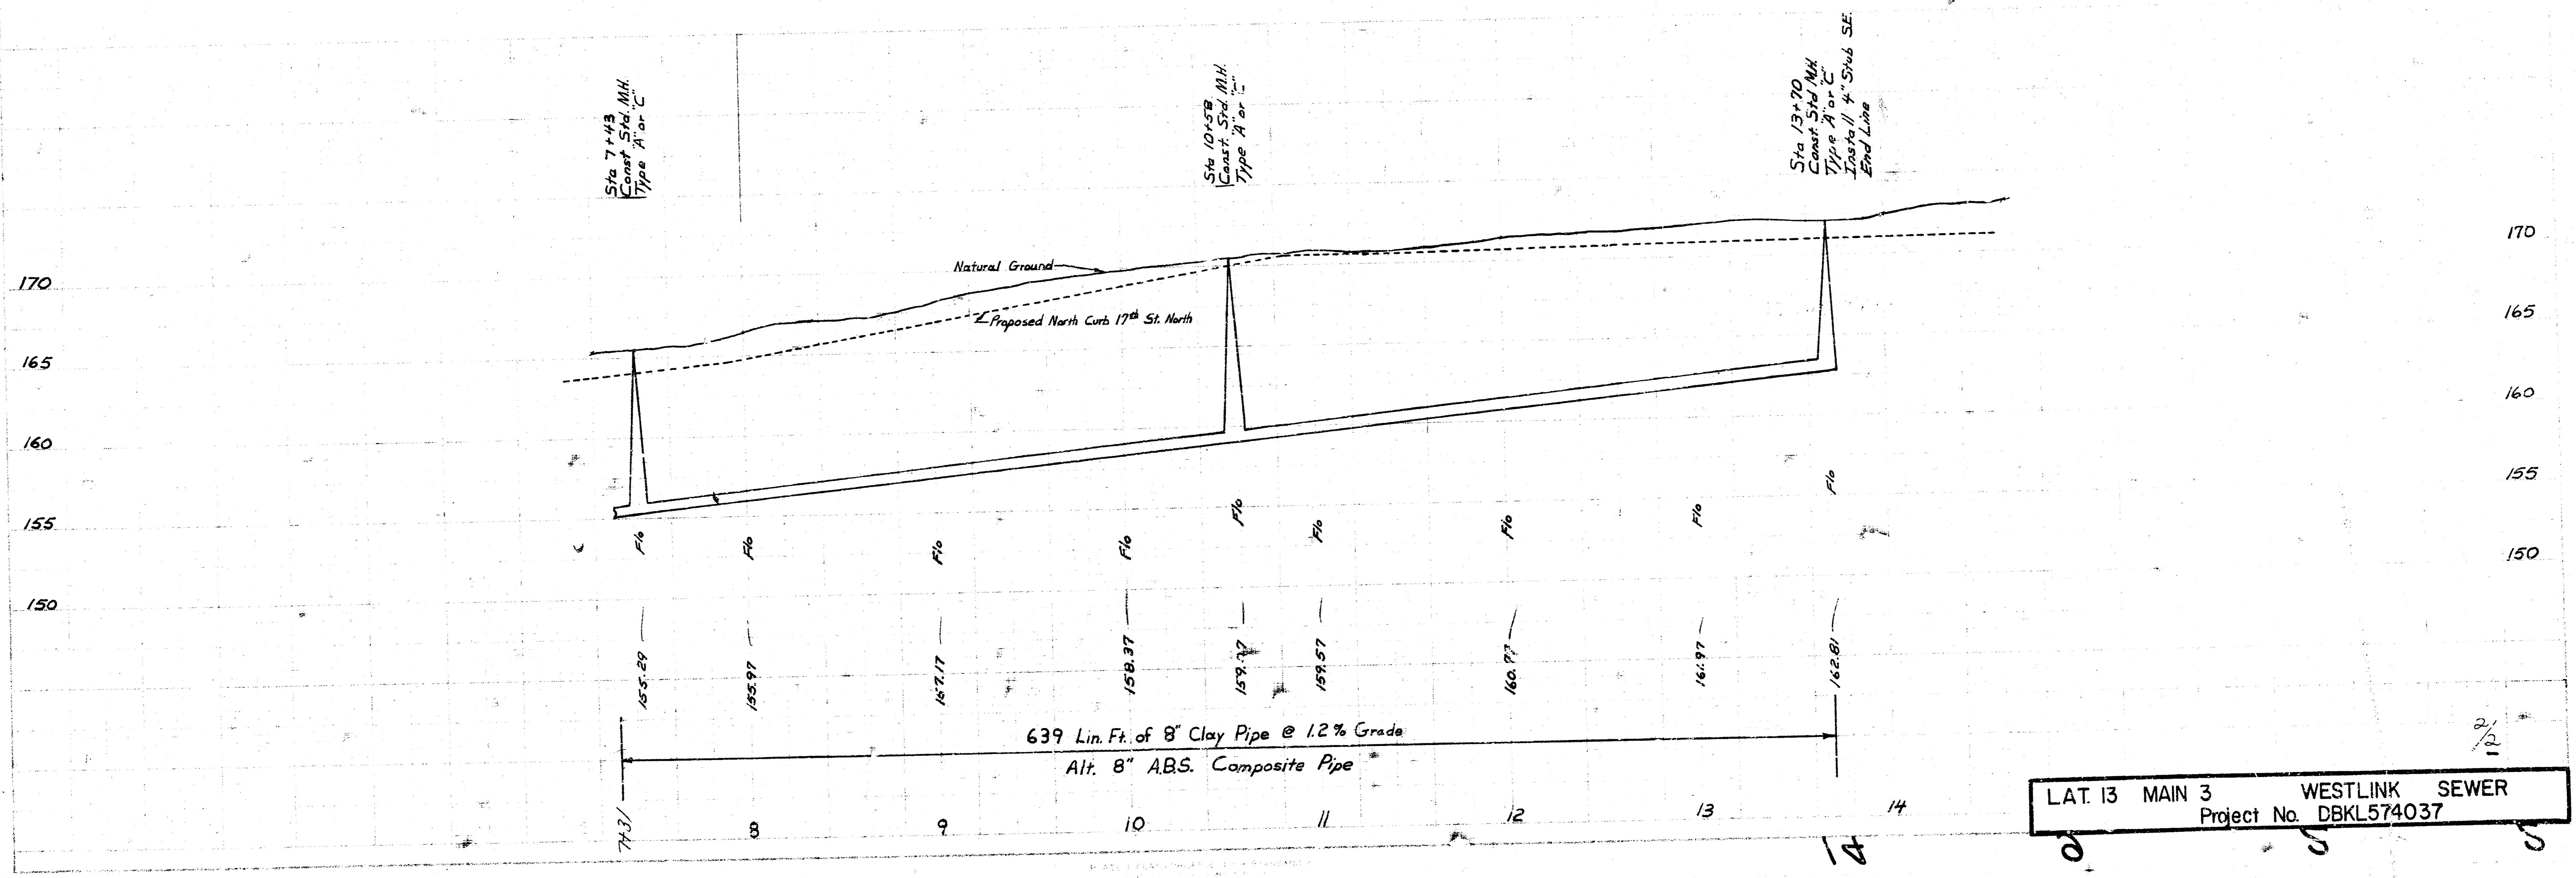

LAT 13 MAIN 3 WESTLINK SEWER
 Project No. DBKL574037