



MAIN 4, WESTLINK SEWER


CITY OF WICHITA


R.W. BRUGGEMAN - DIRECTOR OF ENGINEERING /
CITY ENGINEER

PROJECT NO. 468-76-245-80982-000-000-001

LINE #1 SHEETS 2-4

As Built
8/8
8/9/81

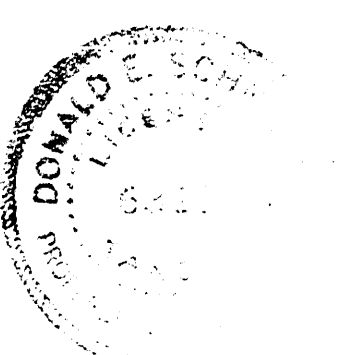

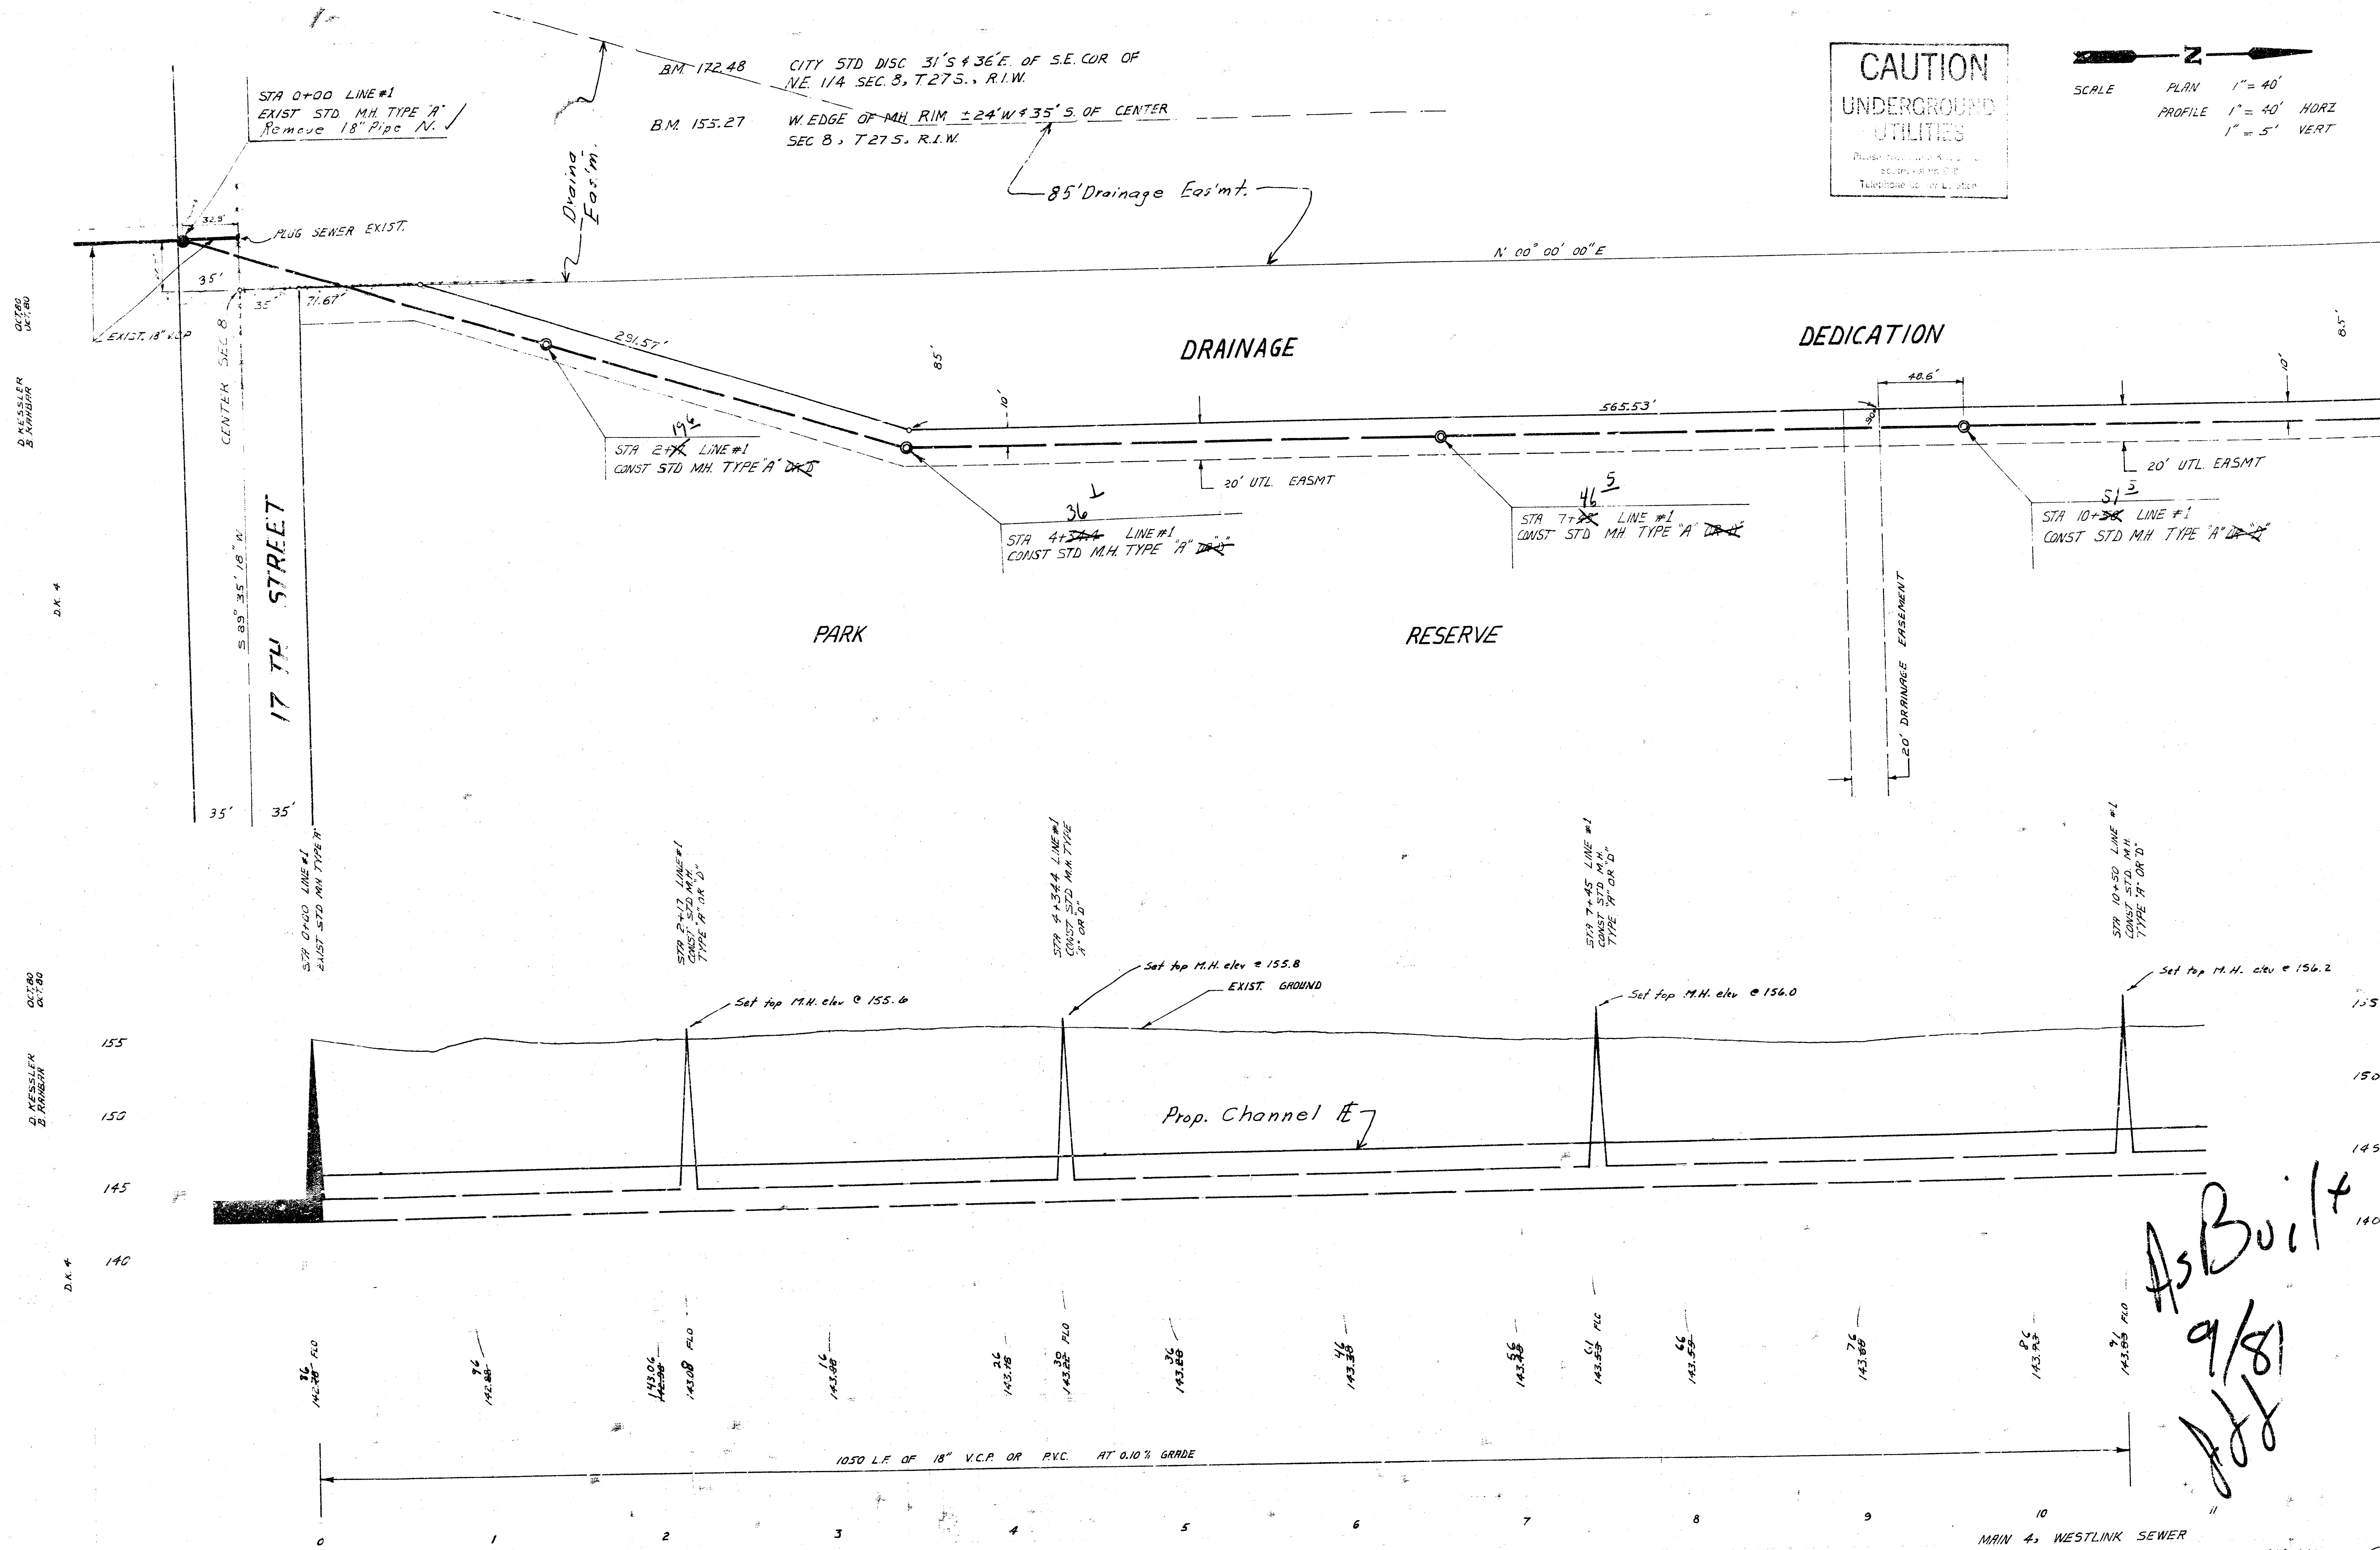

CAUTION
UNDERGROUND
UTILITIES

Push Down and Pull Up
to Discover Location
Telephone 661-4411

SCALE PLAN 1" = 40'
PROFILE 1" = 40' HORIZ
1" = 5' VERT

As Built
9/81
JH

MAIN 4, WESTLINK SEWER
PROJECT NO 468-76-245-80382-000.000.001

FILMED FROM THE BEST
AVAILABLE COPY.....

DATE
02/80

DESIGNED
BY
R. HANSEN


D.K. 4

DATE
02/80

DESIGNED
BY
R. HANSEN


D.K. 4

CAUTION
UNDERGROUND
UTILITIES
P. H. K. & S. E. Inc.
10000 1st St. N.E.
Bellevue, WA 98004
Telephone 754-1111

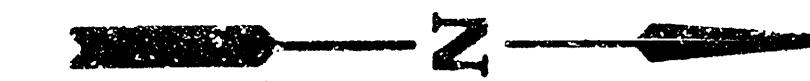

SCALE

PLAN 1" = 40'
PROFILE 1" = 40' HORIZ
1" = 5' VERT

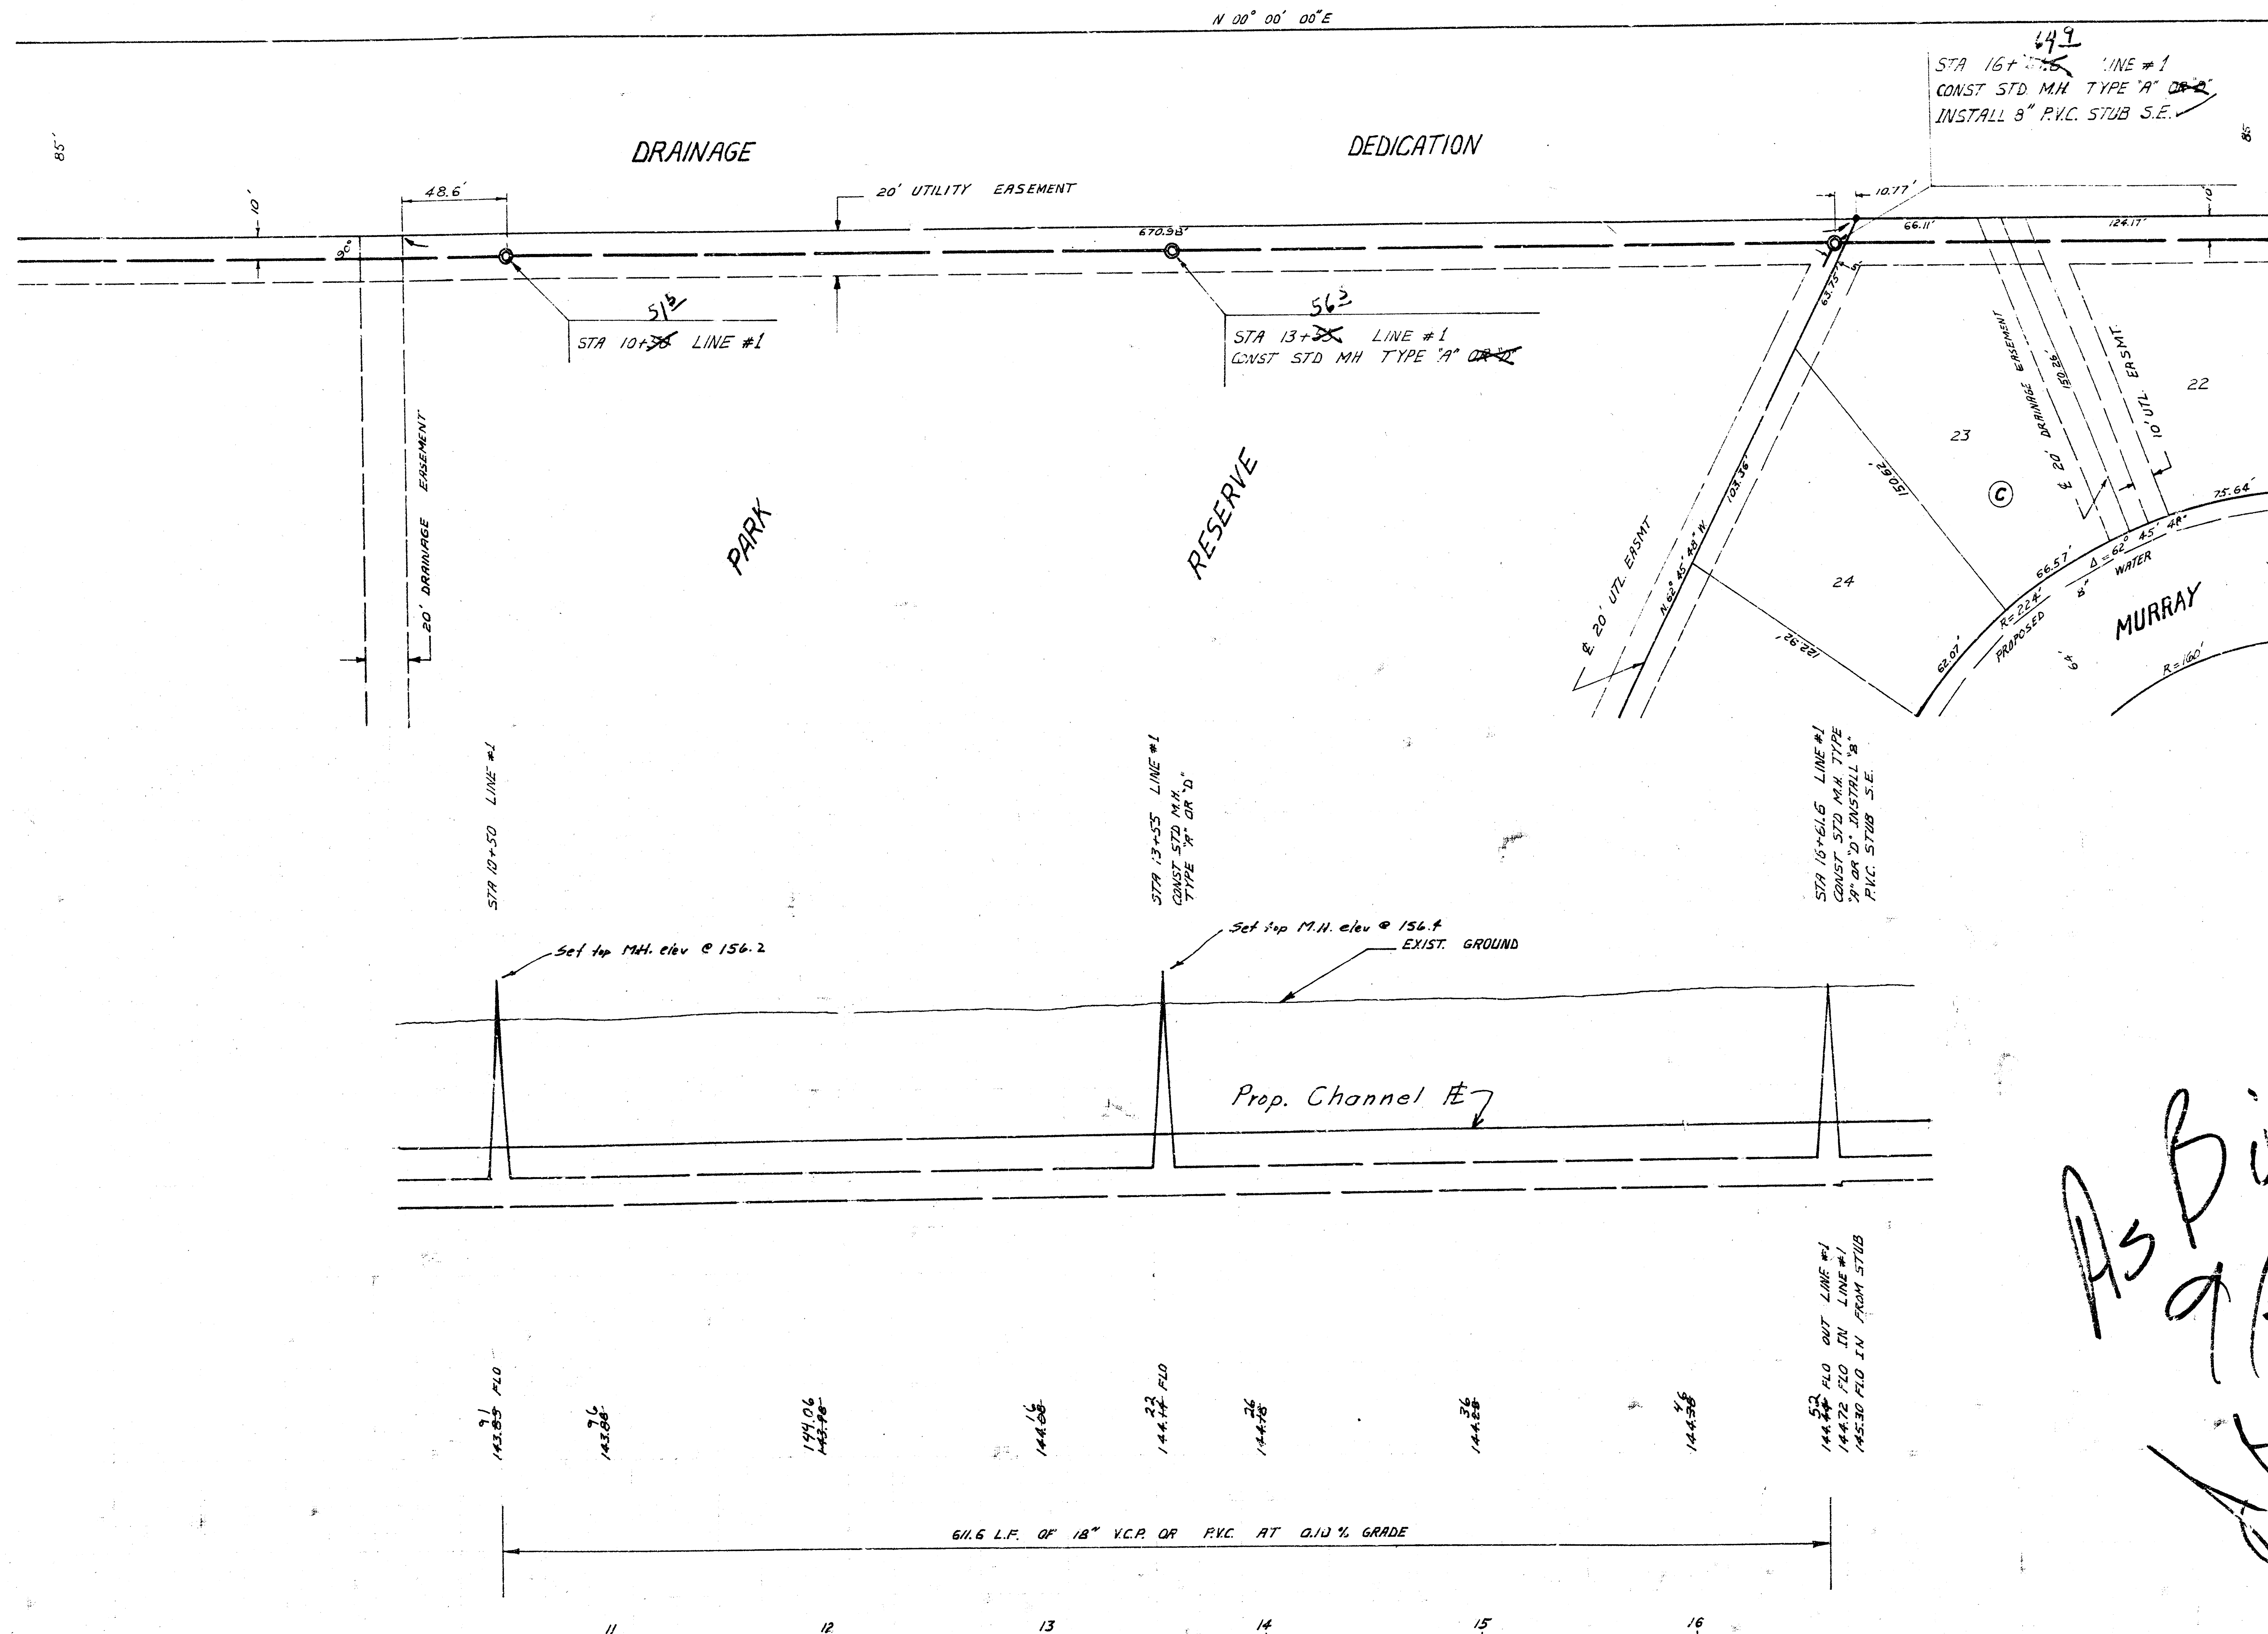


As Built
9/81
JHJ

MAIN 42 WESTLINK SEWER
PROJECT NO. 458-75-245-80982-000-010-001

FILMED FROM THE BEST
AVAILABLE COPY.....



SCALE PLAN 1" = 40'
 PROFILE 1" = 40' HORIZ.
 1" = 5' VERT.

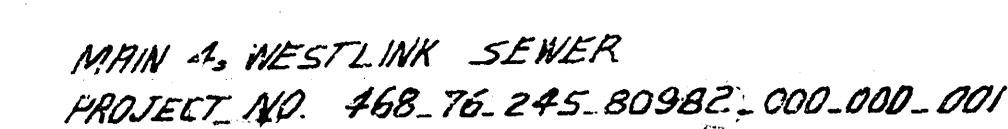

FILMED FROM THE BEST
AVAILABLE COPY.....