


B. M. 143.11 "G" in Globe W.L. Eastern Ave.
N-cb Rose Lane. 1955

Sta. 0+00.0
Const. Std. M.H. Type "A"
over exist. 8" S.

TURNPIKE

KANSAS

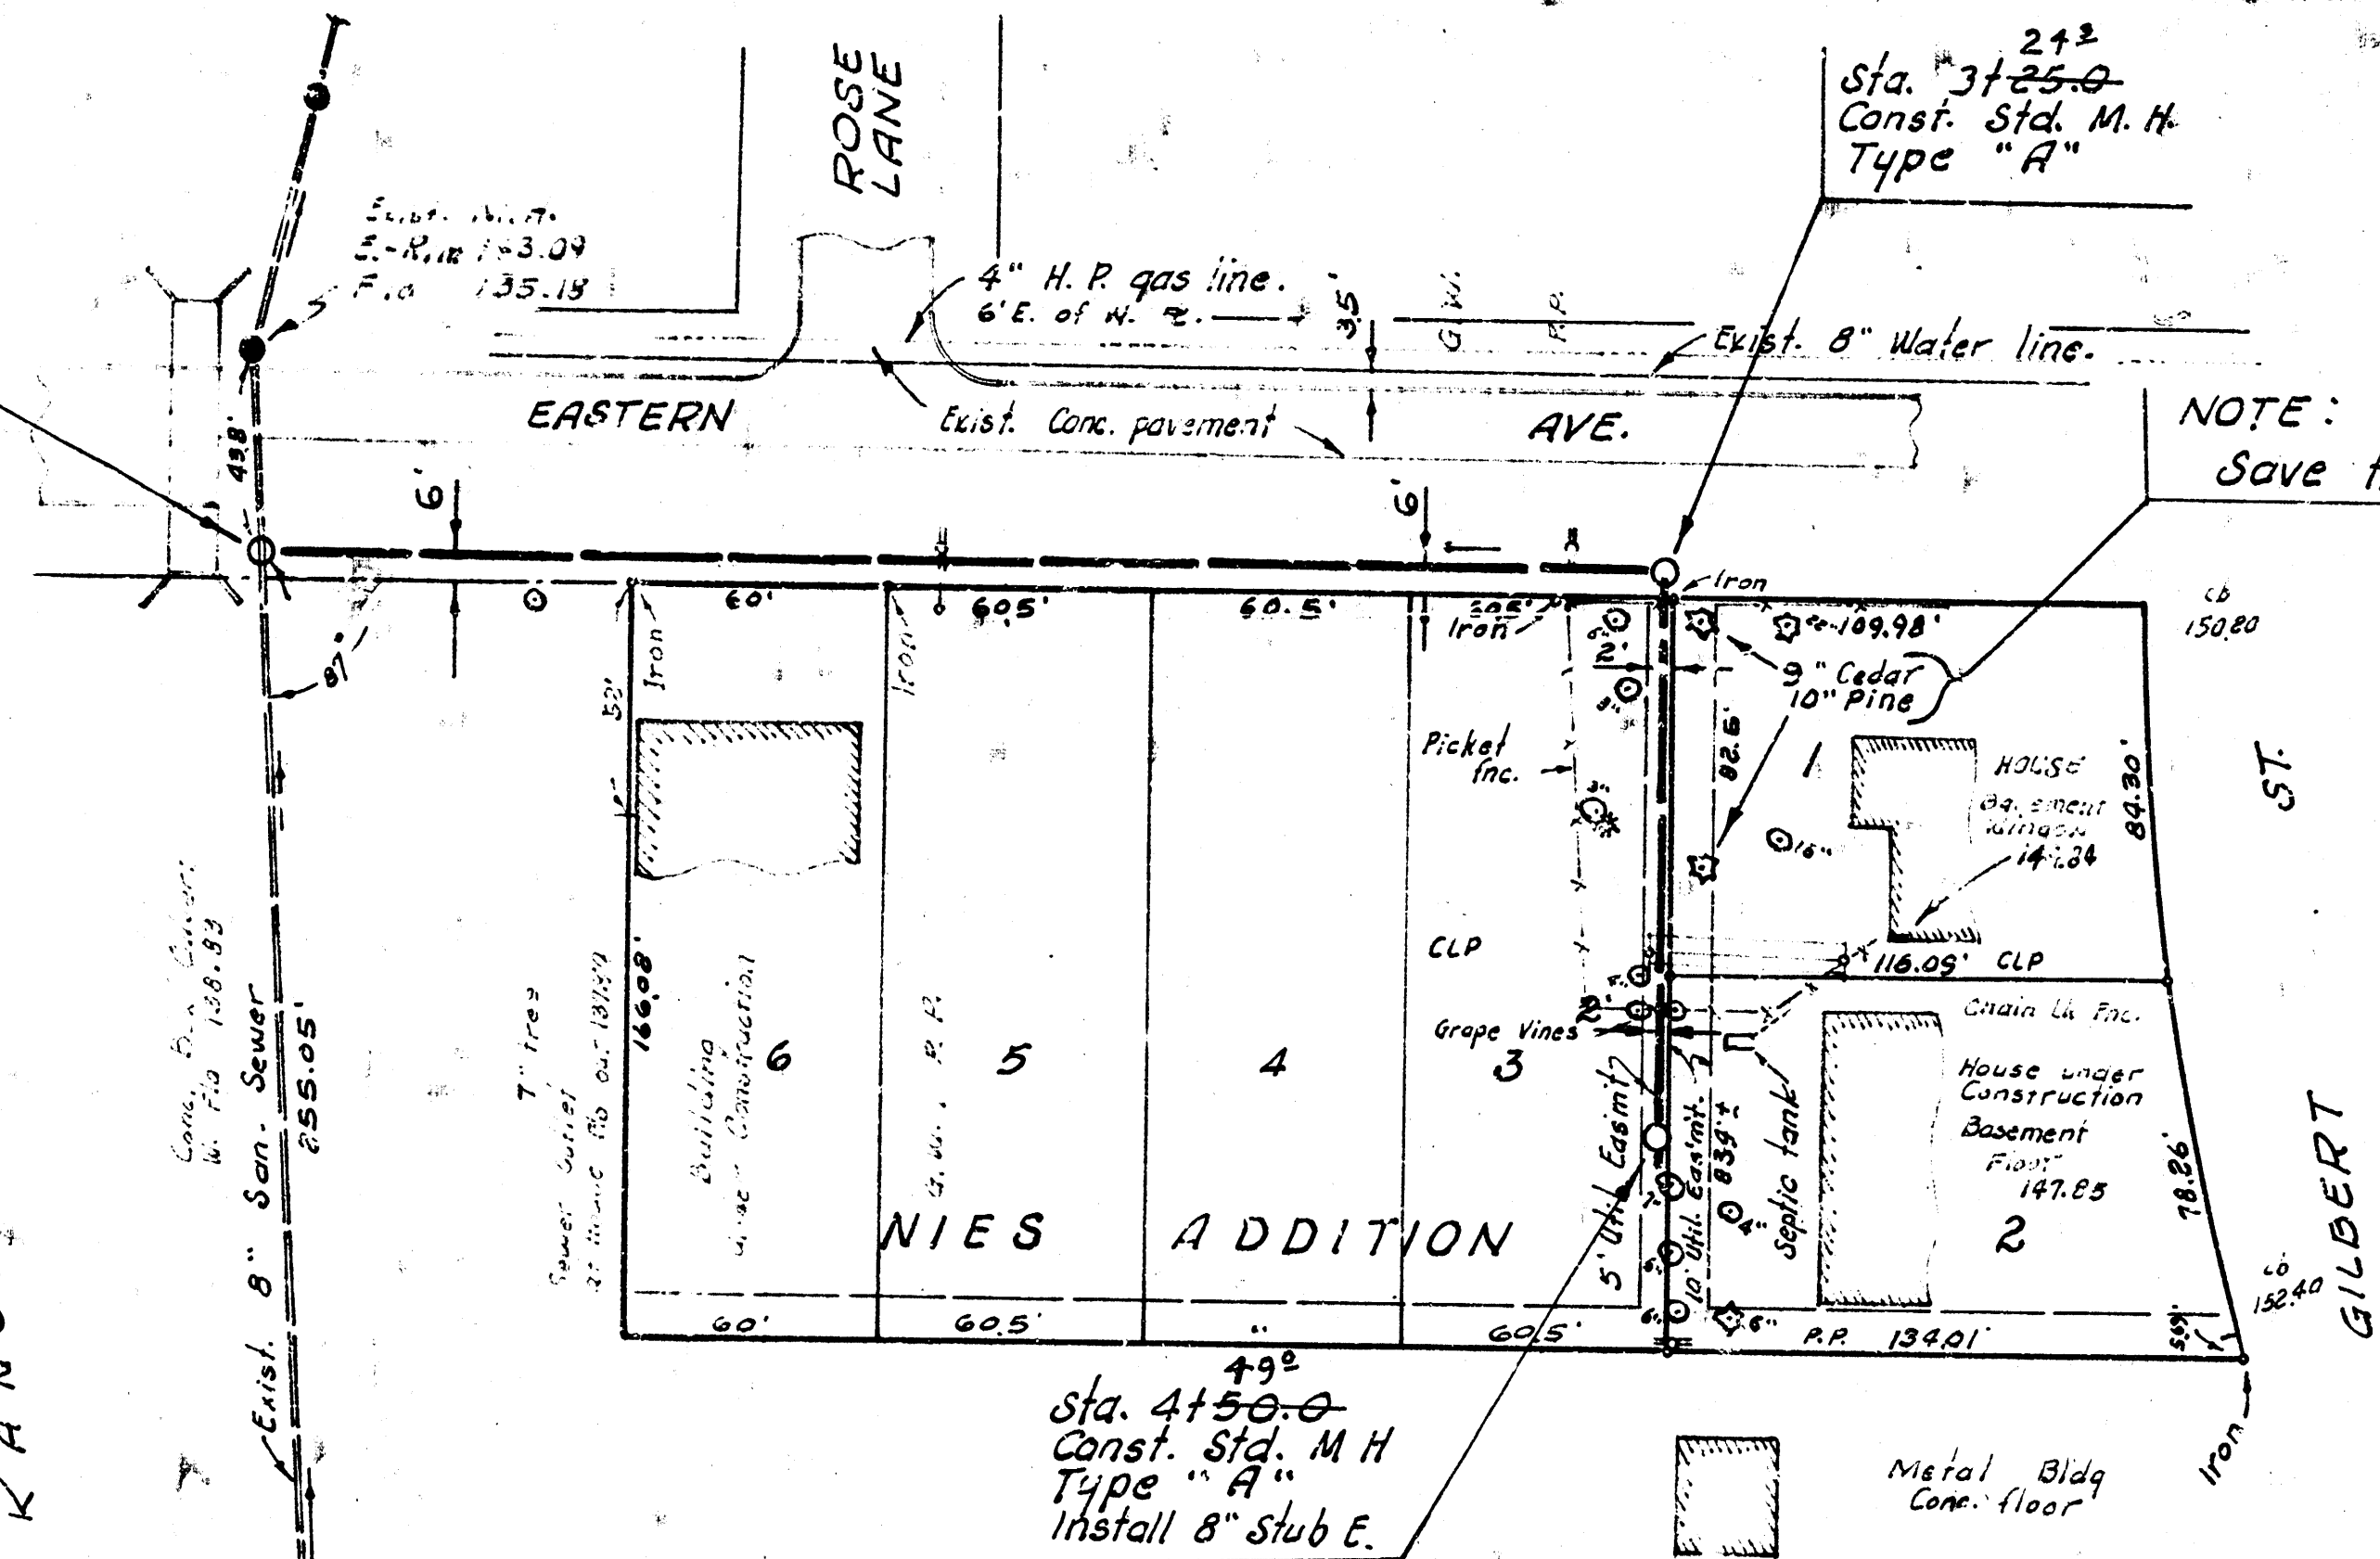

NOTE:
Save these trees.


Plan Scale 1" = 40'
Profile Scale 1" = 40' Horiz
1" = 5' Vert.

Sta. 0+00.0 M.H. Type "A"
Const. Std. M.H. Type "A"
over exist. 8" S.

0+180.0 Sewer outlet
at House

Sta. 3+50.0
Const. Std. M.H. Type "A"

Sta. 4+50.0
Const. Std. M.H. Type "A"
Install 8" stub east

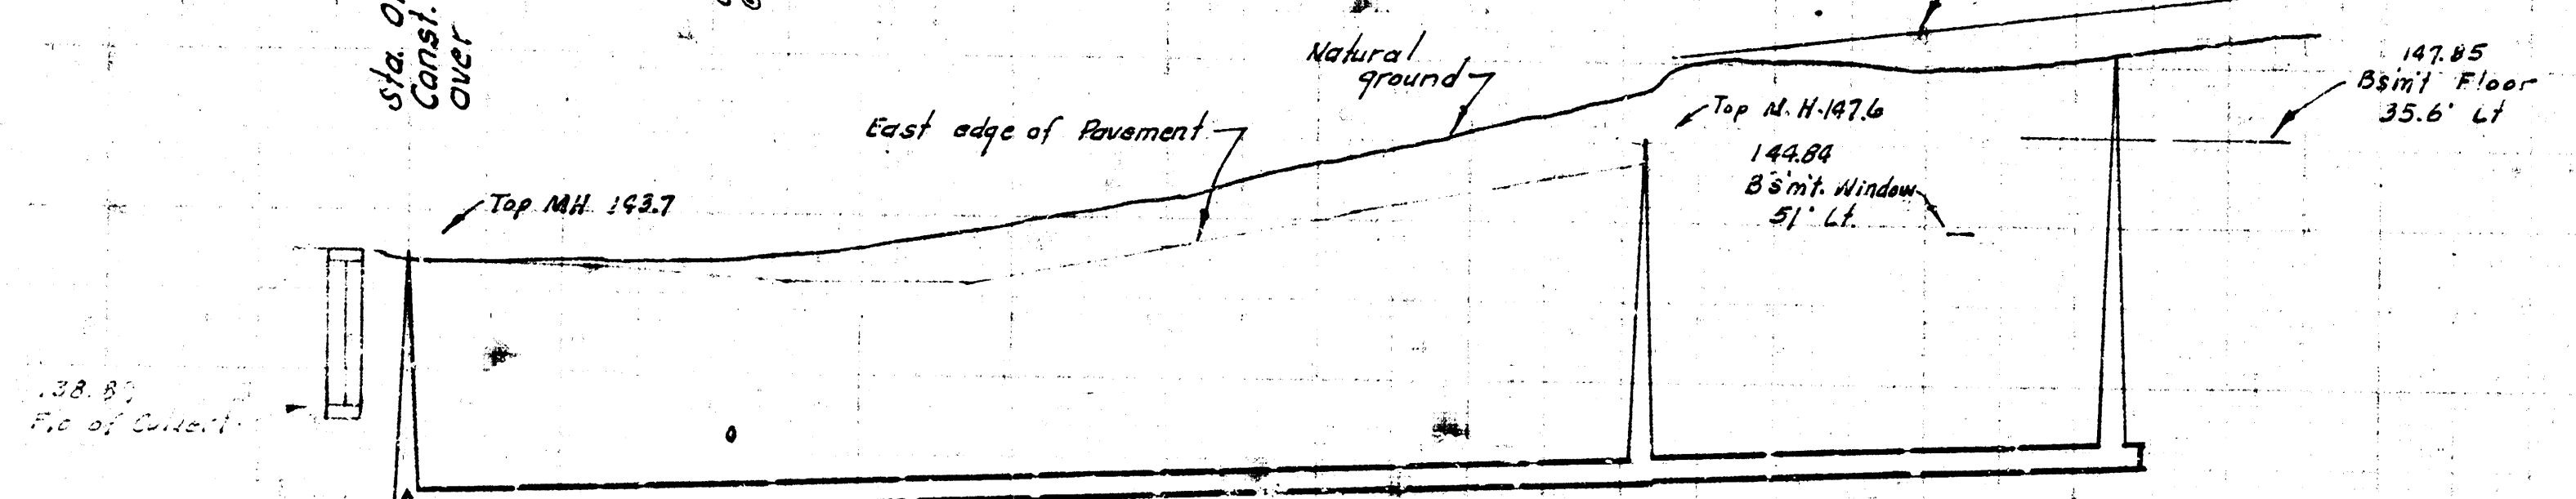

450 Lin. ft. of 8" Clay Pipe @ 0.40% grade.

As Built Final Measurements I-H-79
LAT. 52, WAR INDUSTRIES SEWER
CITY OF WICHITA, KANSAS
R. W. LINN — CITY ENGINEER
FEB. 1973 PROJECT NO. DBKL 572042