
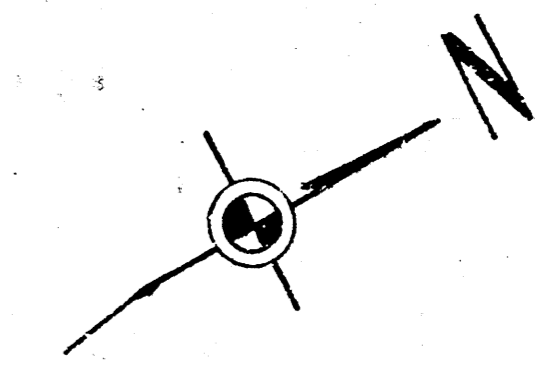




B. M. #1 145.79 "R" in Ritchie So. end Rad.
 S. E. cor. Zimmerly and Briarcliff Circle.
 B. M. #2 148.85 E. Rim M.H. Sta 0100

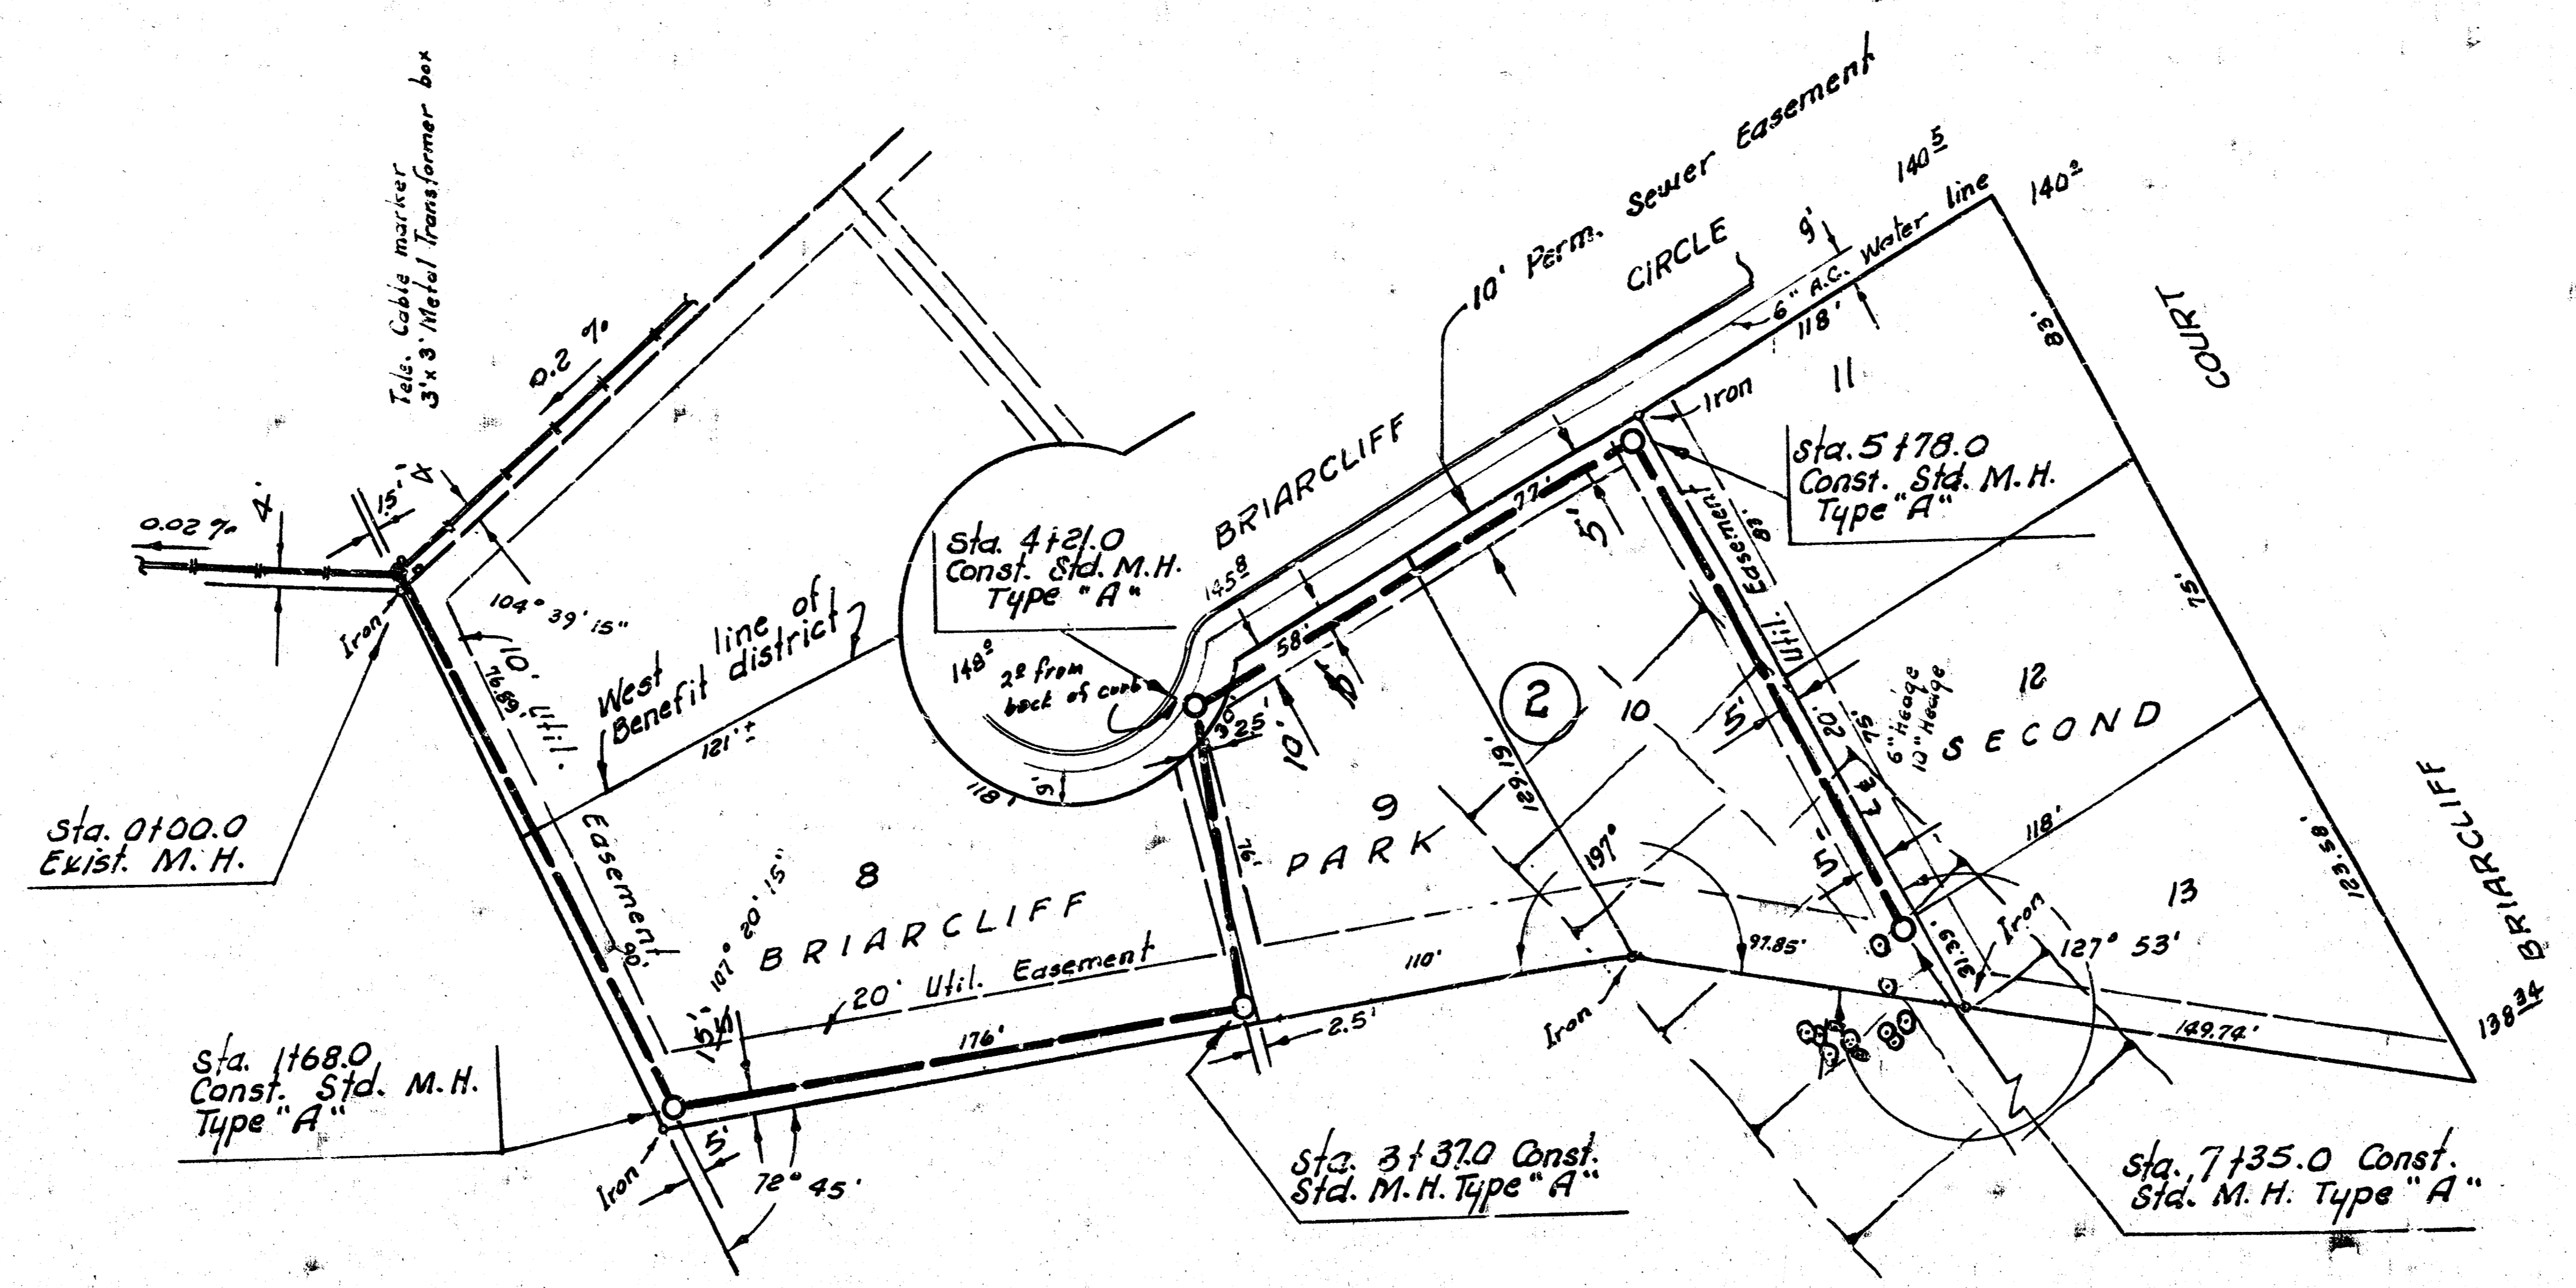

Plan Scale 1" = 40'
 Profile Scale 1" = 40' Horiz.
 1" = 5' Vert.

NOTE:
 San. Sewer pipe must
 have a minimum of
 30" Cover.

5-146

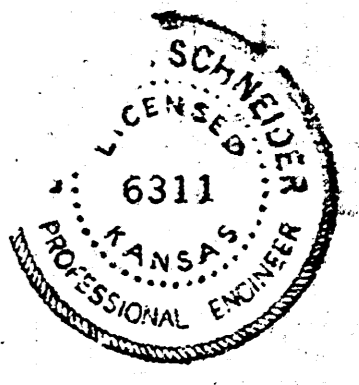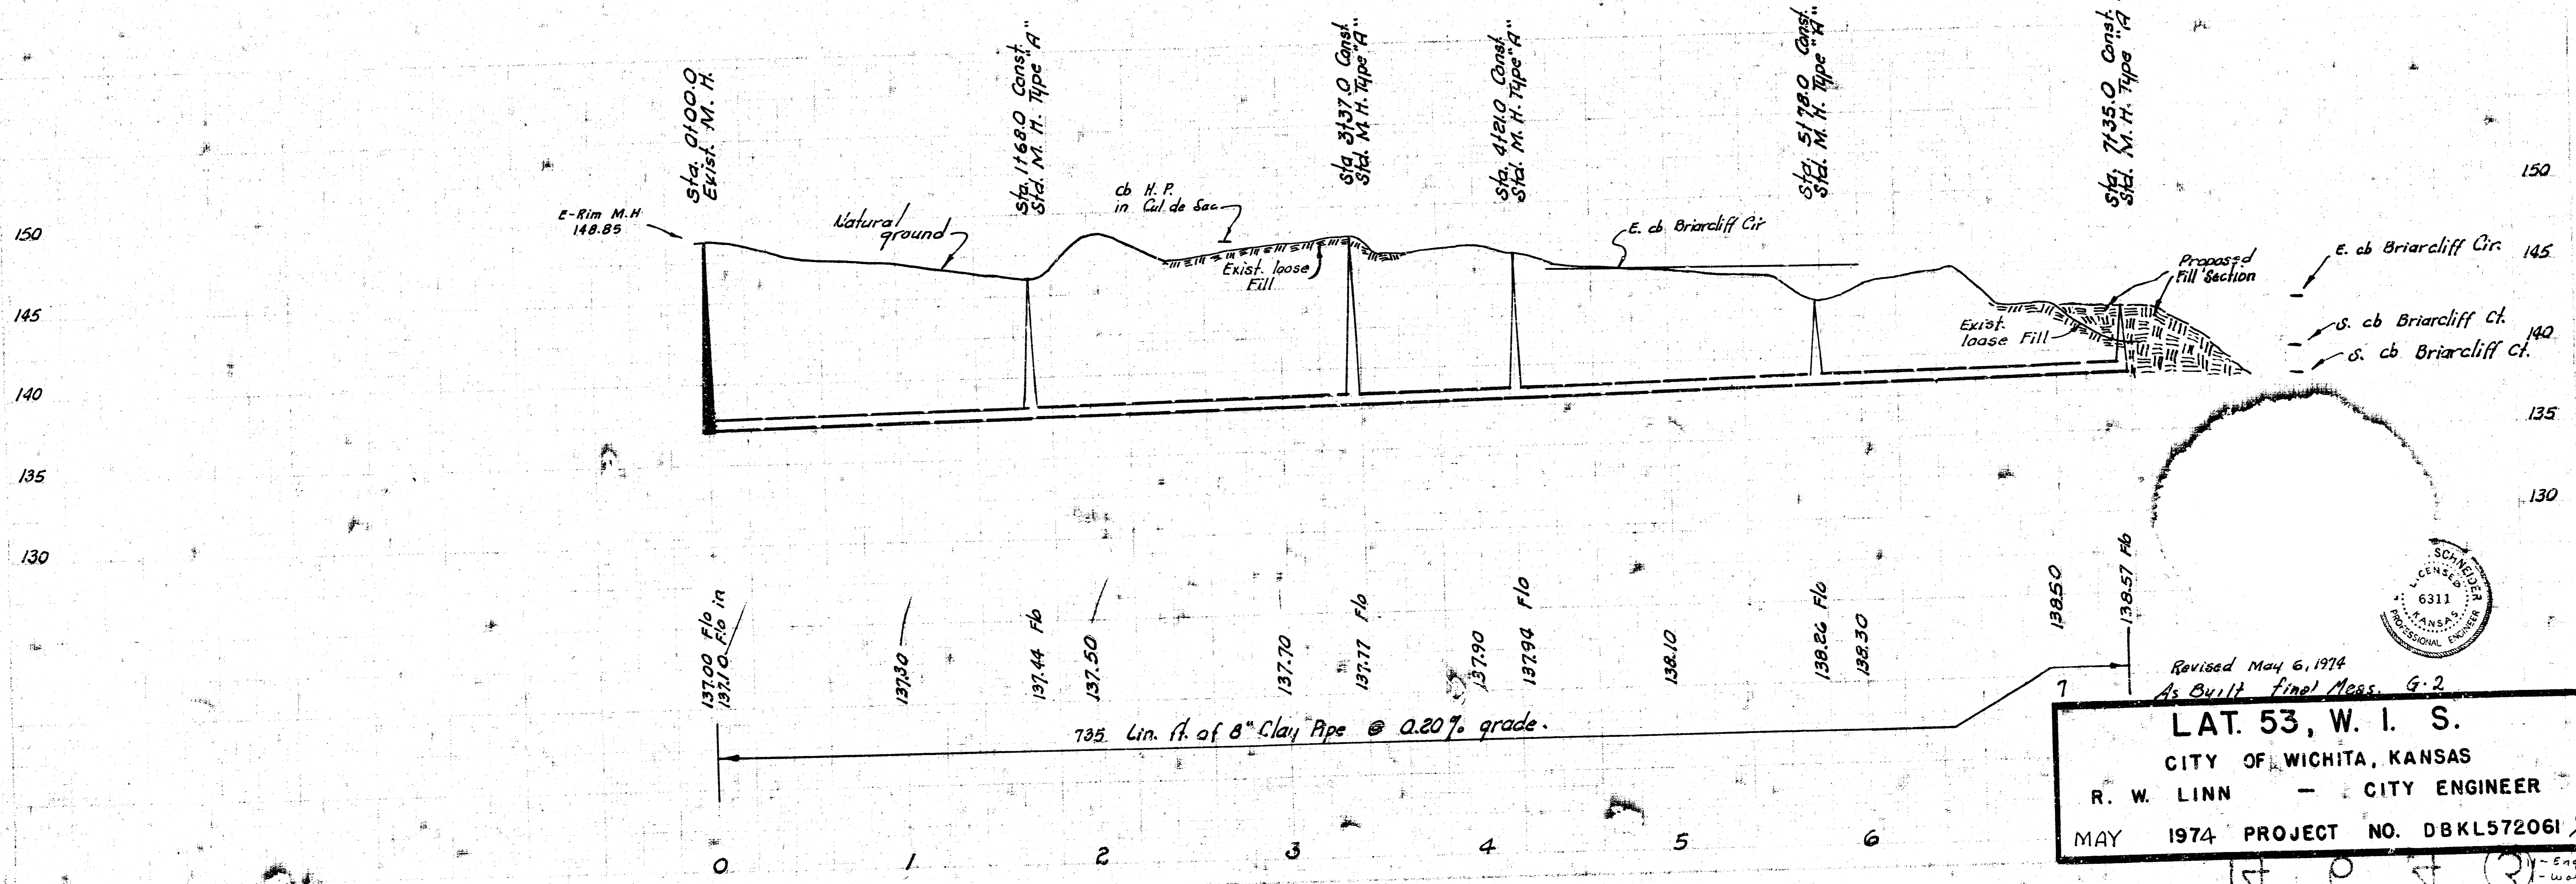

Revised May 6, 1974
 As Built final Meas. G-2
LAT. 53, W. 1. S.
 CITY OF WICHITA, KANSAS
 R. W. LINN - CITY ENGINEER
 MAY 1974 PROJECT NO. DBKL572061

FILMED FROM THE BEST