



J. R. W. A. R. W.
76

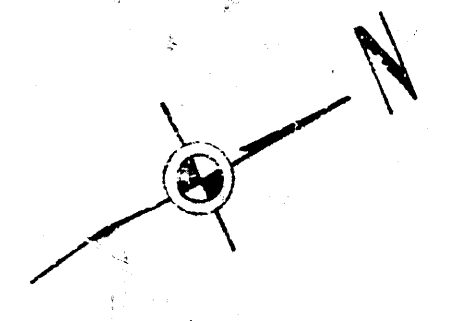

NOTE :
San. Sewer pipe must
have a minimum of
30" Cover.

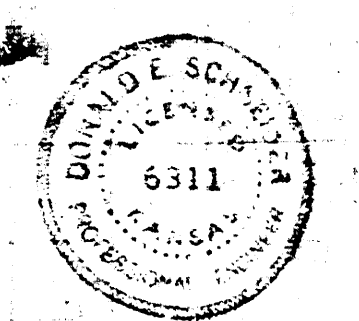

Revised May 6, 1974
As Built final Meas. G-2

LAT. 53, W. I. S.
CITY OF WICHITA, KANSAS
W. LINE - CITY ENGINEER
1974 PROJECT NO. DBKL572061