



B. M. 148.10 City Std. @ Ridge Rd.  
E. 13th St.

B. M. 153.12 R.R. Spike W. side P. Pole  
2' E. of E. cb Holland. approx.  
25' N. of N. Line 13th St.

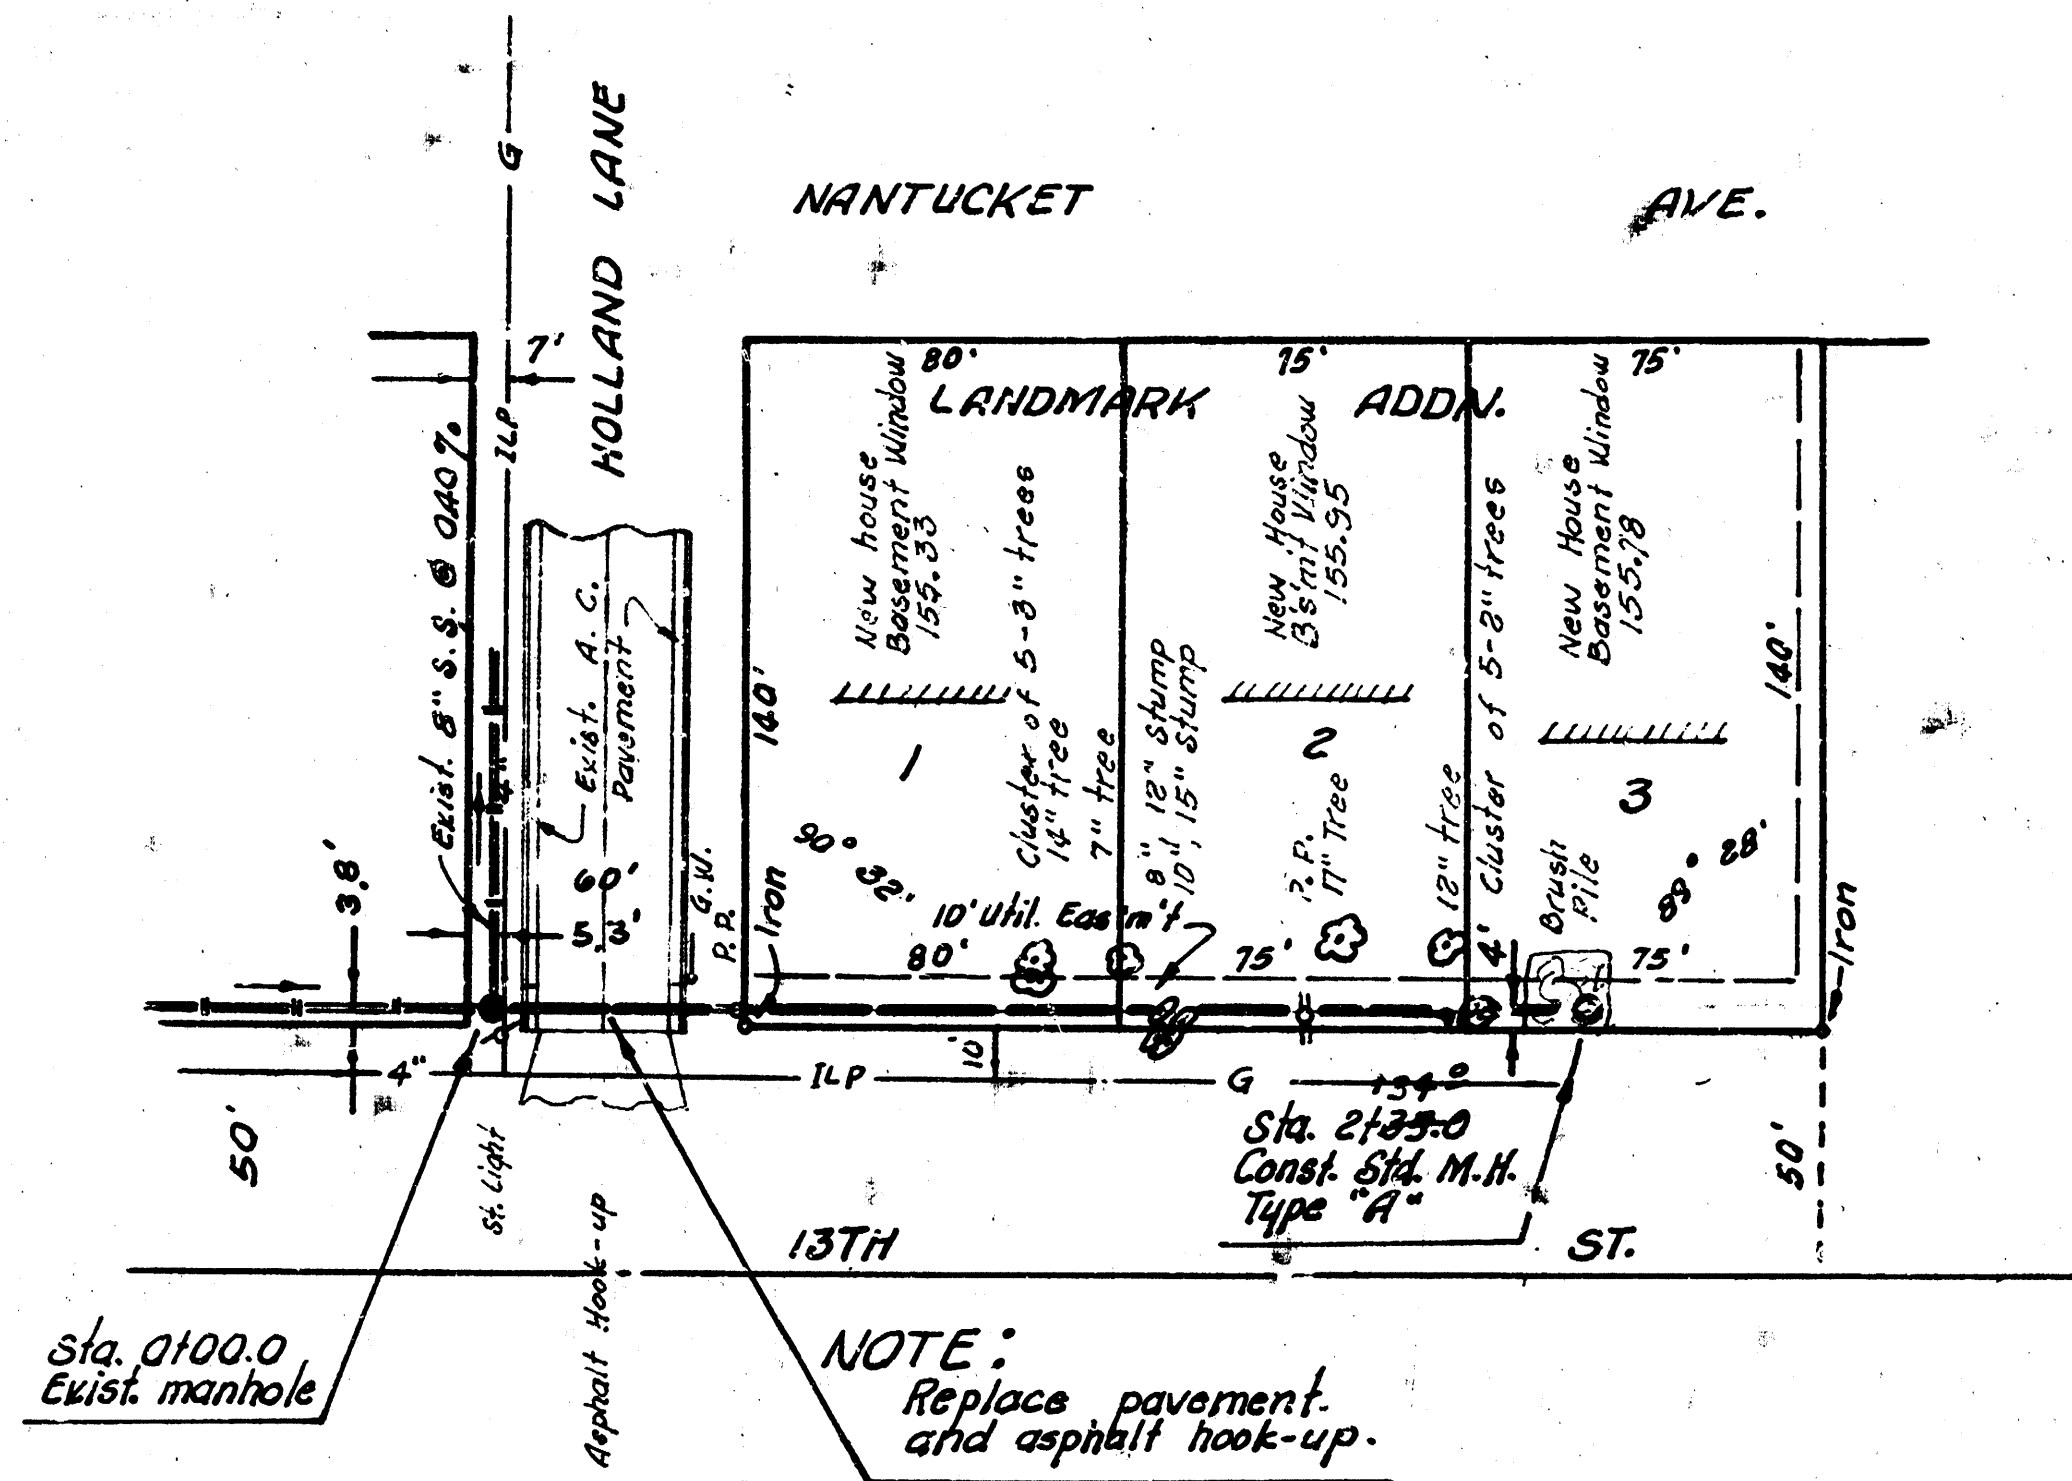

Plan Scale 1" = 40' 1  
Profile Scale 1" = 40' Horiz.  
1" = 5' Vert.

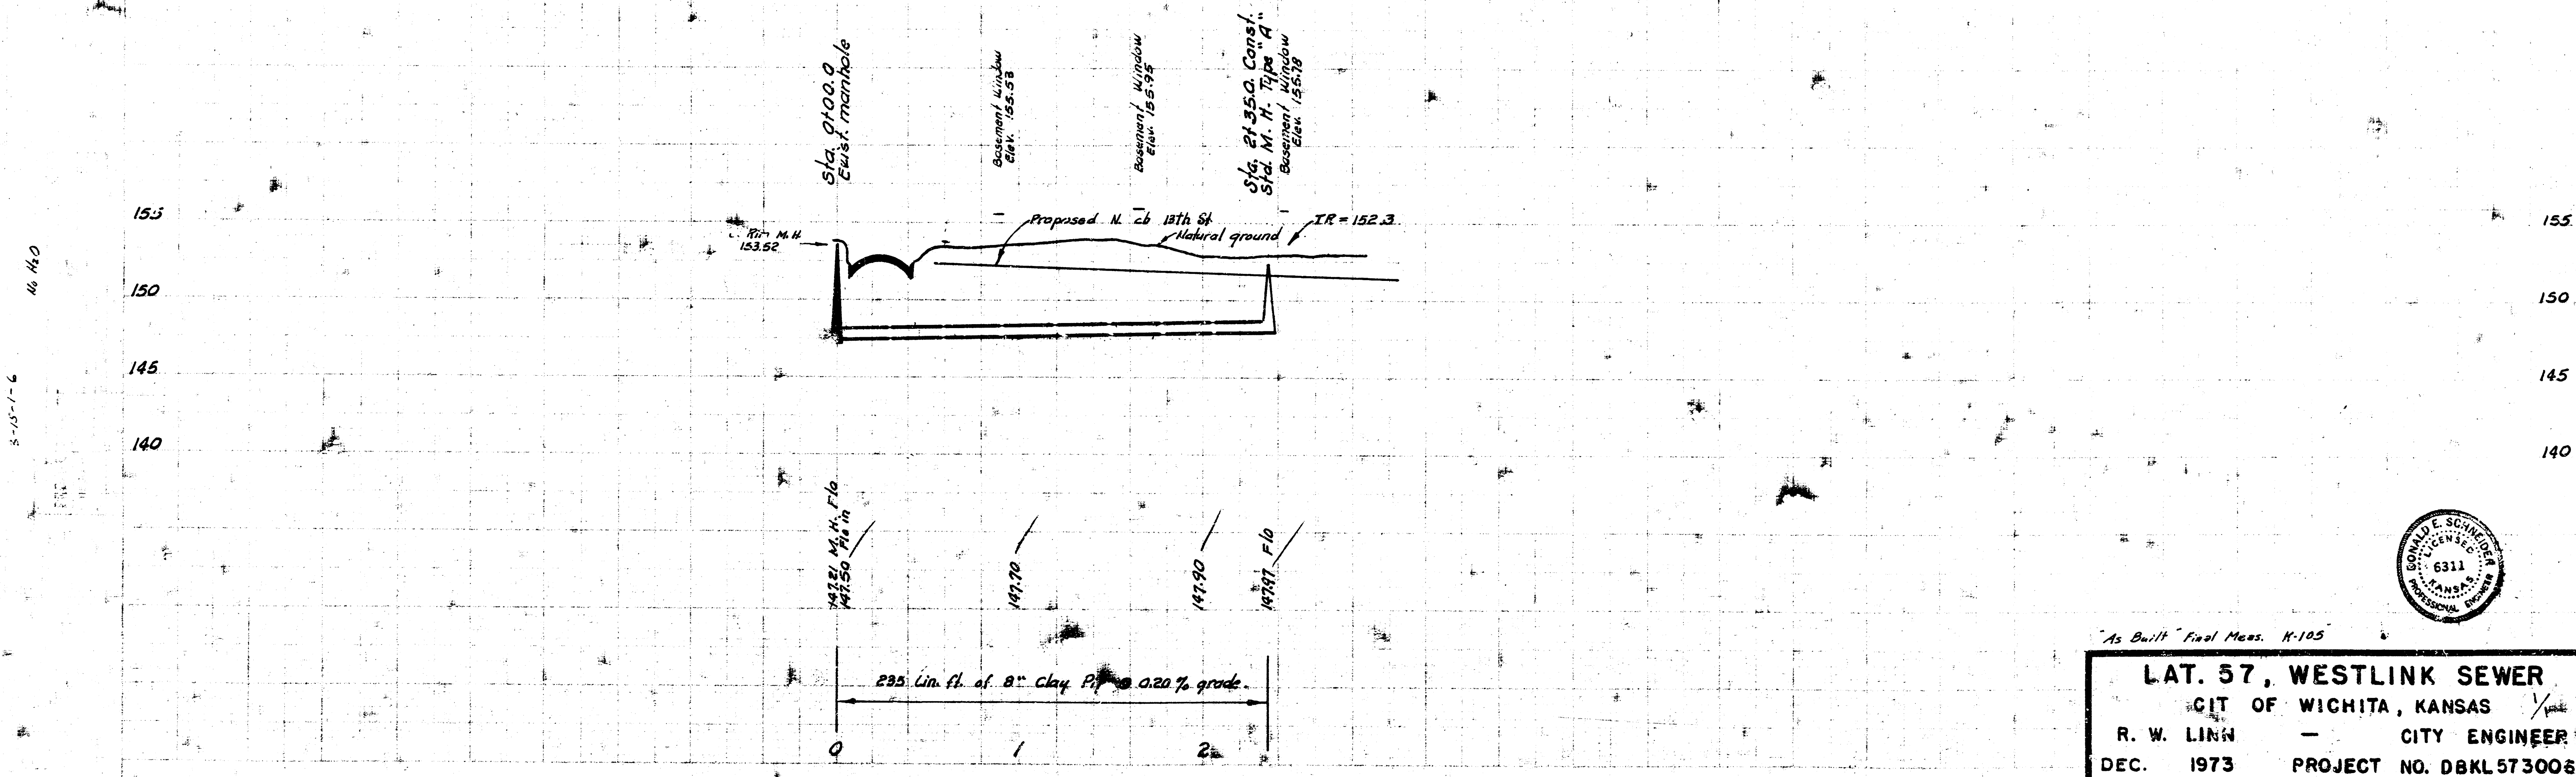

"As Built" Final Meas. K-105

LAT. 57, WESTLINK SEWER  
CITY OF WICHITA, KANSAS  
R. W. LINN — CITY ENGINEER  
DEC. 1973 PROJECT NO. DBKL573006