


B.M. 104.29 City Disc 52' N. + 44' E. @ Hillside + 31st South
 B.M. 99.14 "X" cut on N.W. corner of Lower step on W-side of Bldg.

Plan Scale 1" = 40'
 Profile Scale 1" = 40' Hor
 1" = 5' Vert.


CAUTION
 UNDERGROUND
 UTILITIES
 Please refer to the
 Survey Report for
 Telephone & Gas Locations

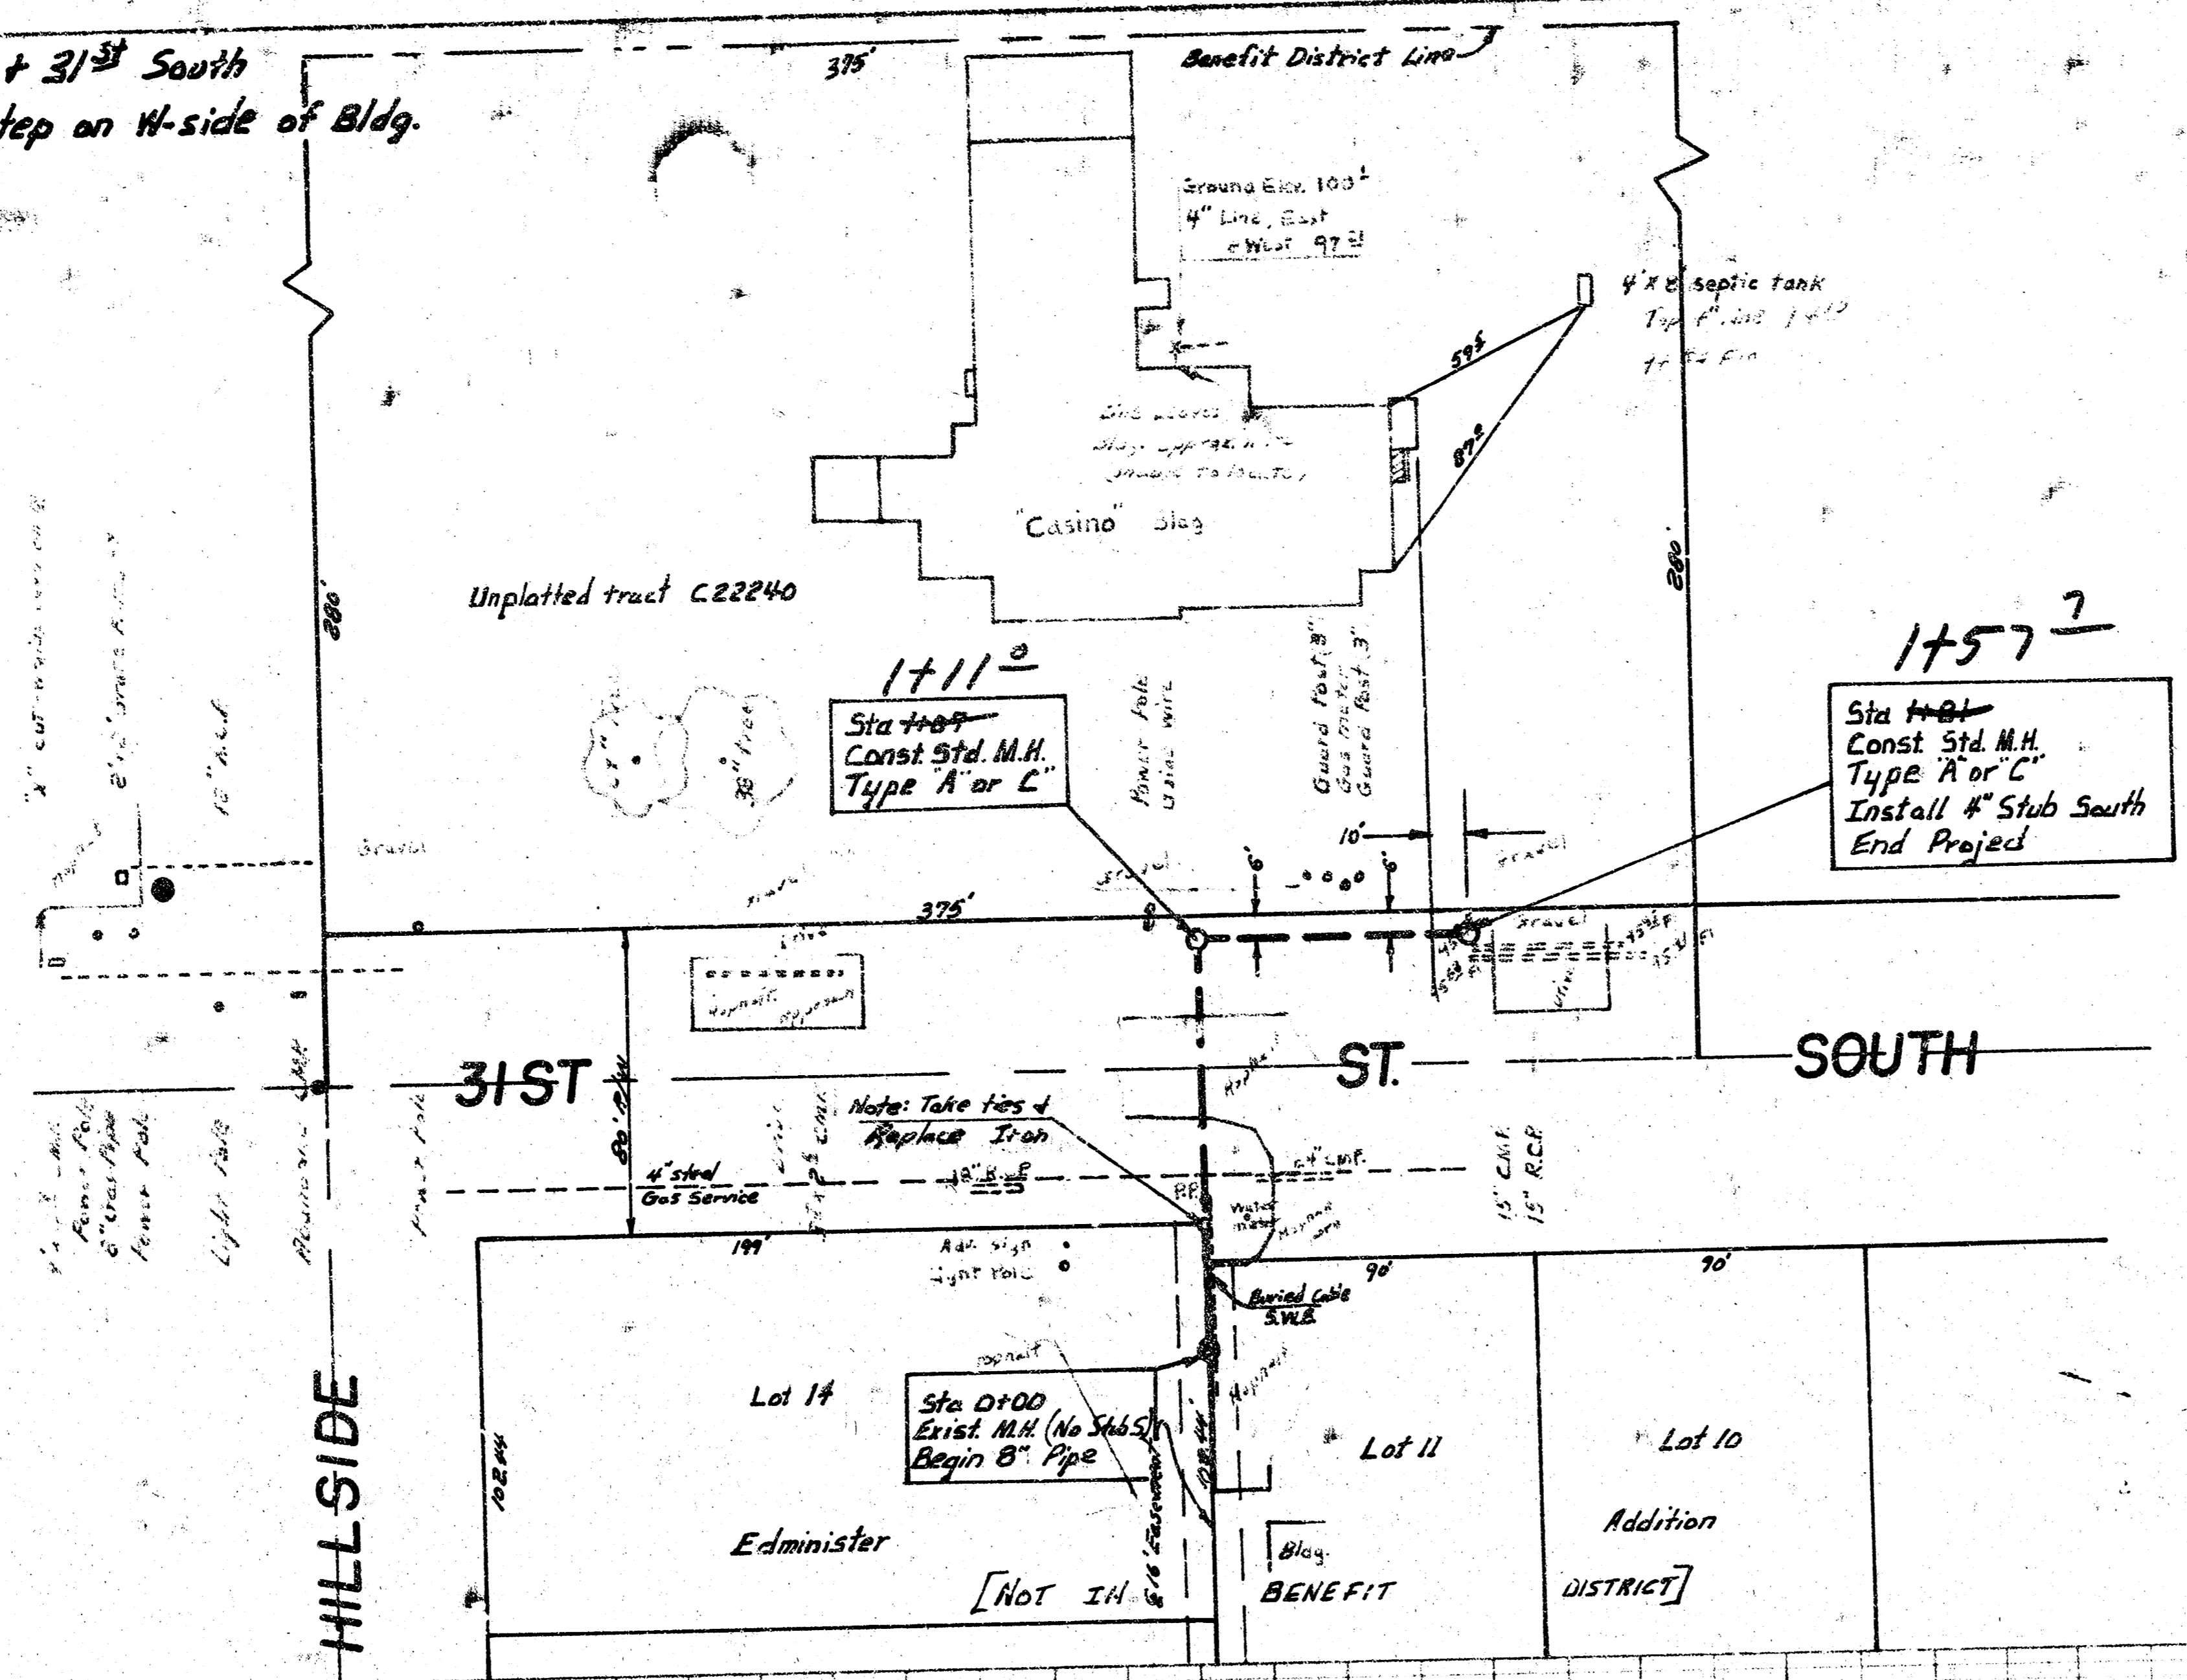

NOTE: TRAFFIC SHALL BE CARRIED THROUGH CONSTRUCTION ON 31ST STREET SOUTH. THIS ESTABLISHMENT IS UNDER COURT ORDER TO CONNECT TO CITY SEWER SO THE CITY WILL EXPECT CONSTRUCTION TO PROCEED IMMEDIATELY AFTER THE CONTRACT IS AWARDED.

PLAN SHEET
 SOUTH BOUND
 7/2/78

PROFILE SHEET
 SOUTH BOUND
 7/2/78

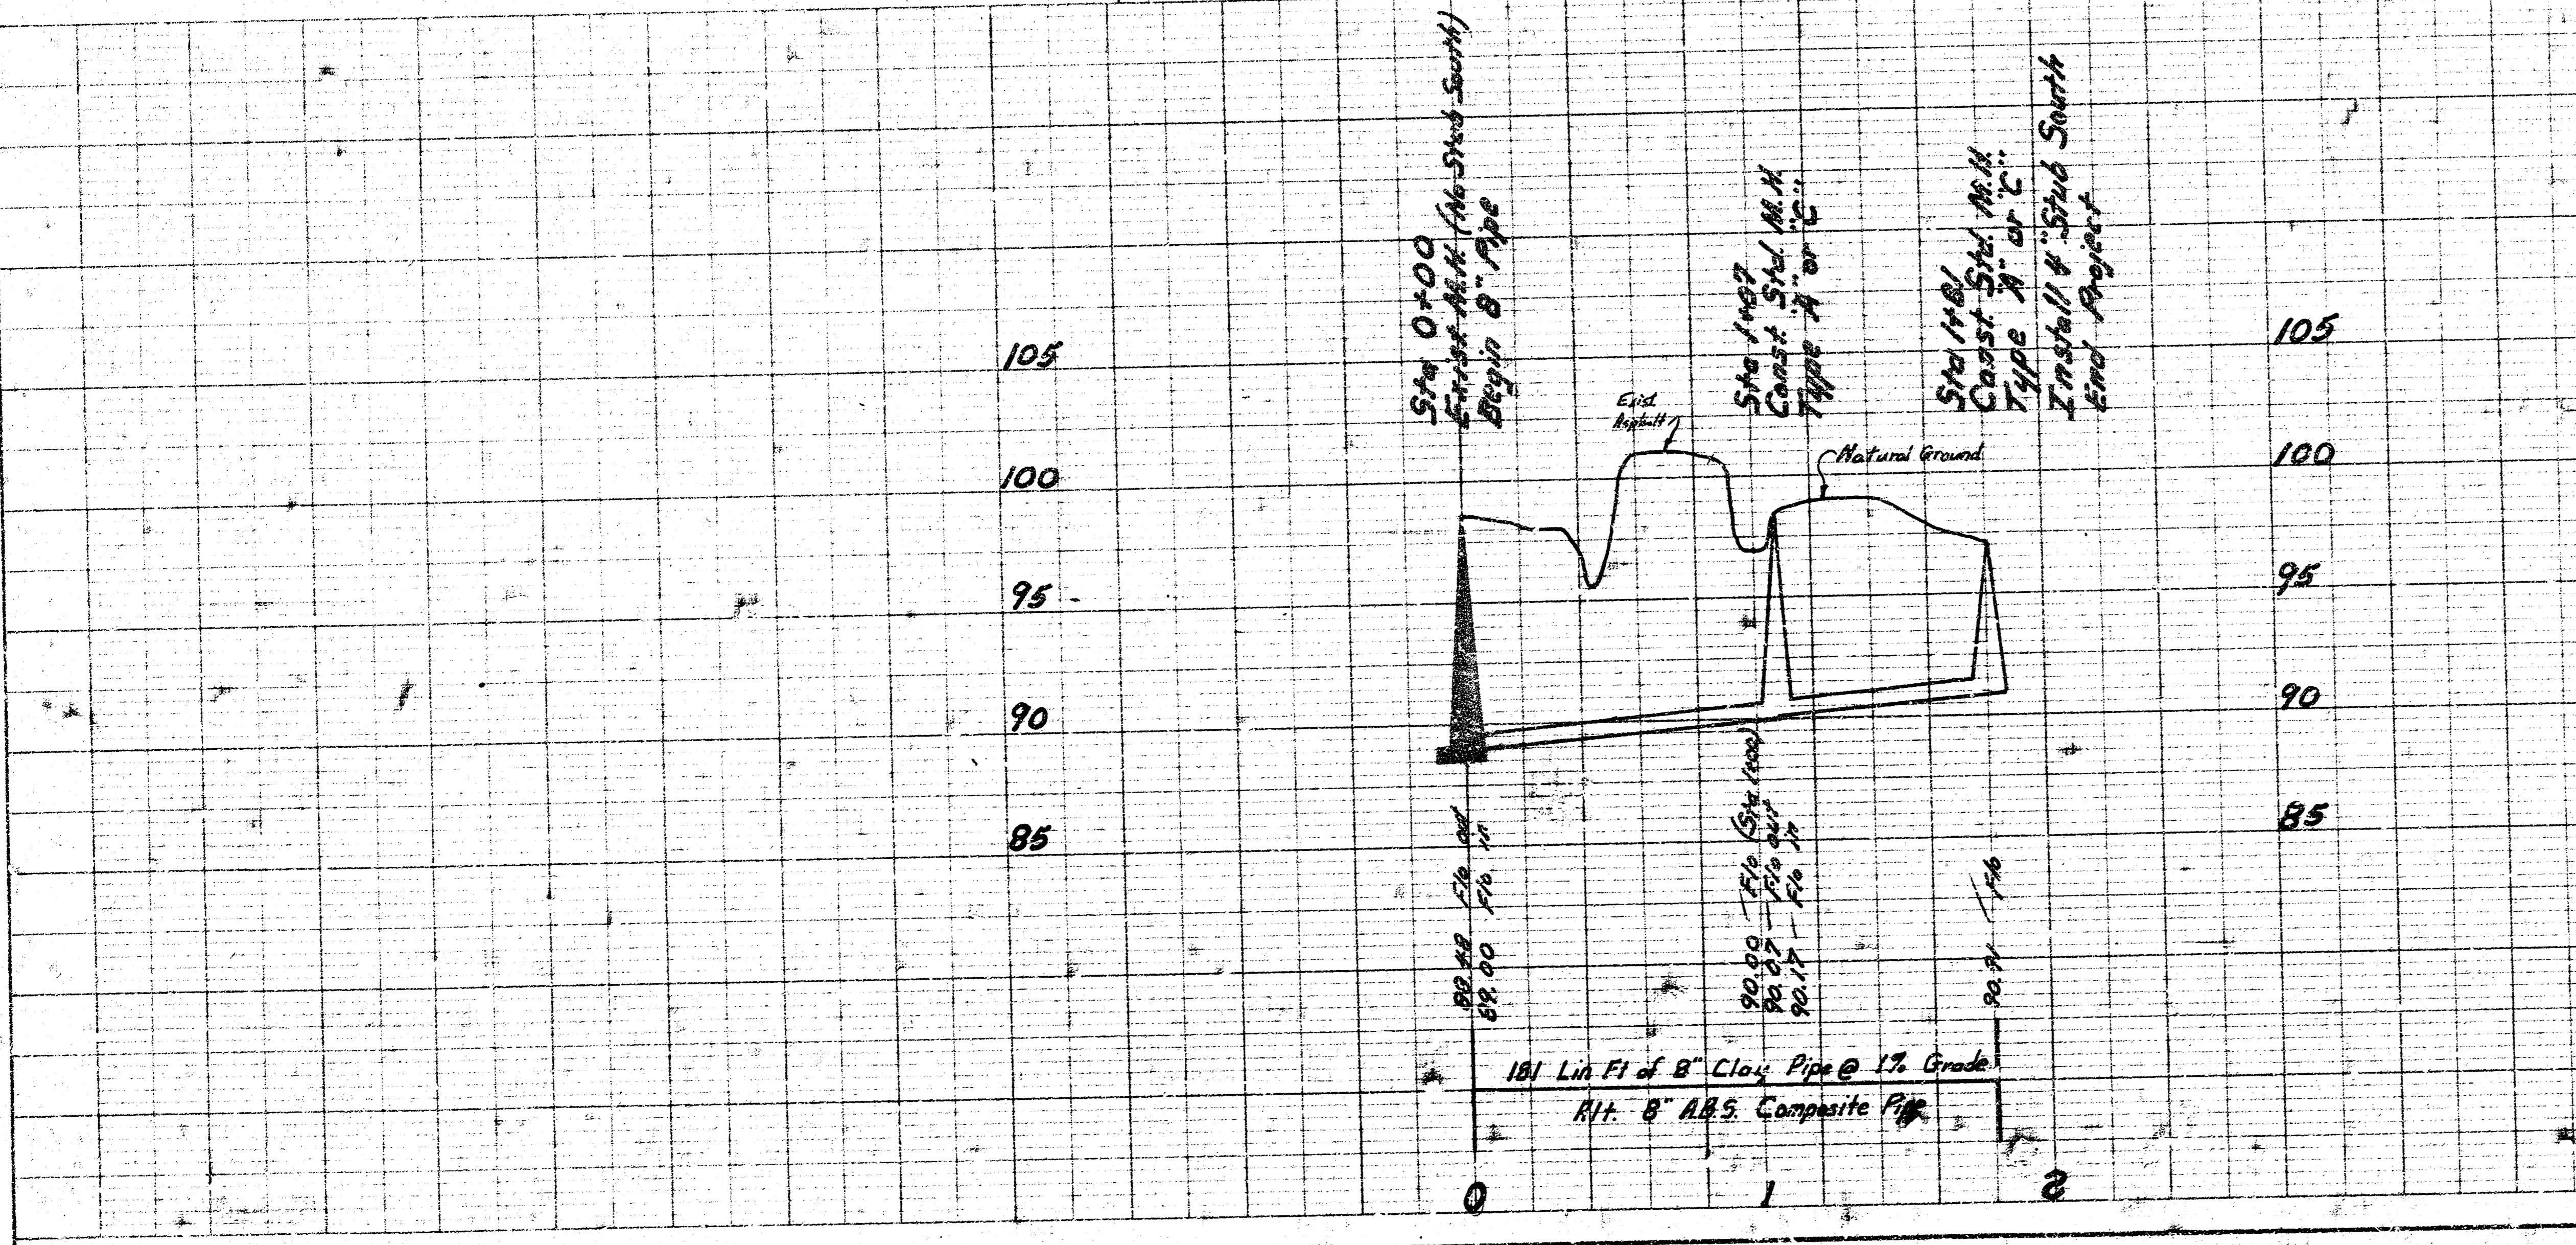

As built 10-26-78
LAT 60 WAR INDUSTRIES SEWER
 CITY OF WICHITA, KS.
 R. W. LINN CITY ENGINEER
 Project No. 468-76-245-80540-000-000-001

