

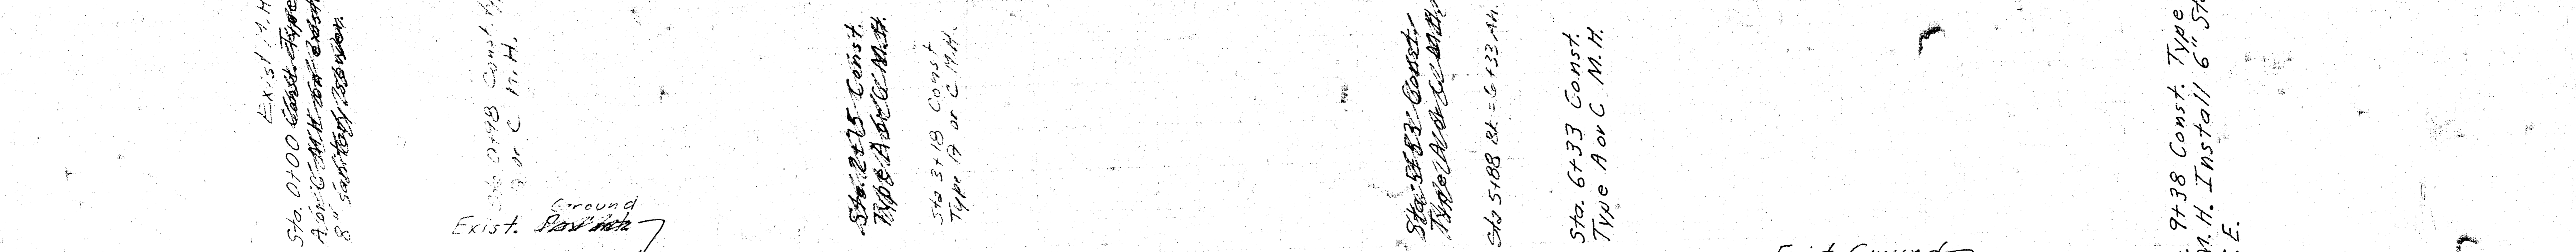
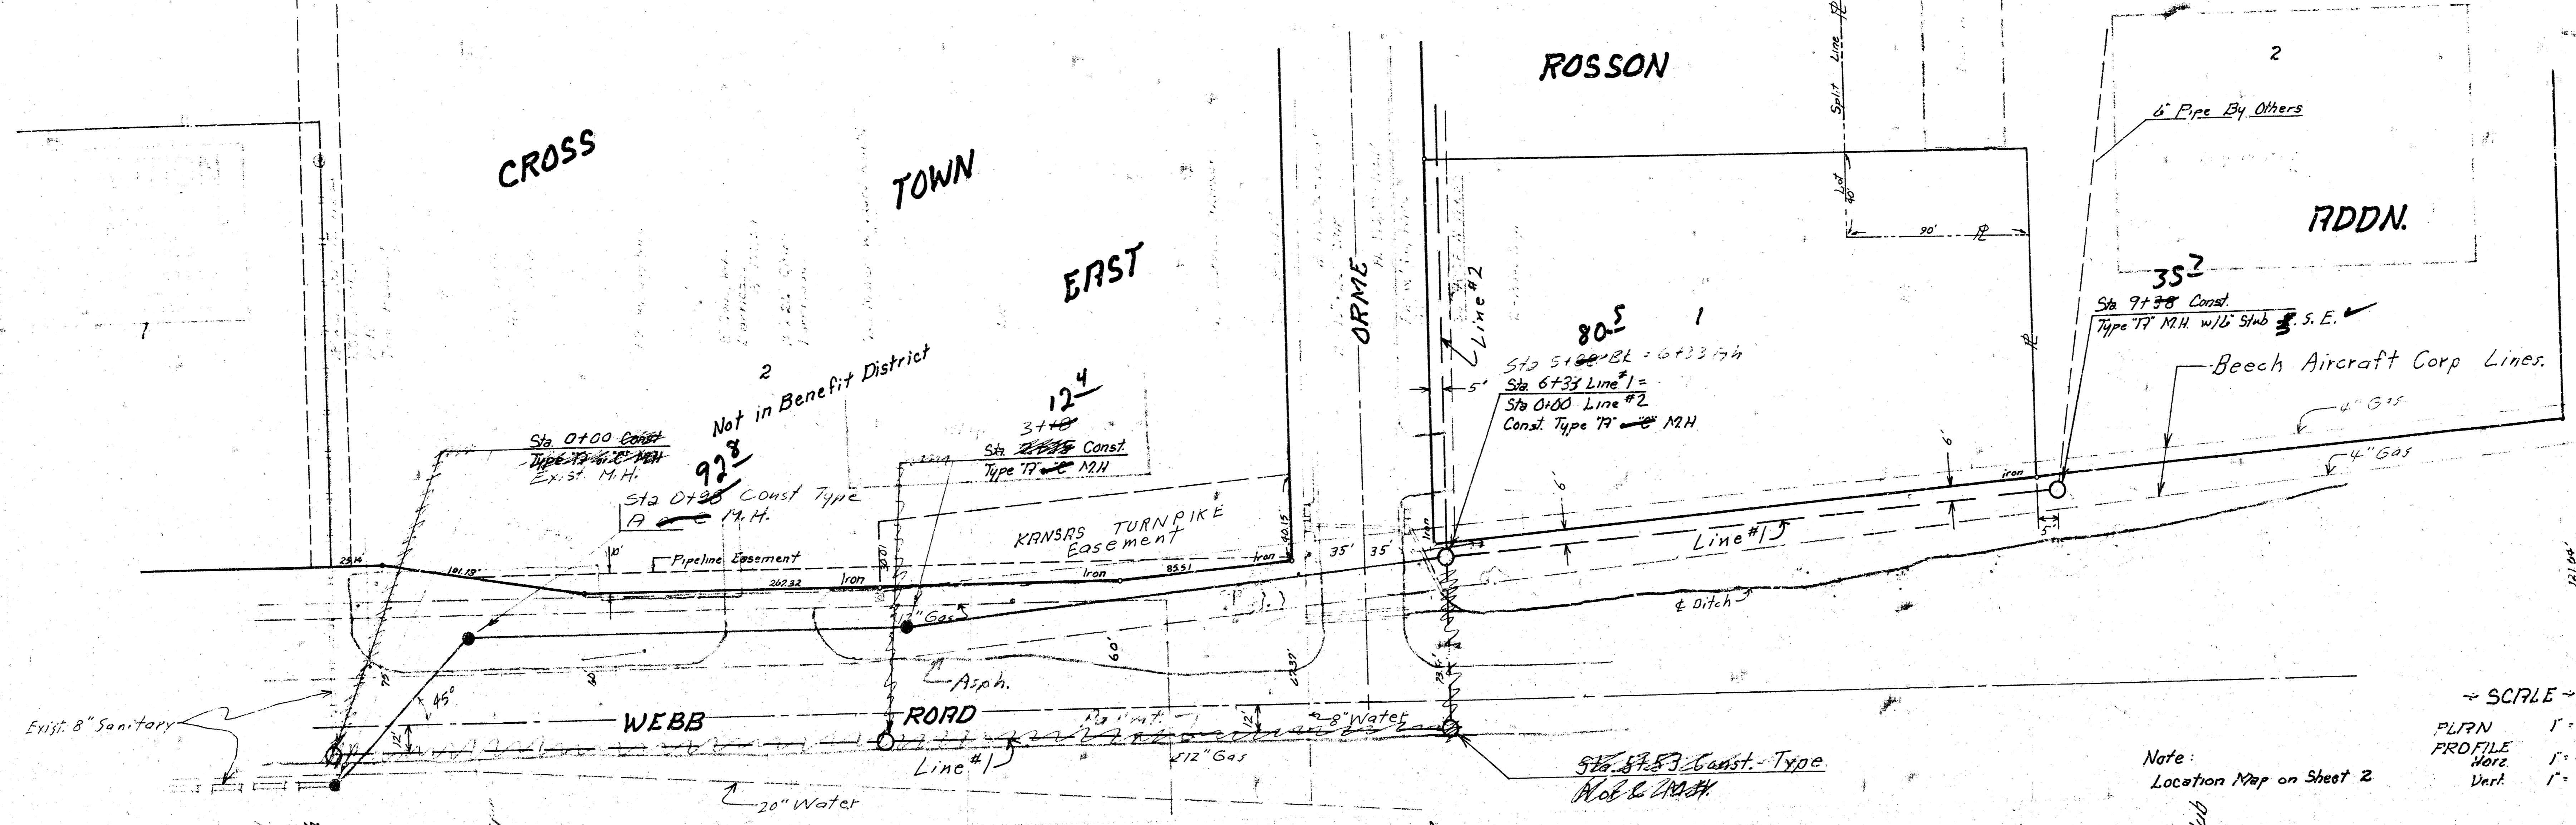


B.M. 17914 City Sta. 734' S. + 31' E. of E. WEBB and KELLOGG
 B.M. 17796 " " N. - of ORME + E. of EL WEBB ROAD

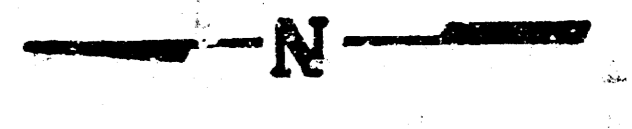

180
175
170
165
160

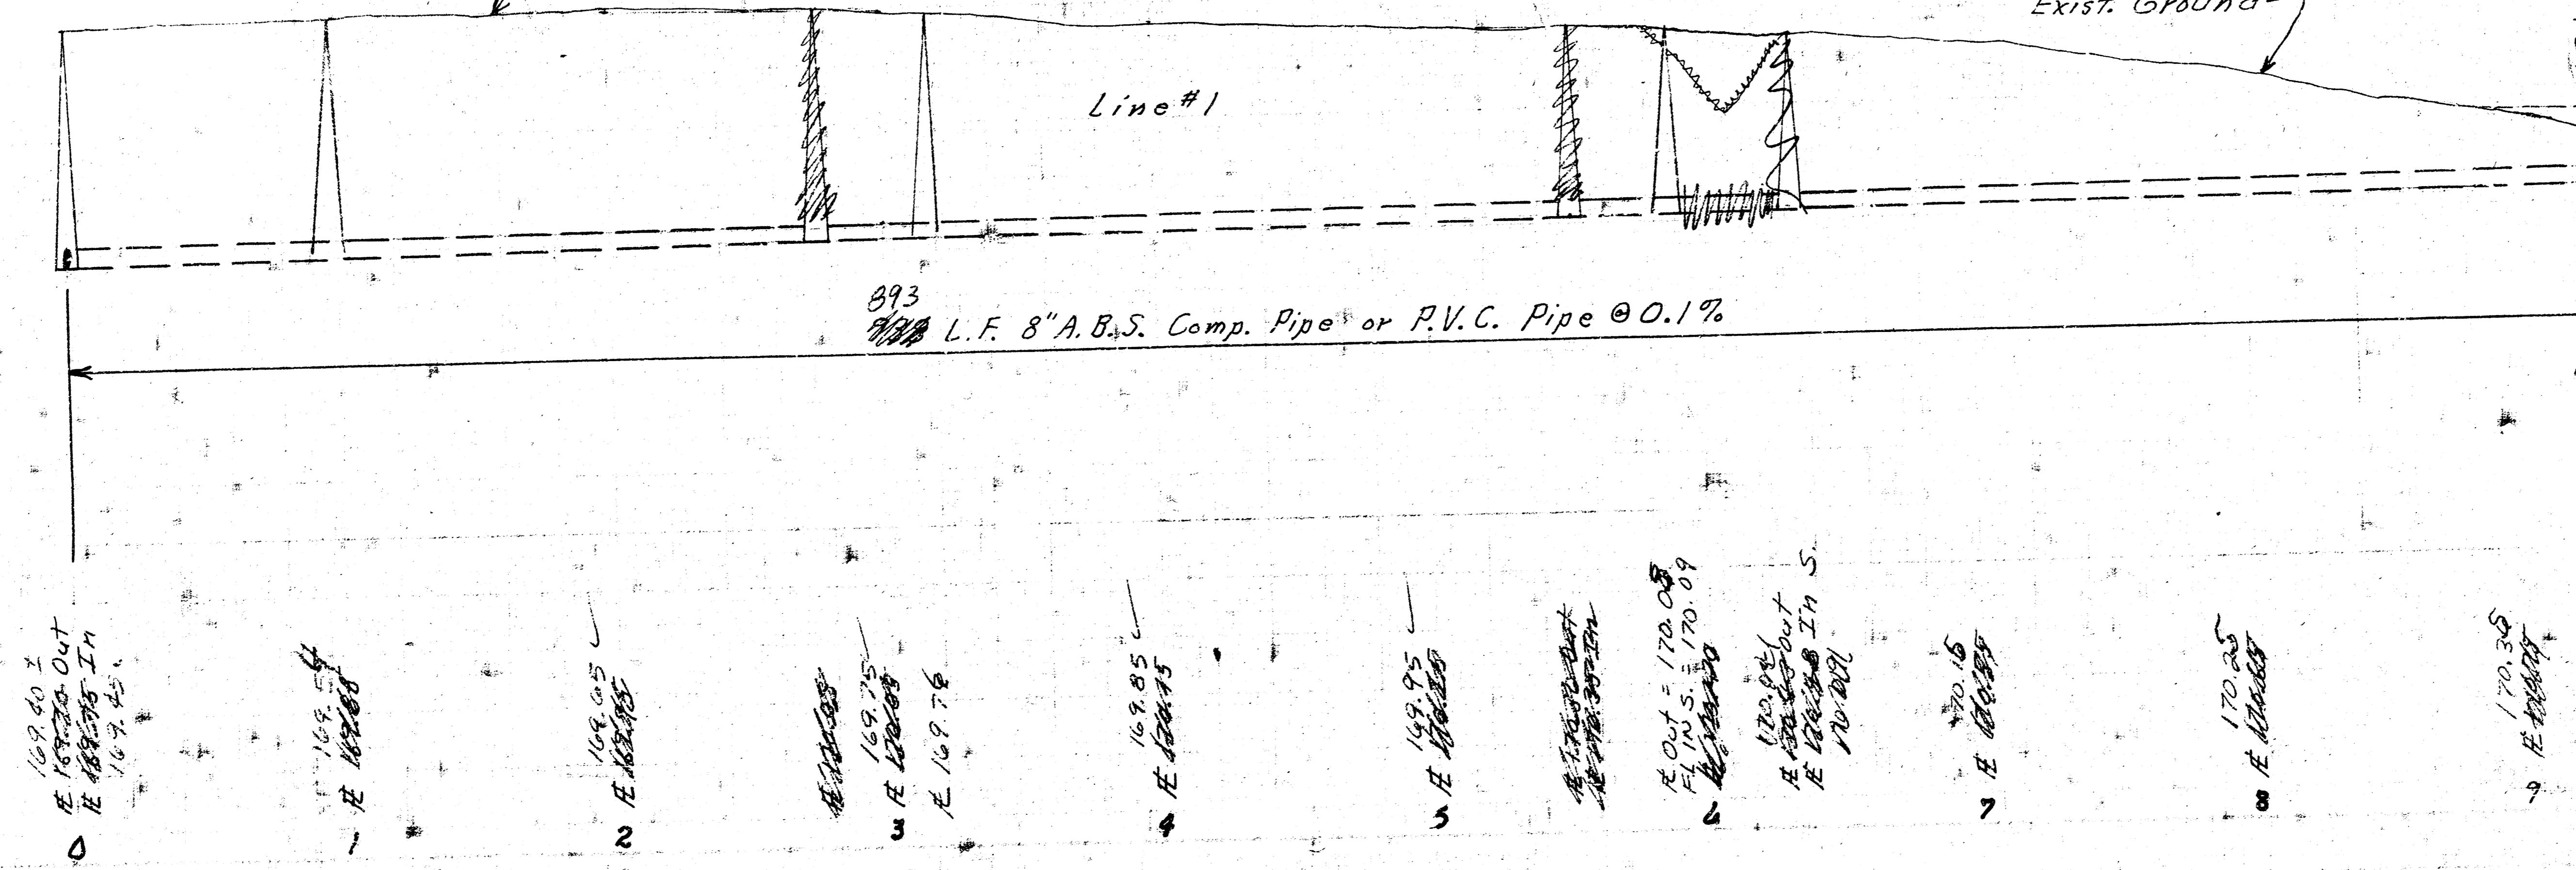


SCALE
 PLAN 1" = 40'
 PROFILE 1" = 40'
 VERT. 1" = 5'

Note:
 Location Map on Sheet 2

Sta. 9+78 Const. Type
 A M.H. Install 6" Stub
 E.S.E.

Comp. fill to 30" above top
 of pipe.


As Built
 J.S.
 9/81

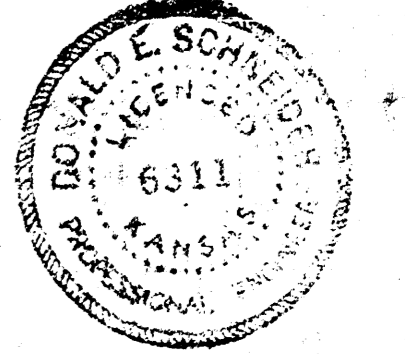

Rev. 12-25-80

Lateral 61, WAR INDUSTRIES SEWER
 Proj. No.: 468-76-245-80543-000-0001001
 CITY OF WICHITA, KANSAS
 Date _____ Sheet 1 of _____

UNION
TOWN

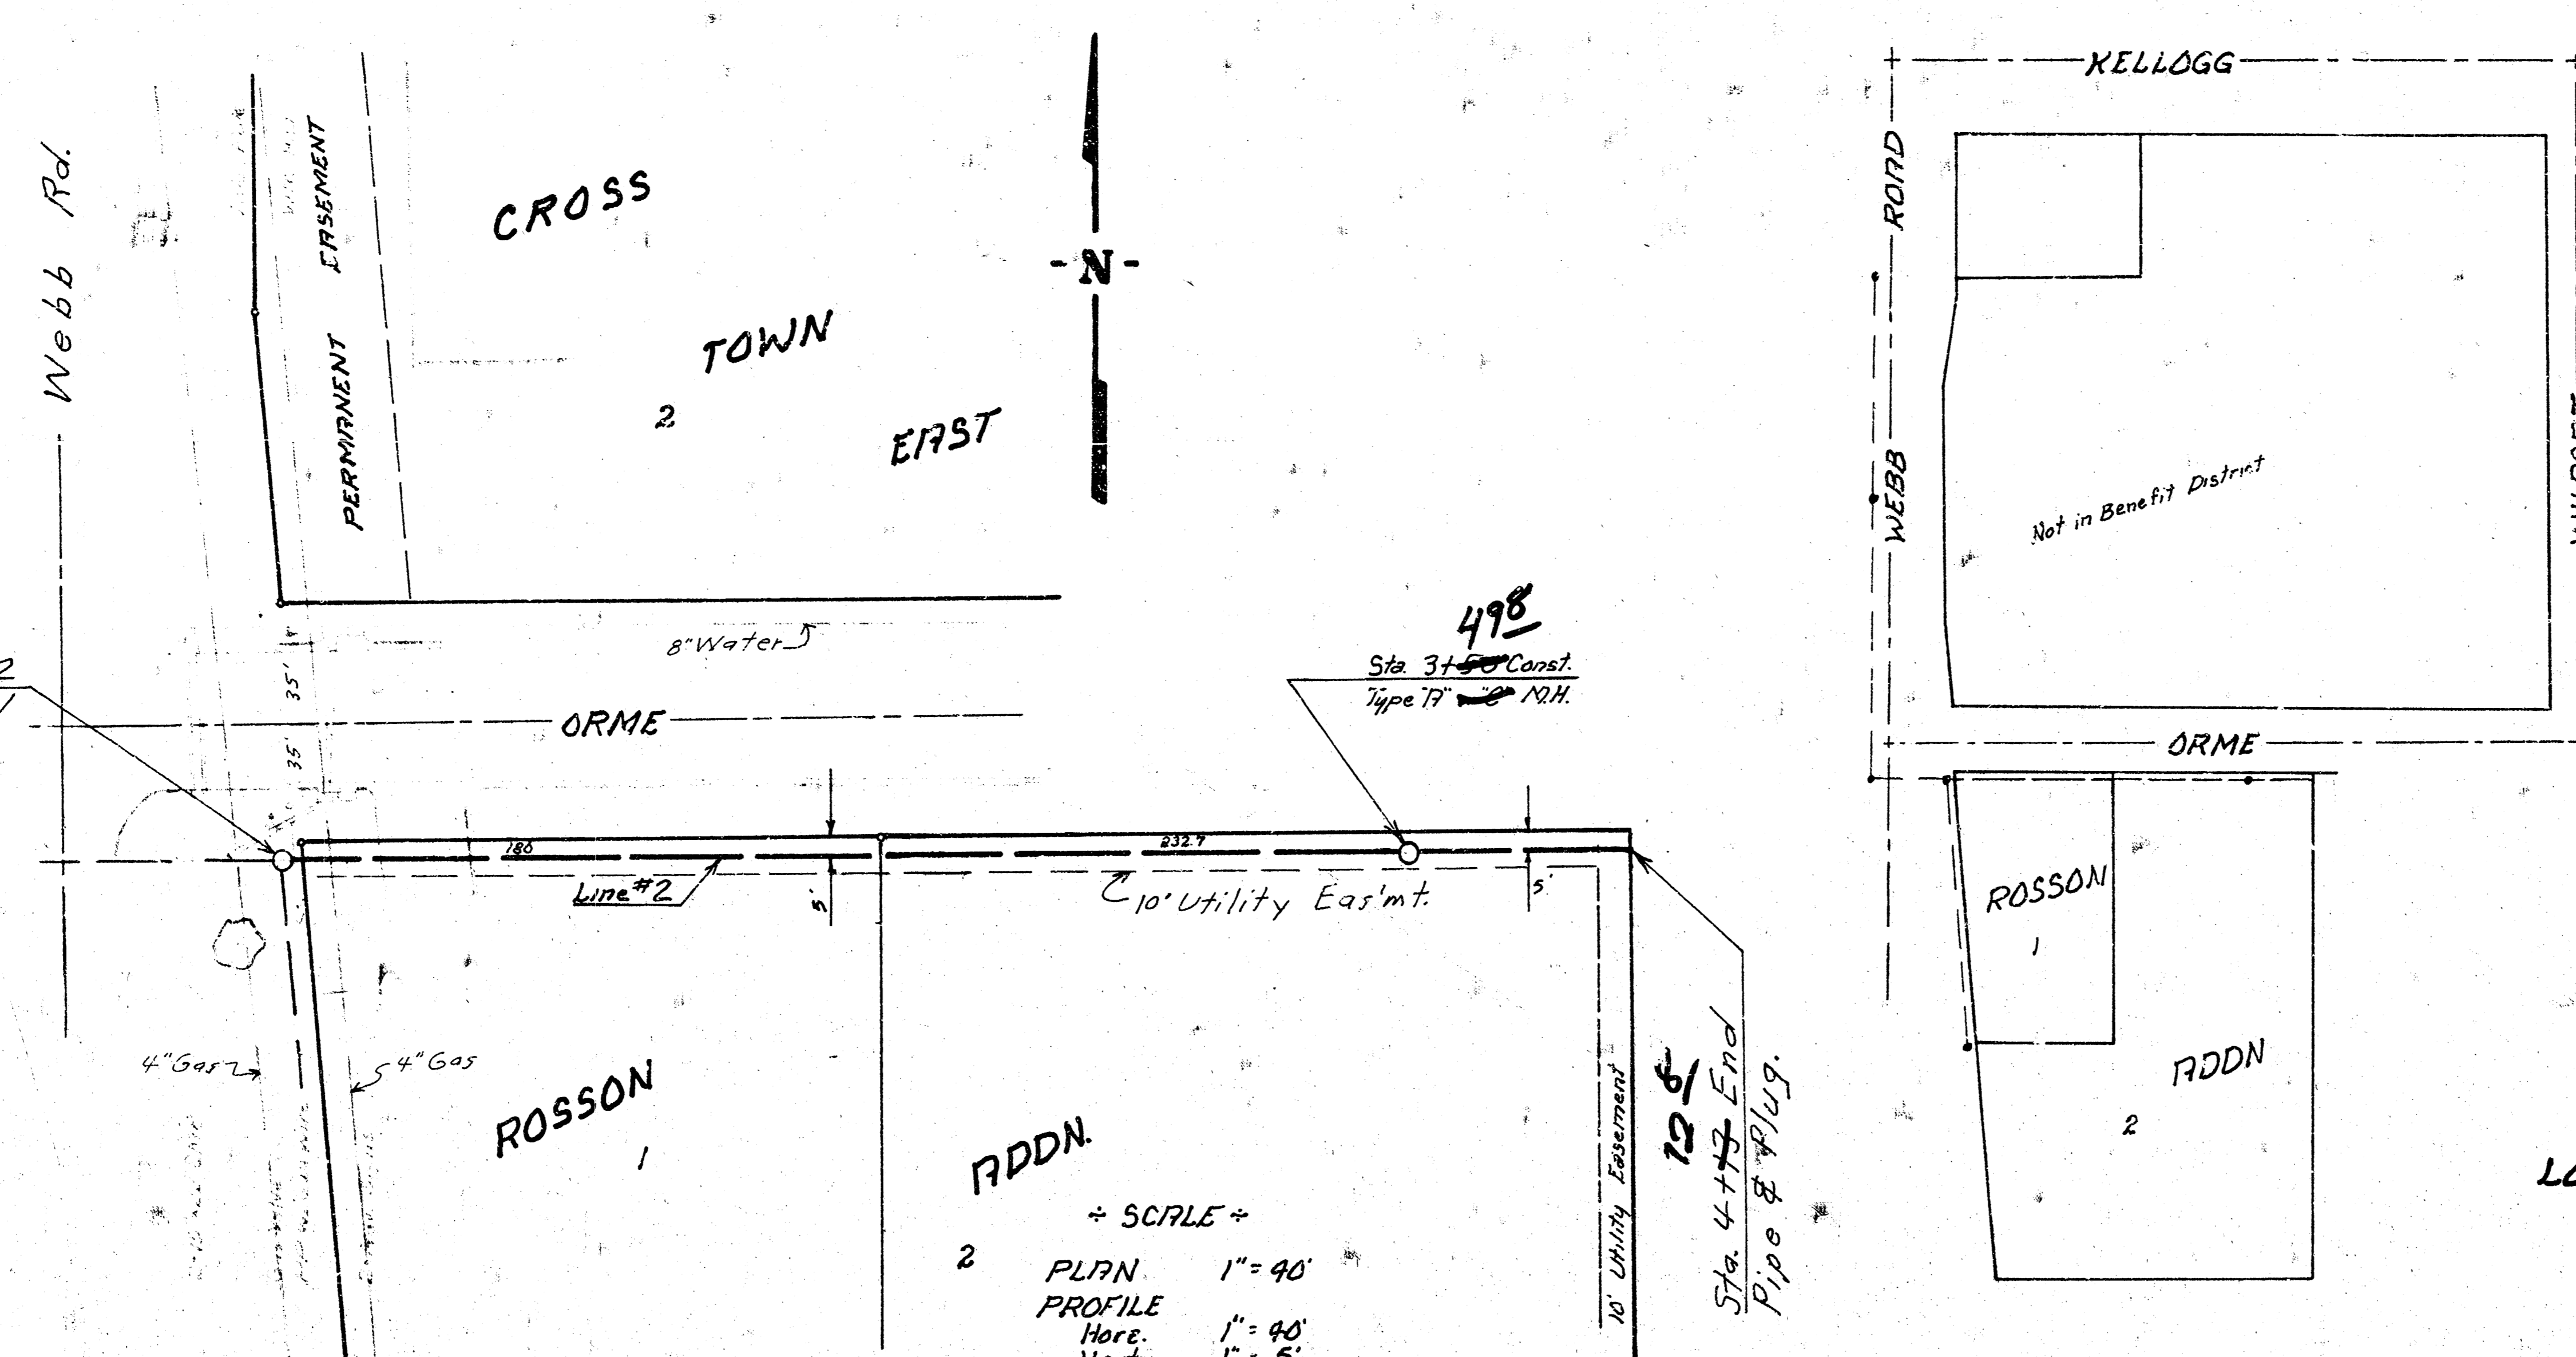


SCALE 1" = 100'

SCALE
PLAN 1" = 40'
PROFILE Hor. 1" = 40'
Vert. 1" = 5'

LOCATION MAP

As Built
9/81

180
175
170
165
160

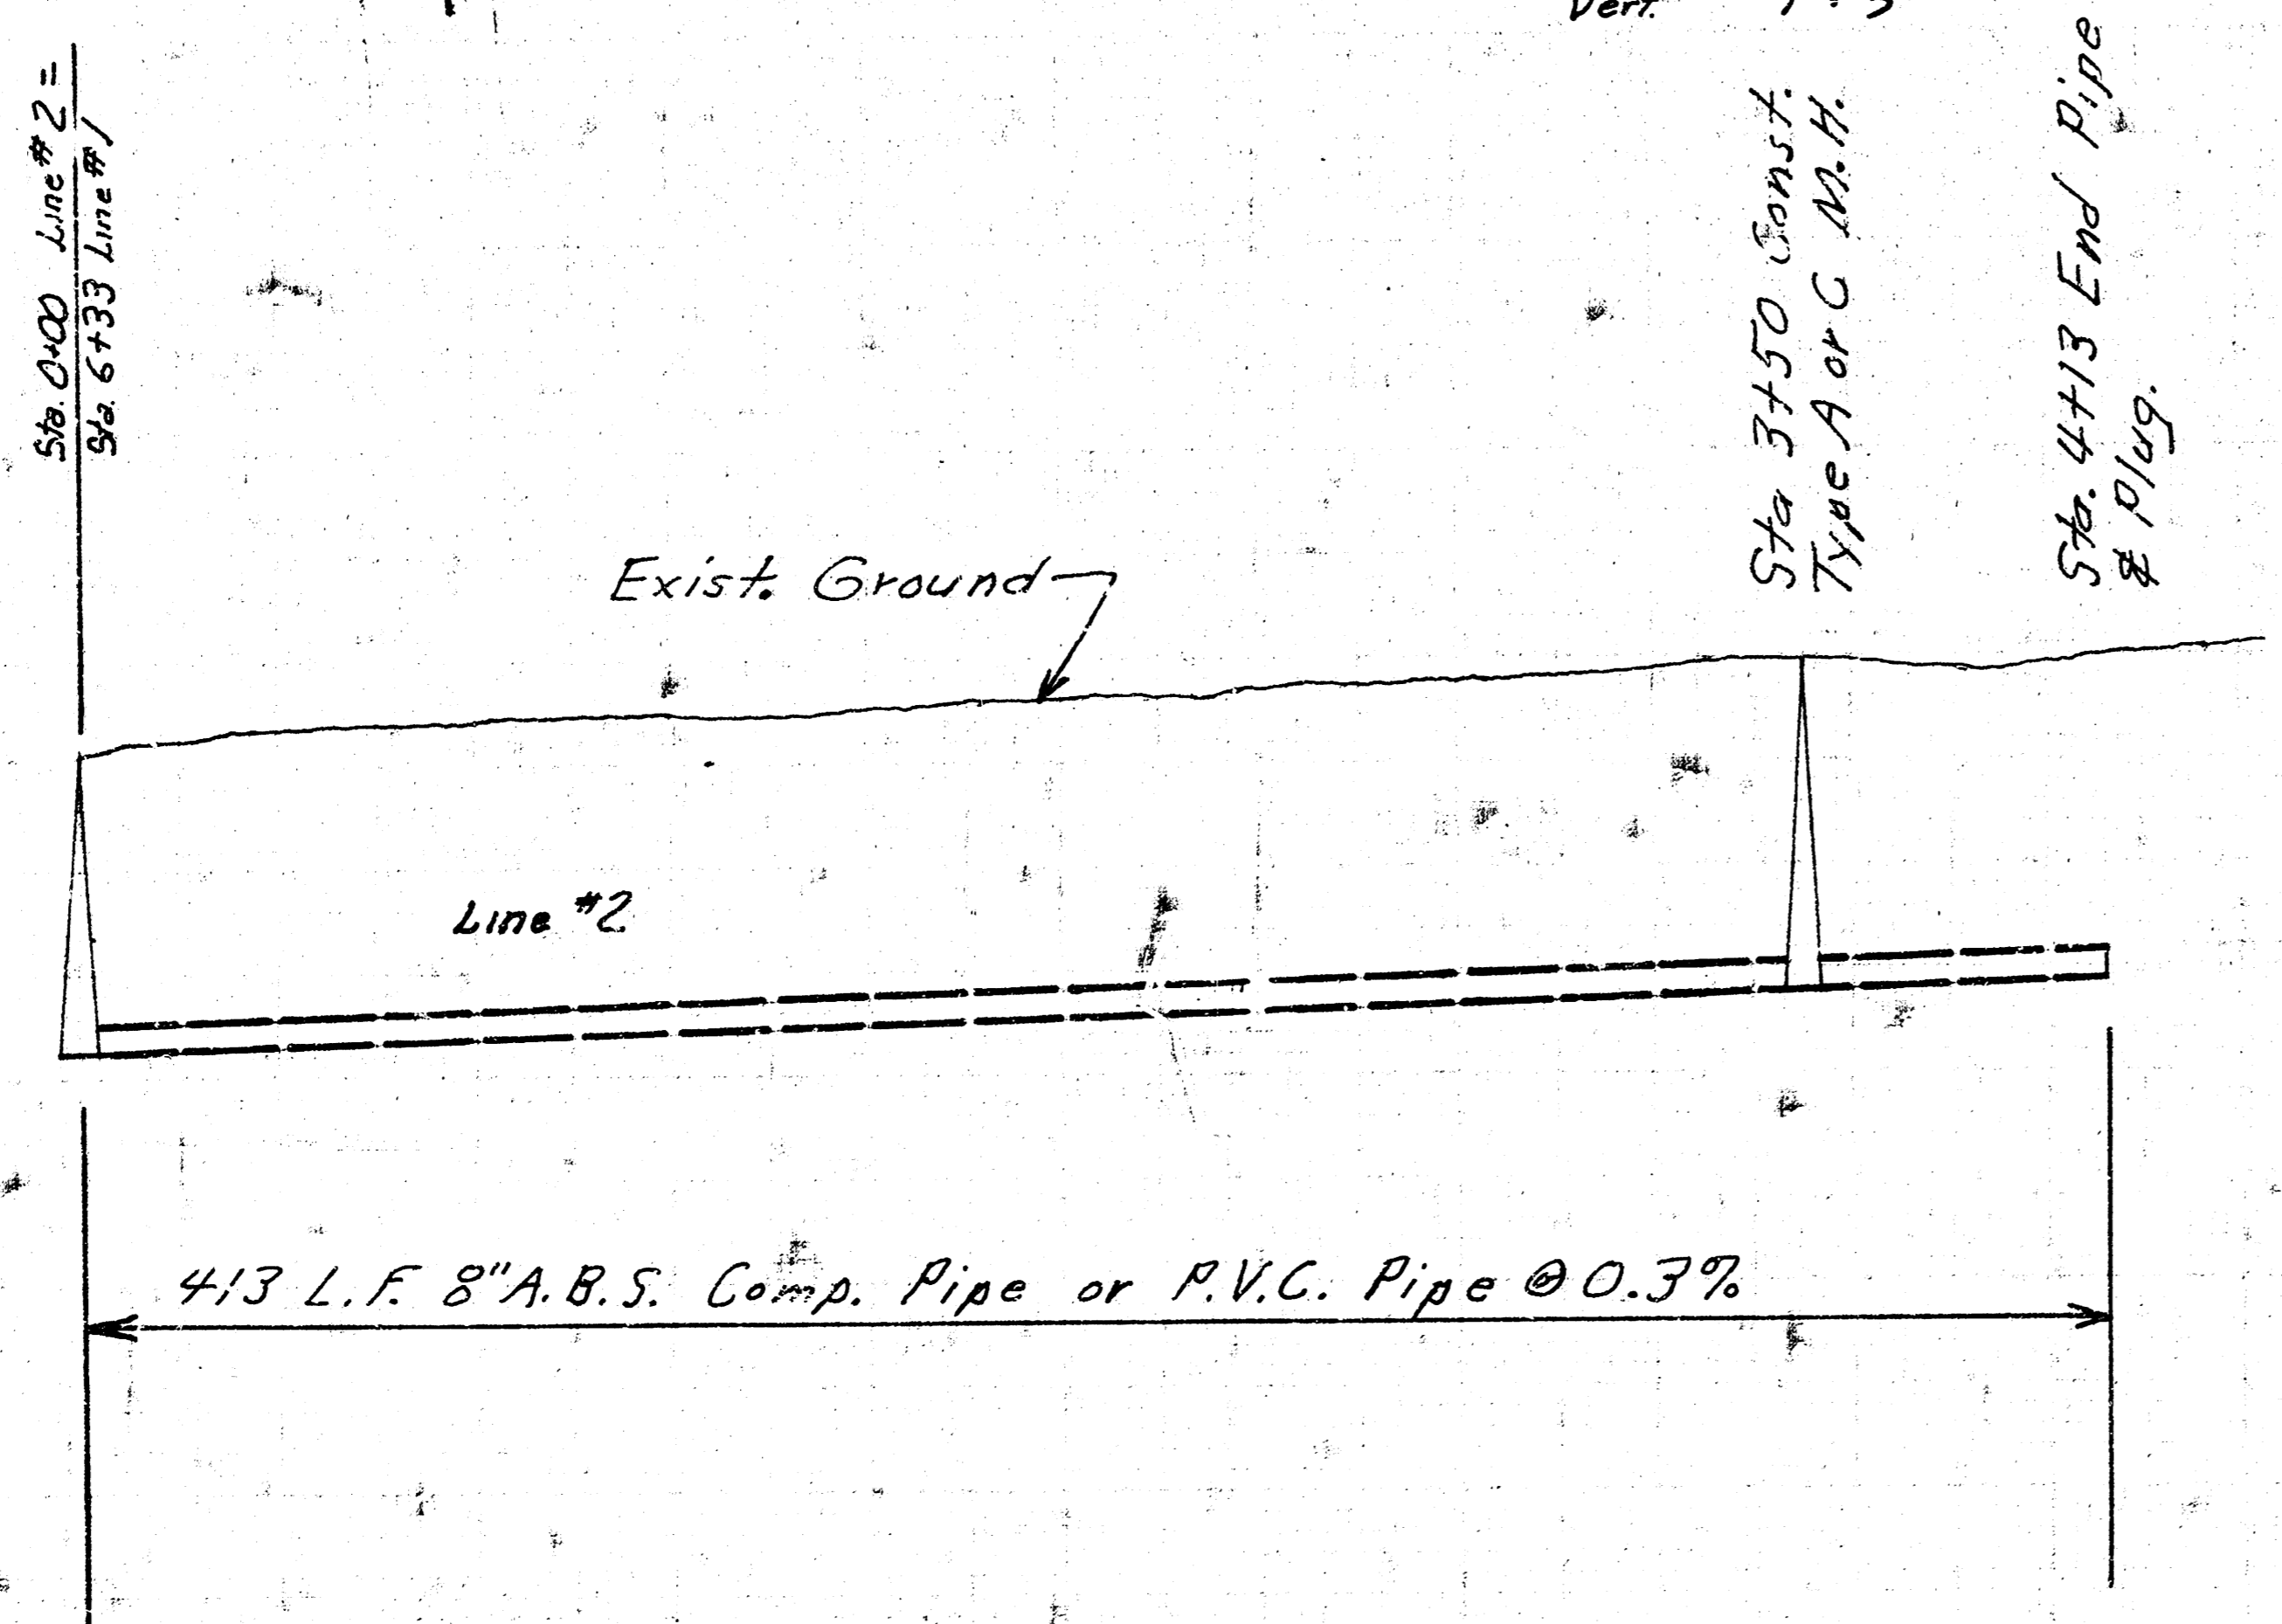

170.04
170.04
170.14

170.44
170.44

170.74
170.74

171.04
171.04

171.19
171.19

171.38
171.38

171.58
171.58