


LATERAL 73, WAR INDUSTRIES SEWER

Project no. 468-76-245-81168-000-000-001

CITY OF WICHITA, KANSAS
MIKE E. LINDEBAK CITY ENGINEER

As Built
J.L.
8-84


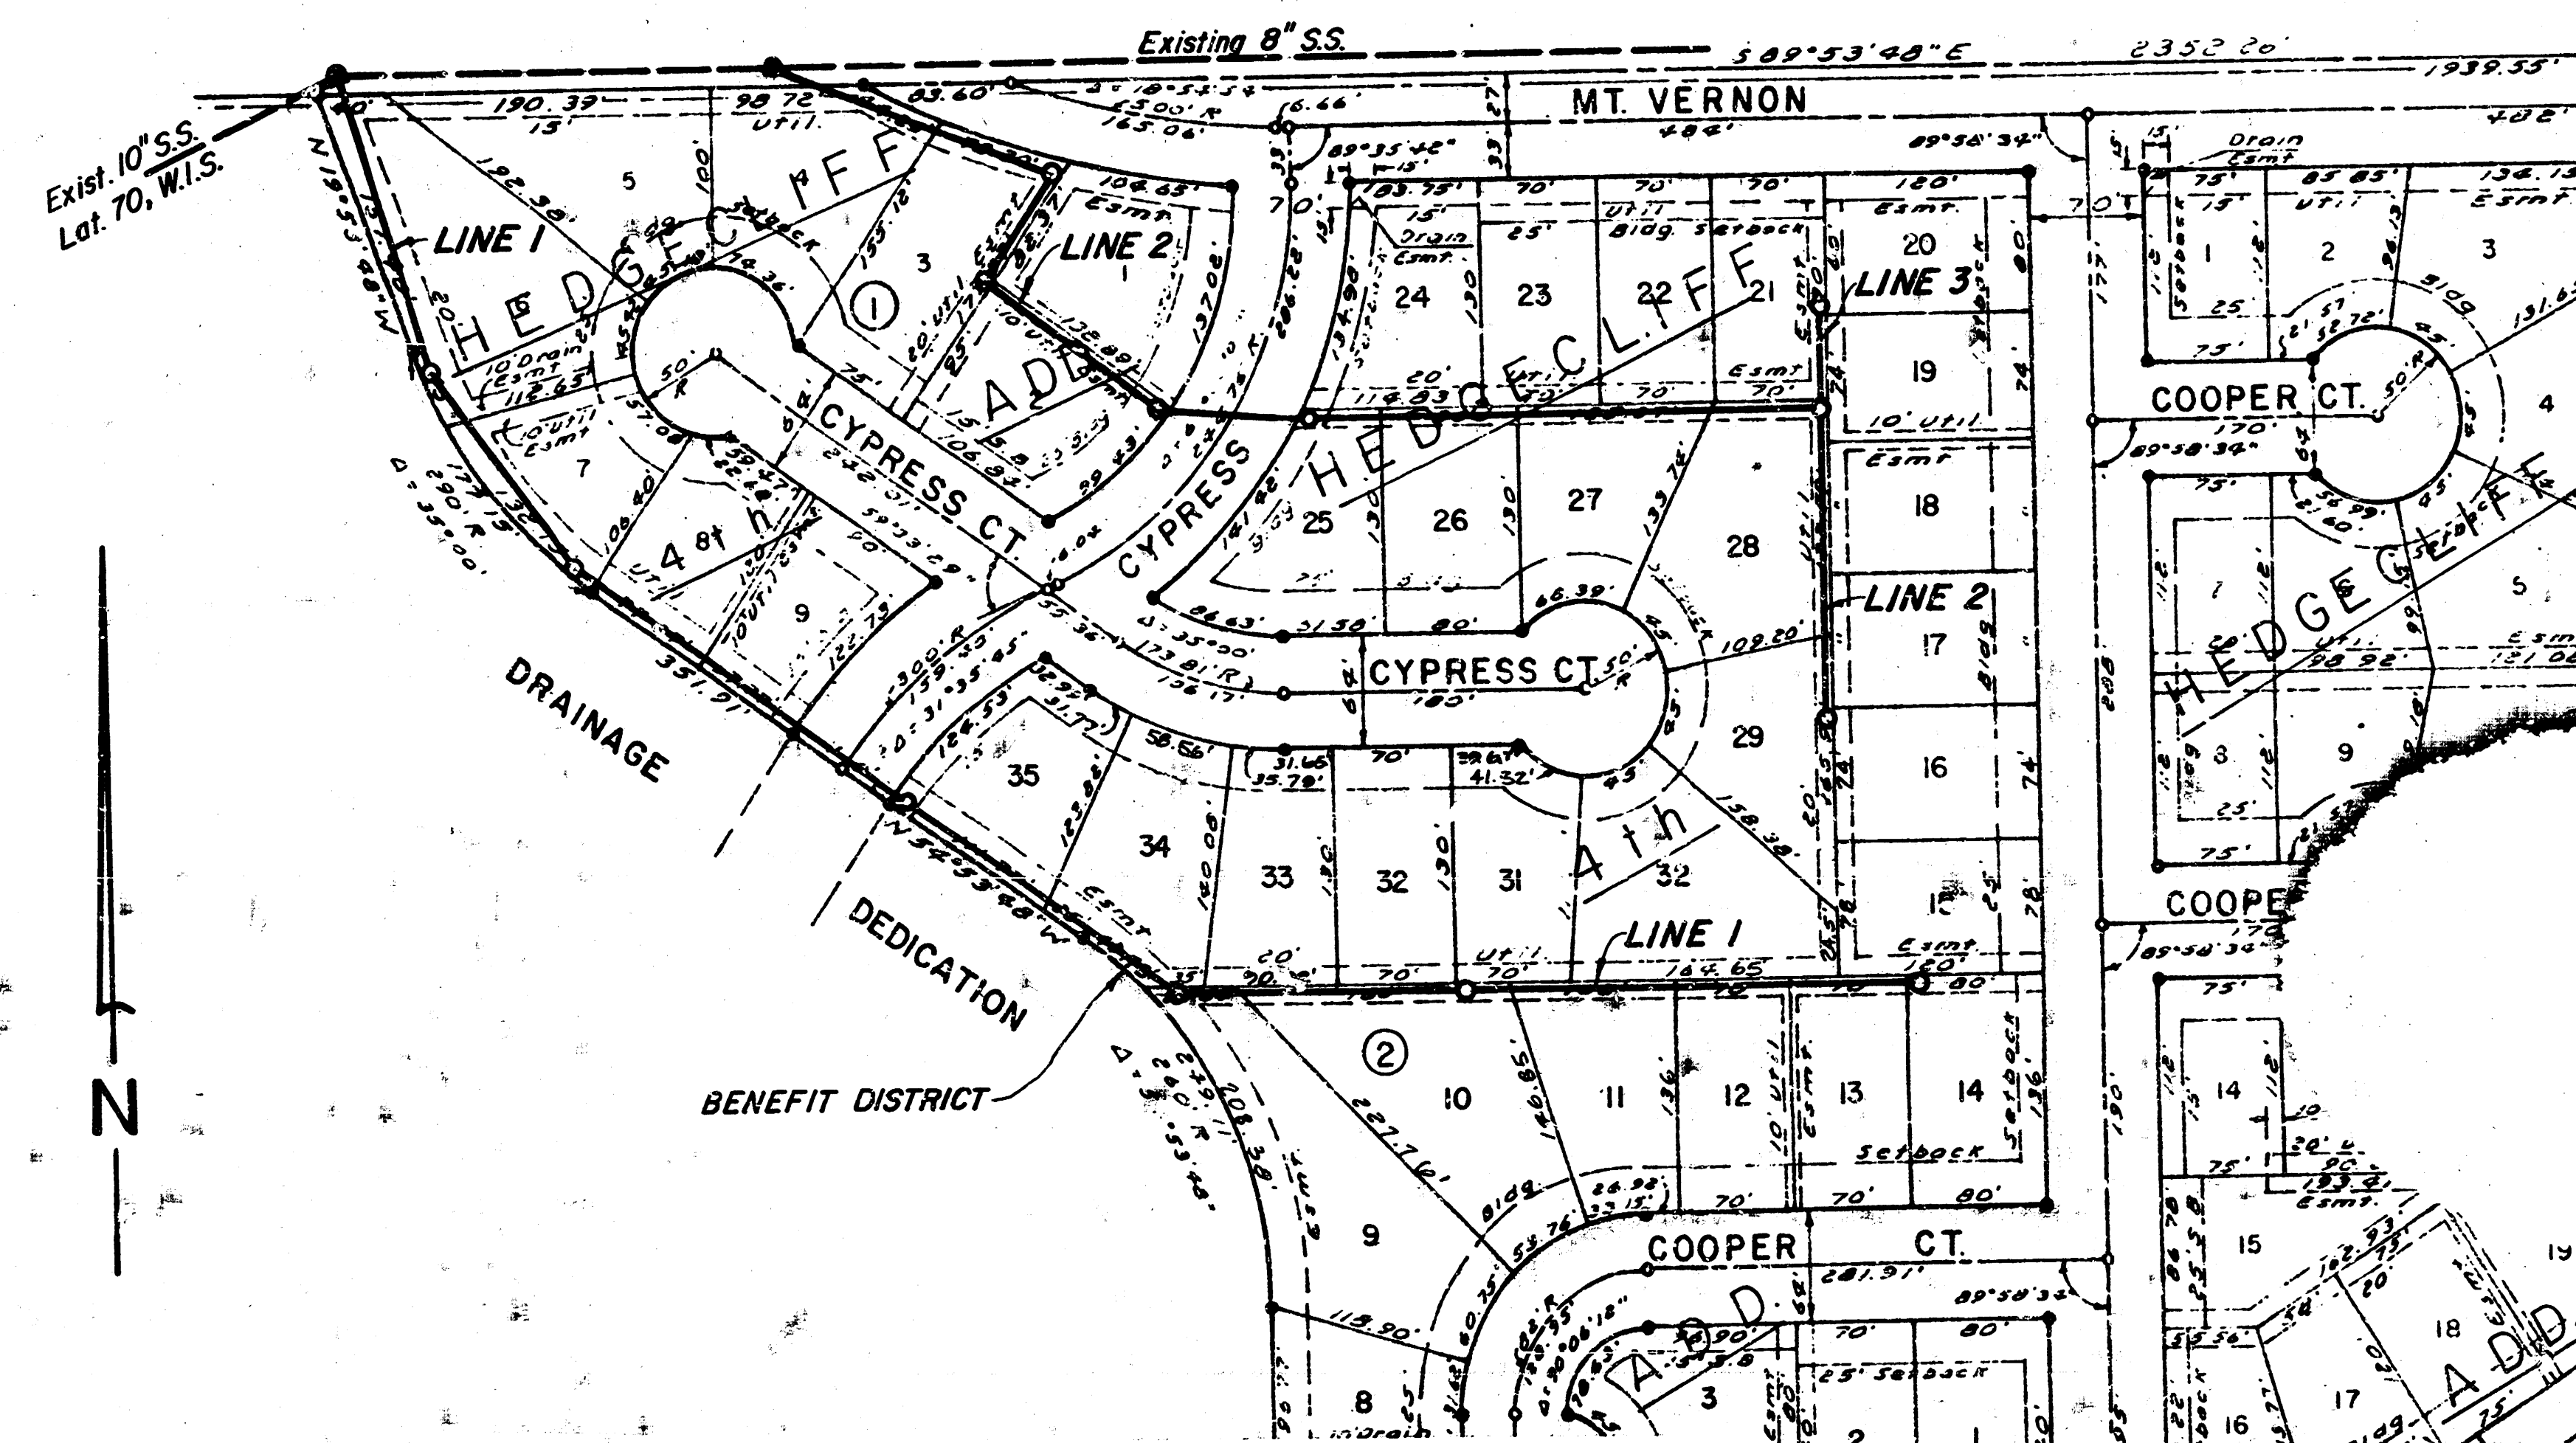


NOTE: AREA SERVED BY THIS SEWER IS PRESENTLY PLATTED AS HEDGECLIFF 3RD ADDITION AND IS IN THE PROCESS OF BEING PLATTED INTO HEDGECLIFF 4TH ADDITION.



BAUGHMAN COMPANY, P.A.
SURVEYING & ENGINEERING
314/262-7221 • 330 LAURA • WICHITA, KANSAS 67211

FILMED FROM THE BEST
AVAILABLE COPY

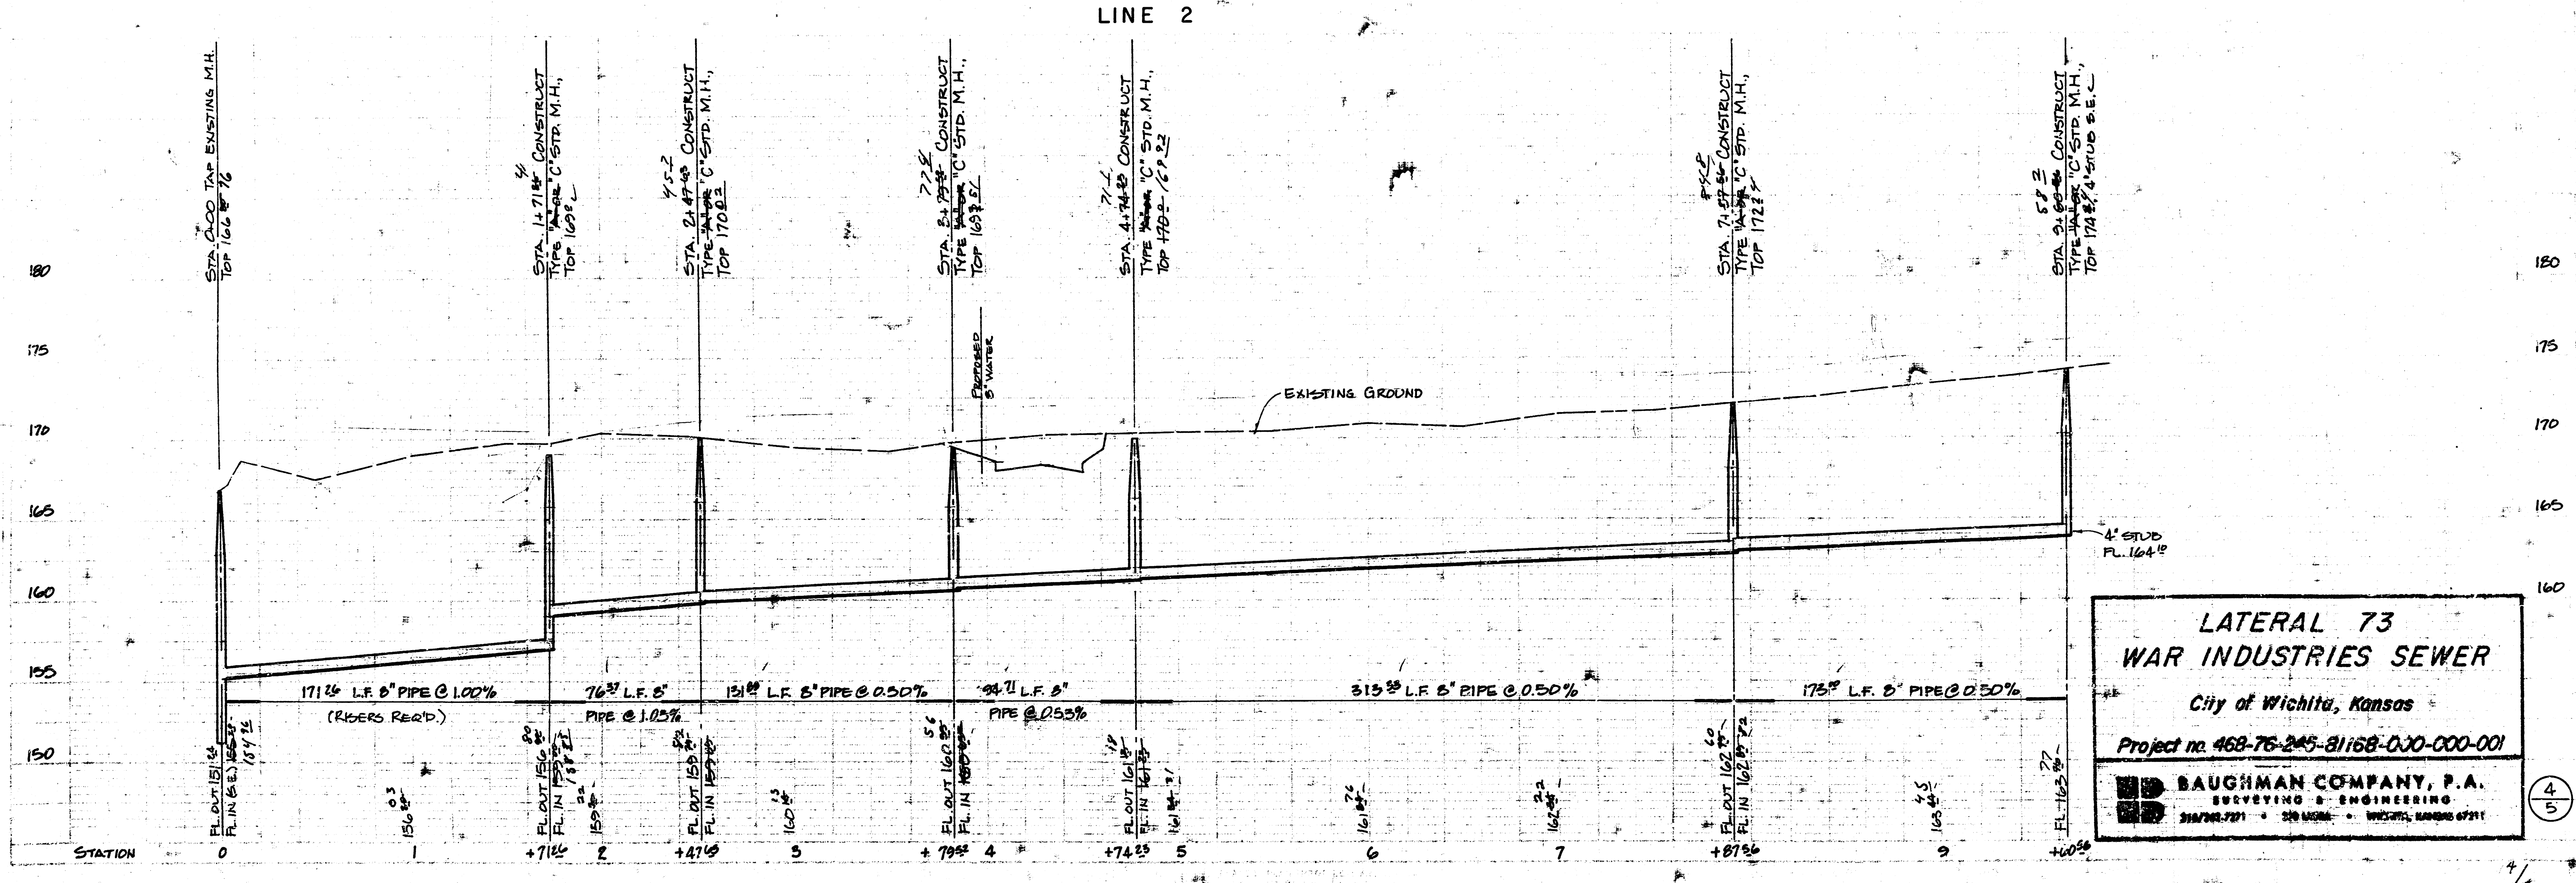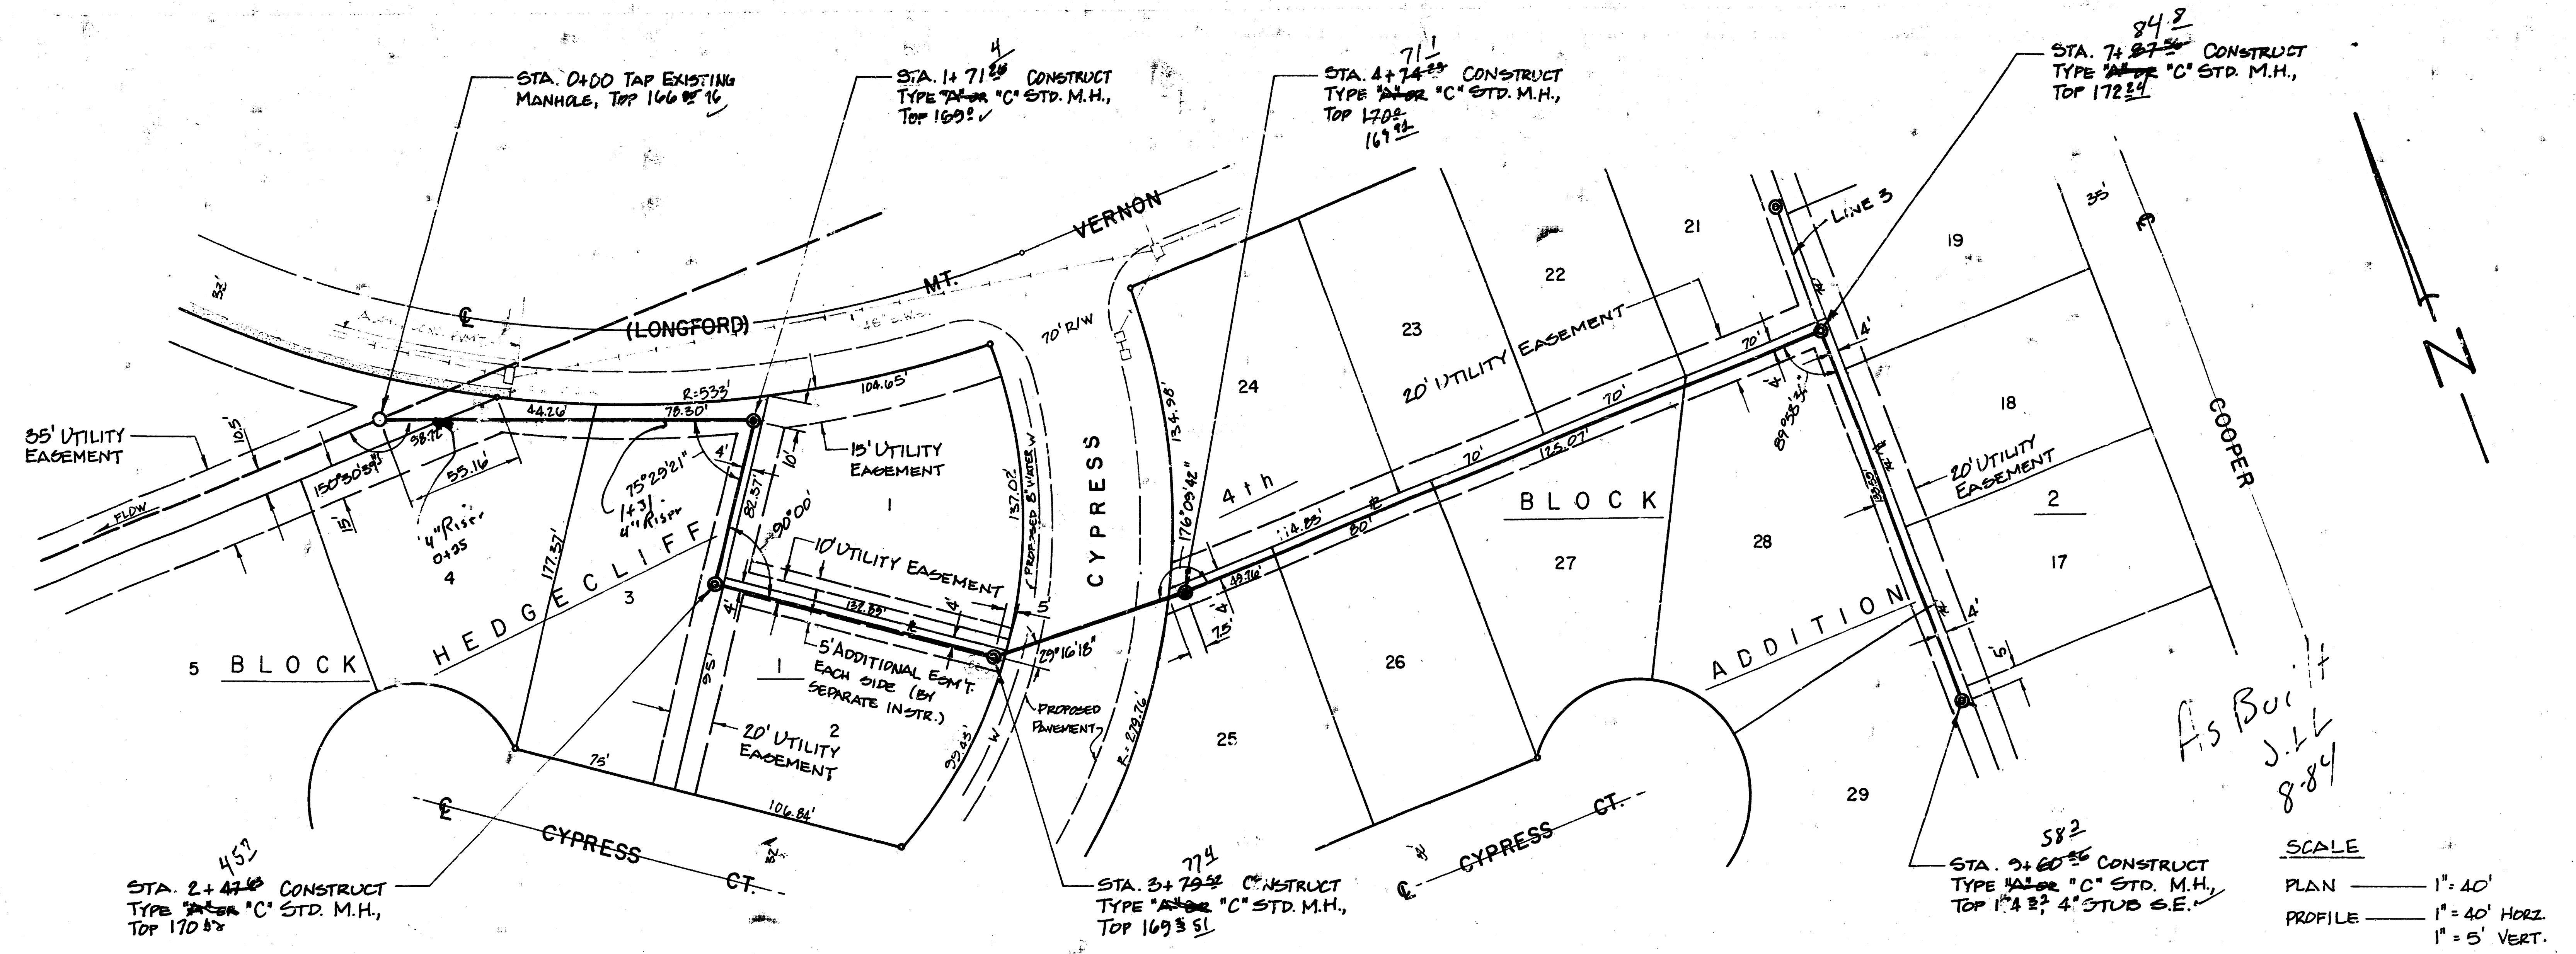

**LATERAL 73
WAR INDUSTRIES SEWER**
City of Wichita, Kansas
Project no. 468-76-245-81168-000-001

BAUGHMAN COMPANY, P.A.
SURVEYING & ENGINEERING
2107 W. 21ST ST. • WICHITA, KANSAS 67211

CITY OF WICHITA, KANSAS



NOTE:
TOP OF 4" OR 6" RISER PIPE TO BE
EXTENDED TO AN ELEVATION OF 1 ft.
MINIMUM ABOVE THE WATER TABLE
ELEVATION, WHEN WATER EXISTS,
OR TO AN ELEVATION SUITABLE FOR
PROVIDING SERVICE TO THE LOT TO
BE SERVED AND THEN FLUGGED.

STAKED TO
SUPPORT PIPE

TAMP BACKFILL
AROUND PIPE

UNDISTURBED
EARTH

NOTCH OUT SIDE OF
TRENCH FOR PIPE

[illegible]

FOURTEEN PERCENT SHALL BE PAID FOR ALL "FIT" PRICES BID FOR "PIPE" AND REINFORCED CONCRETE ENCASING FOR THE VARIOUS MAIN SEWER PIPE SIZES INDICATED WHICH PRICE SHALL INCLUDE ALL COSTS FOR COMPLETE TIE OF THIS TIE INCLUDING SAMPLING, HEADS, CONCRETE, REINFORCING STEEL, CAPS OR TIES, AND ALL OTHER NECESSARY MATERIALS OR WORK. CONCRETE ENCASING OF THE RISER PIPE OF THE TIE AT THE SEND AS SHOWN ON THE DRAWINGS WILL NOT BE PAID AS SUCH TIE AND JOINTS FOR THIS WORK SHALL BE CONSIDERED AS A STANDARD OF THE OTHER TIE WORK.

THE PROJECT INSPECTOR SHALL REPORT ON INSPECTION CARDS THE LOCATION OF ALL RISERS CONSTRUCTED AS MEASURED FROM THE SQUARES' MANHOLE. THE DIRECTION OF SERVICE, THE ELEVATION OF THE TOP OF THE RISER, AND THE PAY QUANTITIES INVOLVED. THE PROJECT INSPECTOR SHALL ALSO REPORT ON INSPECTION CARDS THE LOCATION, DIRECTION OF SERVICE, AND SIZE OF ALL STUBS INSTALLED IN MANHOLES.

LATERAL 73
WAR INDUSTRIES SEWER
City of Wichita, Kansas
Project no. 468-76-245-81158-000-000-001

BAUGHMAN COMPANY, P.A.
S. TRYING & ENGINEERING
314/362-7271 • 530 LAURA • WICHITA, KANSAS 67211

**FILMED FROM THE BEST
AVAILABLE COPY.....**