



Plan Scale 1"=40'  
 Profile Scale Horz. 1"=40'  
 Vert. 1"=4'

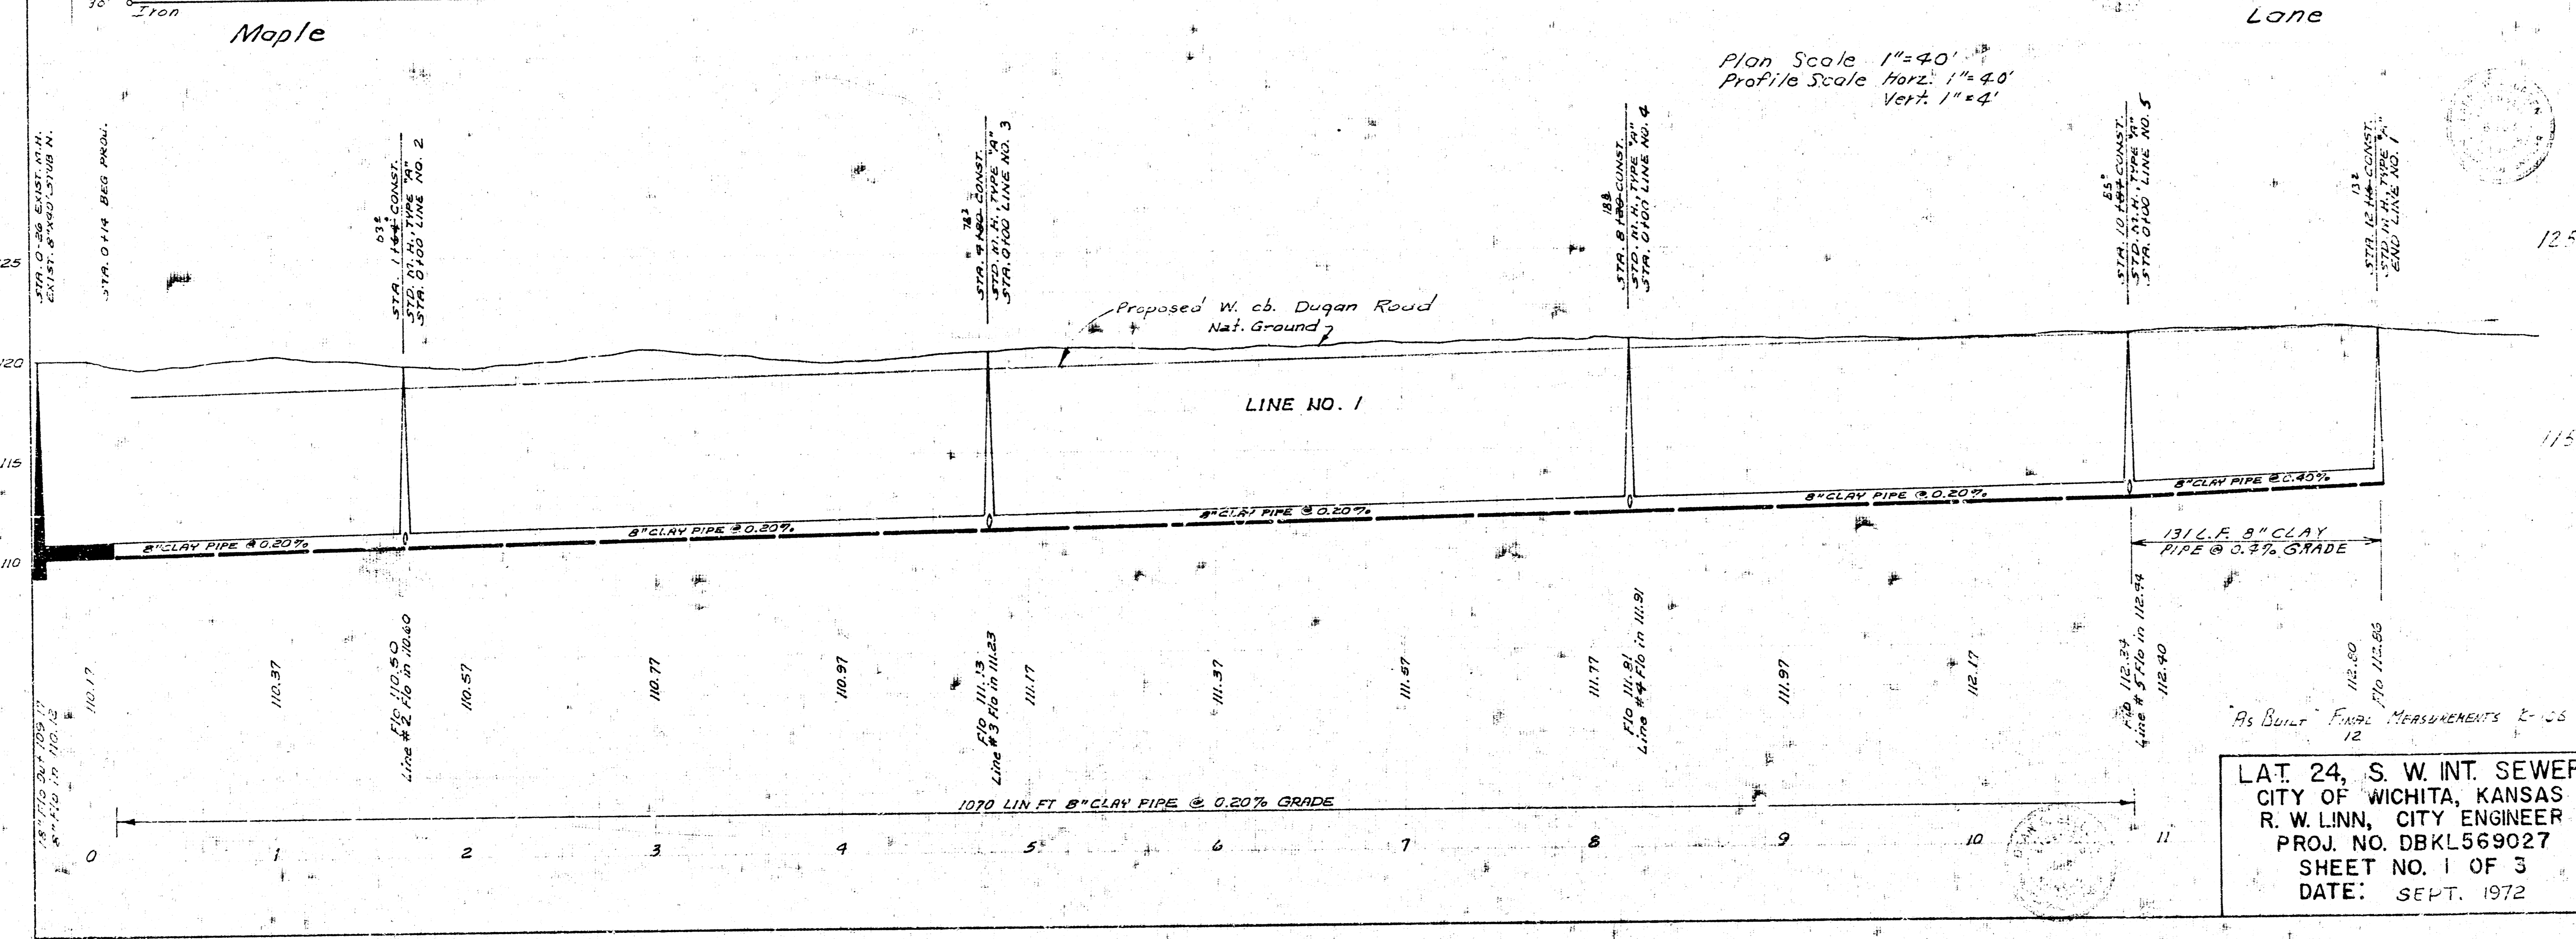

As Built Final Measurements 2-103  
 12  
**LAT. 24, S. W. INT. SEWER**  
 CITY OF WICHITA, KANSAS  
 R. W. LINN, CITY ENGINEER  
 PROJ. NO. DBKL569027  
 SHEET NO. 1 OF 3  
 DATE: SEPT. 1972

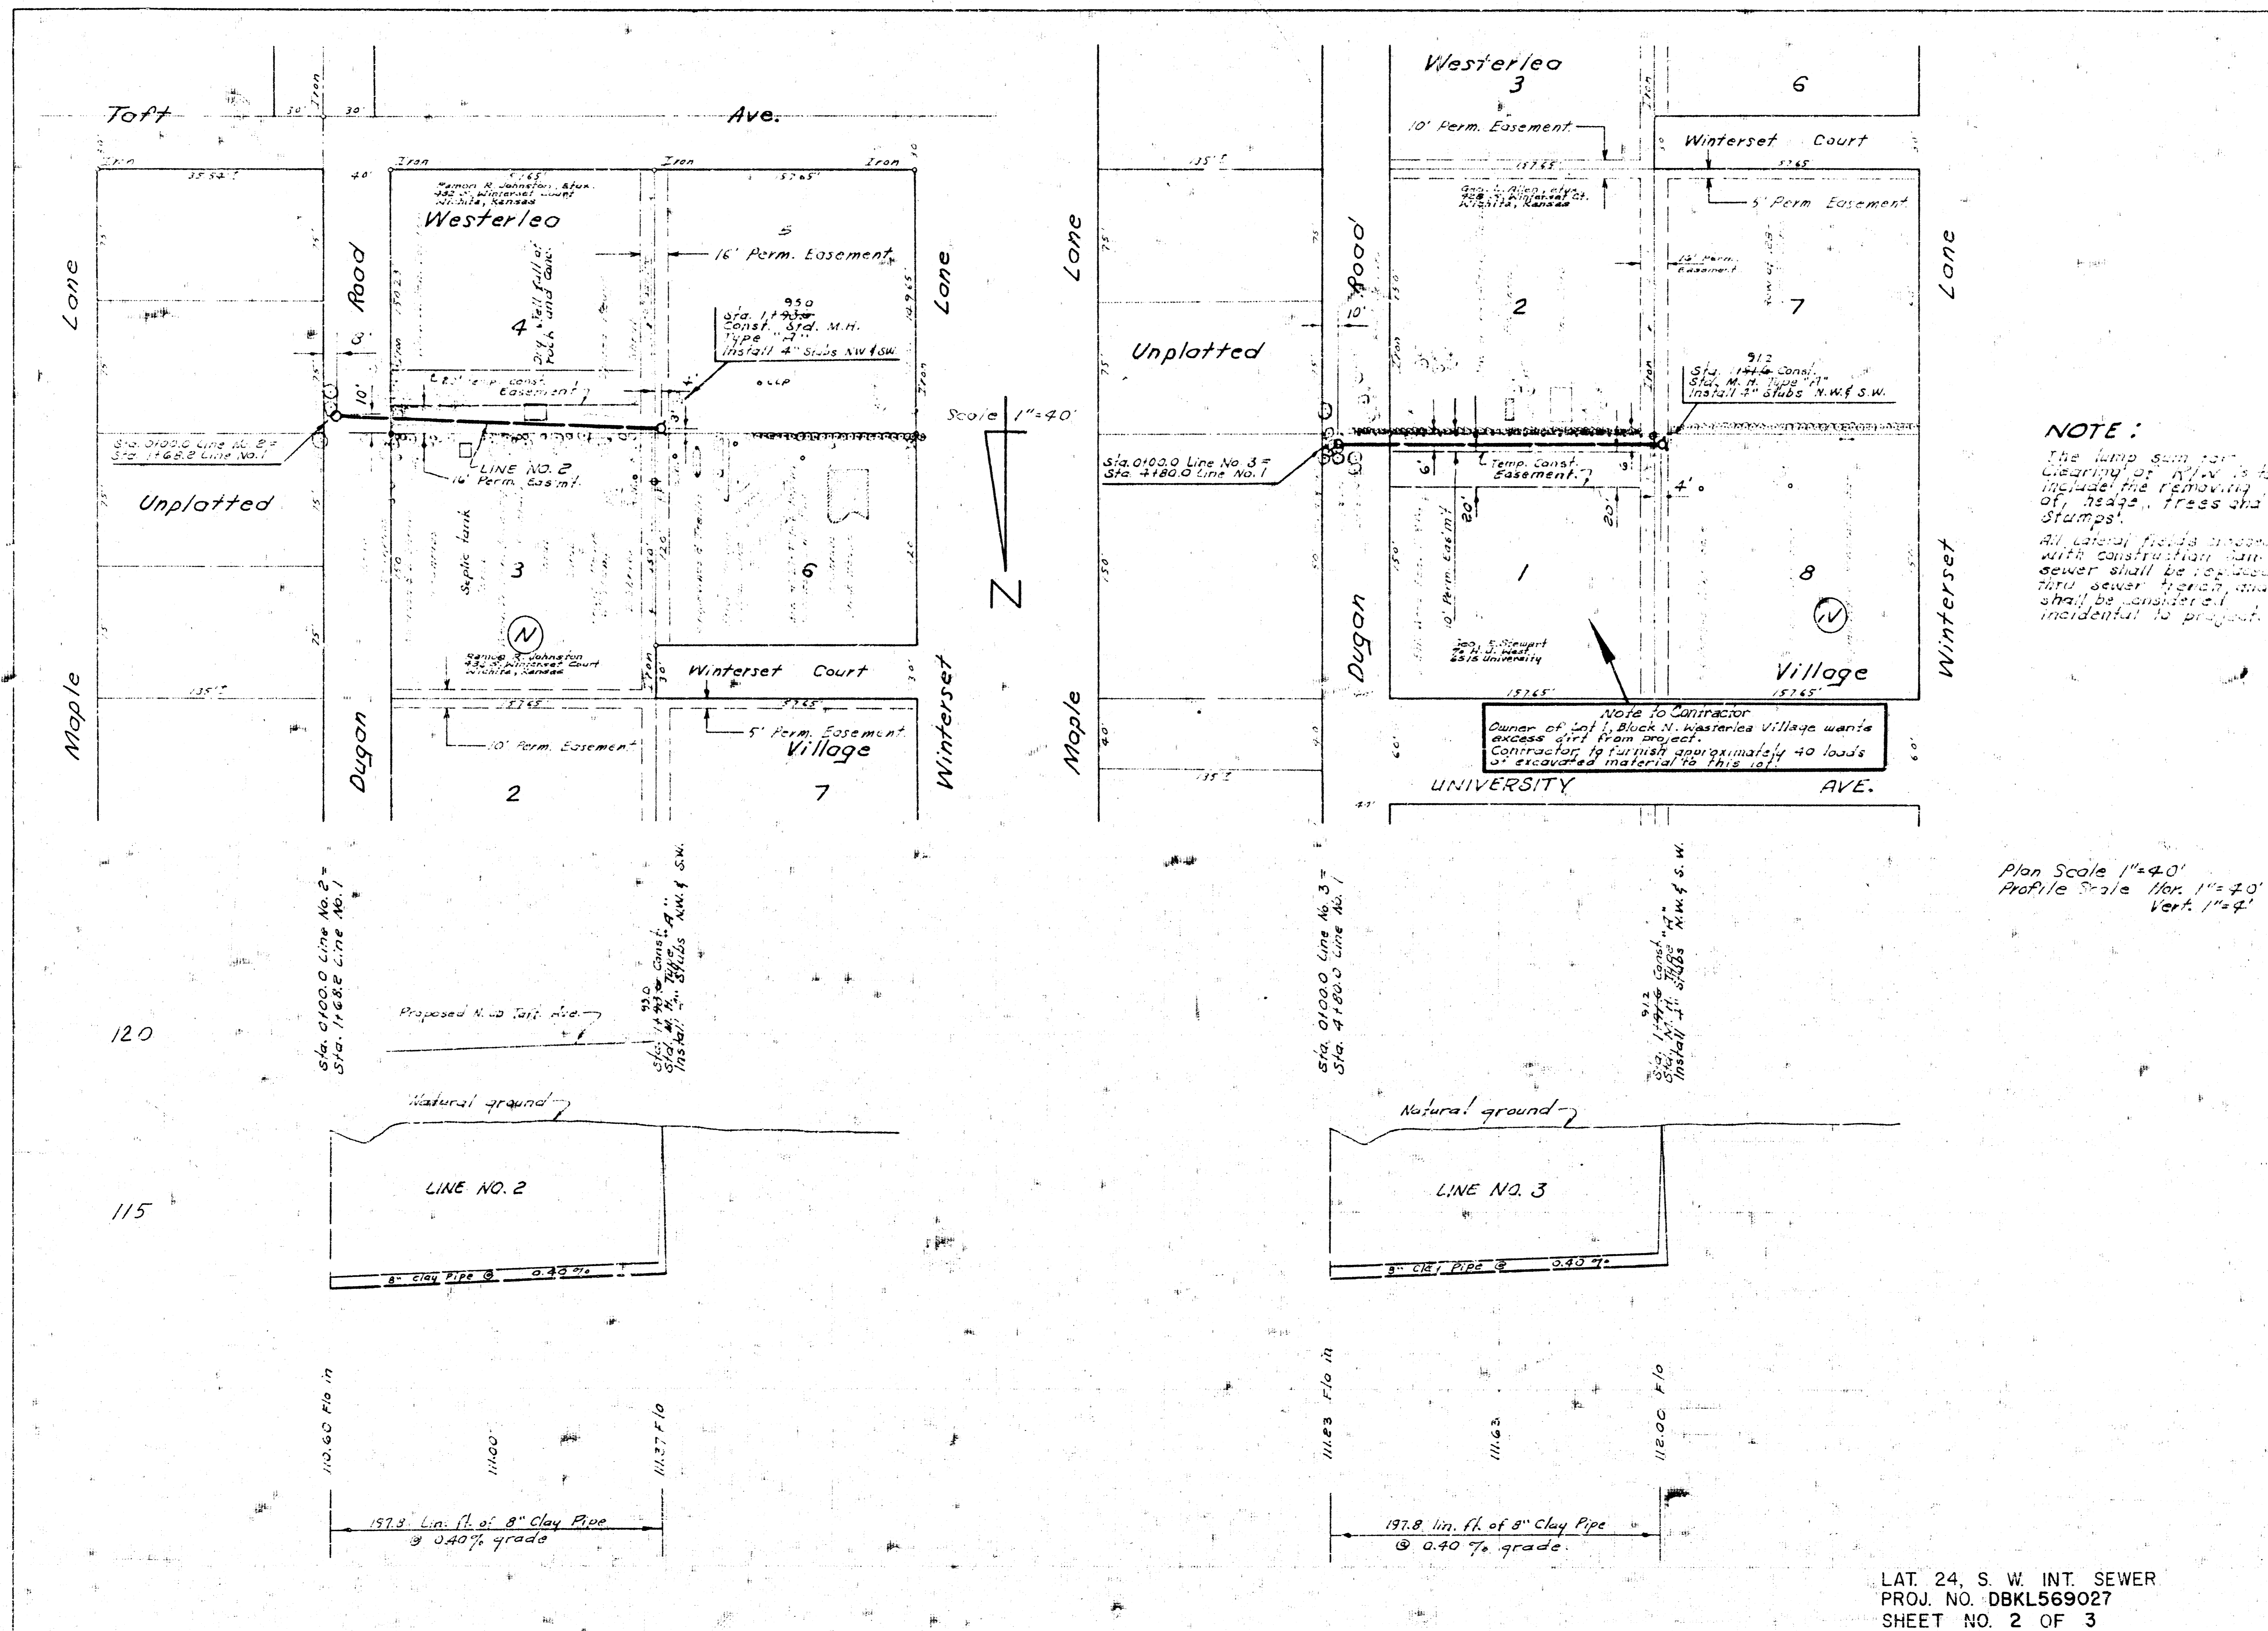

**NOTE:**  
 The lump sum for clearing of N.V. is to include the removing of logs, trees and stumps.  
 All lateral fields around with construction for sewer shall be located into sewer trench and shall be considered incidental to project.

**Note to Contractor**  
 Owner of lot 1, Block N, Westeria Village wants excess dirt from project. Contractor to furnish approximately 40 loads of excavated material to this lot.

Plan Scale 1"=40'  
 Profile Scale Hor. 1"=40'  
 Vert. 1"=4'

