



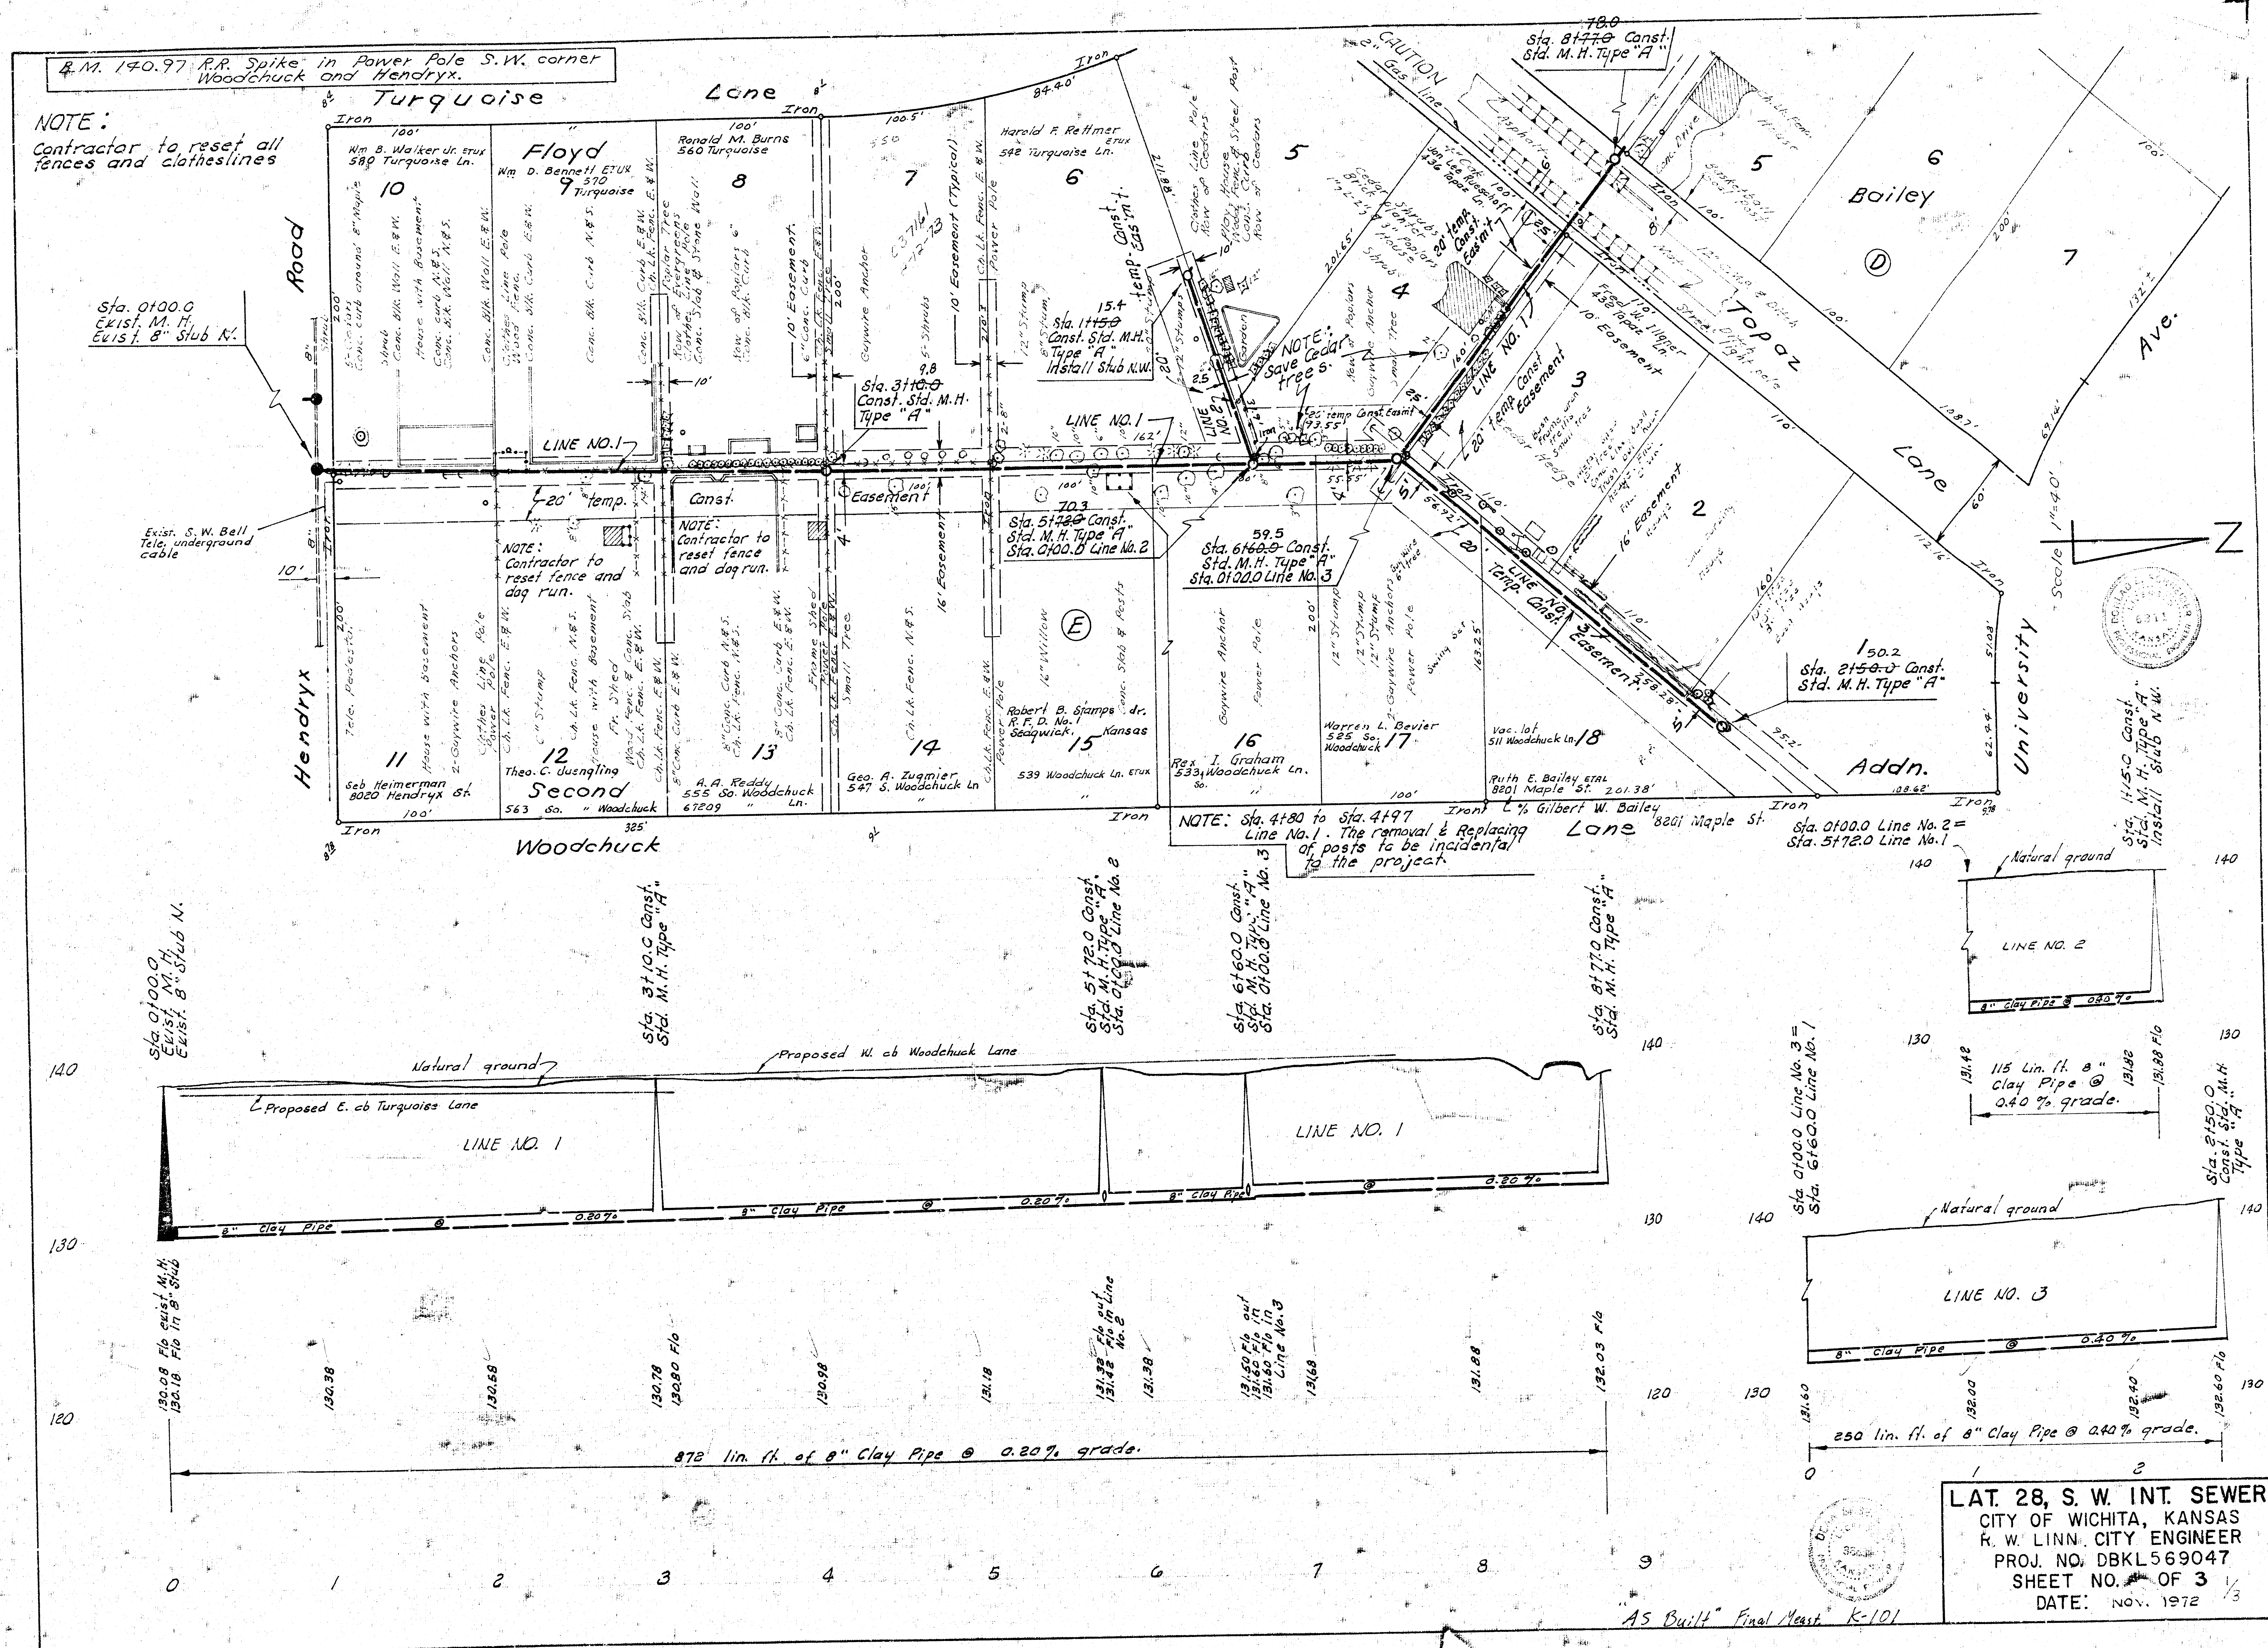

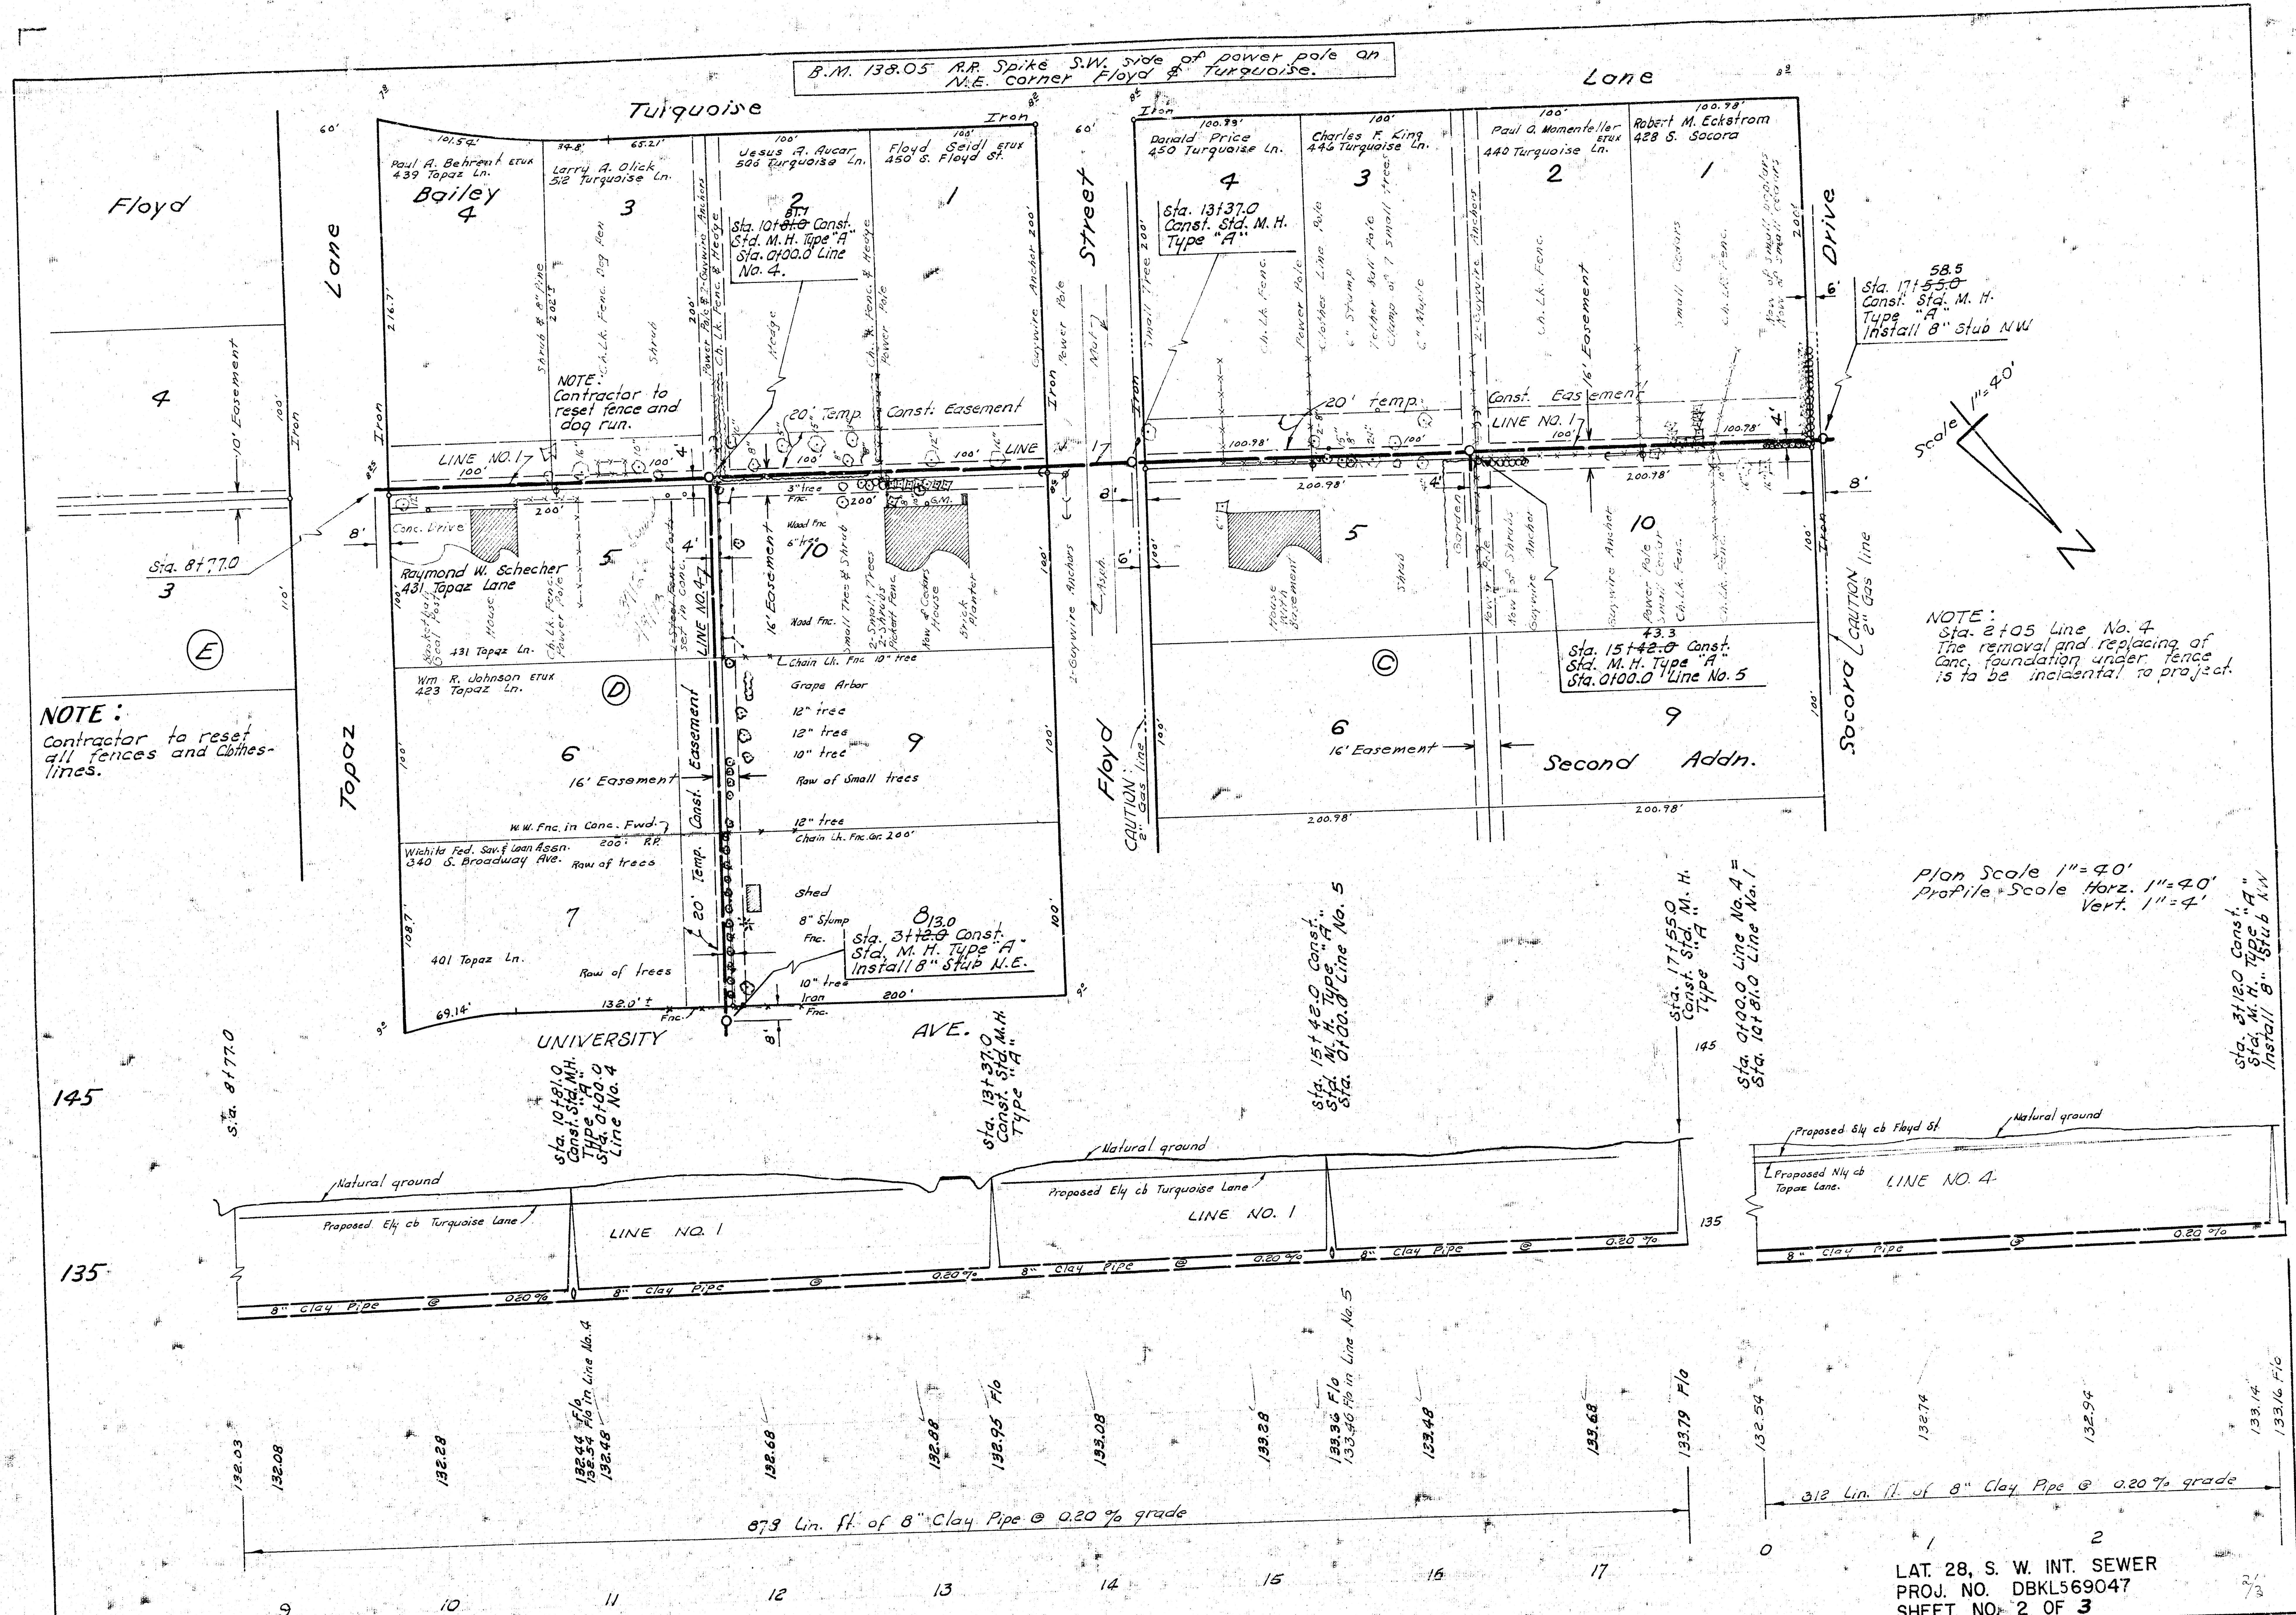

NOTE:
Contractor to reset
all fences and clothes-
lines.


NOTE:
Sta. 2+05 Line No. 4
The removal and replacing of
conc. foundation under fence
is to be incidental to project.

Plan Scale 1"=40'
Profile Scale Horiz. 1"=40'
Vert. 1"=4'

LAT. 28, S. W. INT. SEWER
PROJ. NO. DBKL569047
SHEET NO. 2 OF 3

NOTE:
Contractor to reset all
fences and clotheslines.

Sta. 0+00.0 Line No. 5 =
Sta. 15+42.6 Line No. 1

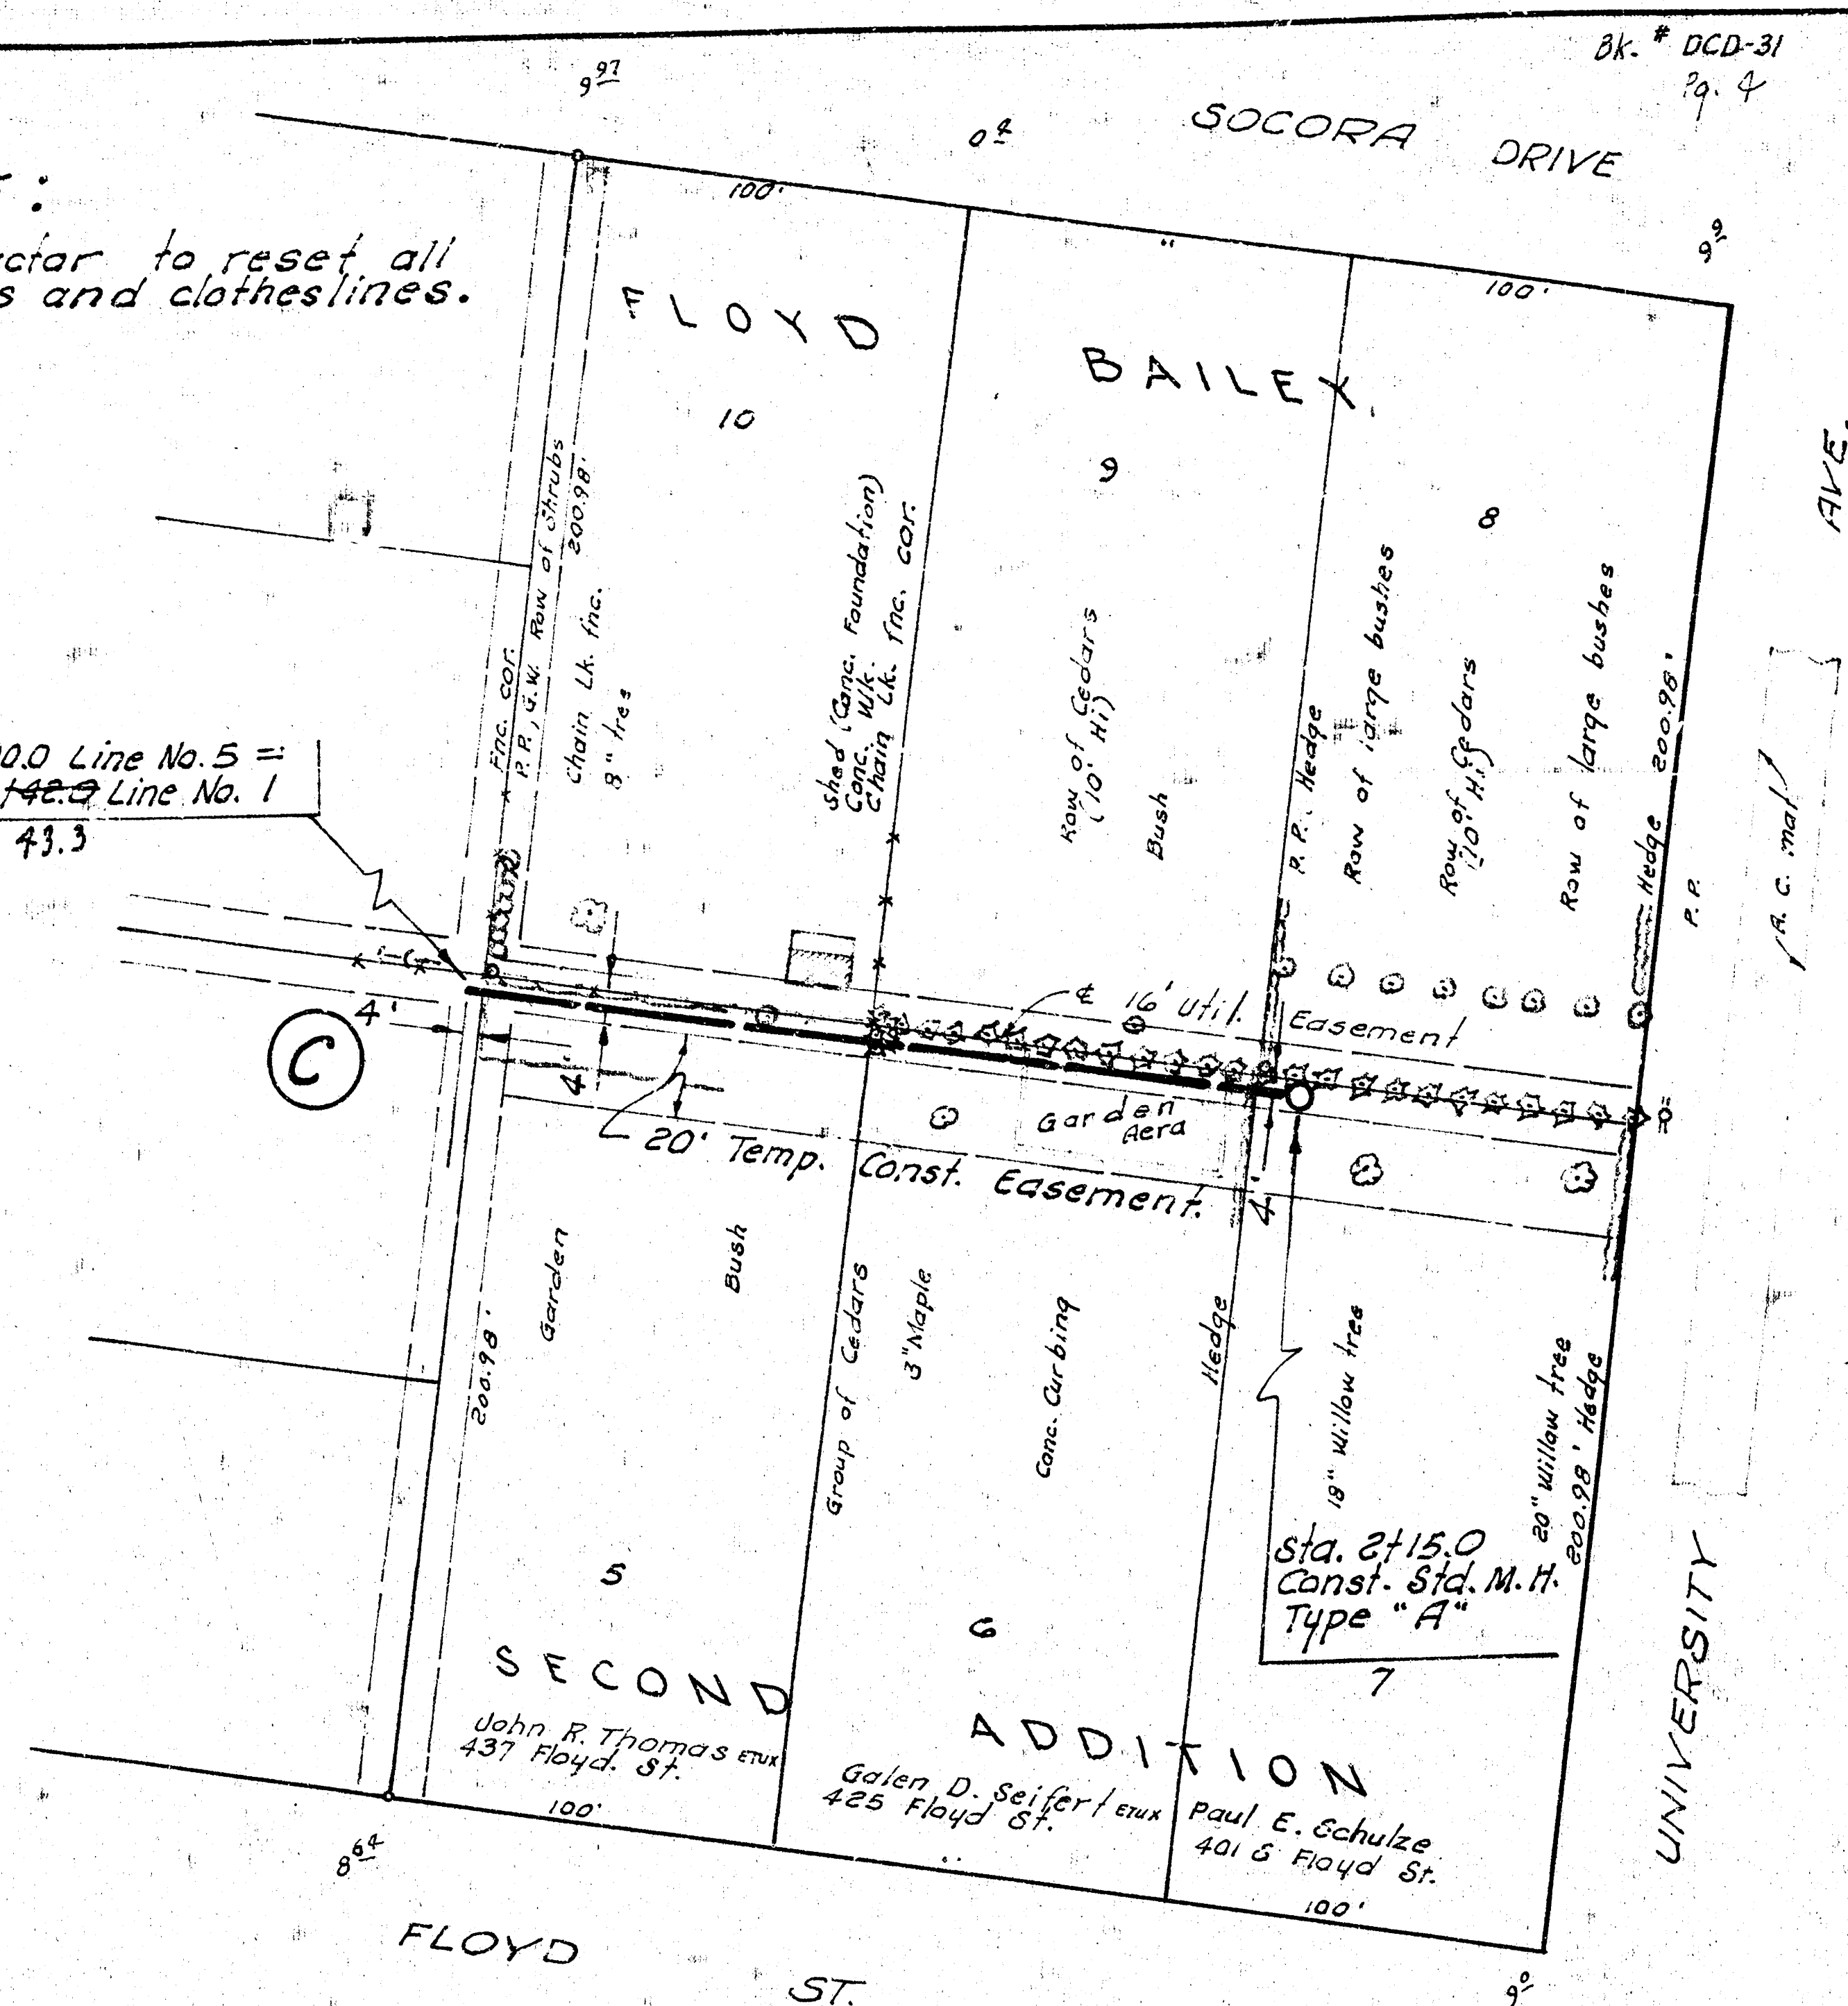

B.M. 139.07 Spk. W. Side R.R. E. side Floyd St. 200' ± N. of Turquoise.
B.M. 140.45 Spk. N. Side Light Pole S.W. cor. University & Socora.

Sta. 0+00.0 Line No. 5 =
Sta. 15+42.6 Line No. 1

Sta. 2+15.0 Const. Std. M.H. Type "A"

