

SANITARY SEWER IMPROVEMENTS TO SERVE BARRINGTON CORNER 2ND ADDITION

Lat. 36, Main 15, SW 1

Project Number

468 82781

Index Code


748328

CITY OF WICHITA, KANSAS

Michael E. Lindebak, P. E., City Engineer

GENERAL NOTES

- Contractor will be required to provide notice to utility companies a minimum of twenty-four (24) hours prior to any excavation, as follows:
Kansas One-Call 687-2470
The Contractor must notify the following in case of an emergency:
Cablevision 262-4270
or
K.P.L. Gas Service Company 383-8650
Kansas Gas & Electric Company 363-8600
Arkla Gas Company 942-8350
Southwestern Bell Telephone Company 1-571-2611
City of Wichita Water Department 268-4908
City of Wichita Sewer Department 268-4071
- Exist. utilities and their locations, as shown on the plans, represent the best information obtainable for design. Location information has been obtained from the various utility companies and is either from company record drawings or company-provided field locations. The Contractor will be required to work around existing utilities which do not conflict with proposed construction.
- The Contractor to verify utility locations prior to construction of this project.
- Utility service and installation shall be coordinated with the respective utility owners. Contacts are:
K&E Gas Steve Orth 261-6867
K.G. & E. Miles Capps 261-6434
Wichita Water Chuck Steven 268-4355
Joe Botinelly 268-4908
Southwestern Bell Jim Tabin 268-2759
- All areas disturbed by construction shall be seeded with rye Rebel II Fescue grass at a rate of 350 lbs./acre immediately following construction in that area.
- Traffic affected by the construction of this project shall be handled in accordance with the latest edition of the Manual on Uniform Traffic Control Devices.

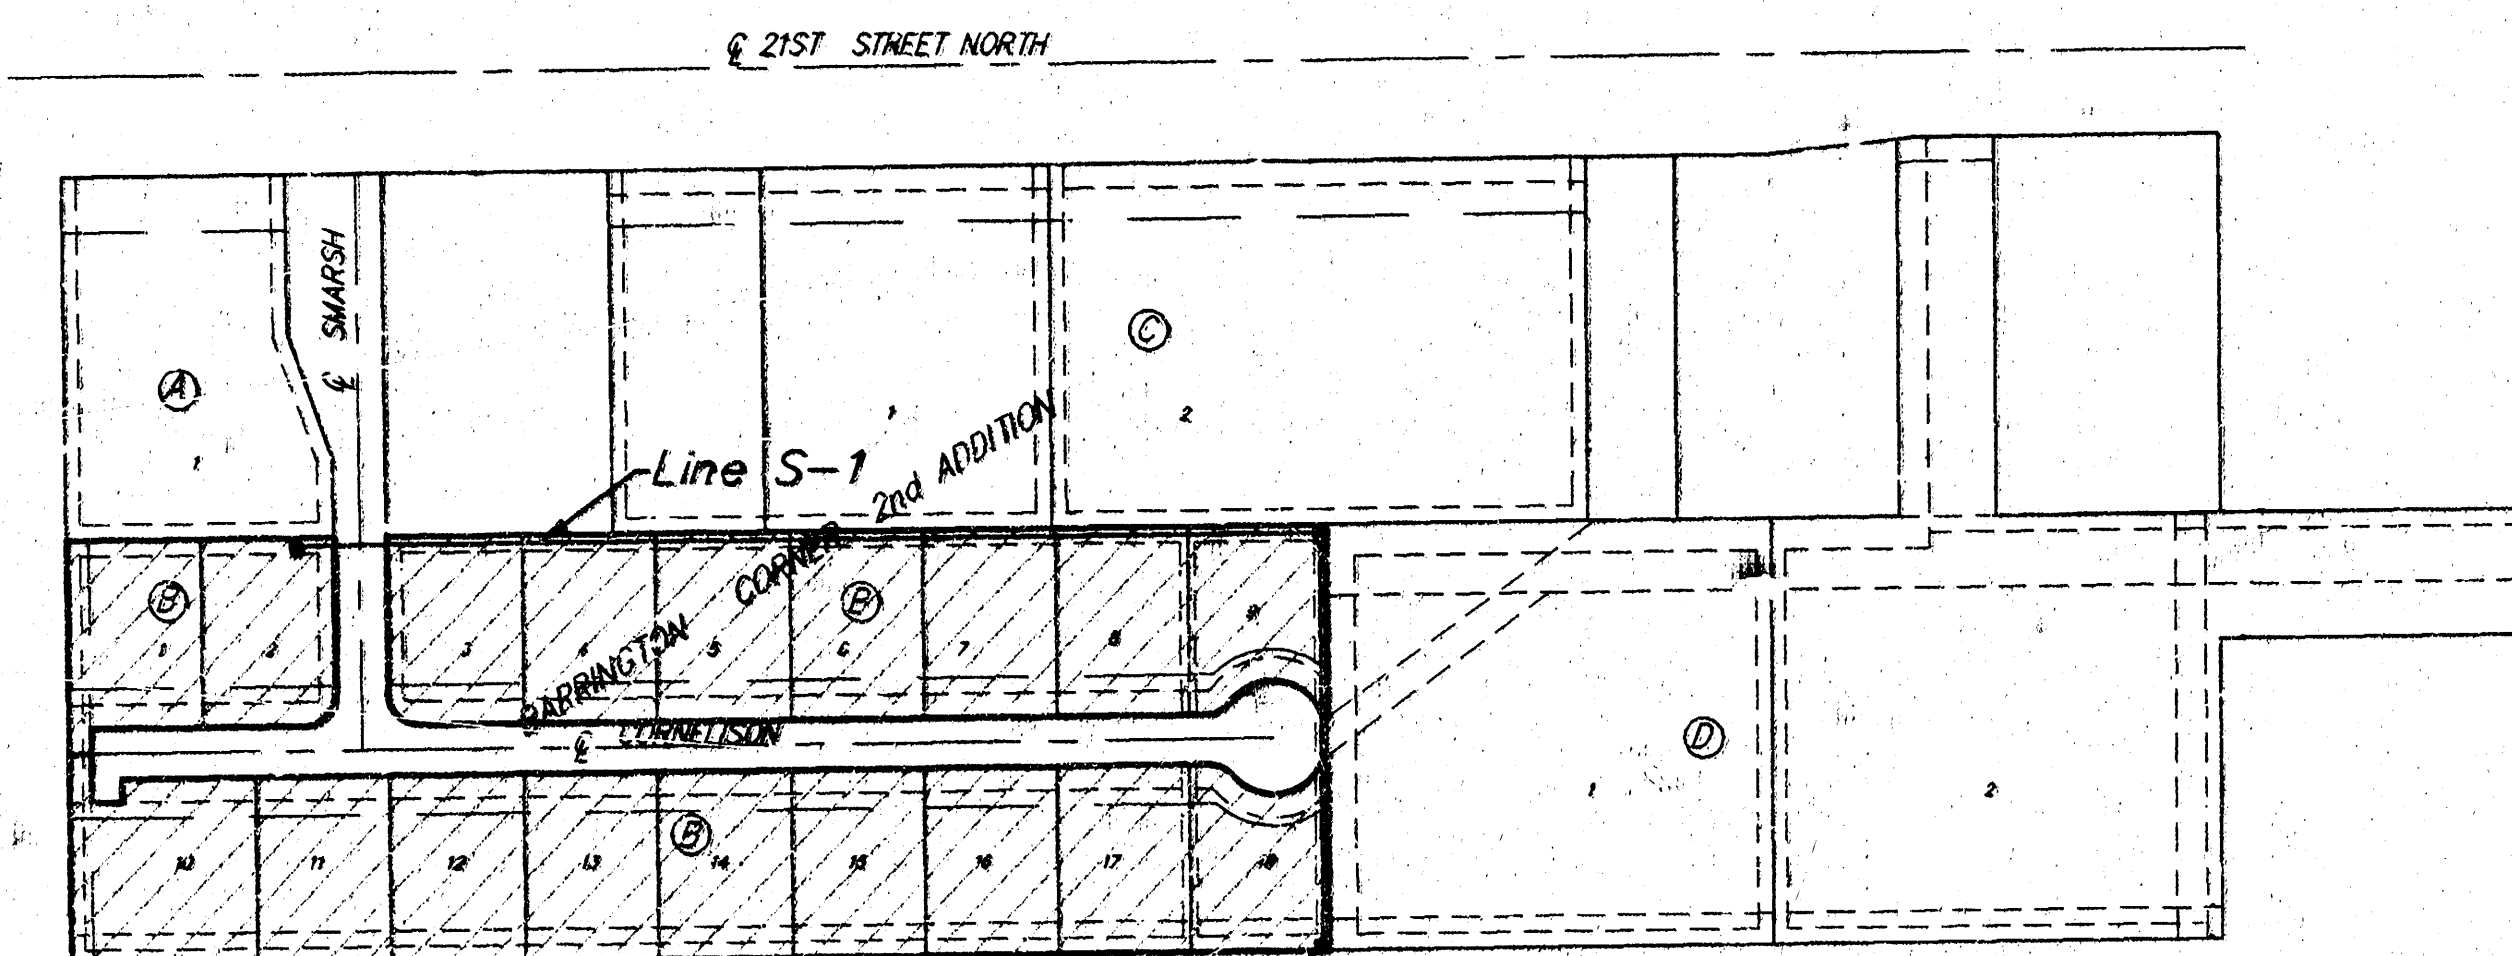


Legend:
Benefit District Included

BENCHMARK

RR Spike in Power Pole
Northeast Corner of 21st. & Ridge Road
Elev. = 1,330.70'



INDEX



- Title Sheet
- Plan and Profile
- Easement Grading Plan
- 5- Cross-Sections

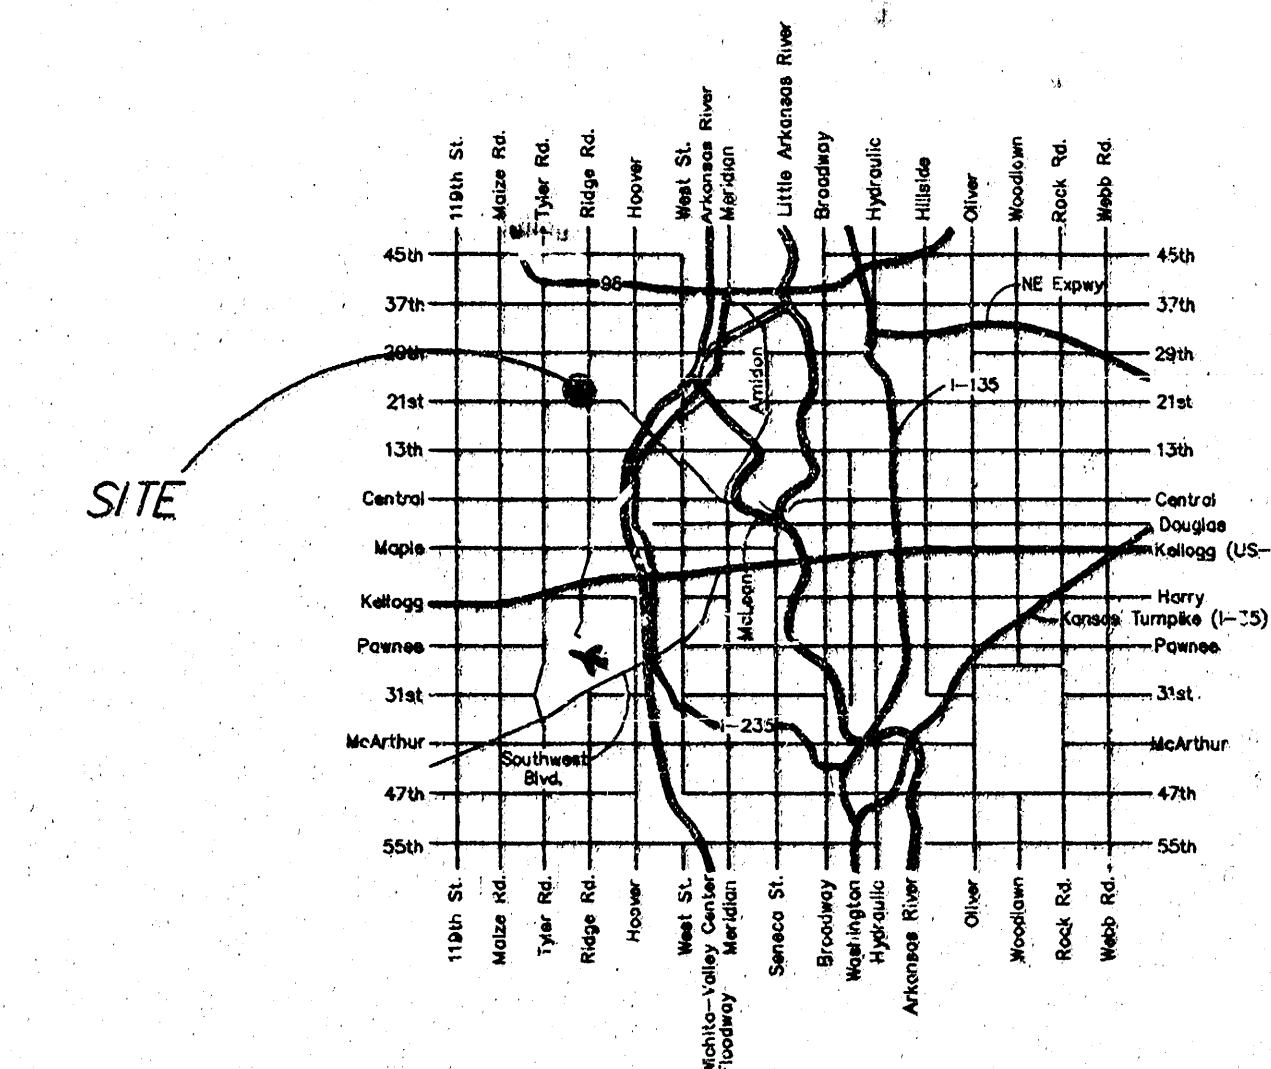

LOCATION MAP



Booked
P-11
6/10/98
AS BUILT
R. Loomis

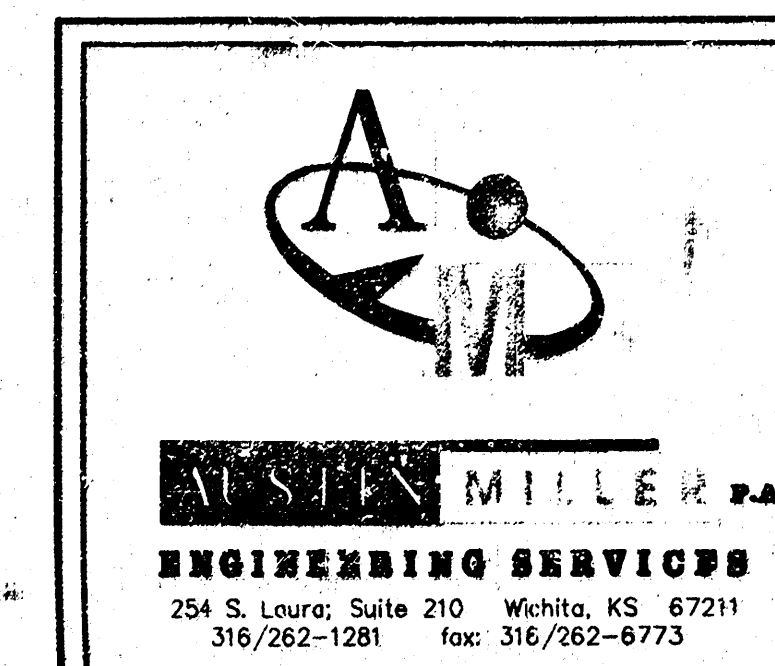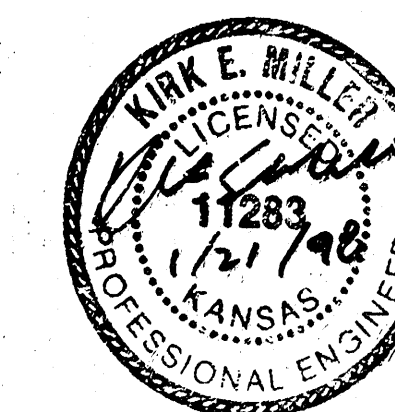

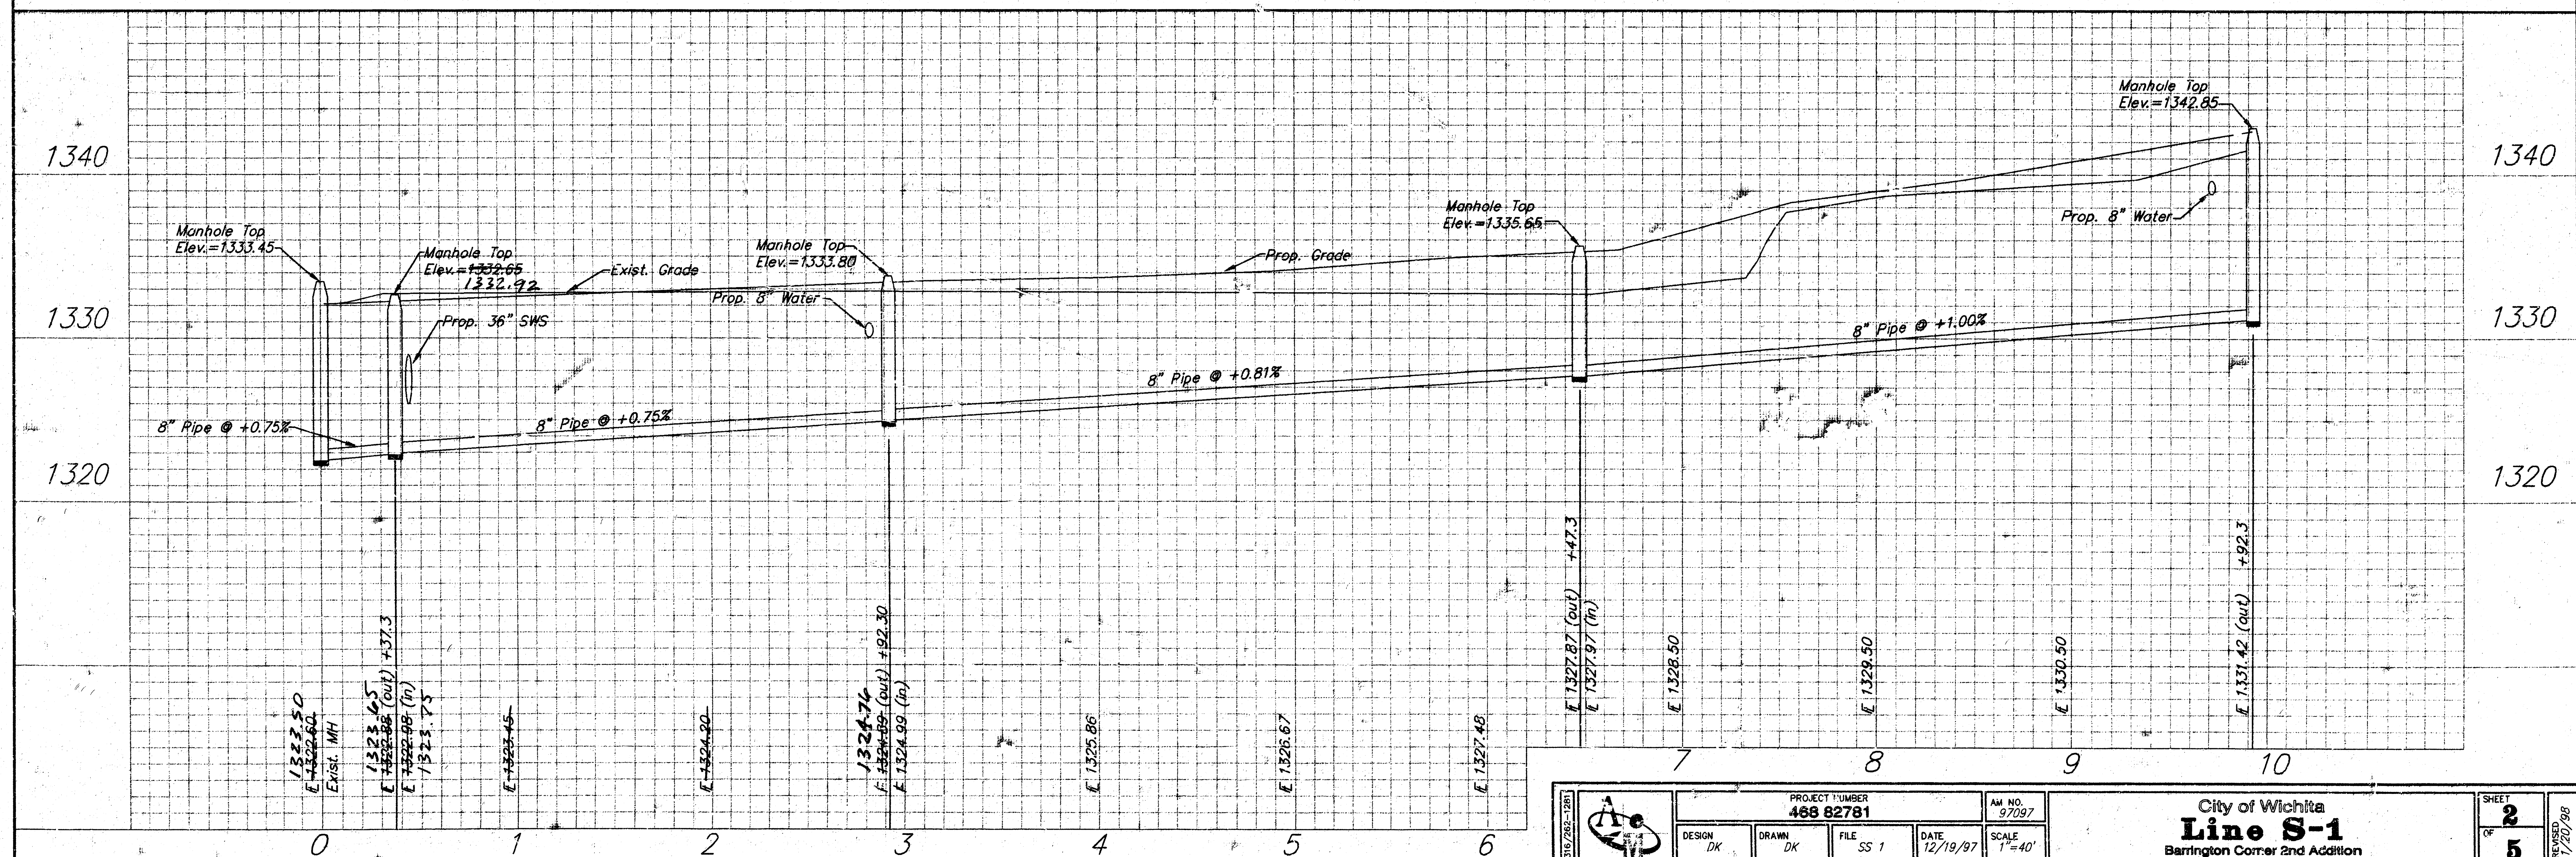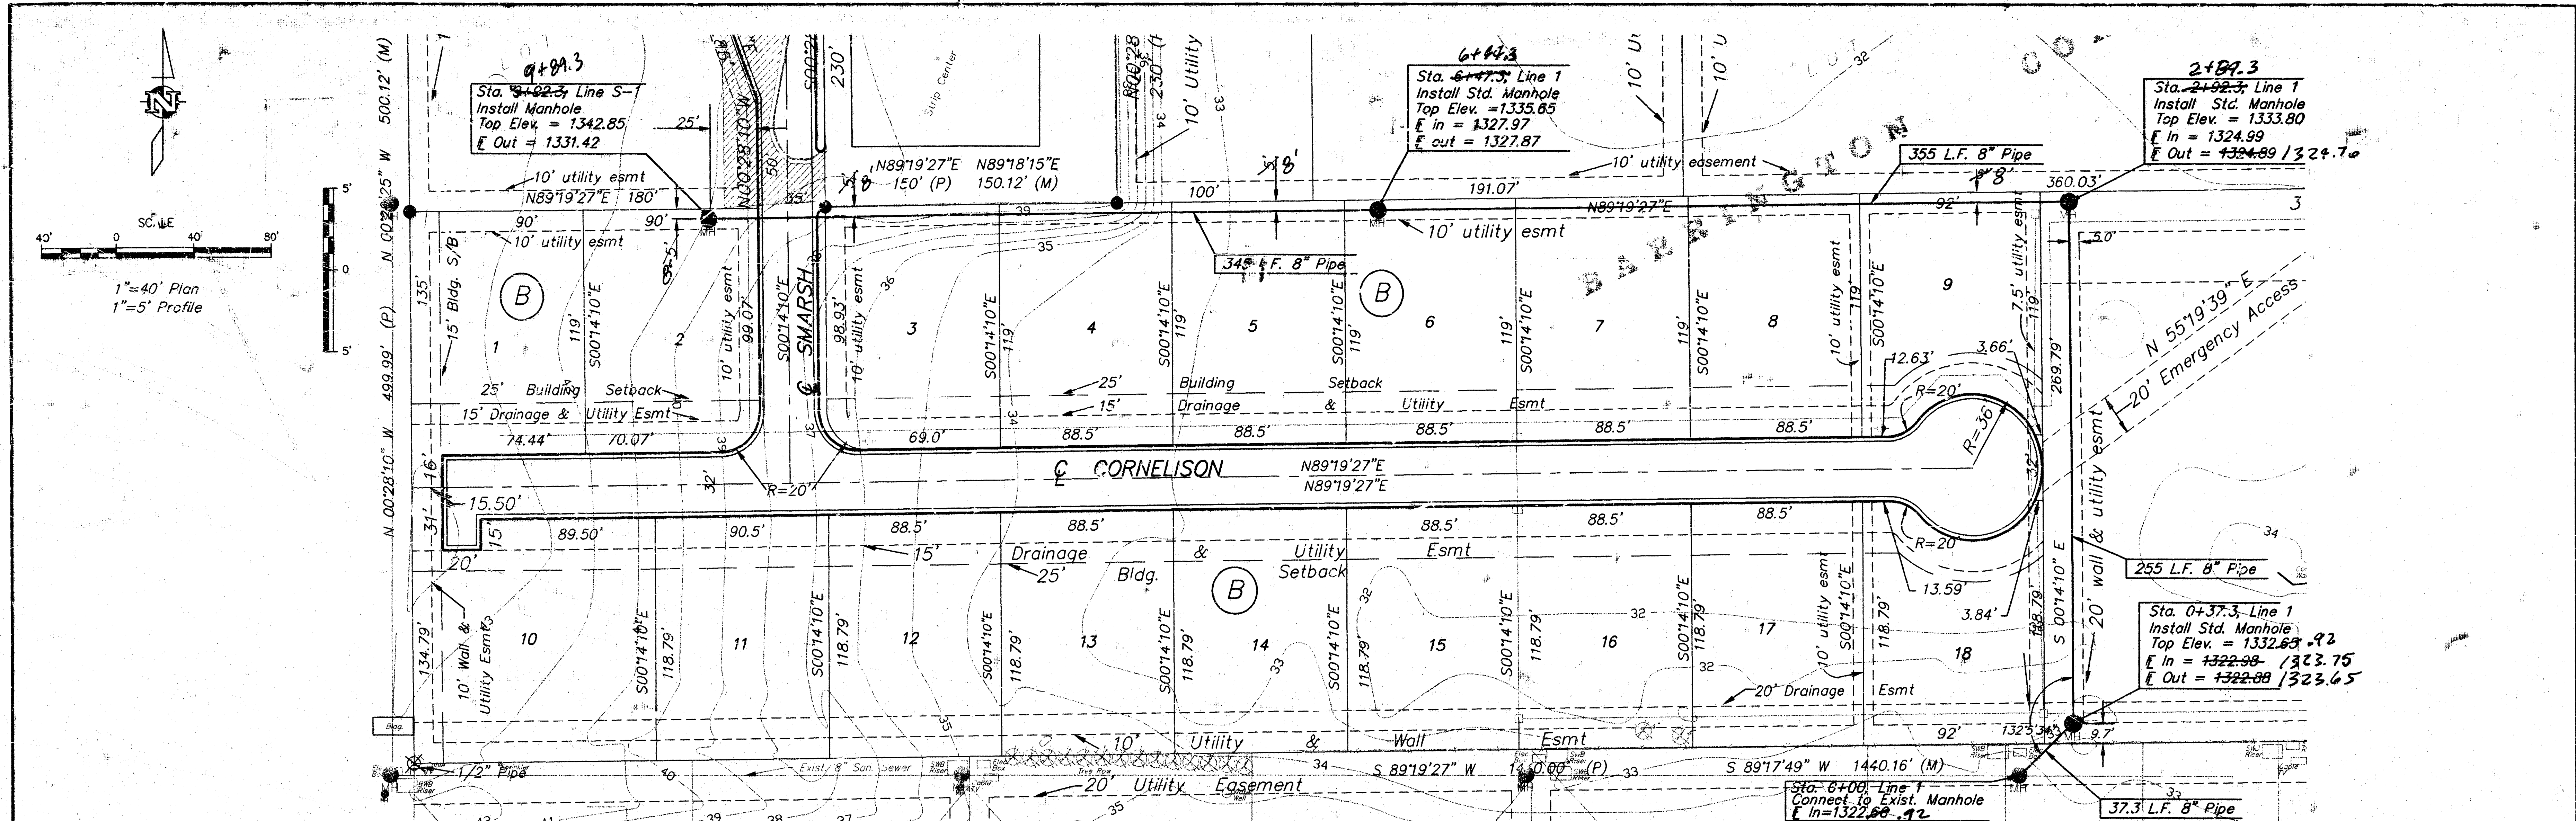



PROJECT NUMBER 488 82781				AM. NO. 97087	
DESIGN DK	DRAWN DK	FILE SS 1	DATE 12/19/97	SCALE 1"=40'	City of Wichita Line S-1 Barrington Corner 2nd Addition
SHEET 2 OF 5					REVISED 1/20/98

BENCHMARK:
RR Spike in power pole
Northeast corner of 21st & Ridge
Elev. = 1,330.70 MSL

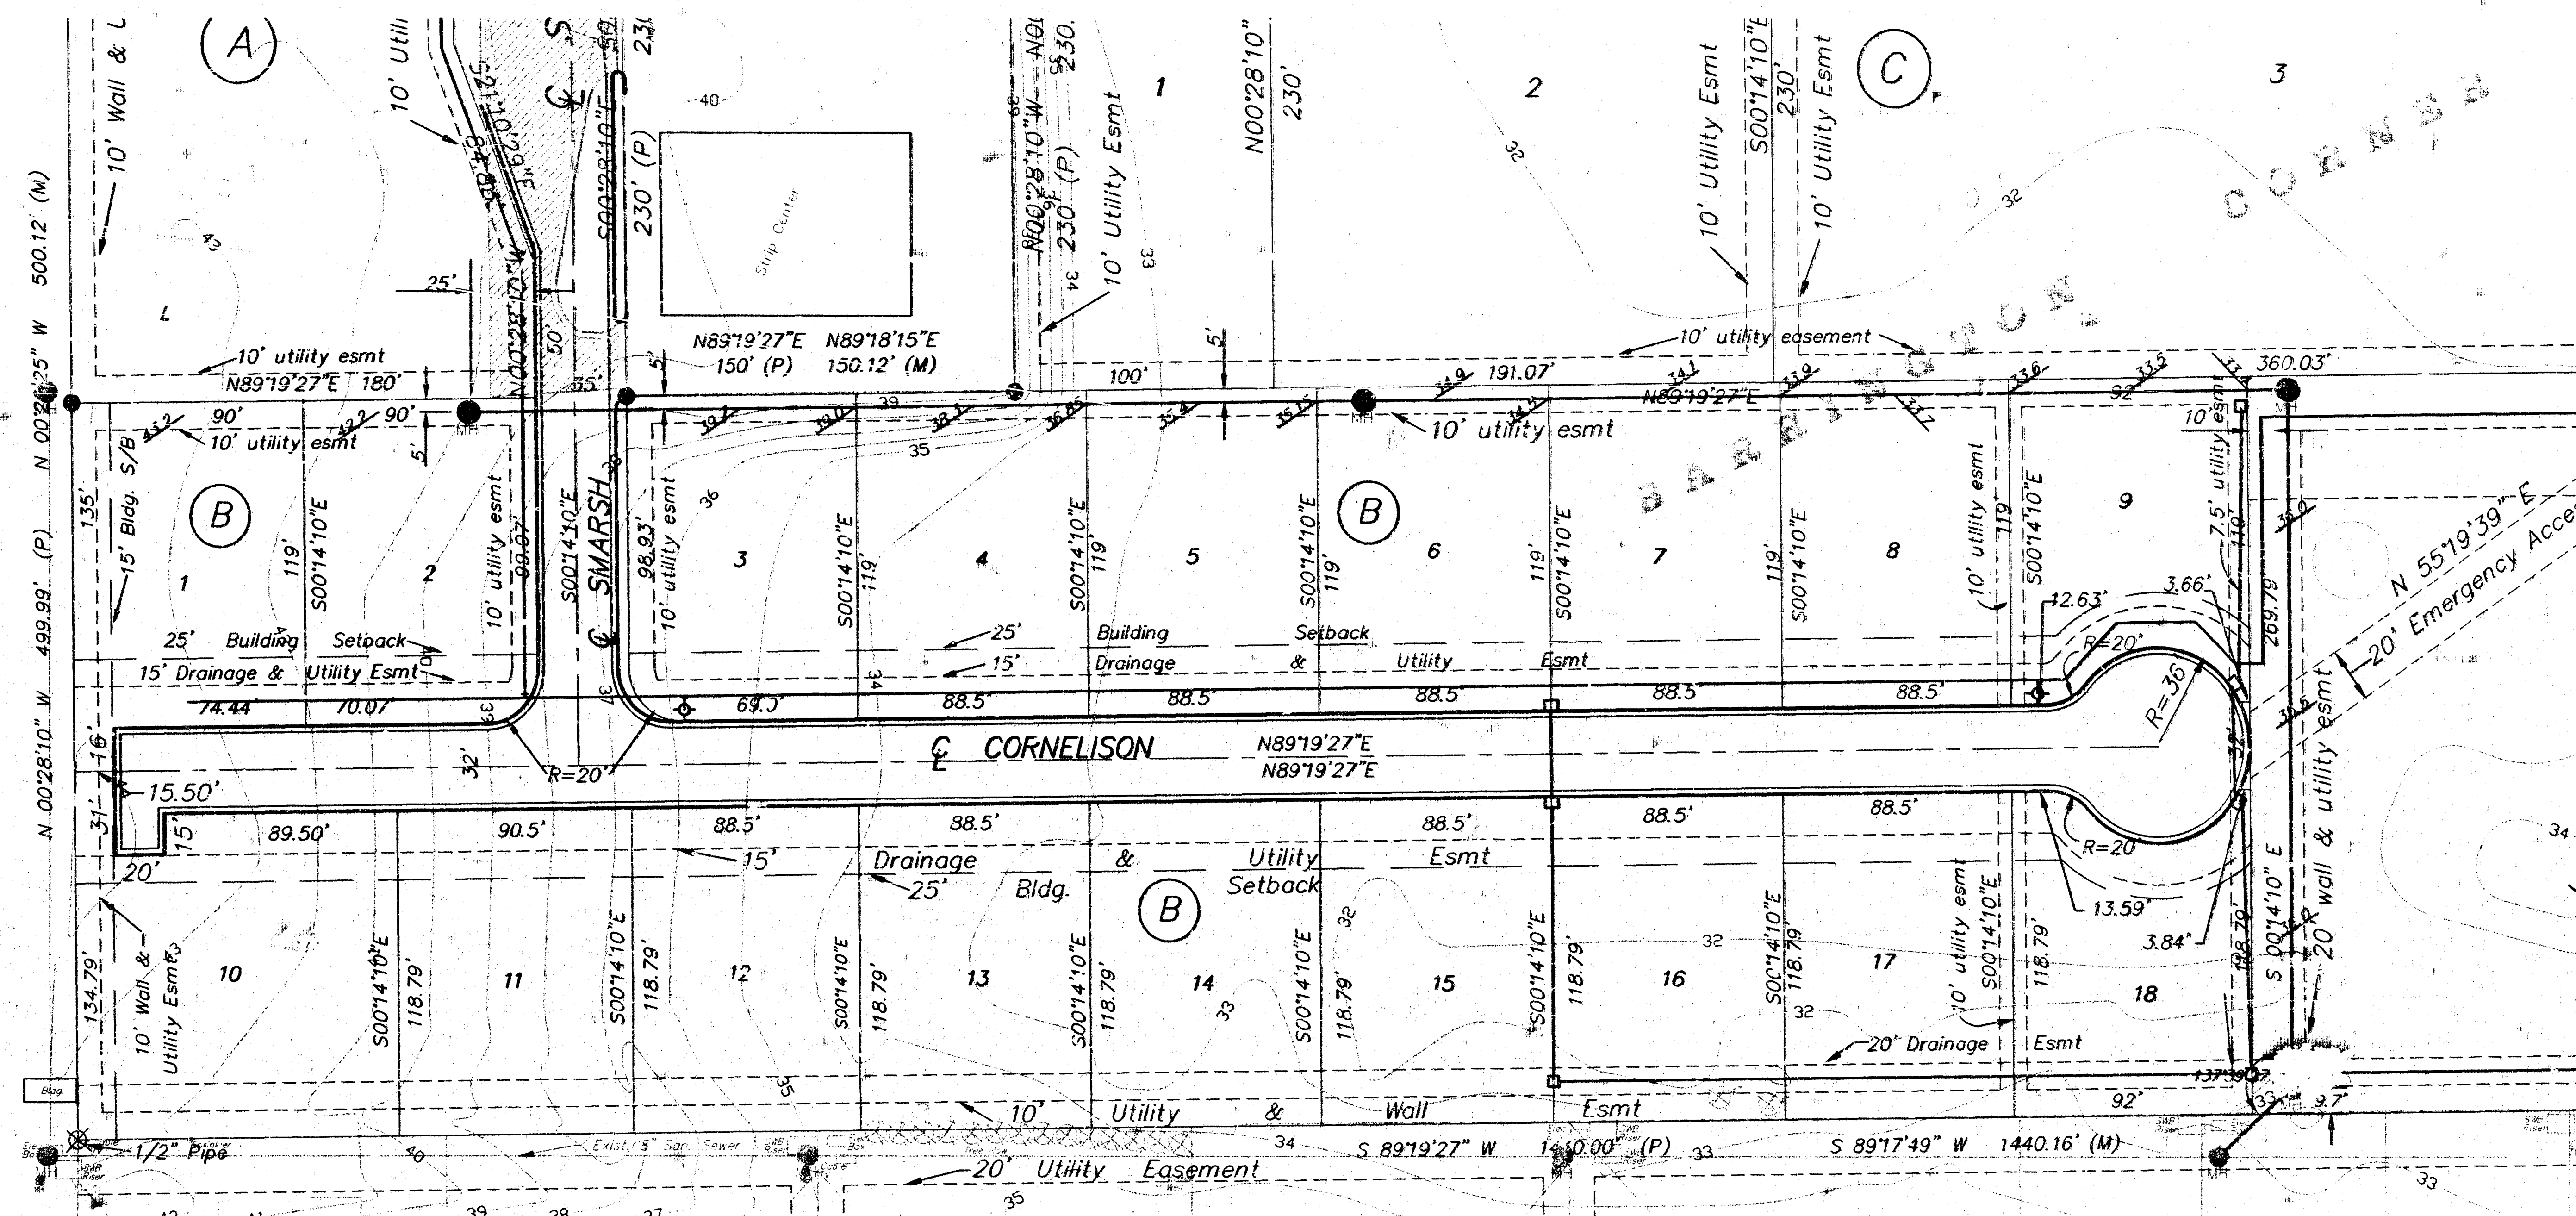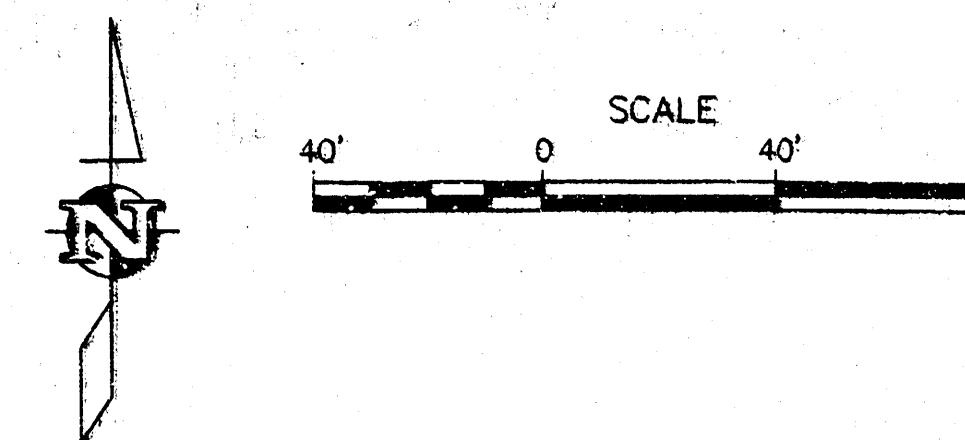

	PROJECT NUMBER 468 82781		AM. NO. 97097
	DESIGN DK	DRAWN DK	FILE ESMTGR2
DATE 1/20/98		SCALE 1" = 40'	City of Wichita Easement Grading Barrington Corner
SHEET 3 OF 5			

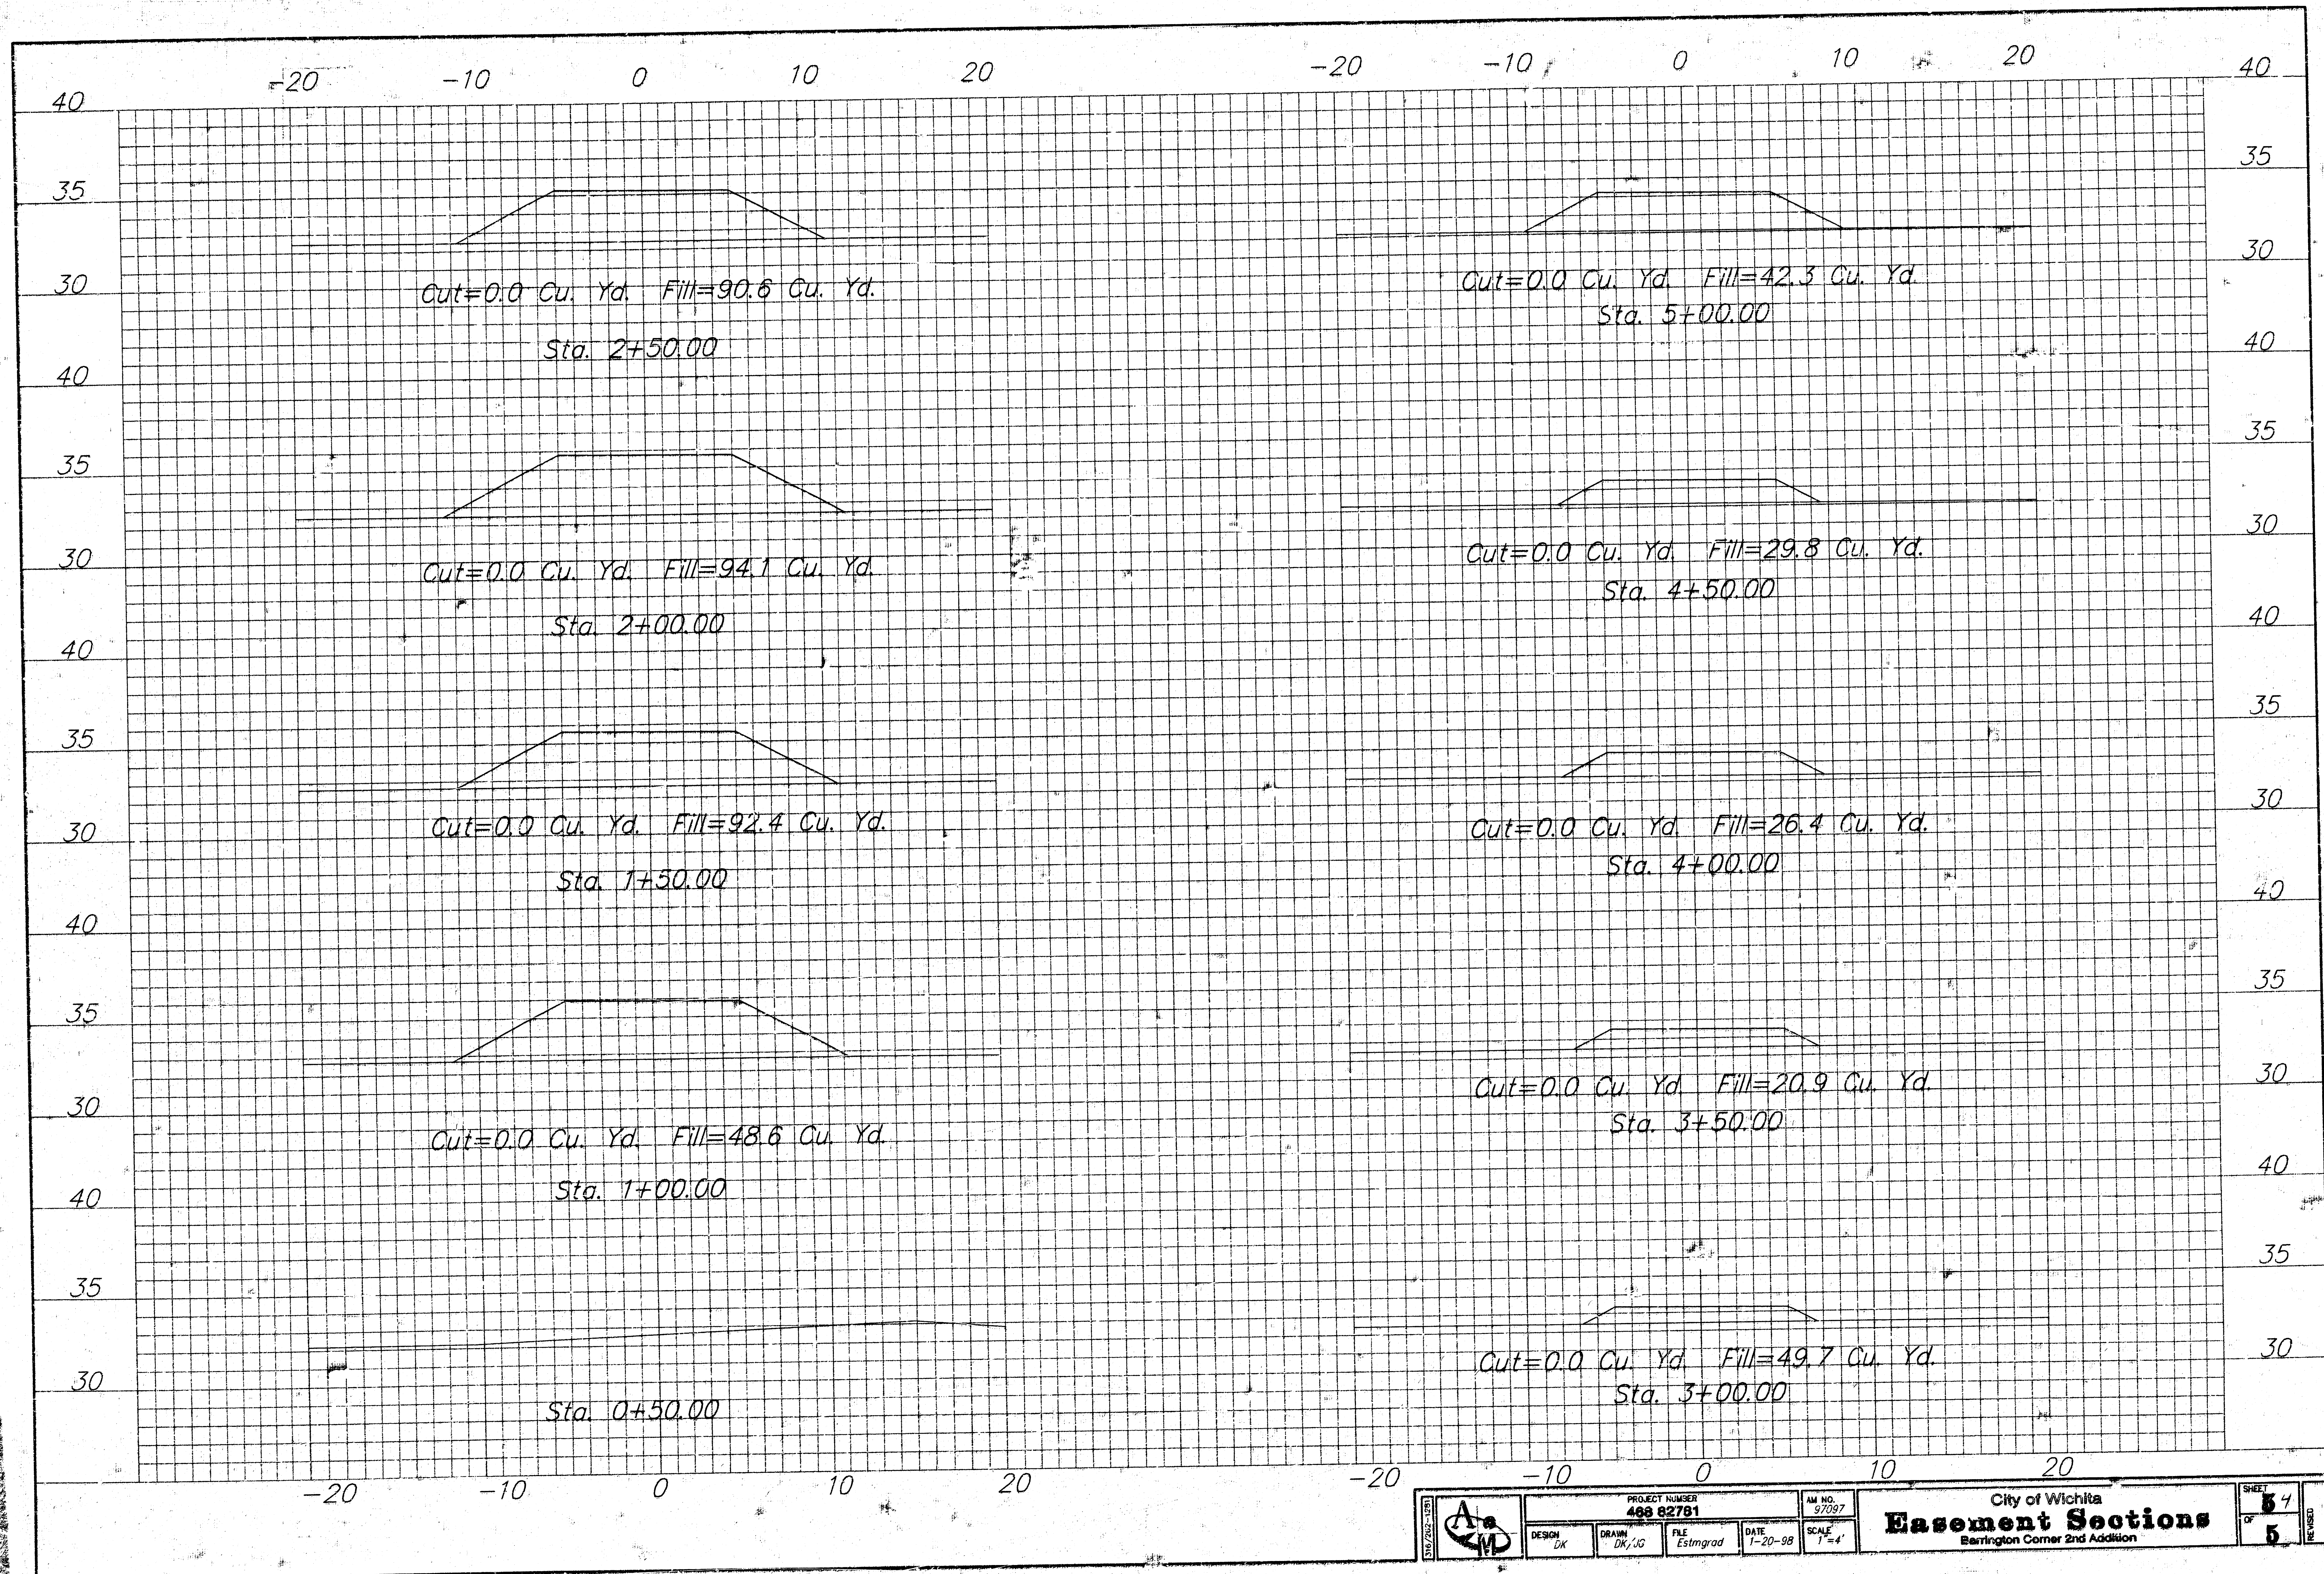

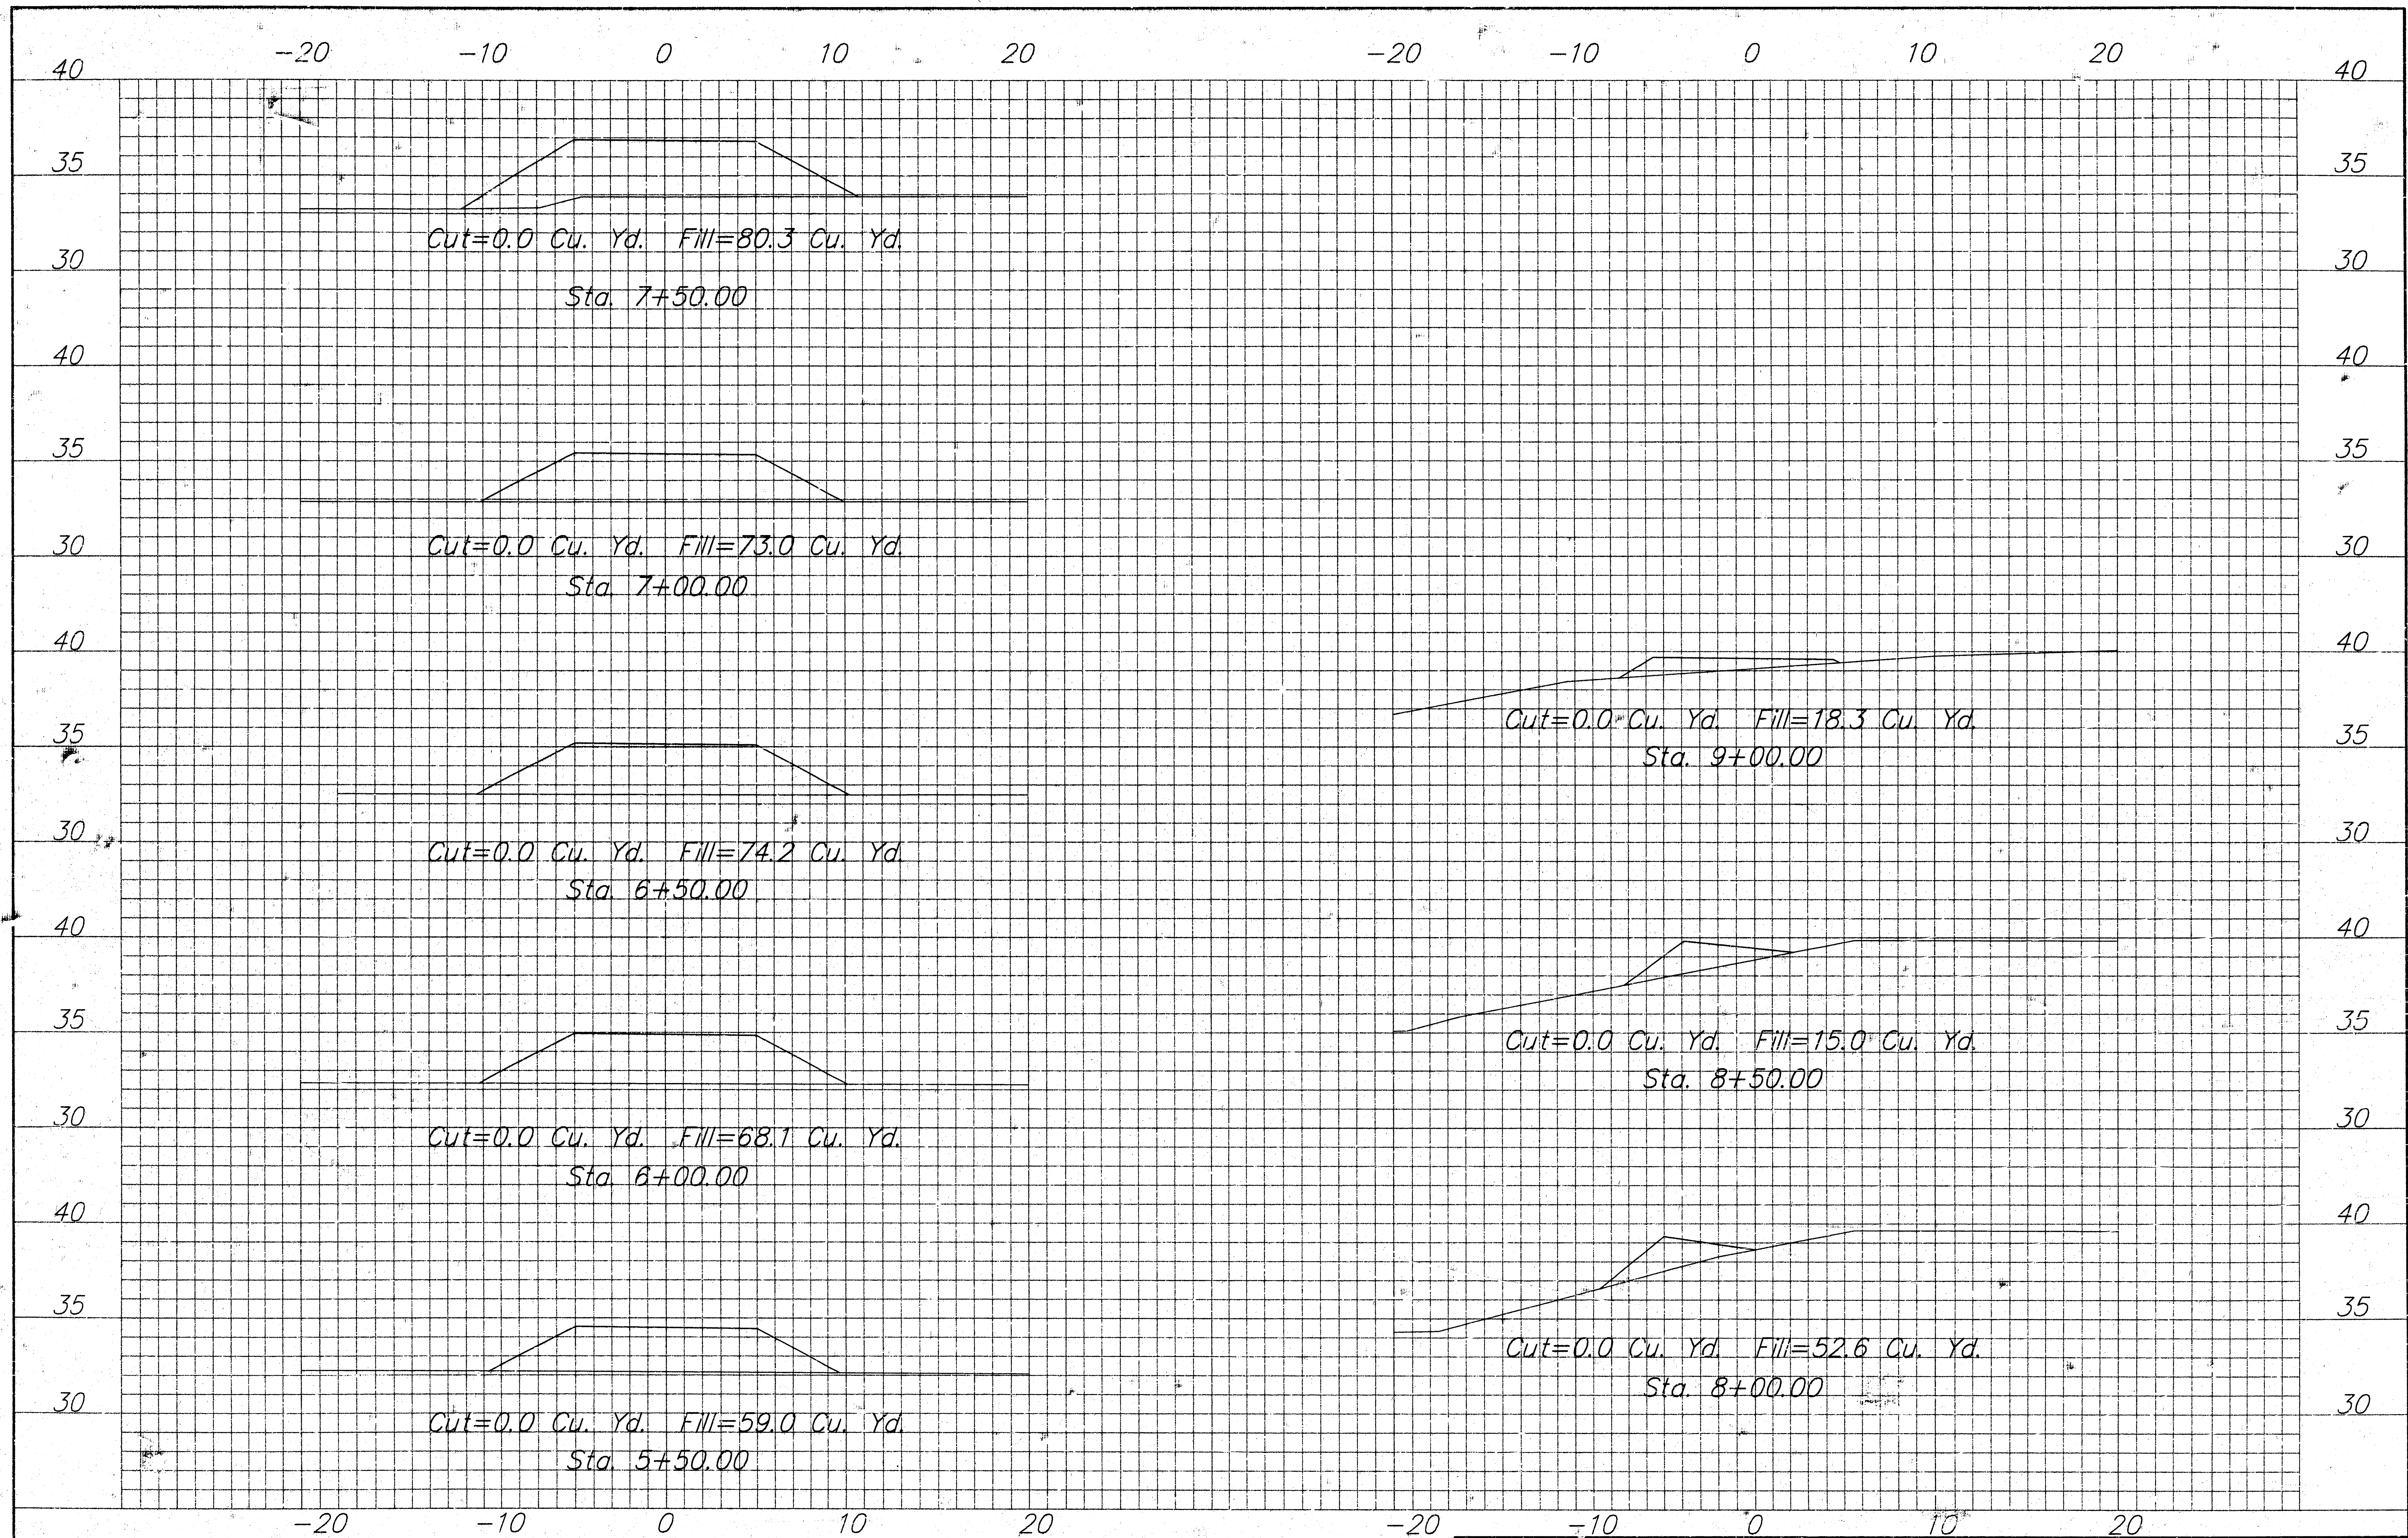

	PROJECT NUMBER 488 82781				AM NO. 97097
	DESIGN DK	DRAWN DK/JG	FILE Esm/grad	DATE 1-20-98	SCALE 1"=4'

City of Wichita		SHEET 85 OF 75
Easement Sections Barrington corner 2nd Addition		

10-00-04