



B.M. #1 ~ 106.43 City Std. 31" St. South + Hoover Road 44' E. + 32' N. of @ both
 B.M. #2 ~ 106.945 RR Spike E-face PP. W-side Hoover 1/2 mile S. of 31" St. South

Plan Scale ~ 1"=40'
 Profile Scale ~ Horiz. 1"=40'
 ~ Vert. 1"=5'

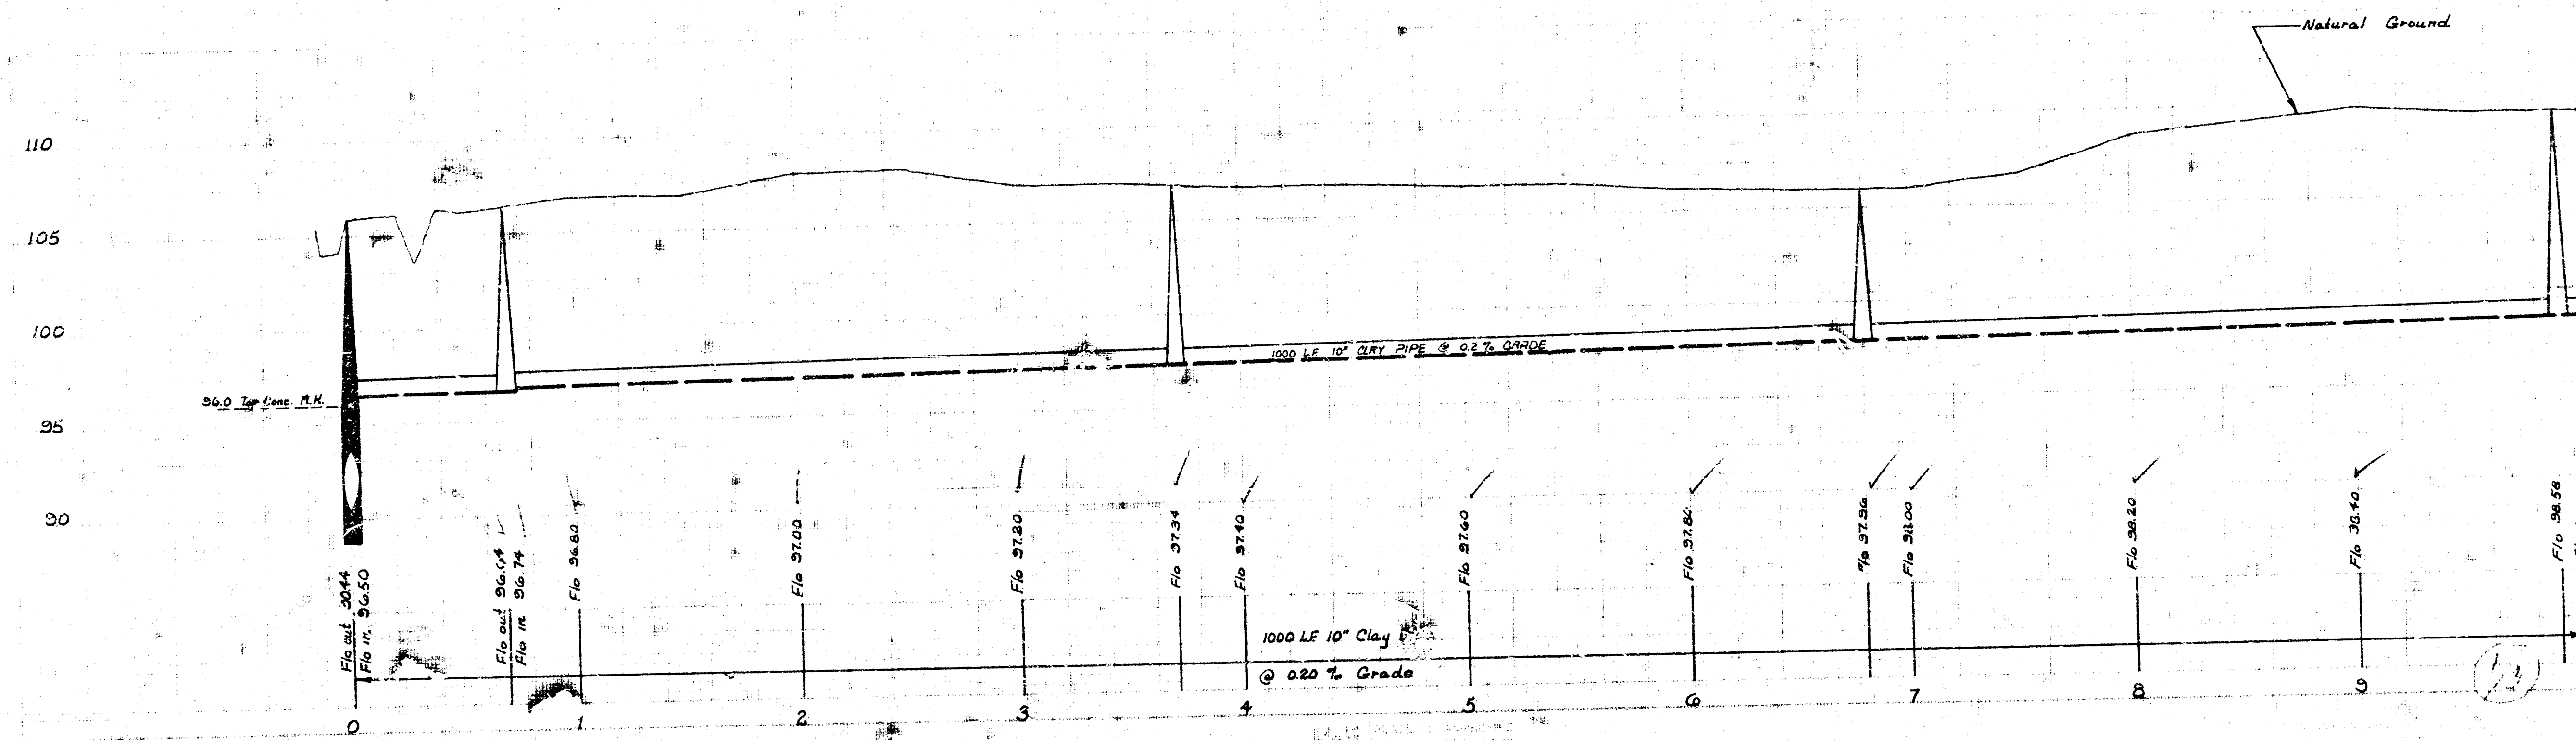

As Built Final Plans SS-AK-10
 LAT. 42, S.W.I.
 CITY OF WICHITA
 R.W. LINN-CITY ENGINEER
 DATE NOV. 1978 PROJ. NO. BHK503054

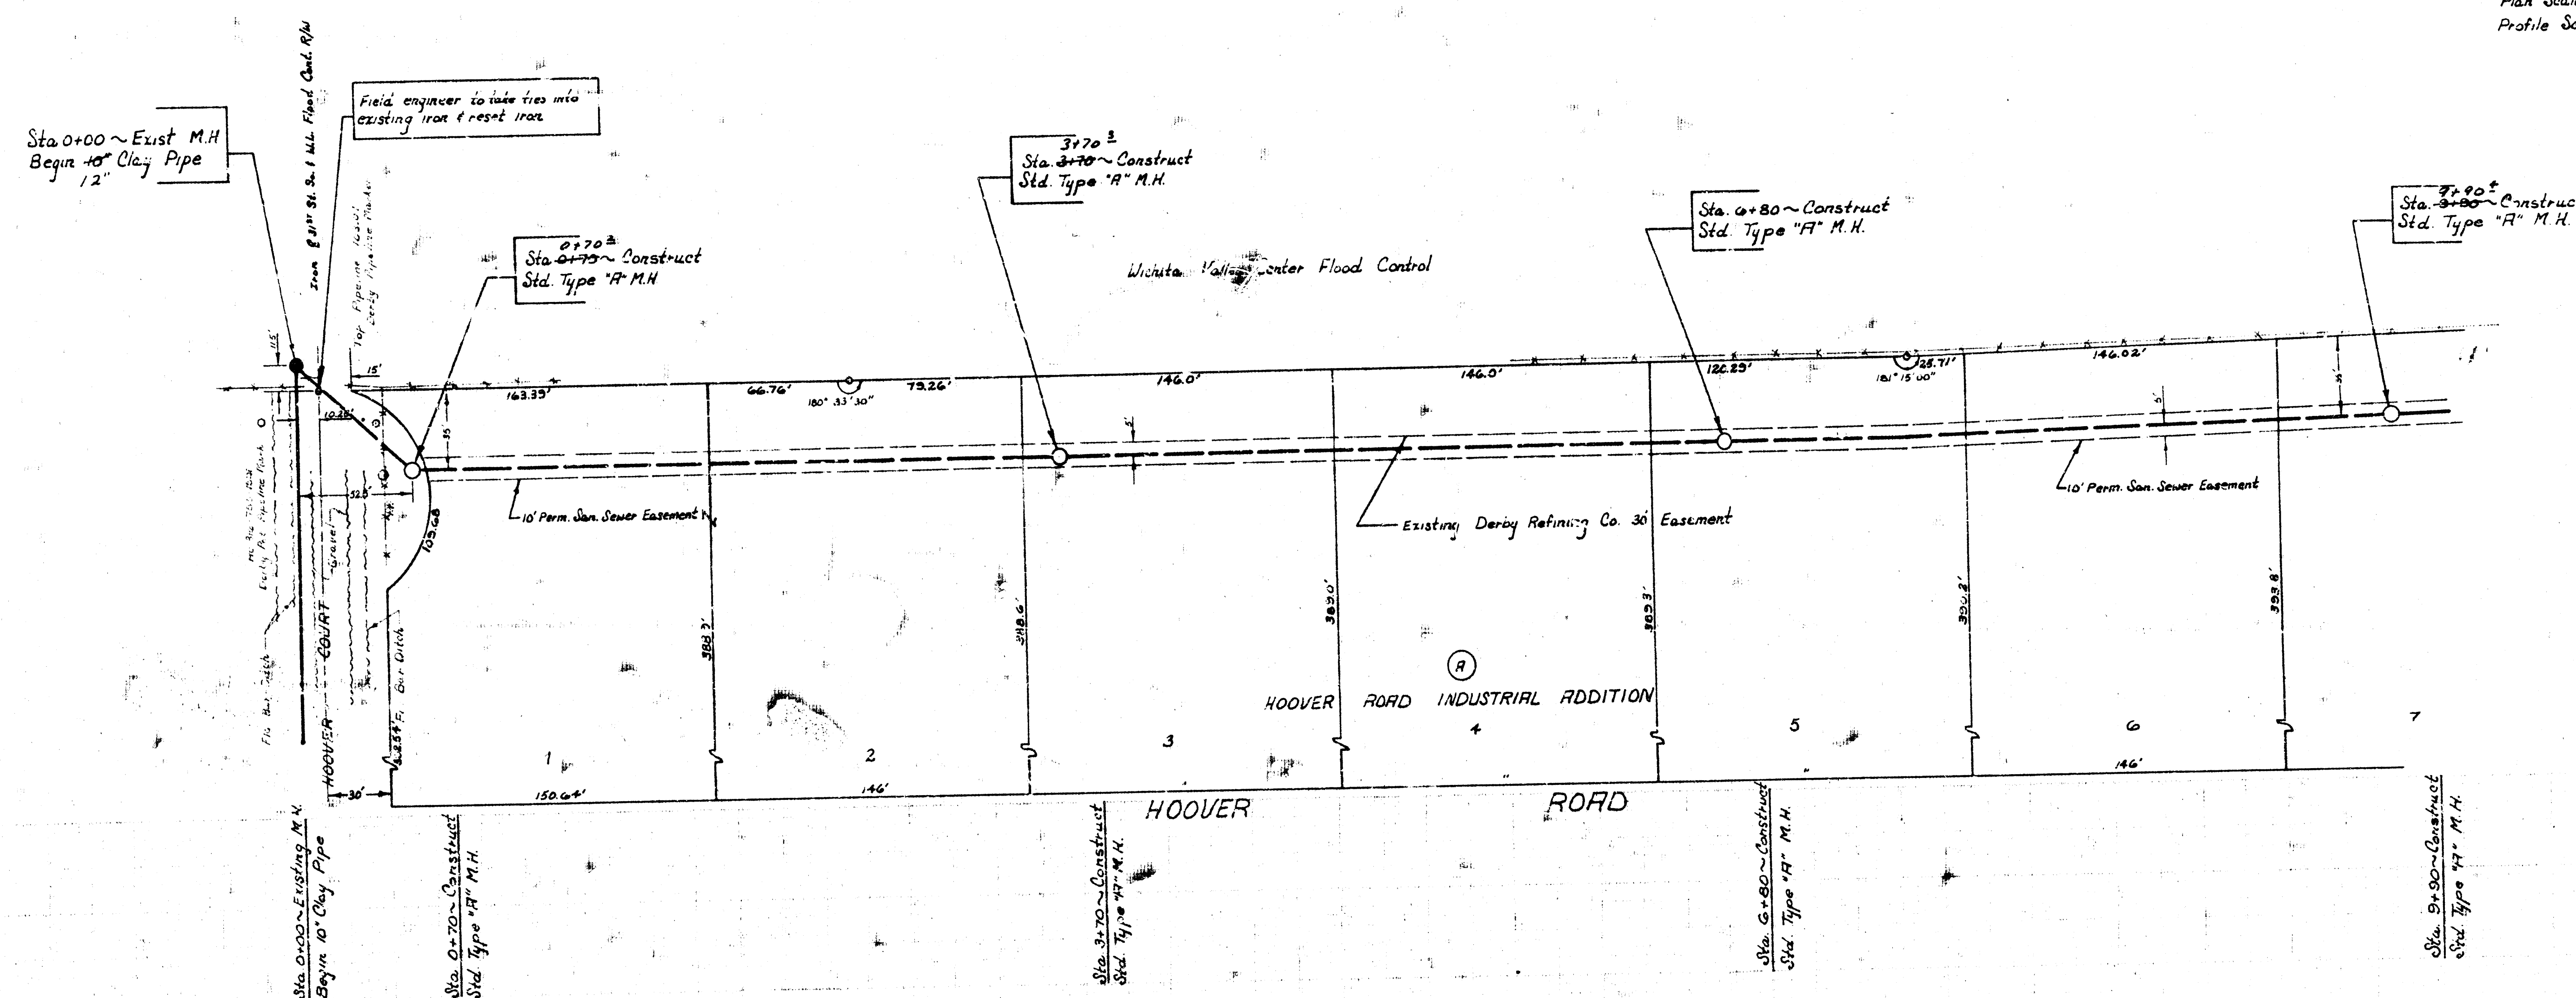