



572
01/11/72


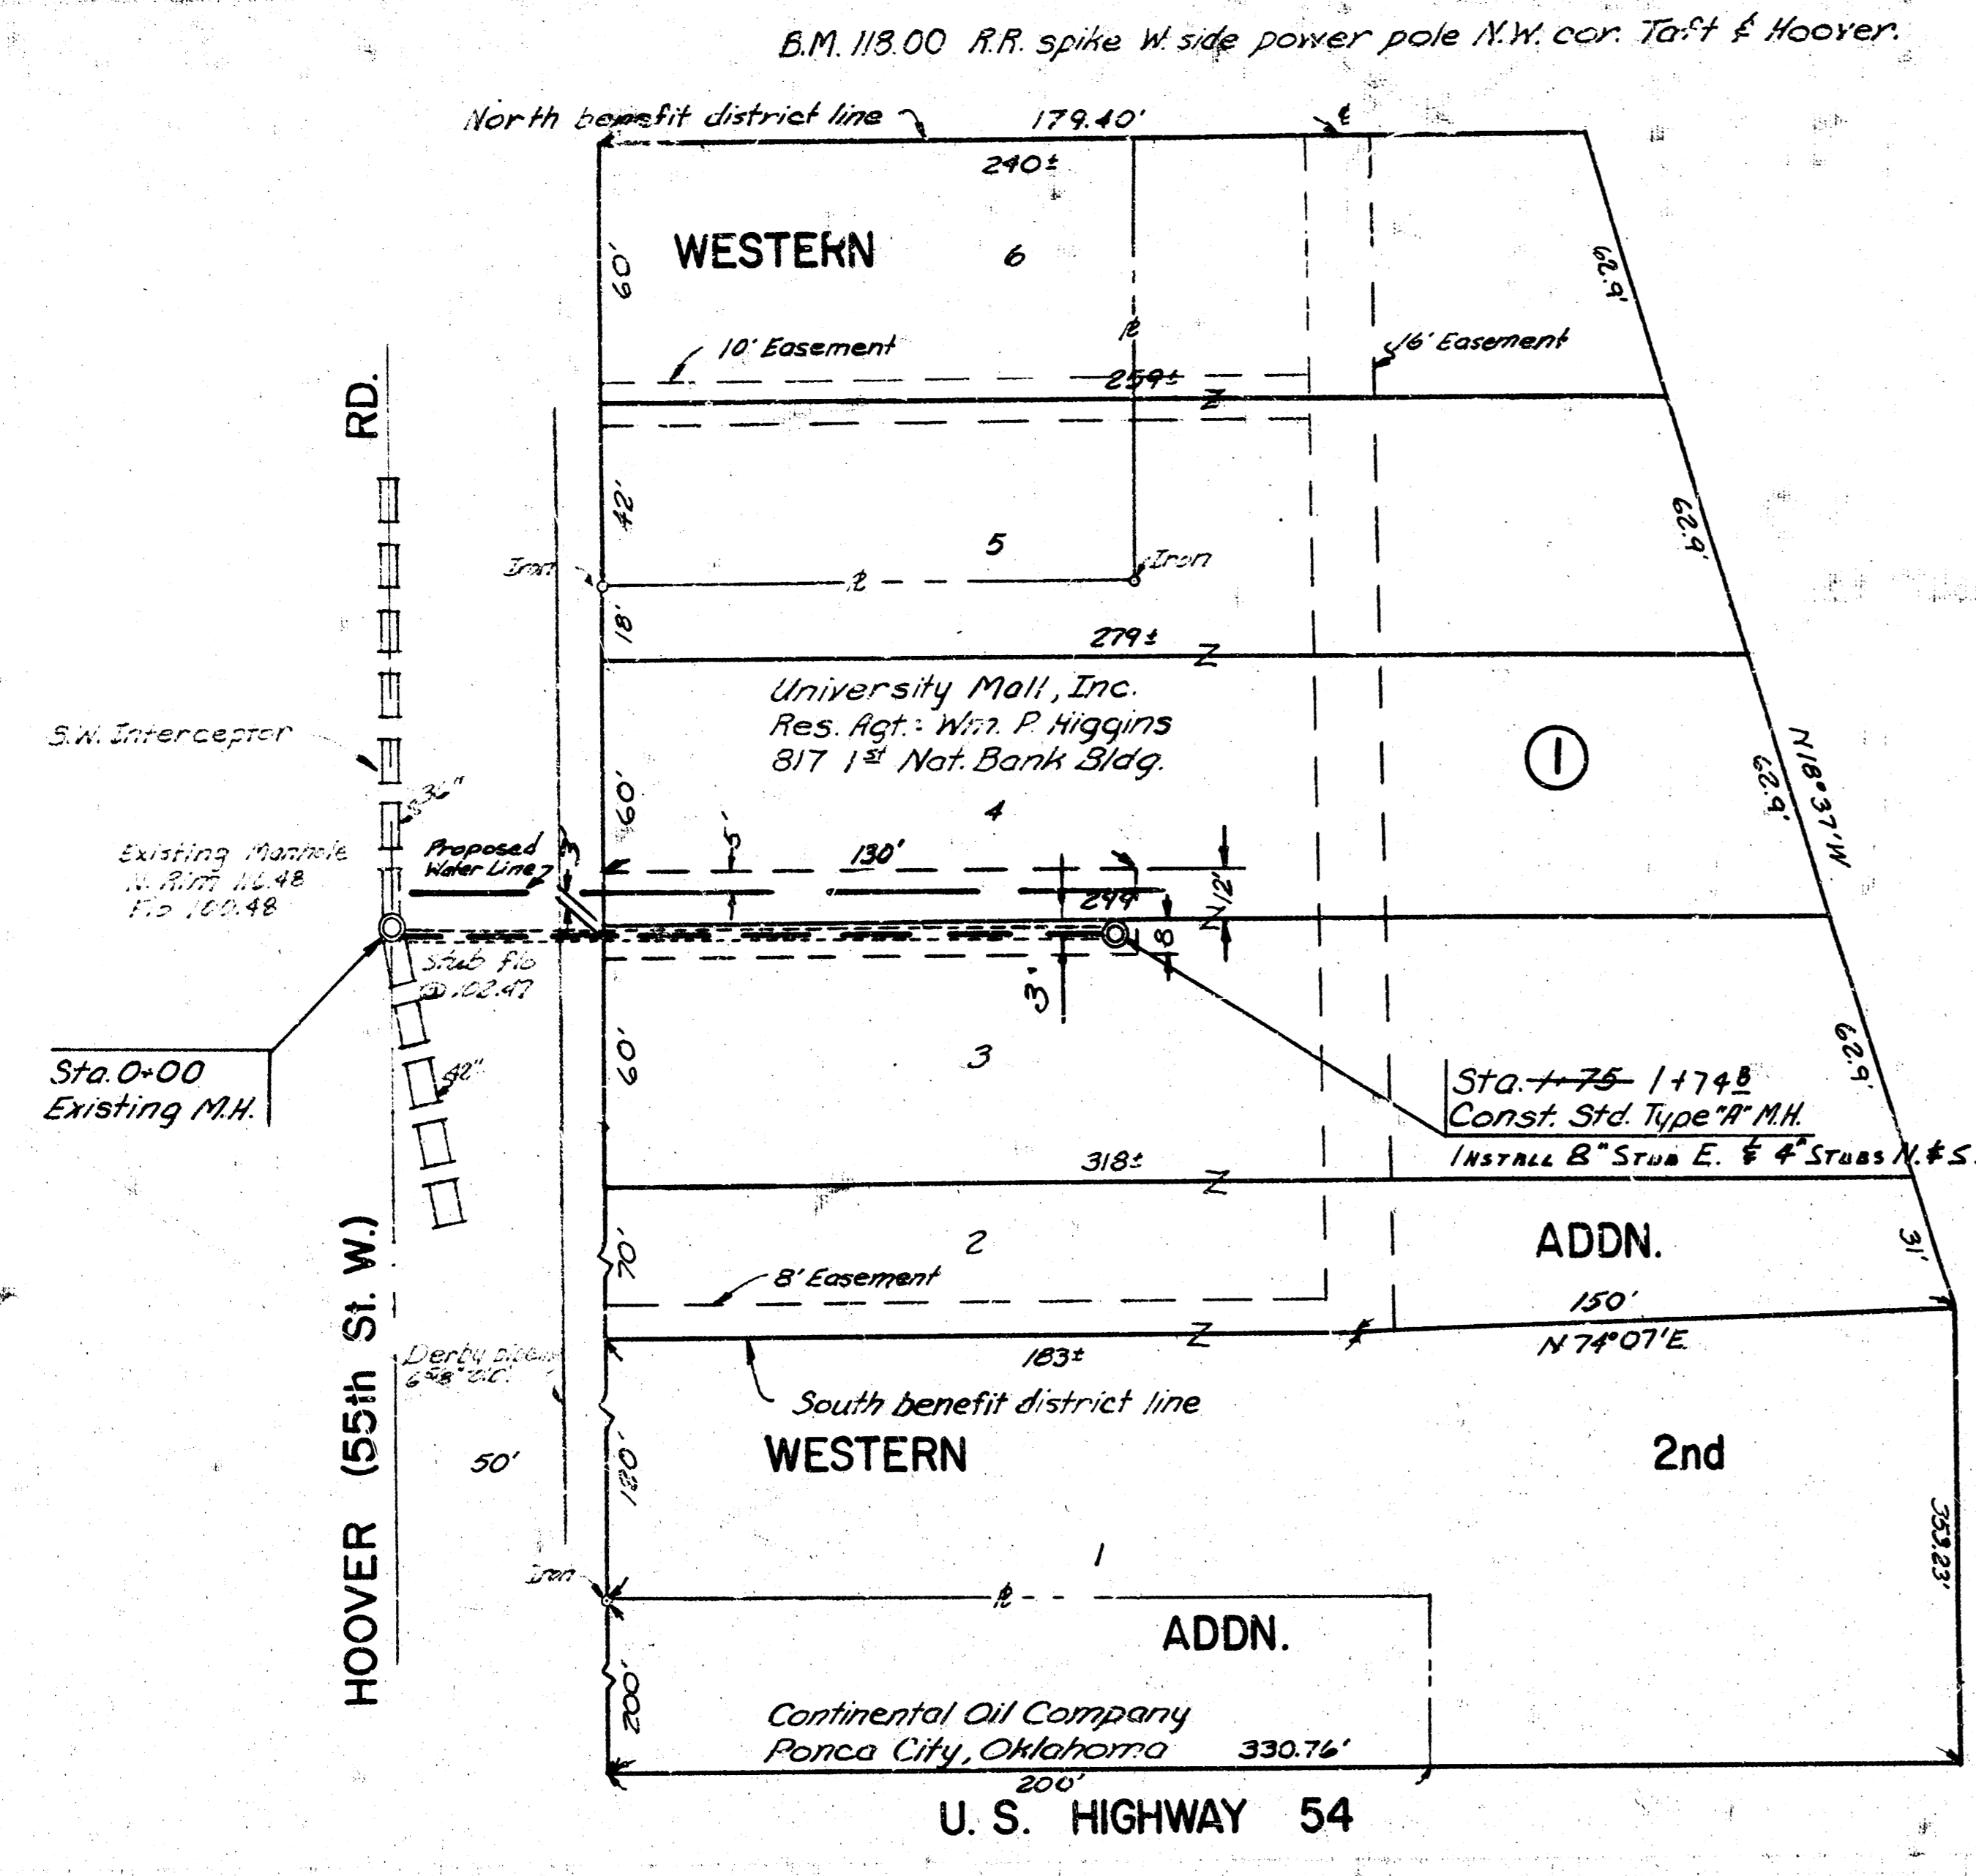


Note: Contractor shall contact Ben Atkins of Derby Pipe Line Co. prior to crossing under Derby pipeline. Ph. no. 755-1591.

Note: Field Engineer shall check stub's flow elevation prior to construction of sanitary sewer.

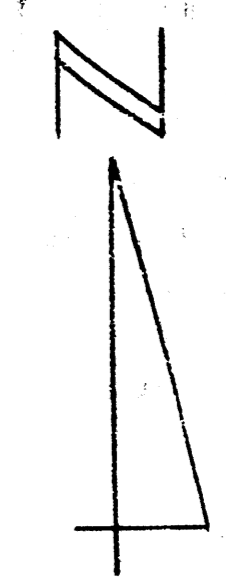

Plan Scale 1"=40'
 Profile Scale Max. 1"=40'
 Profile Scale Var. 1"=5'

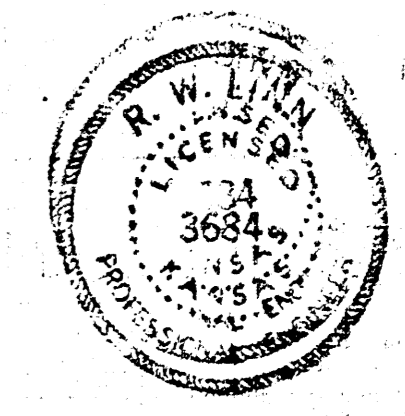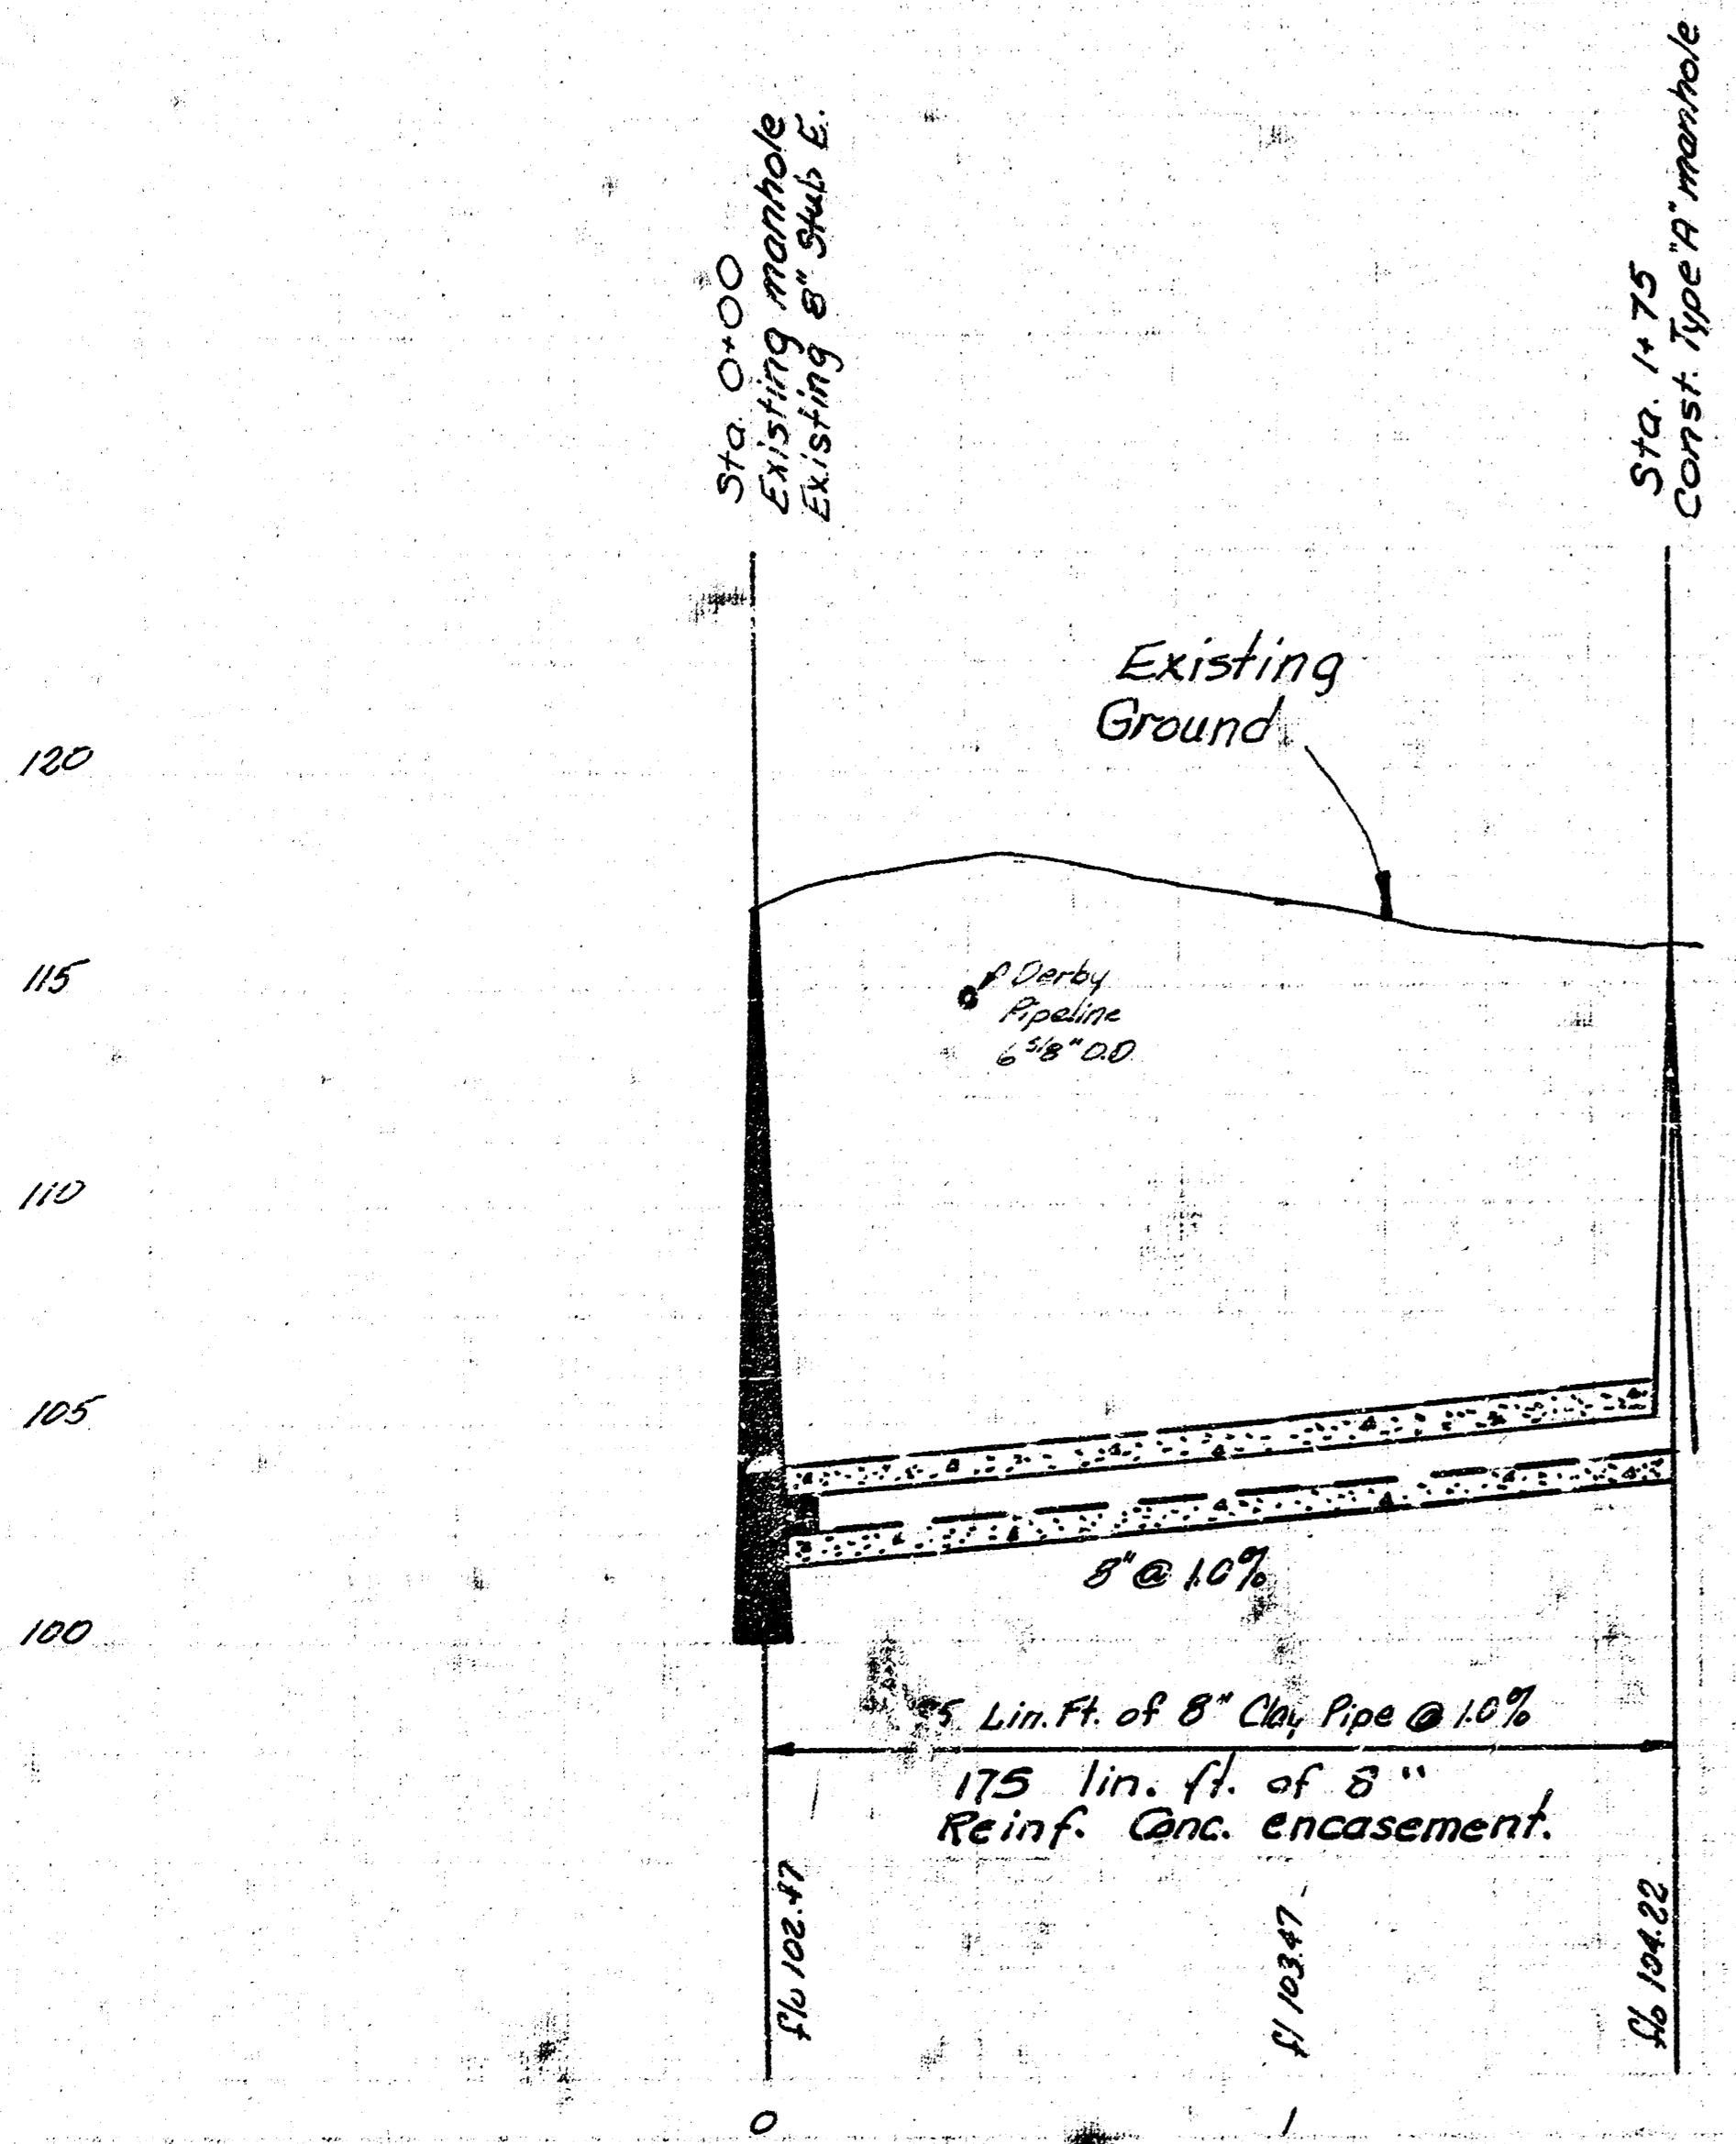

As Built Final Measurements 11-22

LAT. 50 S.W. INTERCEPTOR
 R. W. LINN CITY ENGINEER
 CITY OF WICHITA, KS.
 PROJ. NO. DBKL 572033
 DATE 7-72

FILMED FROM THE BEST