

3. M. 109.35 R.R. Spk. in N.S.
P.P. N.W. cor. Hoover & 31st
St. So.

CONSTRUCTION TO BE DONE IN THE AREA OF THE
EXIST. MANHOLE SHALL BE DONE AT THE
COST OF THE CITY ENGINEER'S OFFICE.

Sta. 11254 Const.
Std. M.H. Type "B"
Install 8" x 15" Stub No.
at 0.40% grade.
Install 4" Stub N.E.

NOTE: Replace 24" R.C.P.
Replace gravel drive.
Replace A.C. mat.

Sta. 11250 Const. Std. M.H.
Type "A"

CAUTION:
S.W. Bell Tele.
underground cable
6" x 1" W. of E.R.
Cell 268-1556
prior to construction.

Sta. 71400 Const. Std. M.H.
Type "A"
Install 6" Stub East


Sta. 01000
Exist. M.H.
8" Opening is 3' South
of Center of manhole.

NOTE: Replace fence.

Exist. 4" Continental Jet Fuel line
4 strand barbed wire inc.
City Service pipe line


NOTE: Remove Stone coping.
Do not replace.

EXIST. M.H.
8" x 15" Stub
FLO. OUT 91.09
8" Stub S. 93.00

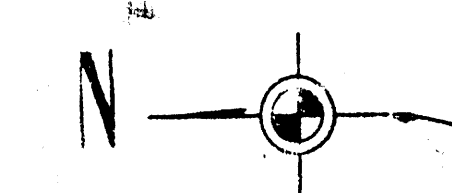

Plan Scale 1" = 40'
Profile Scale 1" = 5'

CAUTION
UNDERGROUND
UTILITIES

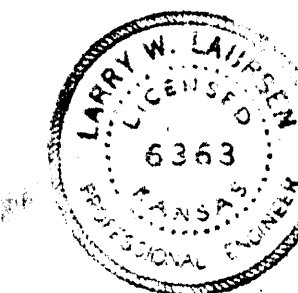

110

105

100

95

90

110

105

100

95

90

Sta. 01000 Exist. M.H.
8" Opening is 3' South
of Center of manhole.
Exist. City Service 4" pipe line
Exist. Continental Jet Fuel line.

A.C. mat.
Gravel
Sta. 11254 Const.
Std. M.H. Type "B"
Install 8" x 15" Stub No.
at 0.40% grade.
Install 4" Stub N.E.
Exist. 24" R.C.P.

Sta. 11250 Const.
Std. M.H. Type "A"

Sta. 71400 Const.
Std. M.H. Type "A"
Install 6" Stub East

93.75 Flo. in
8" Stub East

93.88 Flo. out
93.80 Flo. in
8" Stub East
@ 0.40% grade

6146 Lin. ft. of 8" clay pipe at 0.40% grade.

As Built Final Meas. K-106

LAT. 51, S.W. INTERCEPTOR SEWER
CITY OF WICHITA, KANSAS
R. W. LINN - CITY ENGINEER
JAN. 1973 PROJECT NO. DBKL572045

18