



Over Hwy
Rte 76

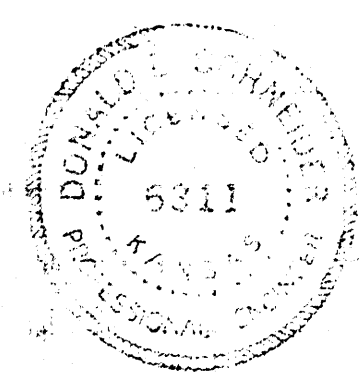

As built 2-9-77

LAT 54 SWI
CITY OF WICHITA, KANSAS
R. W. LINN - CITY ENGINEER
Project No. DBKL572057

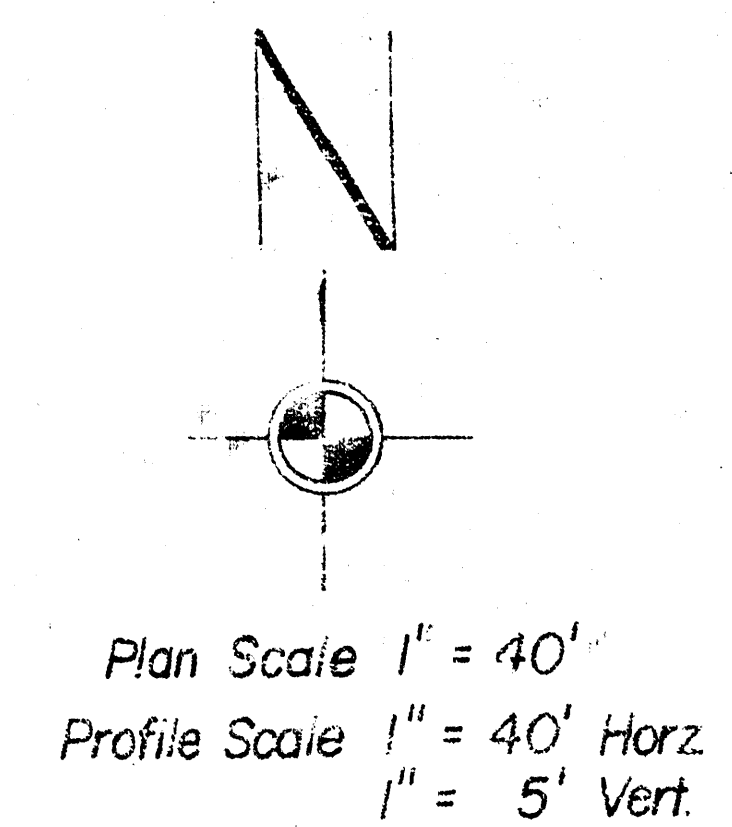