



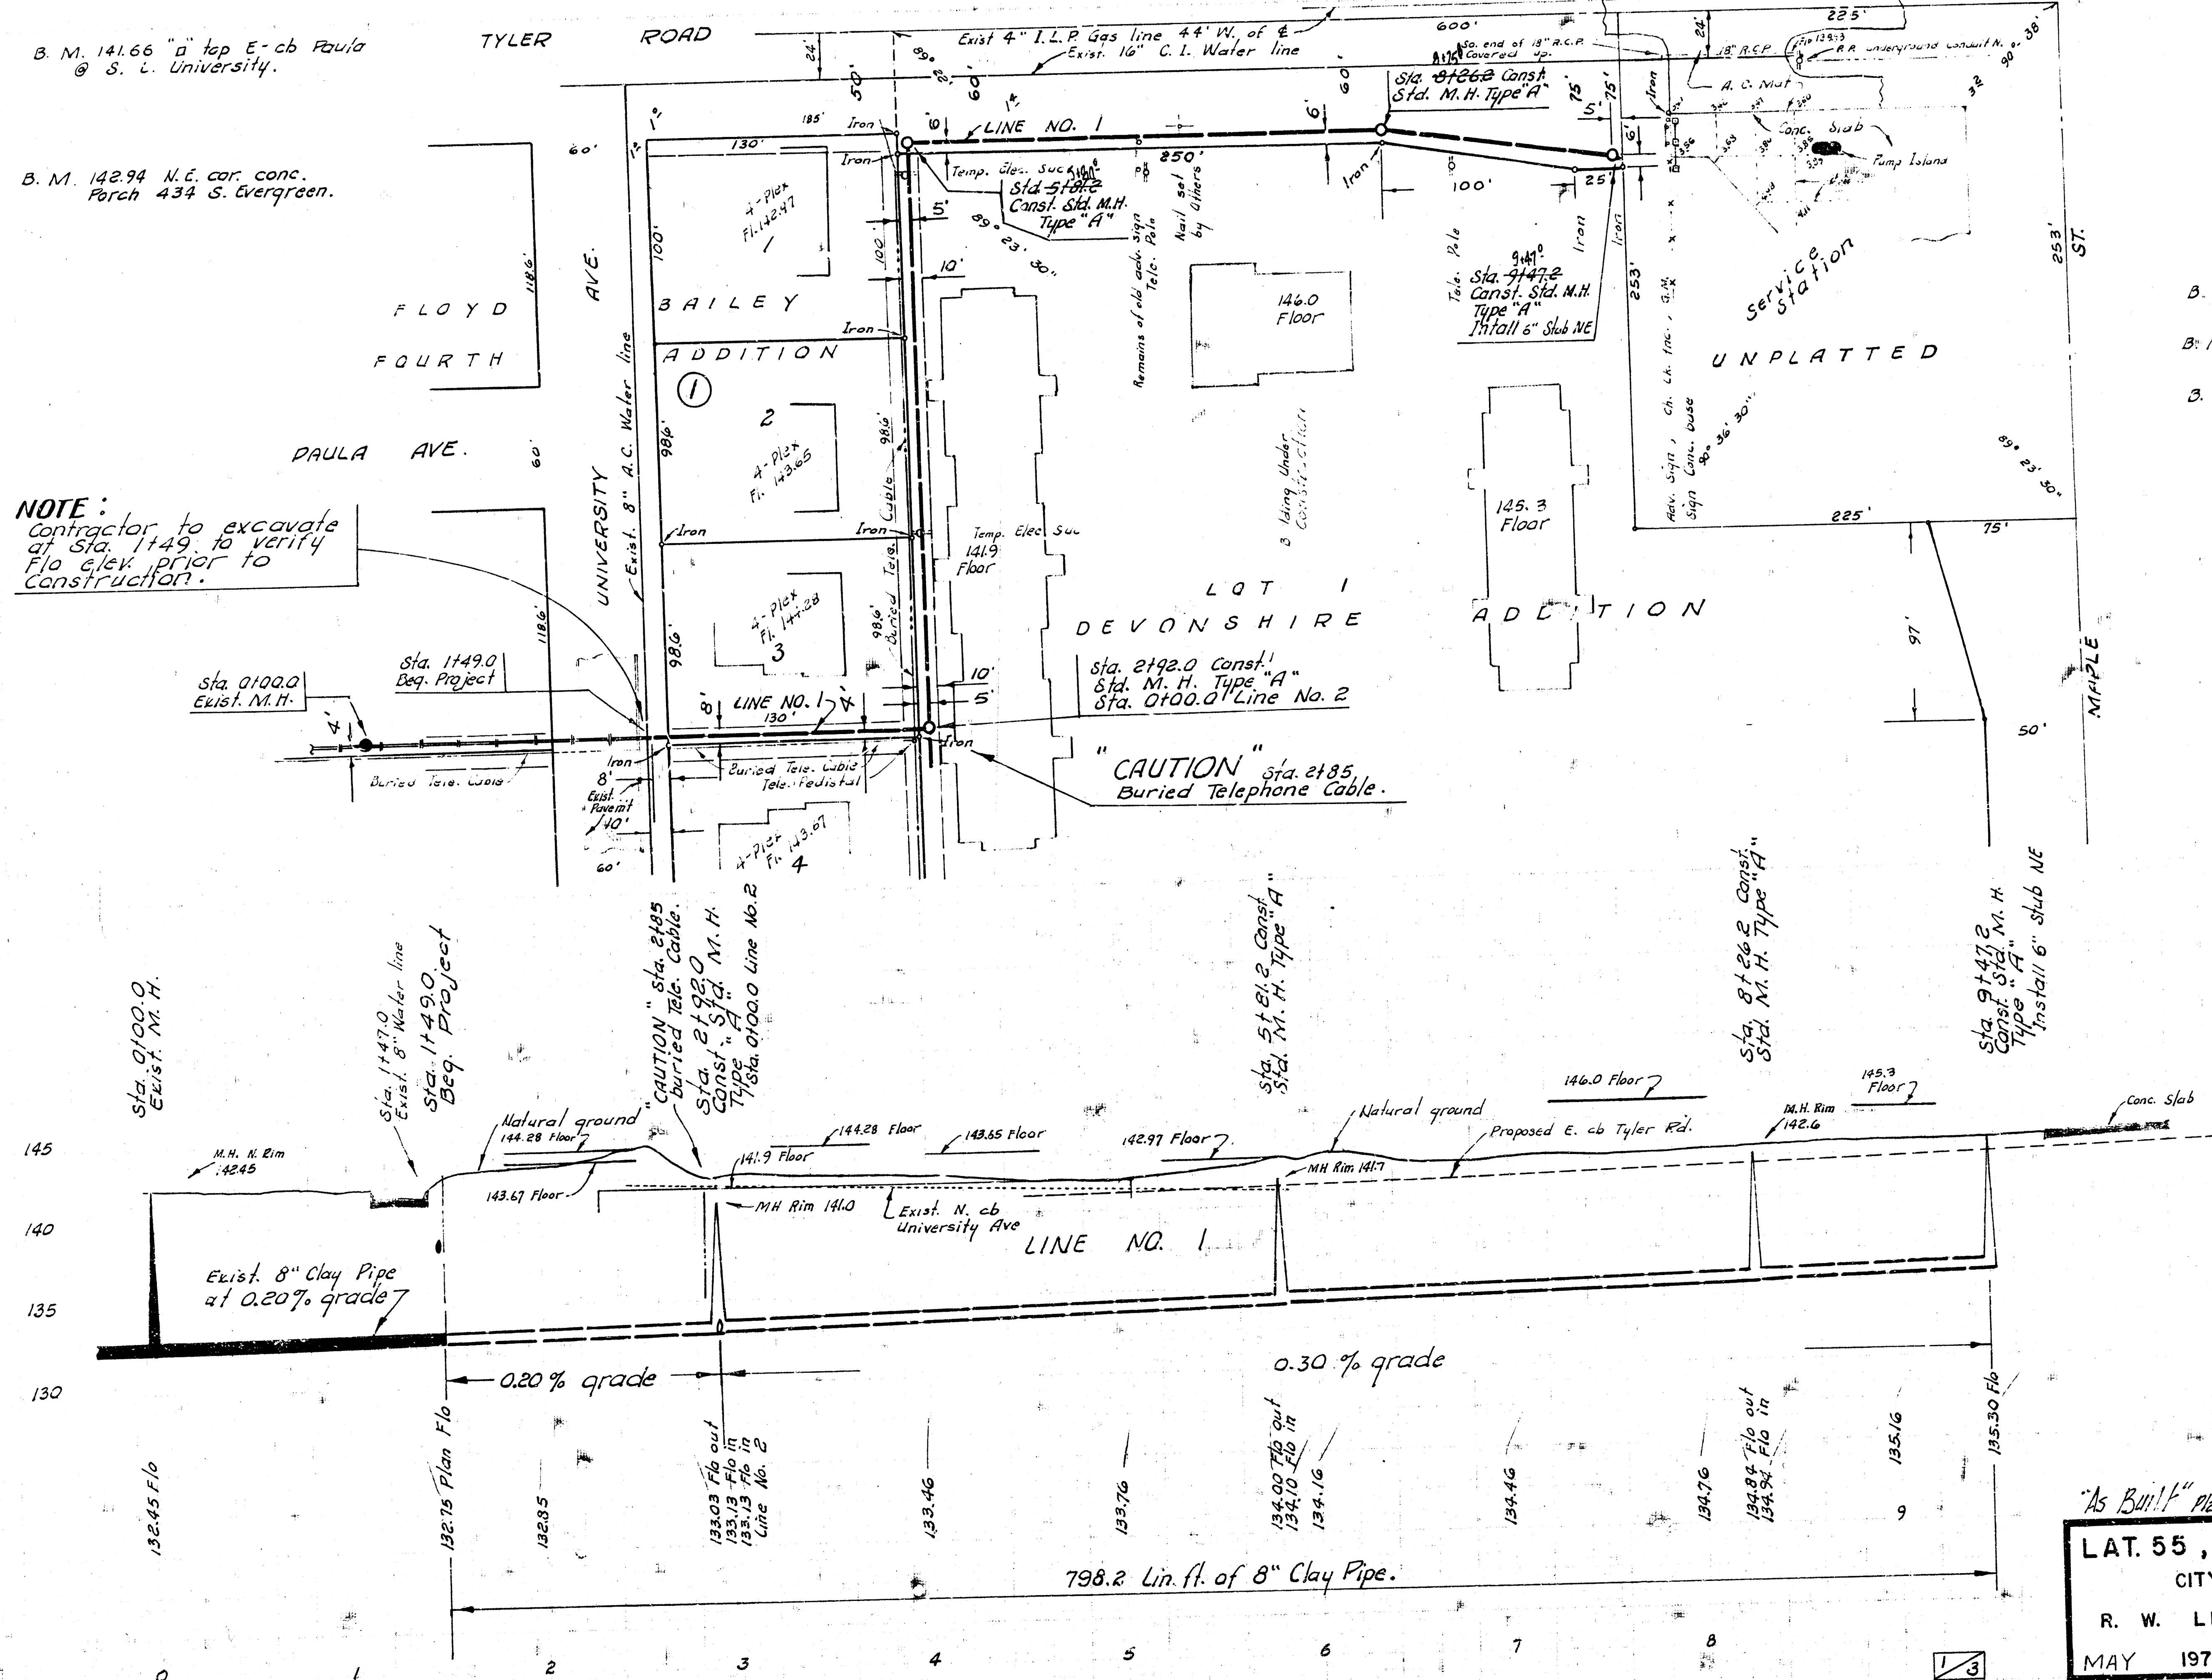

B. M. 141.66 "a" top E. cb Paula
@ S. L. University.

B. M. 142.94 N.E. cor. conc.
Porch 434 S. Evergreen.

NOTE:
Contractor to excavate
at Sta. 1149.0 to verify
Flo elev prior to
construction.

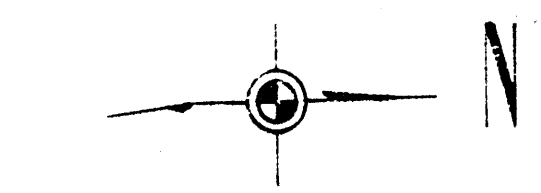


Plan Scale 1" = 40'
Profile Scale 1" = 40' Horiz.
1" = 5' Vert.

B. M. 143.53 Std. 34.2' E. and 27.2'
S. of E. Tyler and Maple.

B. M. 139.31 R. R. Spk. E. face P. P. S. W.
cor. Tyler Rd. & University.

B. M. 141.76 "a" Top S-cb University
at West end of Rad. 1st curve
east of Robin Road.

CAUTION
UNDERGROUND
UTILITIES

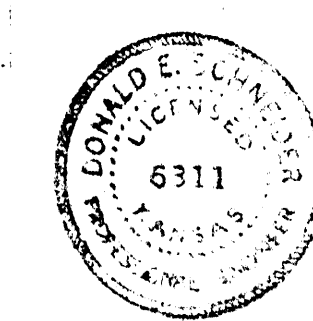



"As Built" Plan from K-108

LAT. 55, S. W. INTERCEPTOR SEWER
CITY OF WICHITA, KANSAS

R. W. LINN — CITY ENGINEER

MAY 1973 PROJECT NO. DBKL 572058

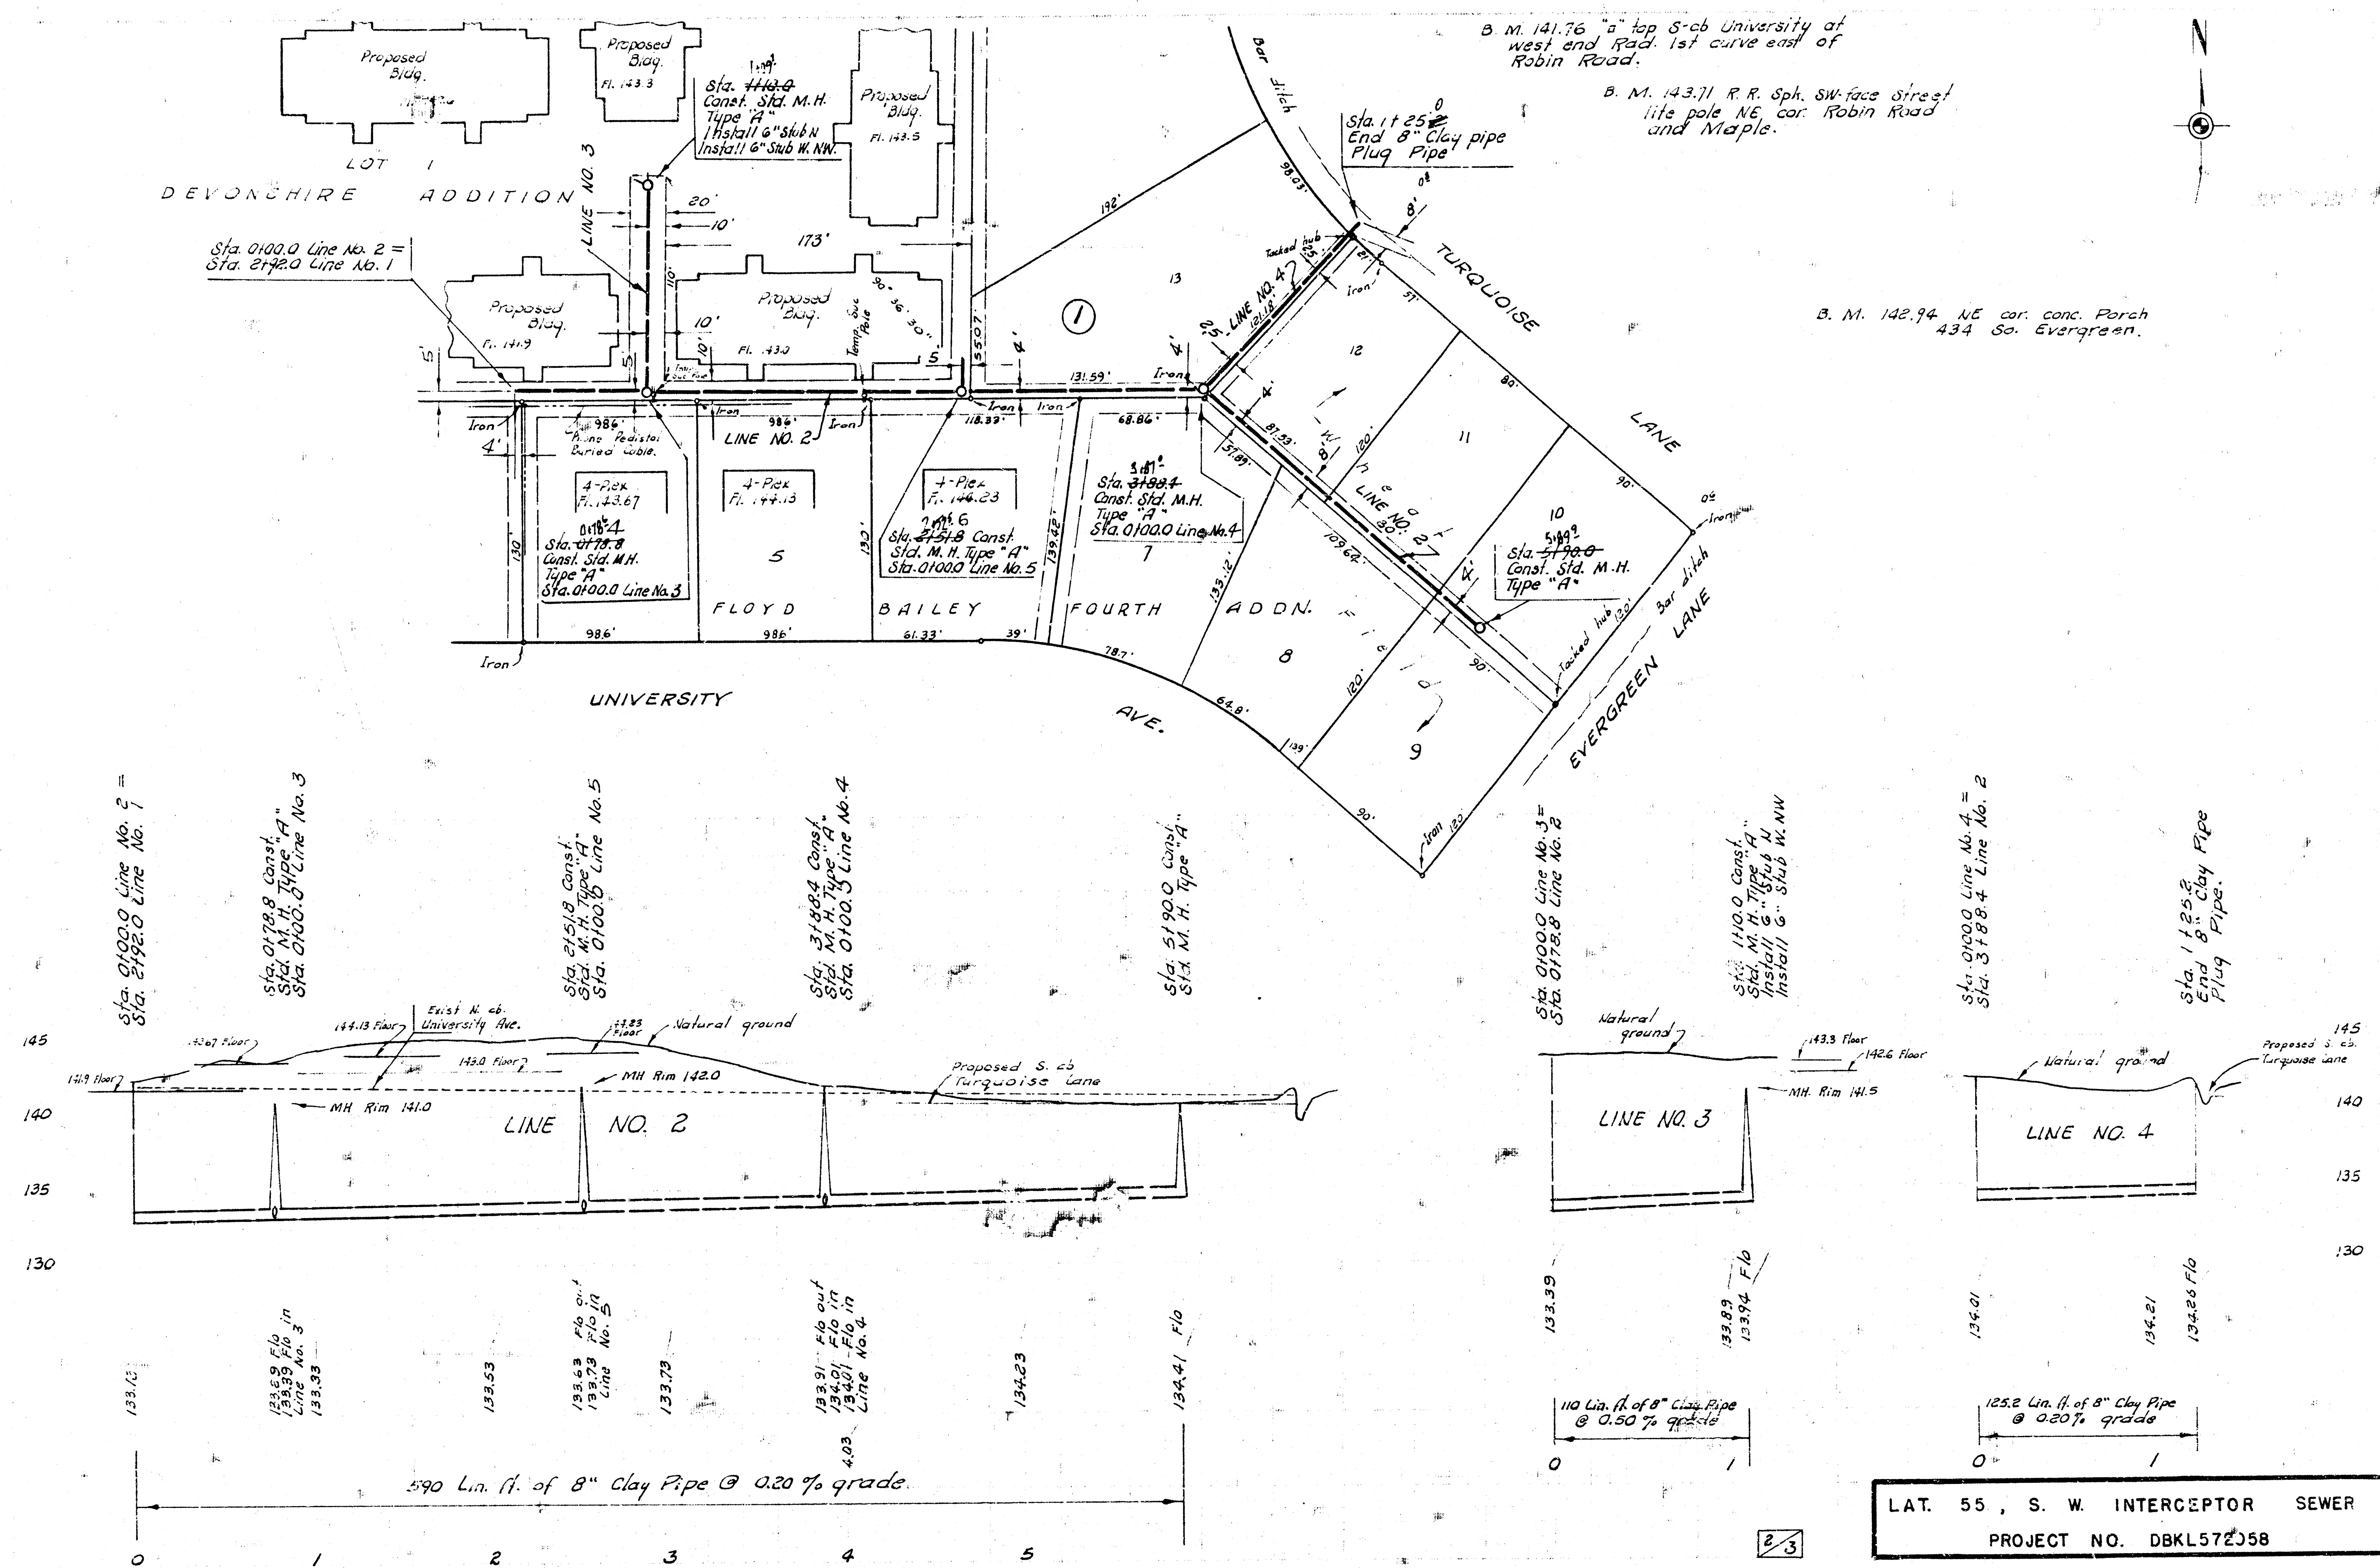

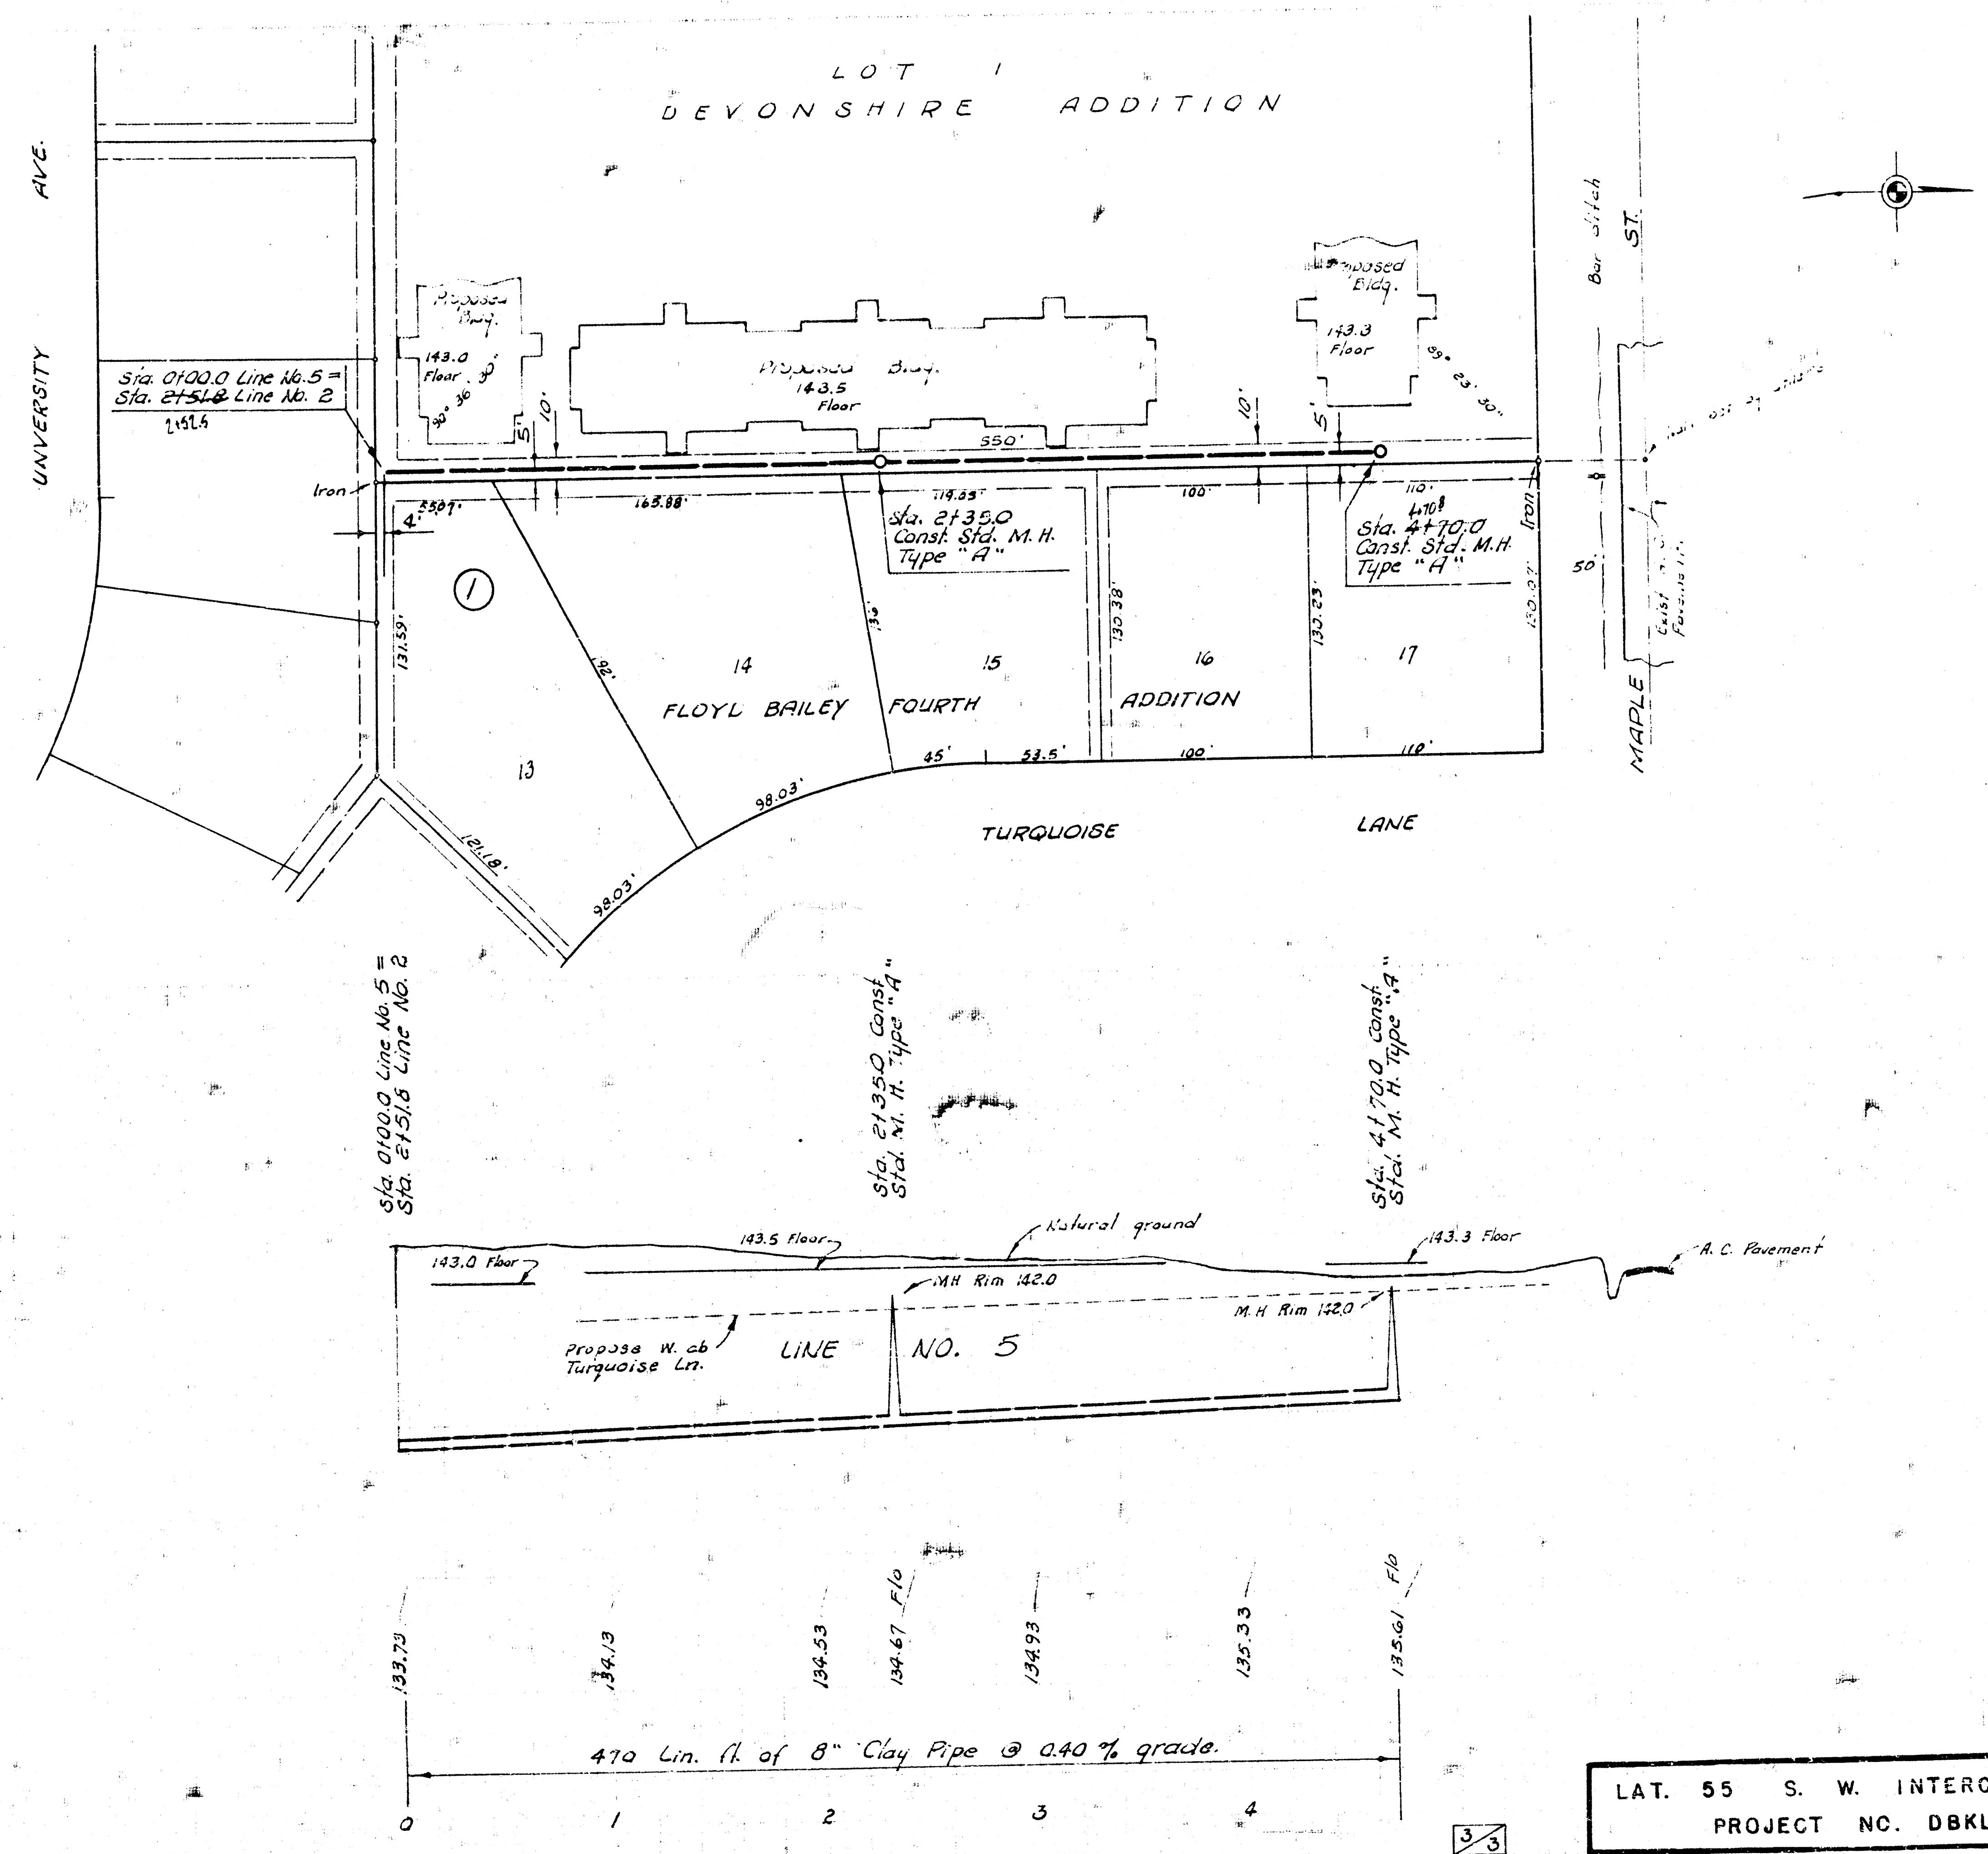

LAT. 55 S. W. INTERCEPTOR SEWER
PROJECT NO. DBKL572058