



B.M. 148.10 City Std. @ Ridge Rd. & 13th St.
 B.M. 159.71 N.E. cor. conc. porch No. 1525 N. Holland.

217
 218
 219

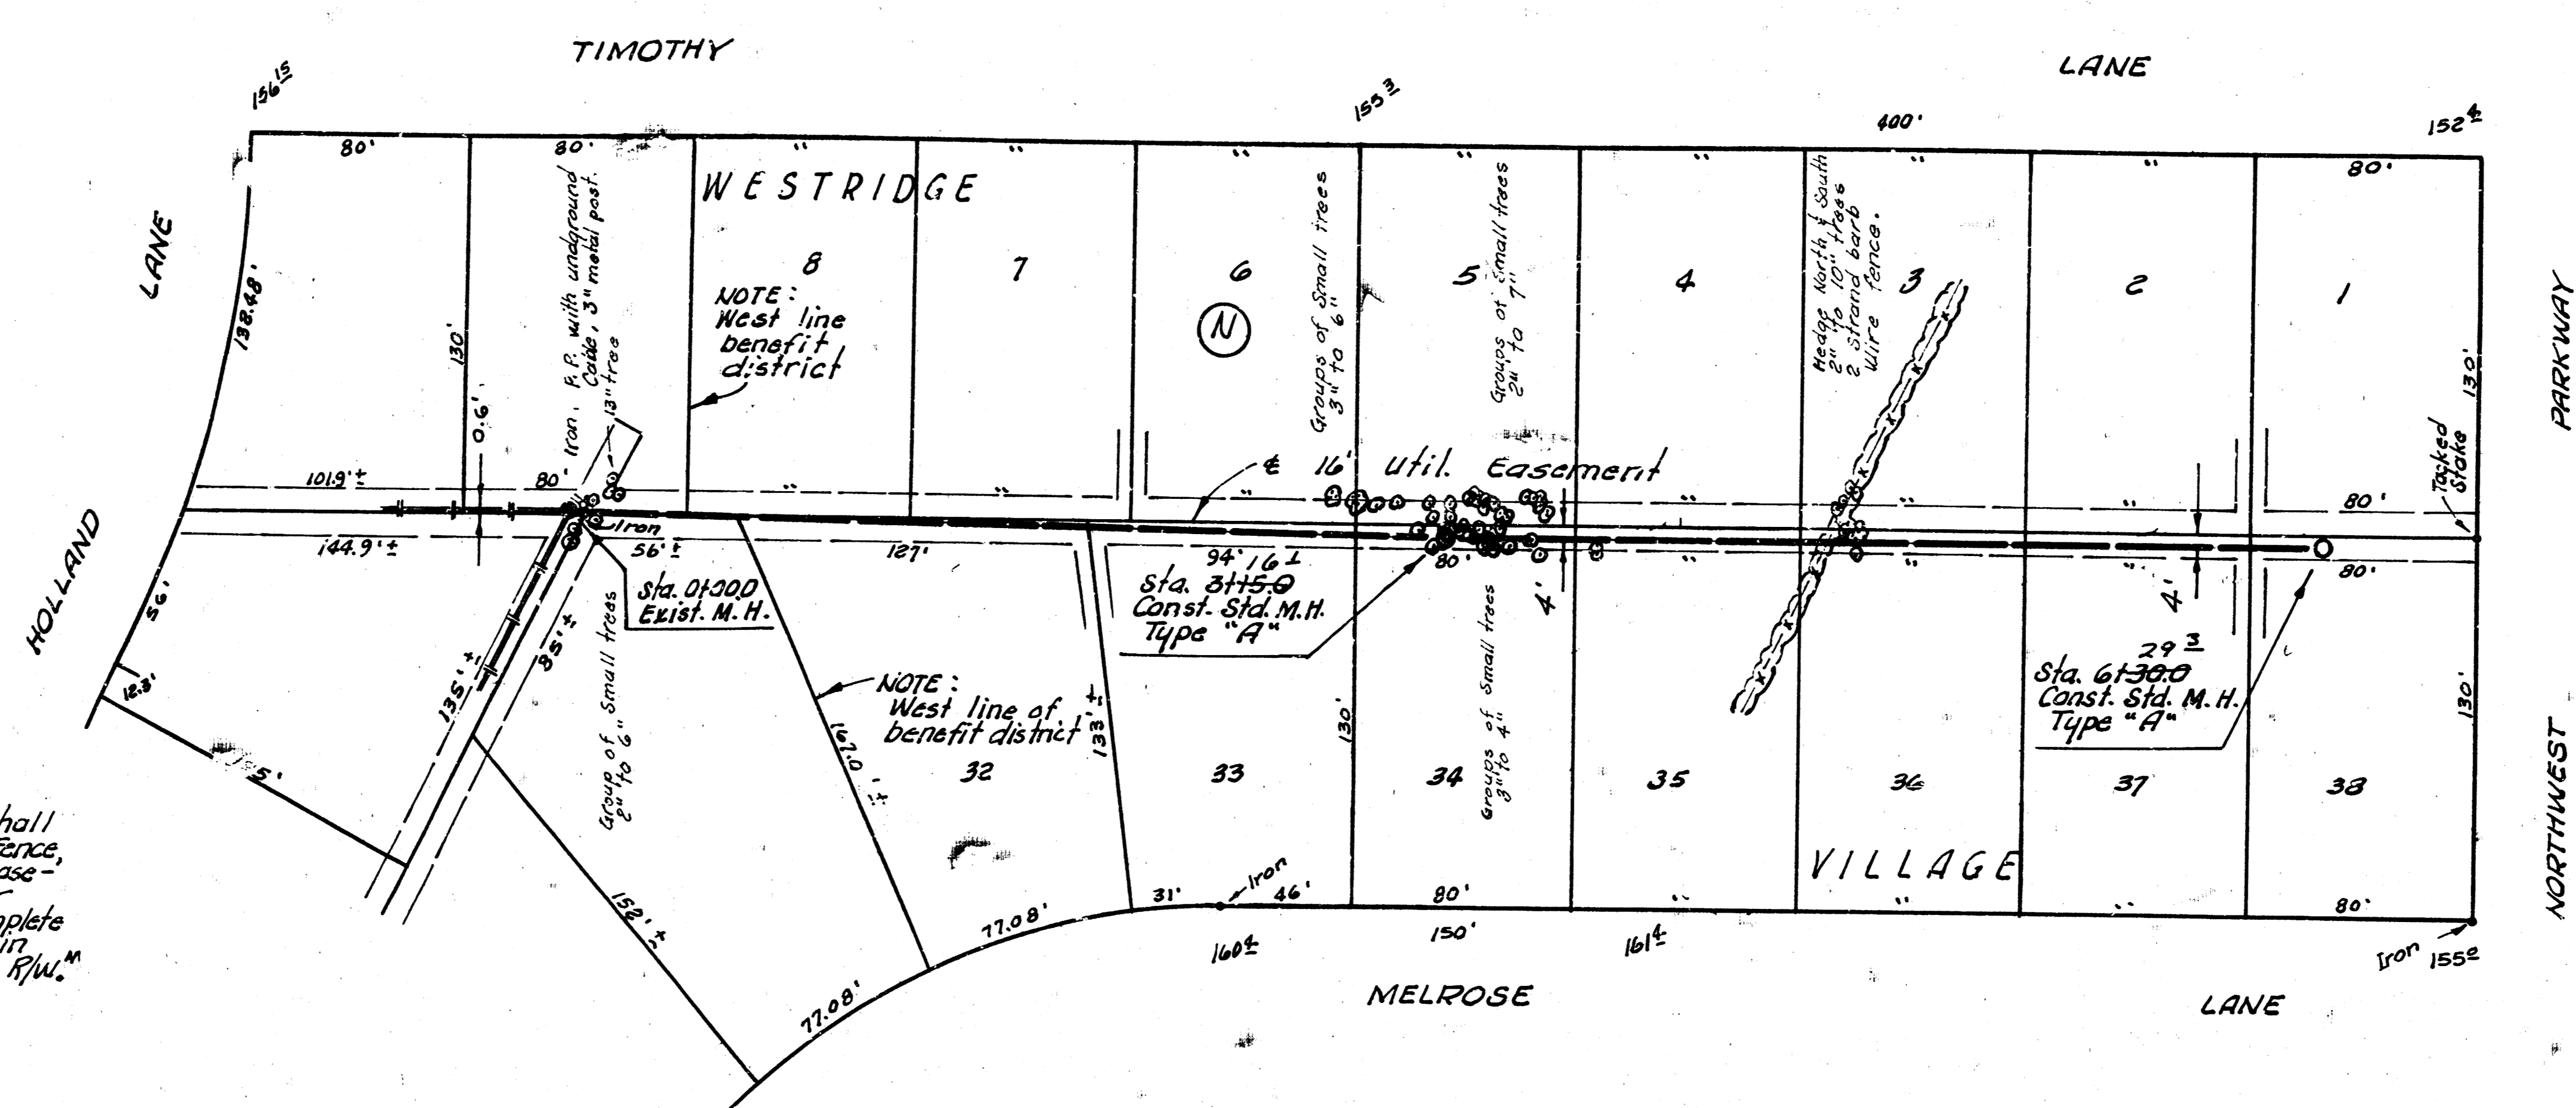

NOTE:
 Clearing of Right-of-Way shall include removal of all trees, fence, hedge and etc. within the easement. All equipment, labor and tools necessary to complete the items shall be included in price bid of "Lump Sum Clear R/W."

Plan Scale, 1" = 40'
 Profile Scale, 1" = 40' Horiz.
 1" = 5' Vert.

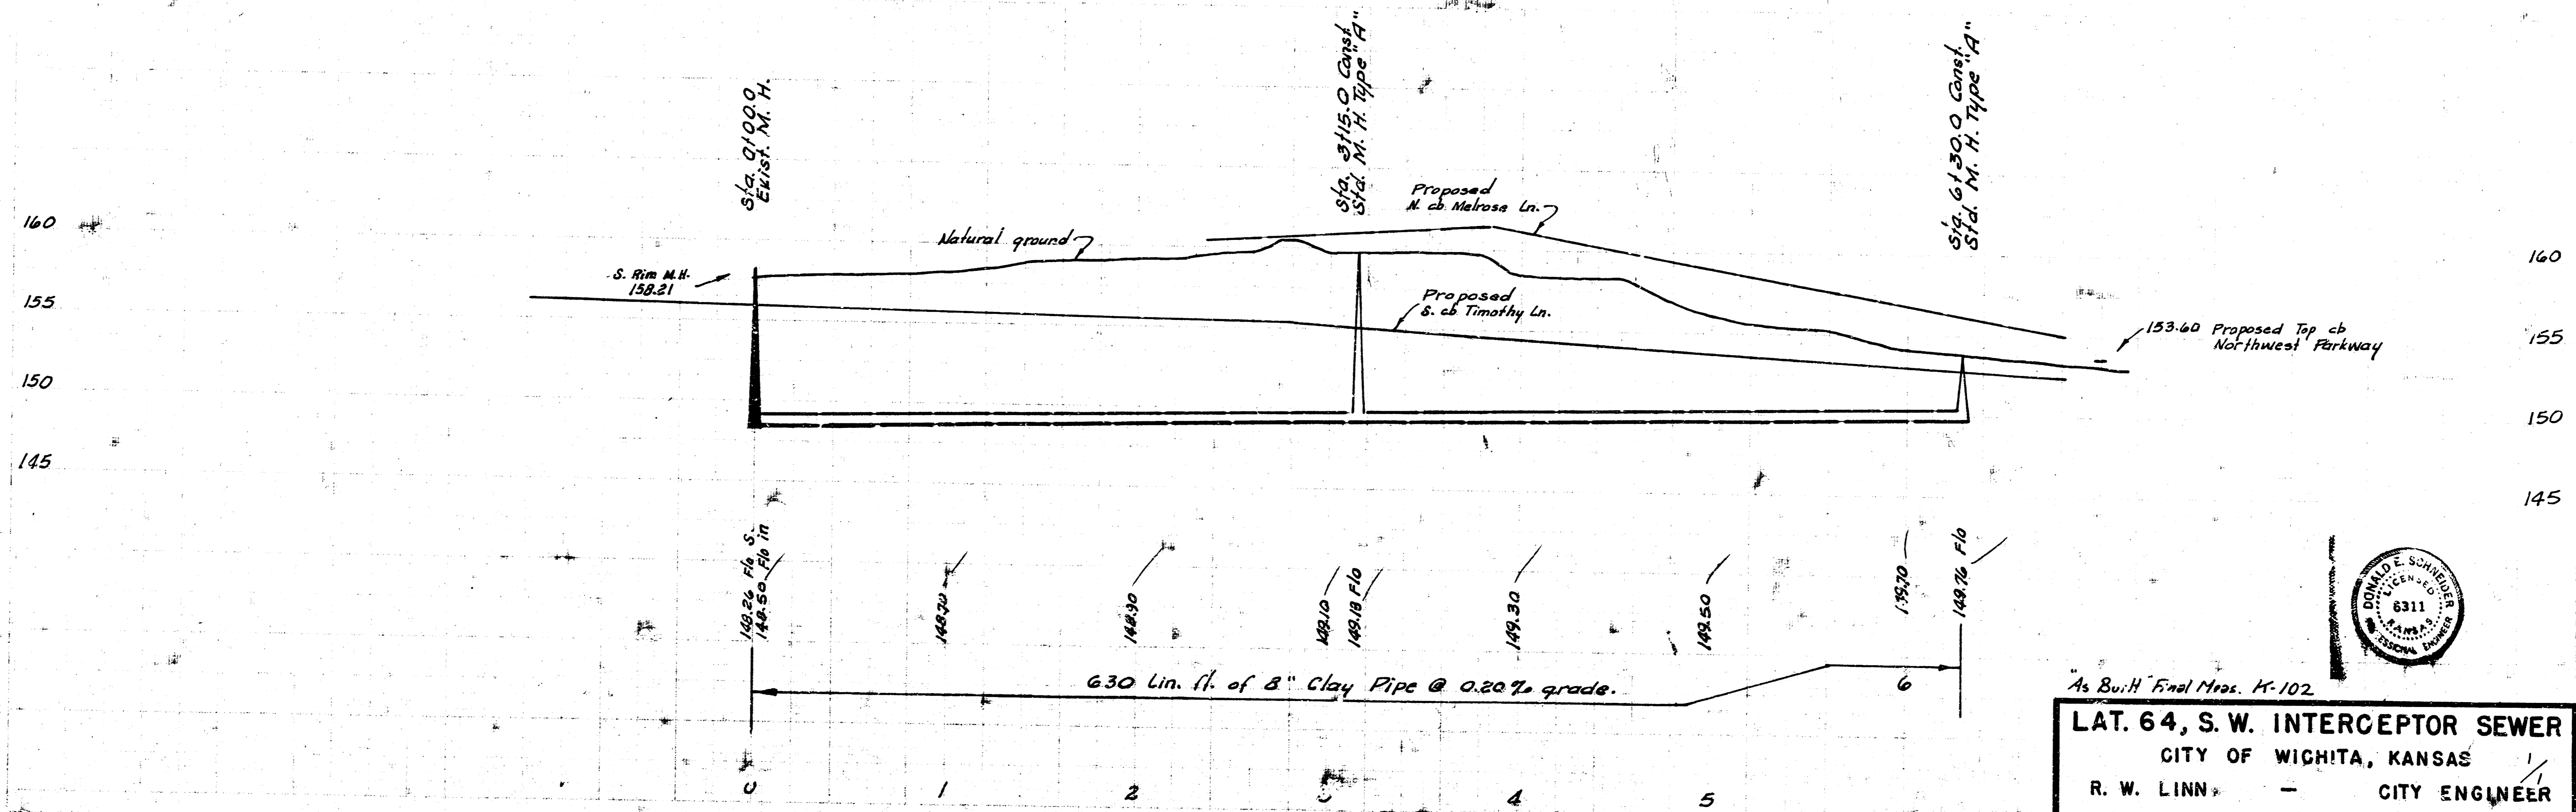

As Built Final Meas. K-102

LAT. 64, S. W. INTERCEPTOR SEWER
 CITY OF WICHITA, KANSAS
 R. W. LINN - CITY ENGINEER
 DEC. 1973 PROJECT NO. DBKL 573075

