


Plan Scale: 1"=40'
 Profile Scale: 1"=40' Horz.
 1"=5' Vert.


B.M. 157.04 R.R. Spike N. face Power Pole approx. 200' S. and 100' W. of NW corner Nantucket and Park.
 B.M. 156.63 R.R. Spike N. face Power Pole approx. 90' W. and 20' S. of NW corner 15th and Parkdale.

NOTE: PIPE BETWEEN STATION 0+00 AND STATION 1+71 ON THIS PROJECT SHALL BE SAME TYPE OF PIPE AS THAT WHICH IS TO BE INSTALLED BY CONTRACTOR FOR CONSTRUCTING LATERAL 111, SOUTHWEST INTERCEPTOR.

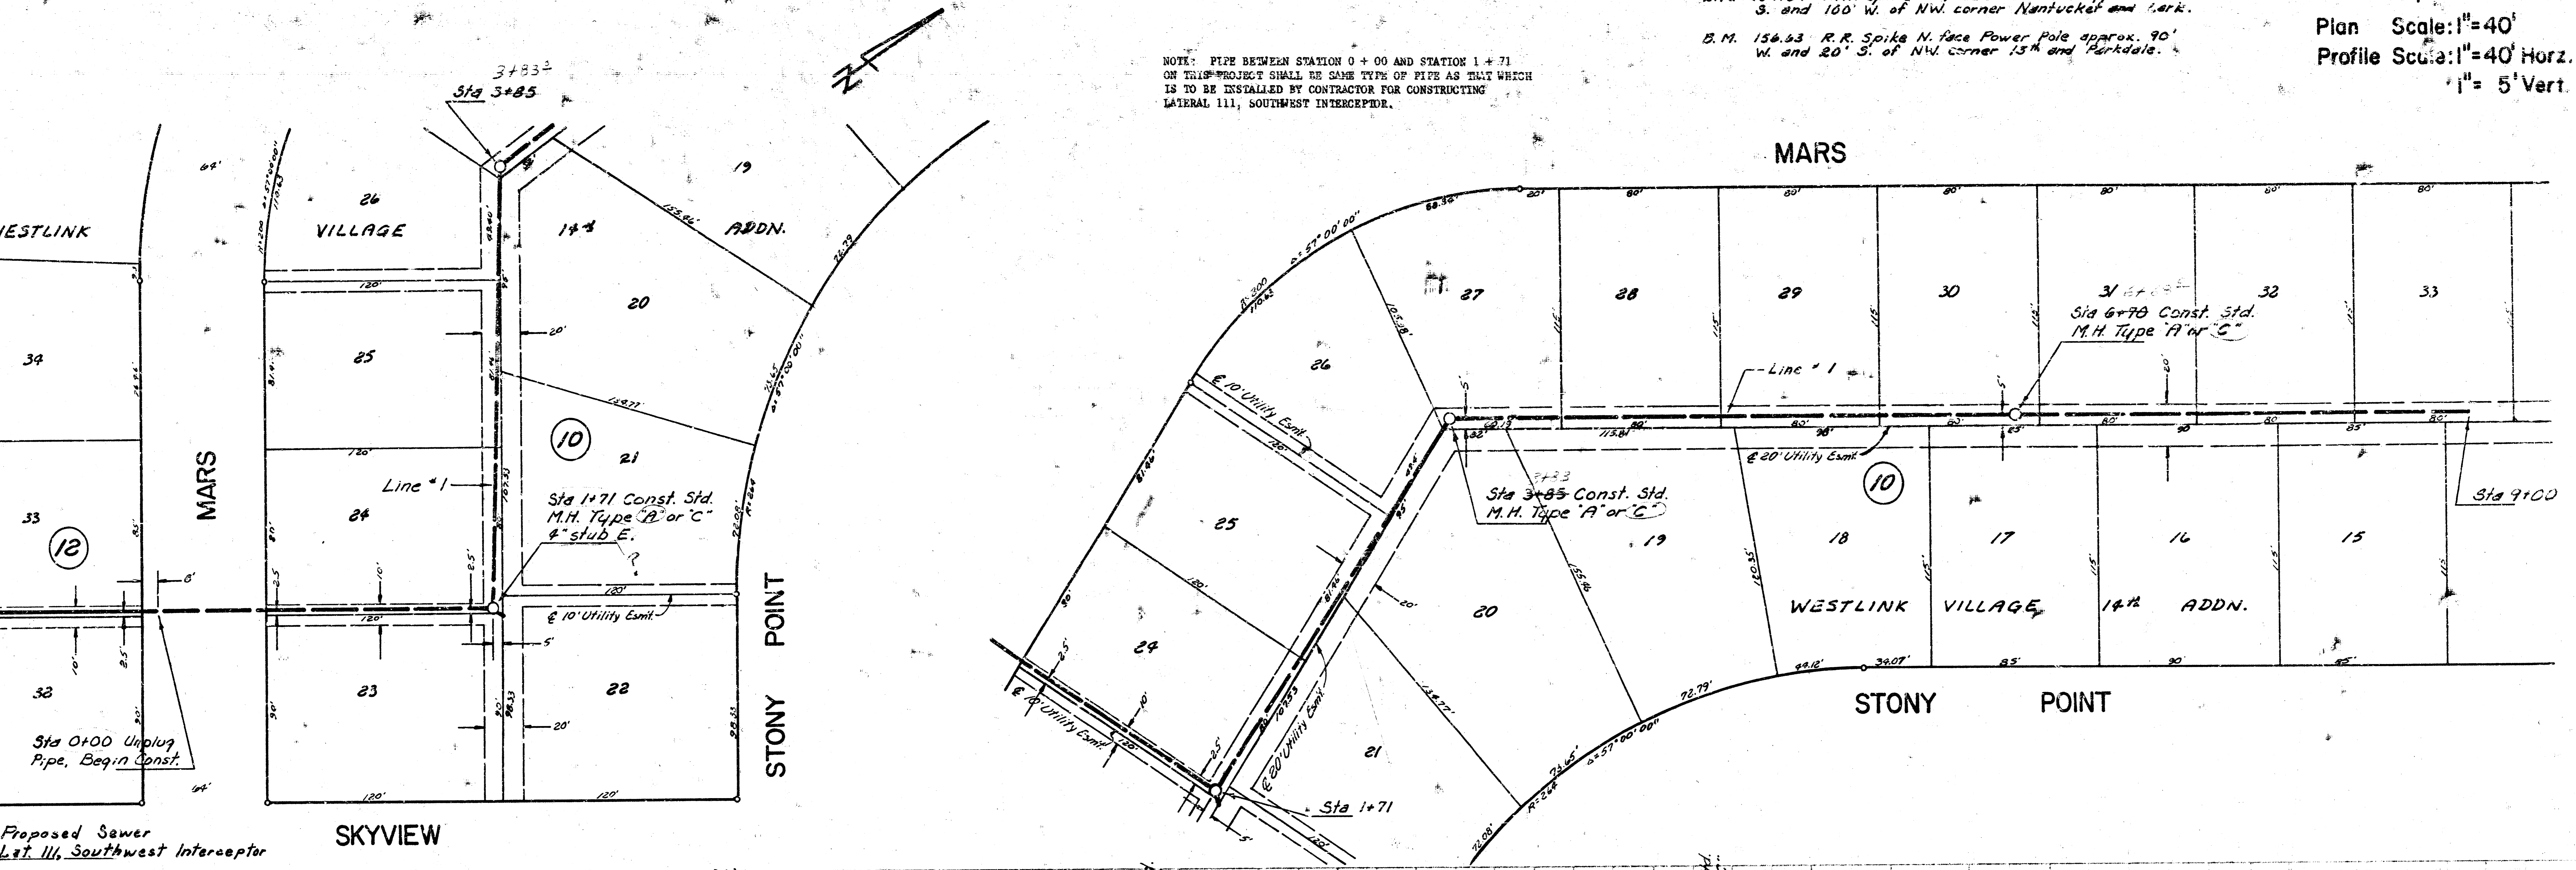

Proposed Sewer Lat. 111, Southwest Interceptor

SKYVIEW

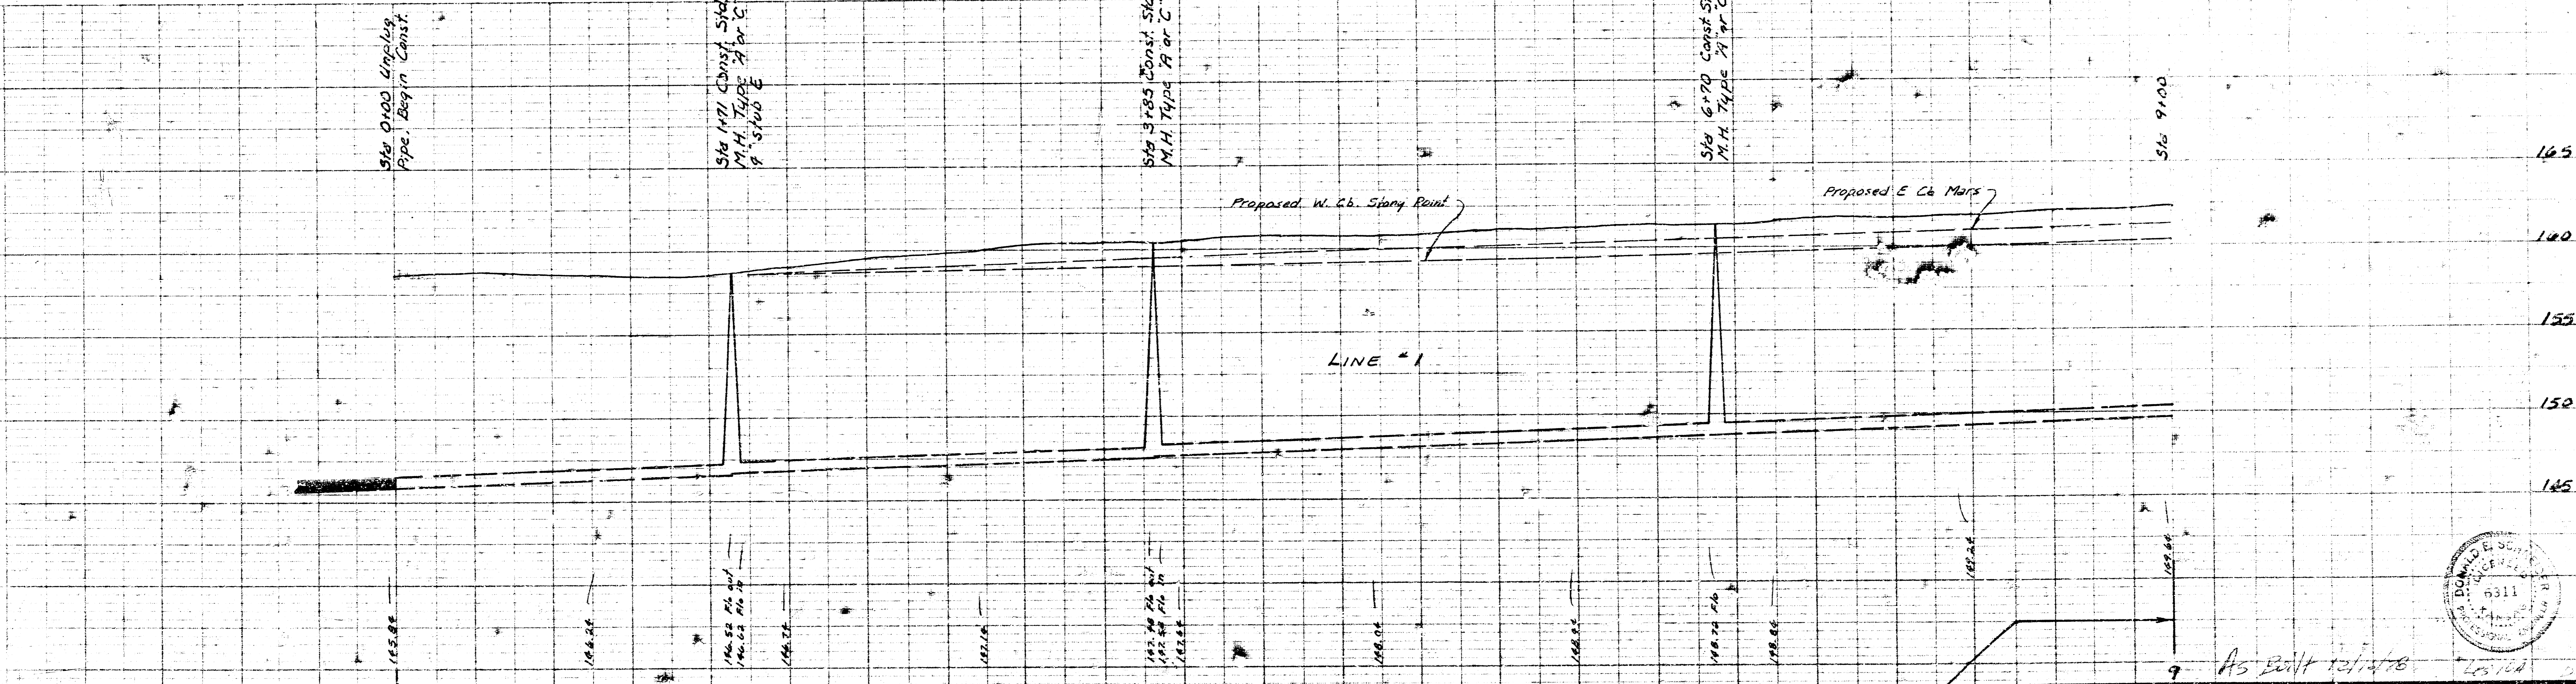


900 L.F. of 8" Clay Pipe @ 0.40% Grade
 Alternate 8" A.B.S. Composite Pipe


As Built relative to 1910

LAT 92 SOUTHWEST INTERCEPTOR
 CITY OF WICHITA, KANSAS


R.W. LINN CITY ENGINEER
 PROJECT NUMBER: 468-76-245-80352-000-000-001

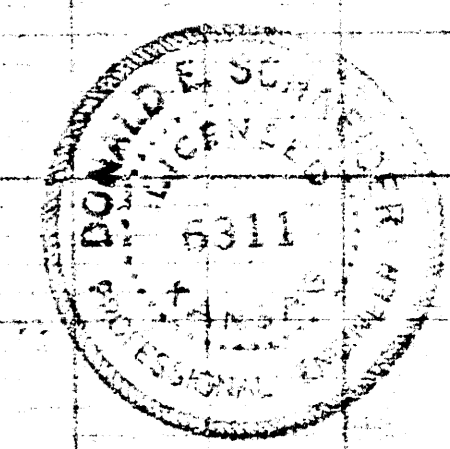

Plan Scale:
 Profile Scale:

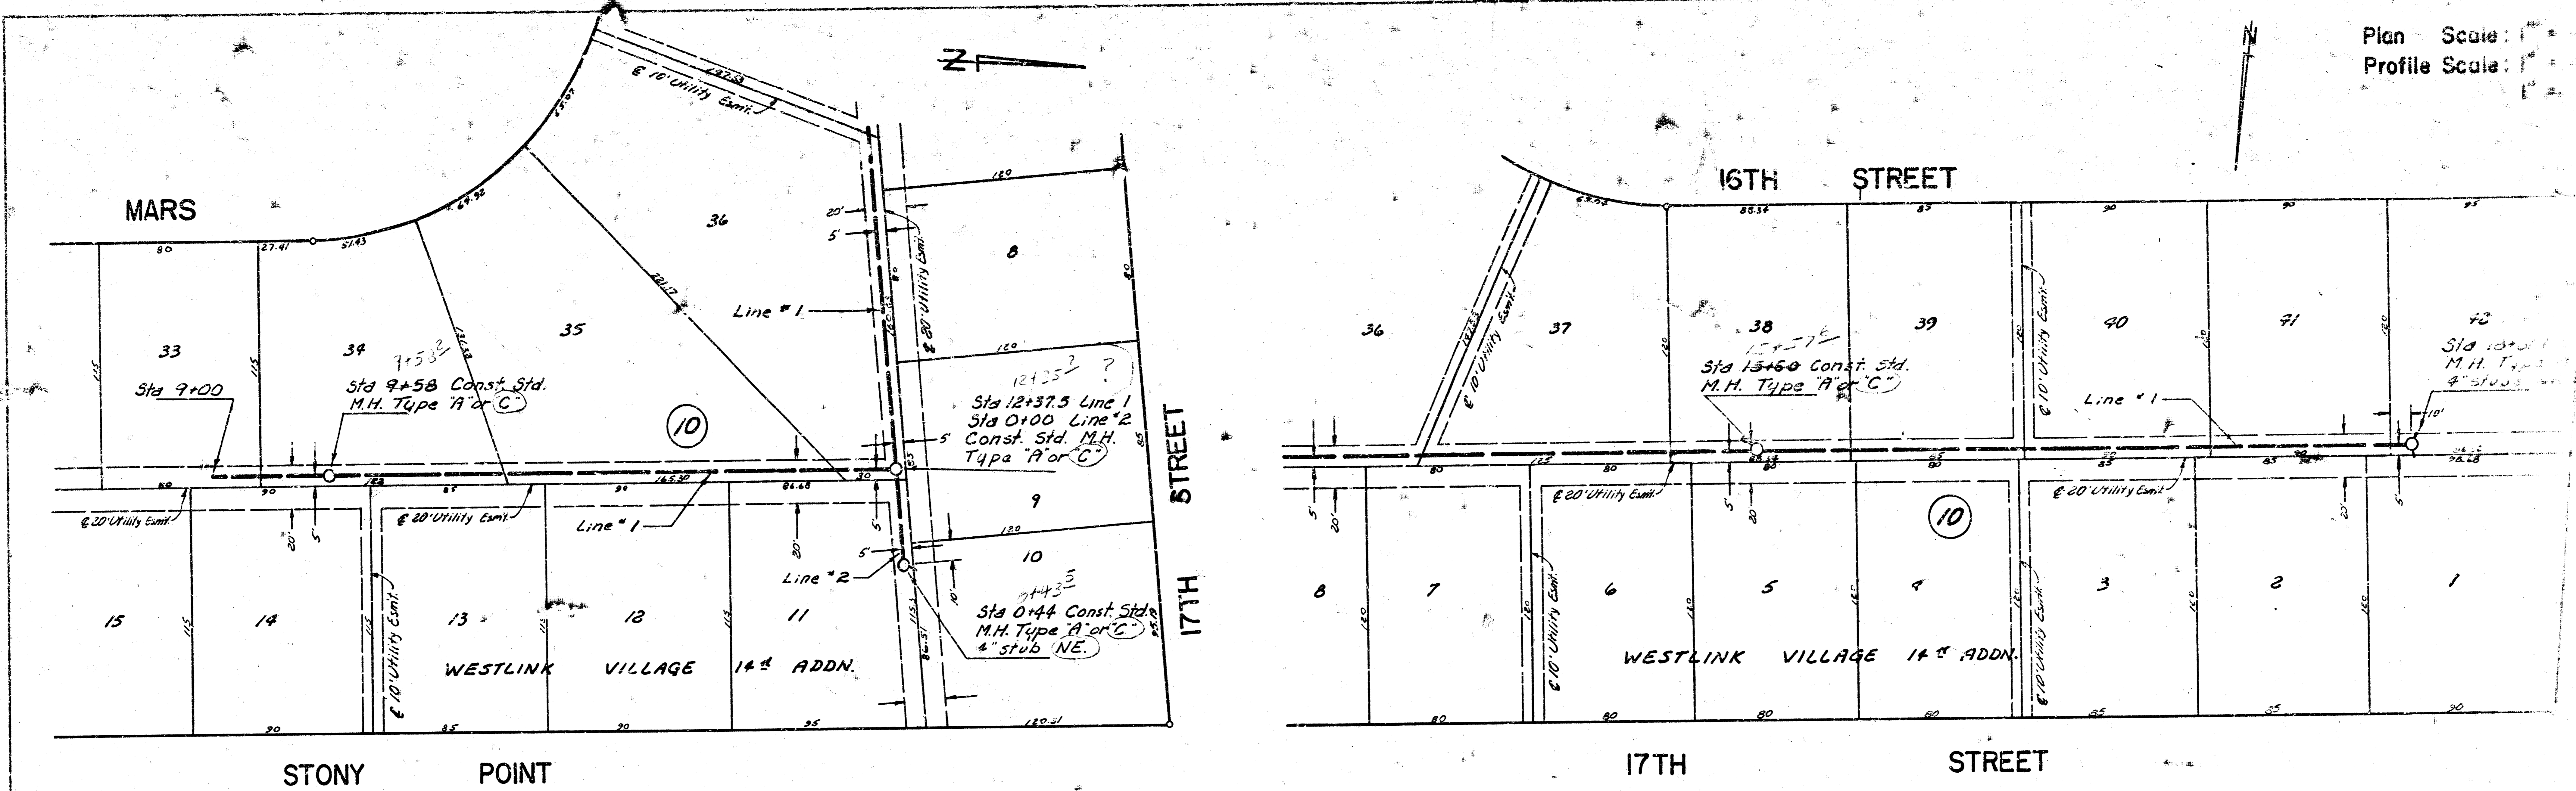

PLAN	DATE	BY	CHECKED
NO. 1			

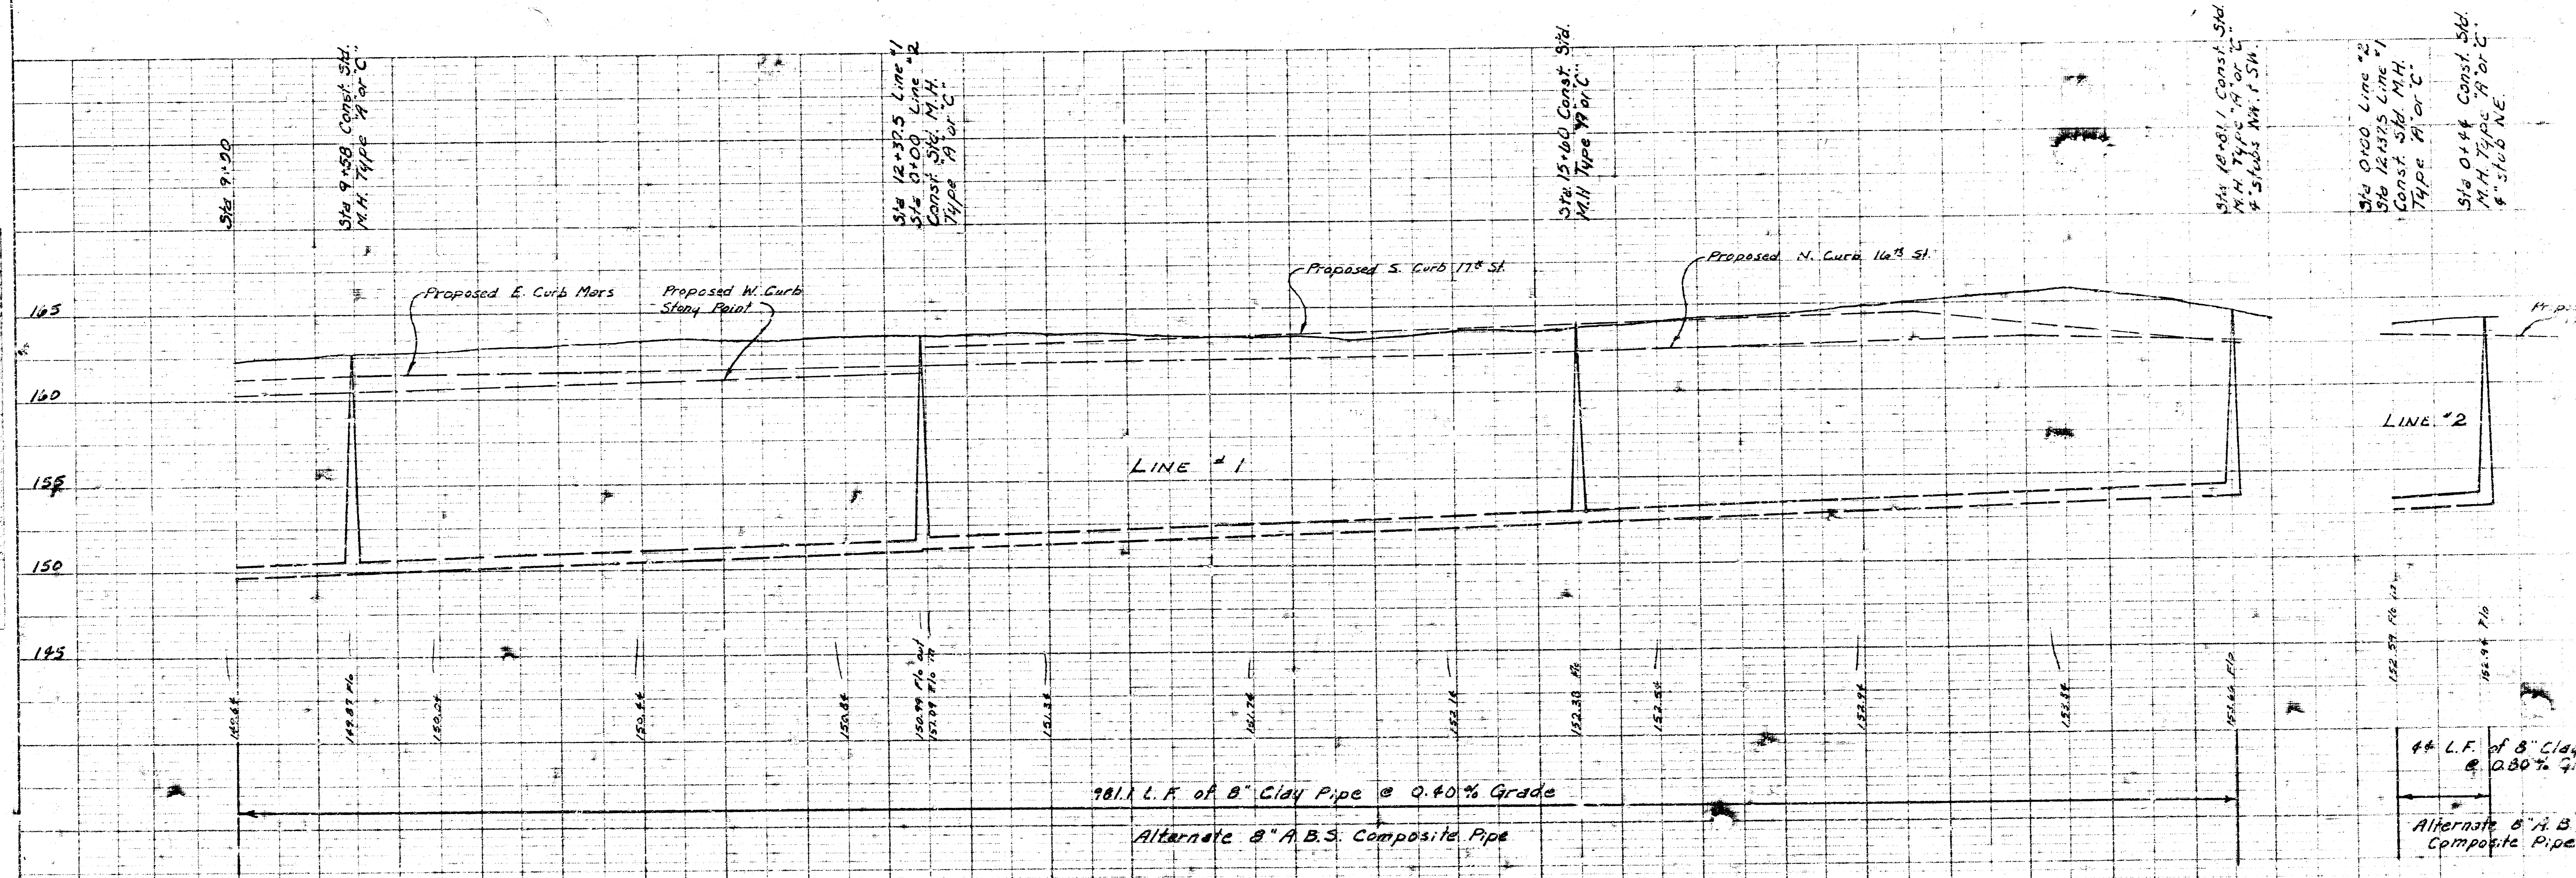

PROFILE	DATE	BY	CHECKED
NO. 1			