



BM 157.04 R.R. spike N. fc. PP approx. 200' S. & 100' W. of NW cor. Nantucket & Lark (4th PP W. Maize Rd.)

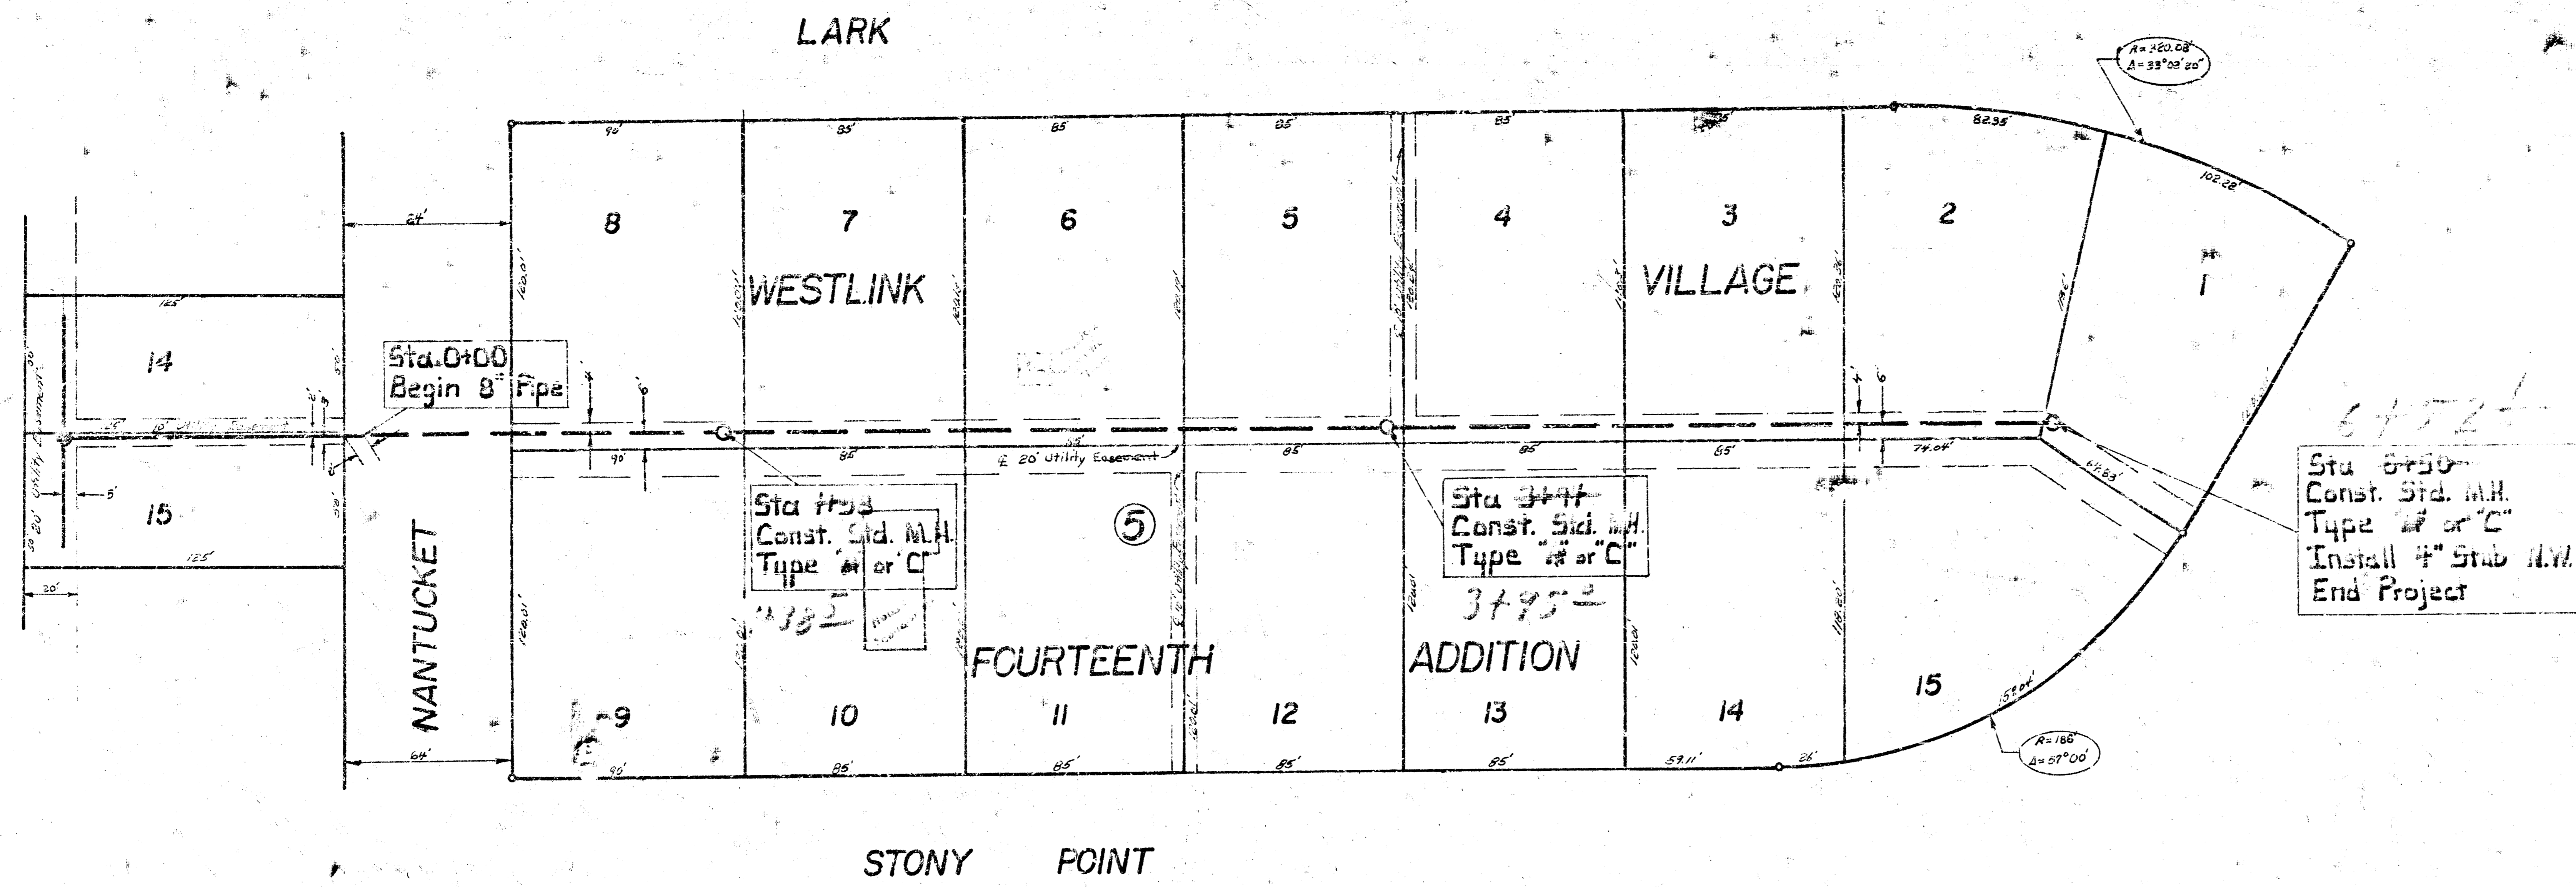

Plan Scale 1" = 40'  
 Profile Scale 1" = 40' Horiz.  
 1" = 5' Vert.

NOTE: PIPE BETWEEN STATION 0 + 00 AND 1 + 38 SHALL BE SAME TYPE OF PIPE AS PIPE SOUTH OF STATION 0 + 00 WHICH IS TO BE INSTALLED BY THE CONTRACTOR FOR LATERAL 103, SOUTHWEST INTERCEPTOR.

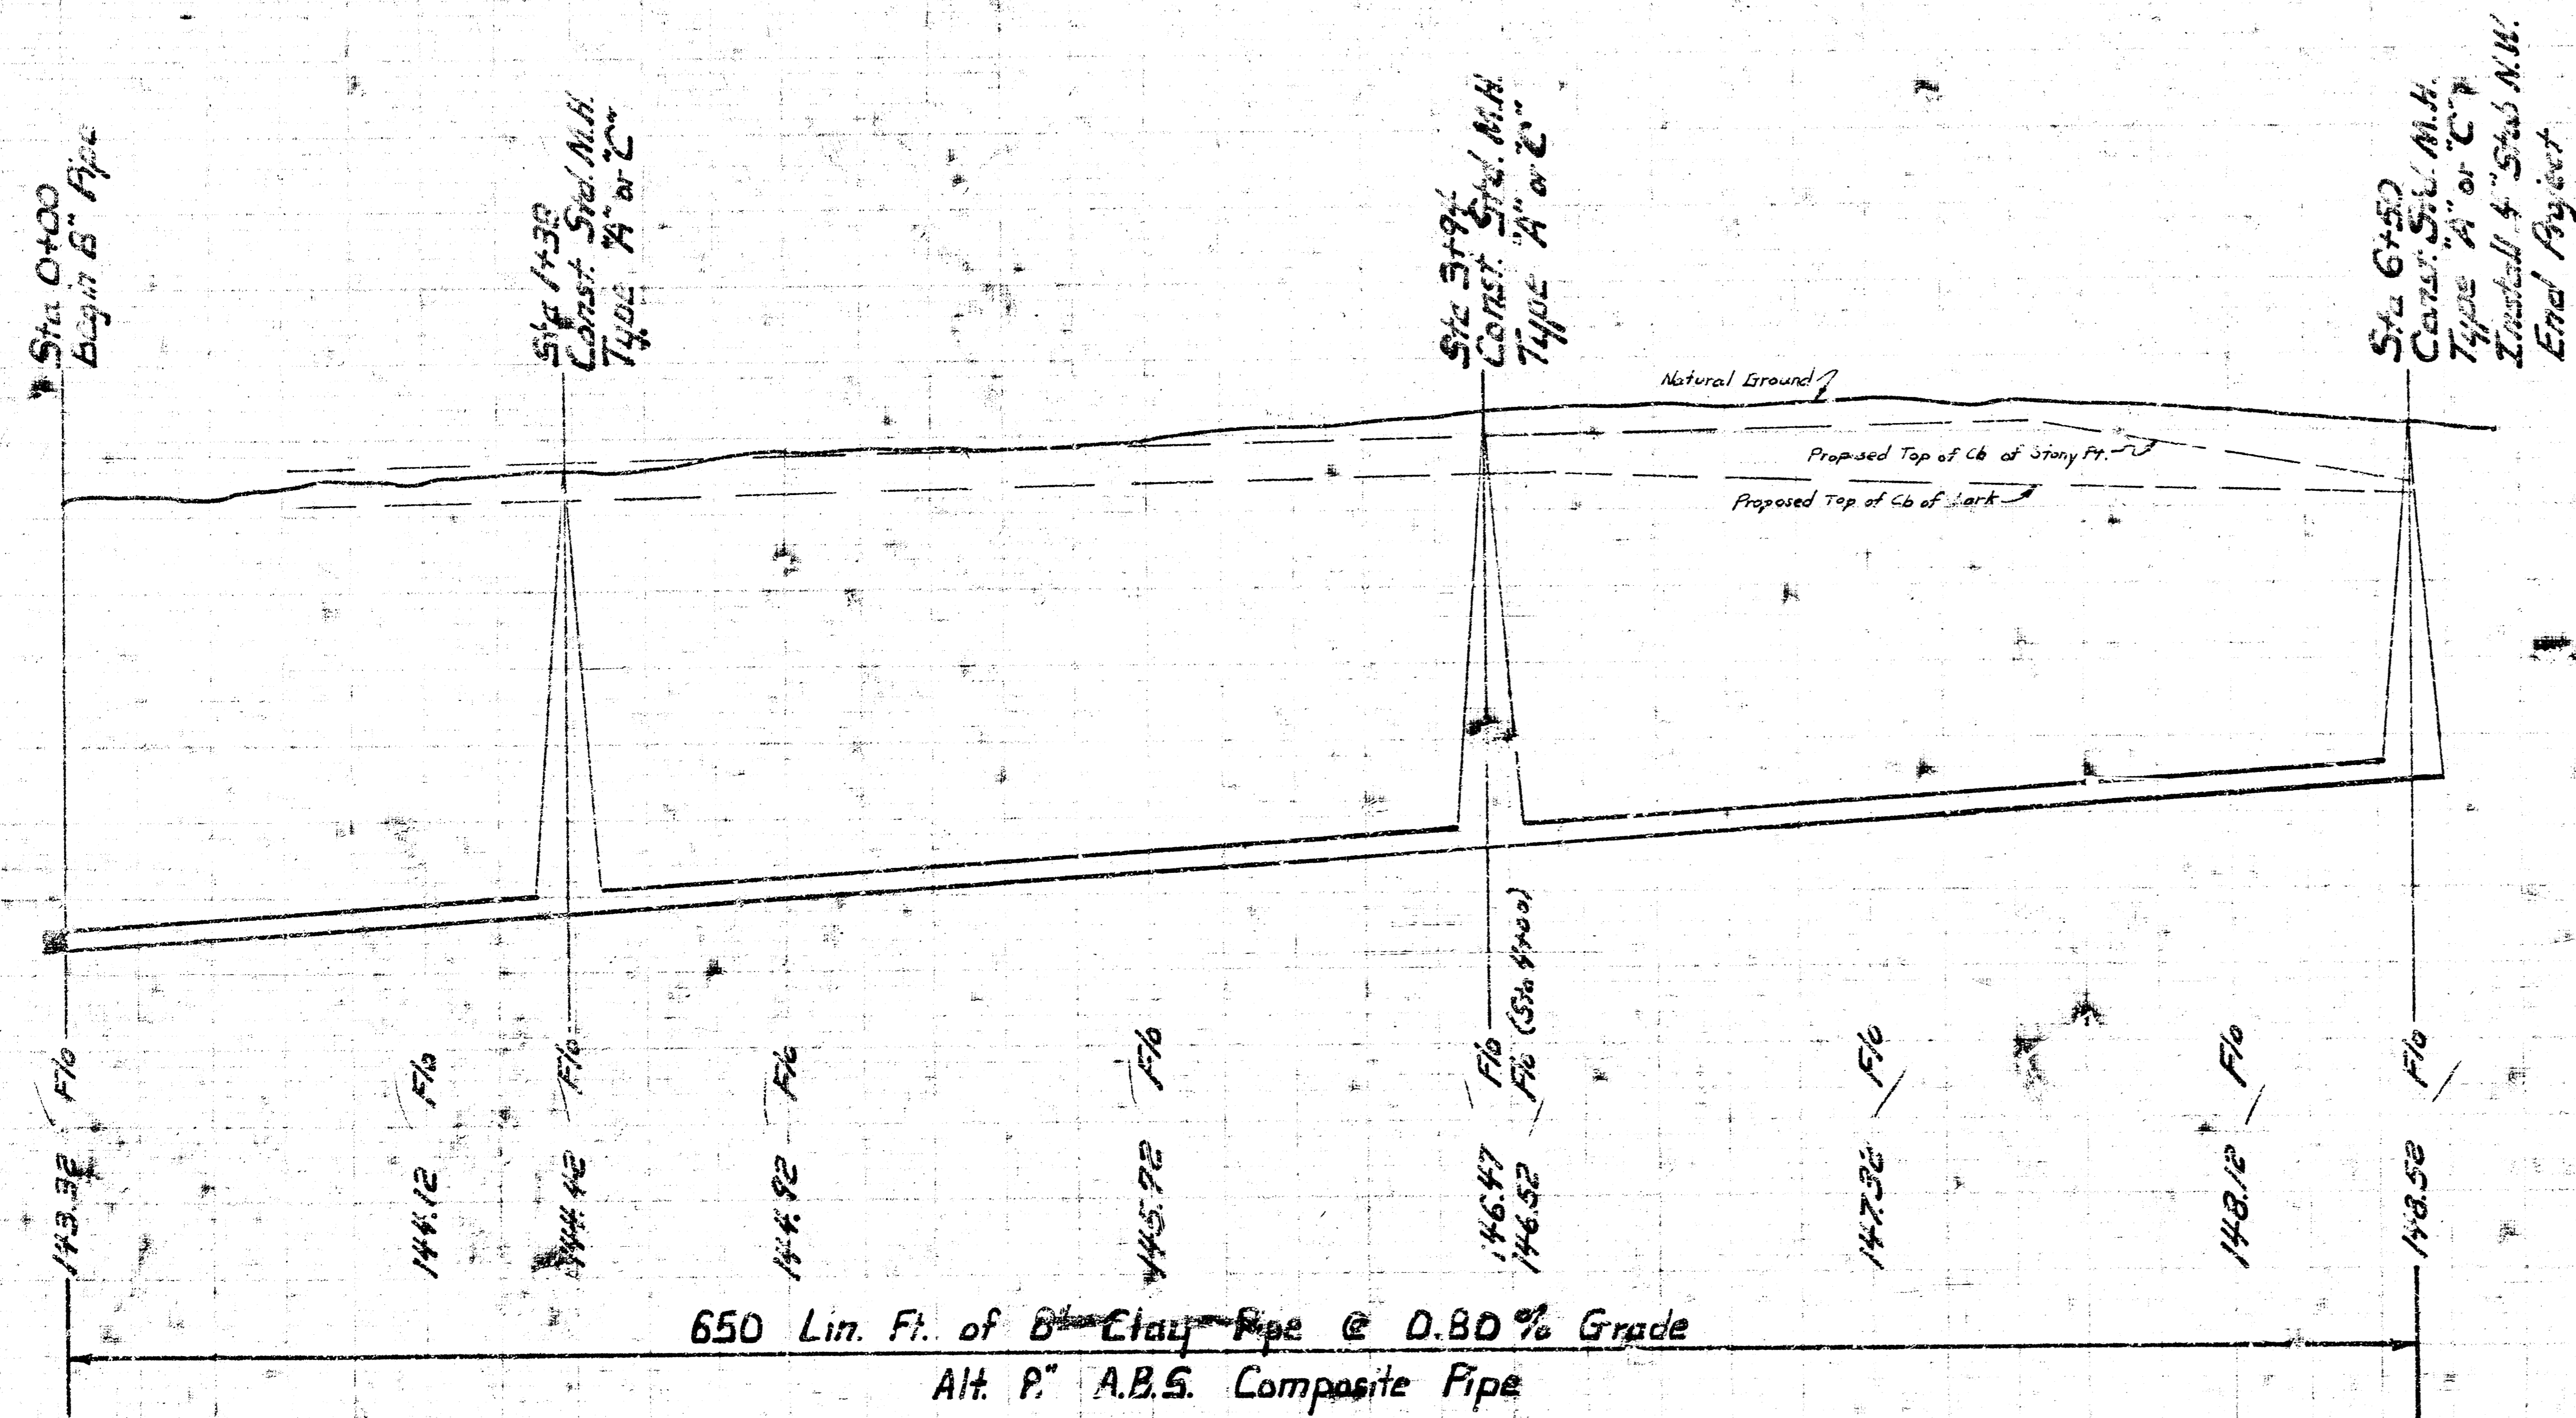

As built 4-24-78



LAT 103 SOUTHWEST INTERCEPTOR  
 CITY OF WICHITA, KANSAS  
 R.W. LINN CITY ENGINEER  
 DATE: PROJECT NUMBER DBKL577040