



3.M.102.58 Northeast corner of concrete porch of house at 3903 West 33rd Street South.

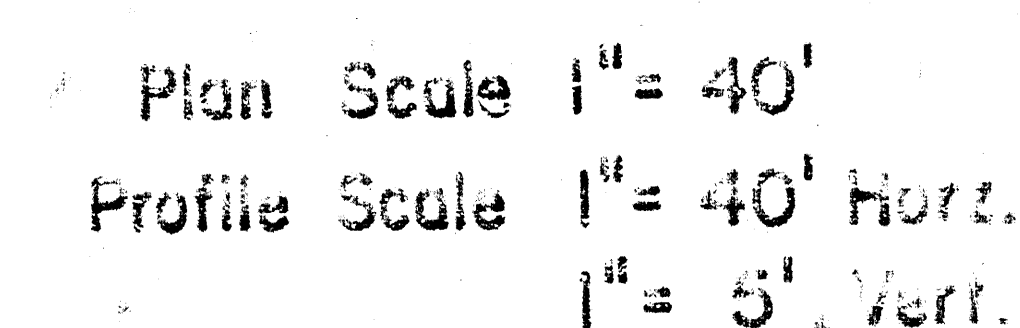

Note: The following lots are in the benefit district of this project:
Lots 1, 2, 6, 7, 8, 9, 13, 14, 15, 16, 20, 21,
22, 23, 27, 28, 29, and 30,
all in Jensen Second Addition.

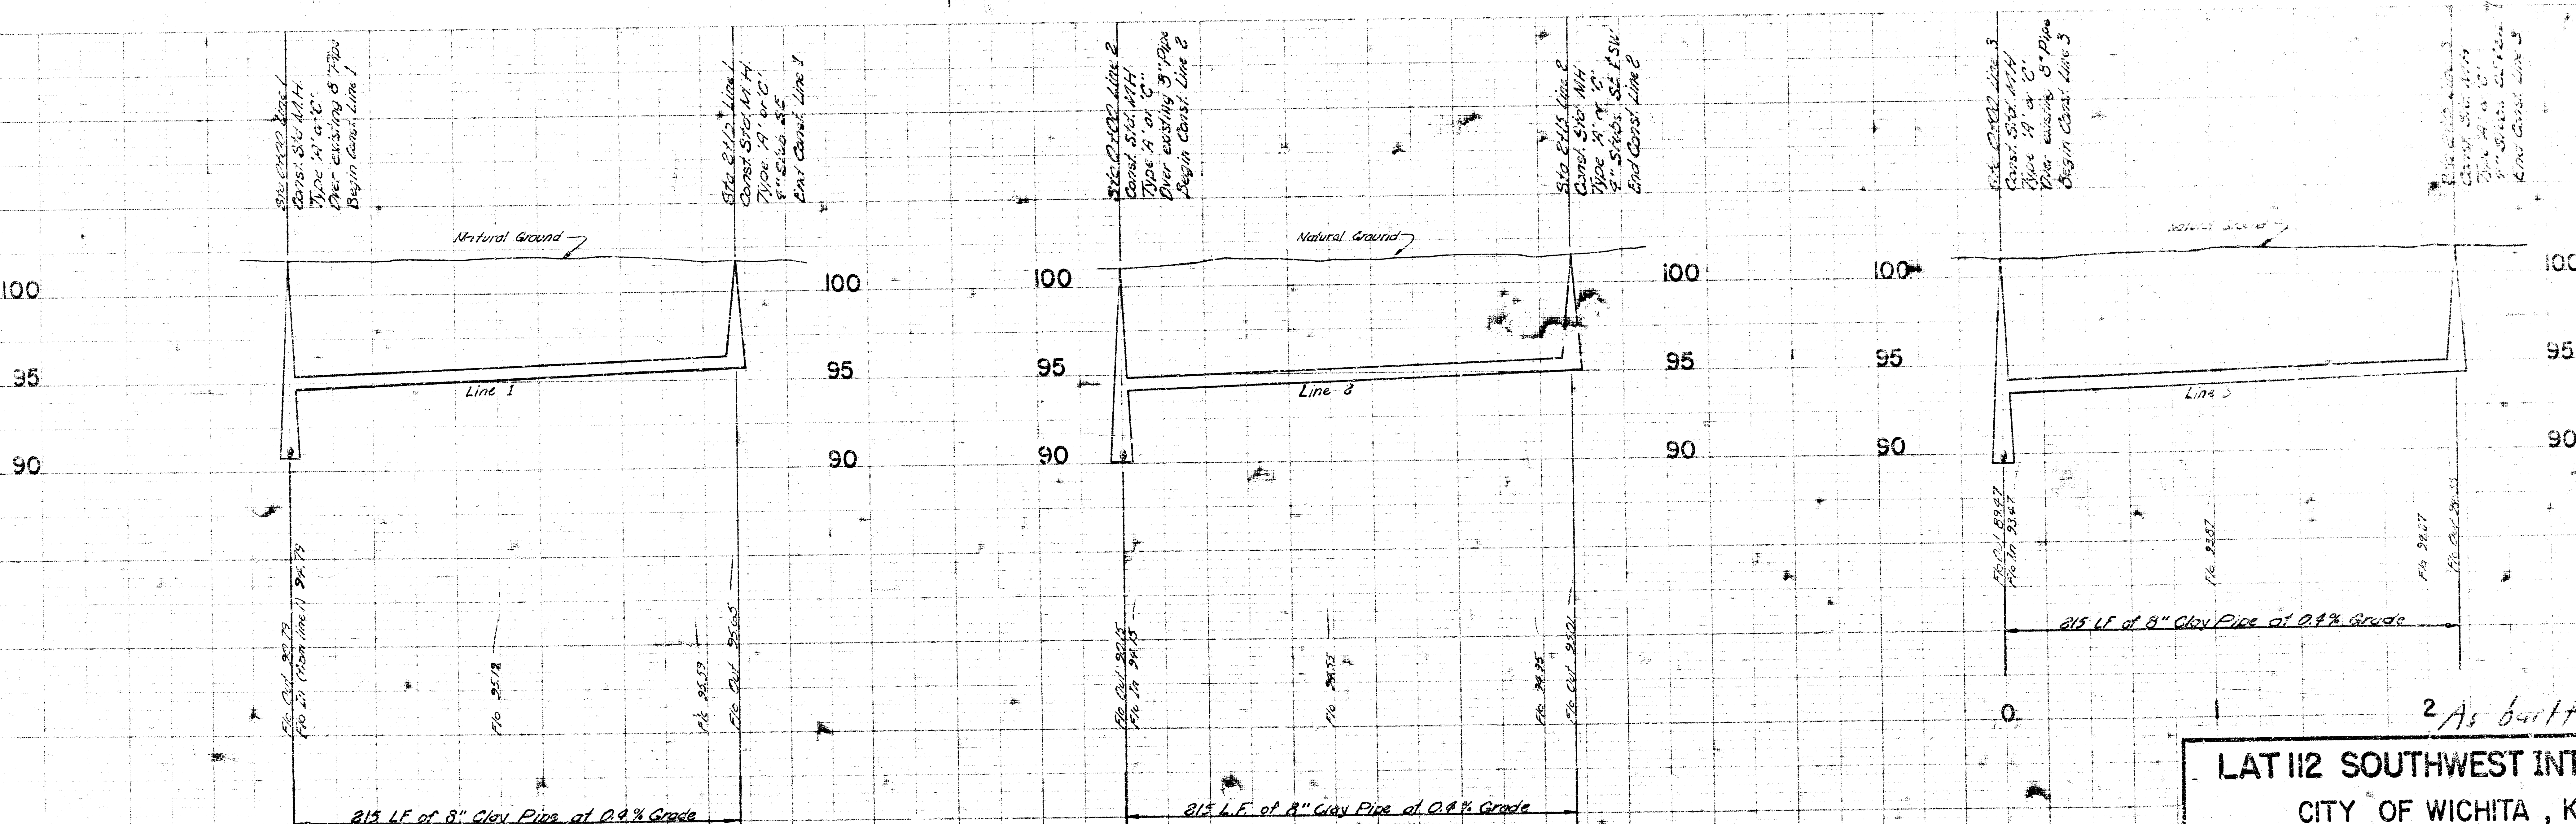


2 As built 7-31-78

LAT 112 SOUTHWEST INTERCEPTOR
CITY OF WICHITA, KANSAS

R. W. LINN CITY ENGINEER

DATE: _____ PROJECT NUMBER: DBKL577052

B.M. 101.84 "X" Chise mark at West end of curb return on Southwest corner of intersection of 31st Street South and Illinois.
B.M. 102.58 Northeast corner of concrete porch of house at 3903 West 33rd Street South.

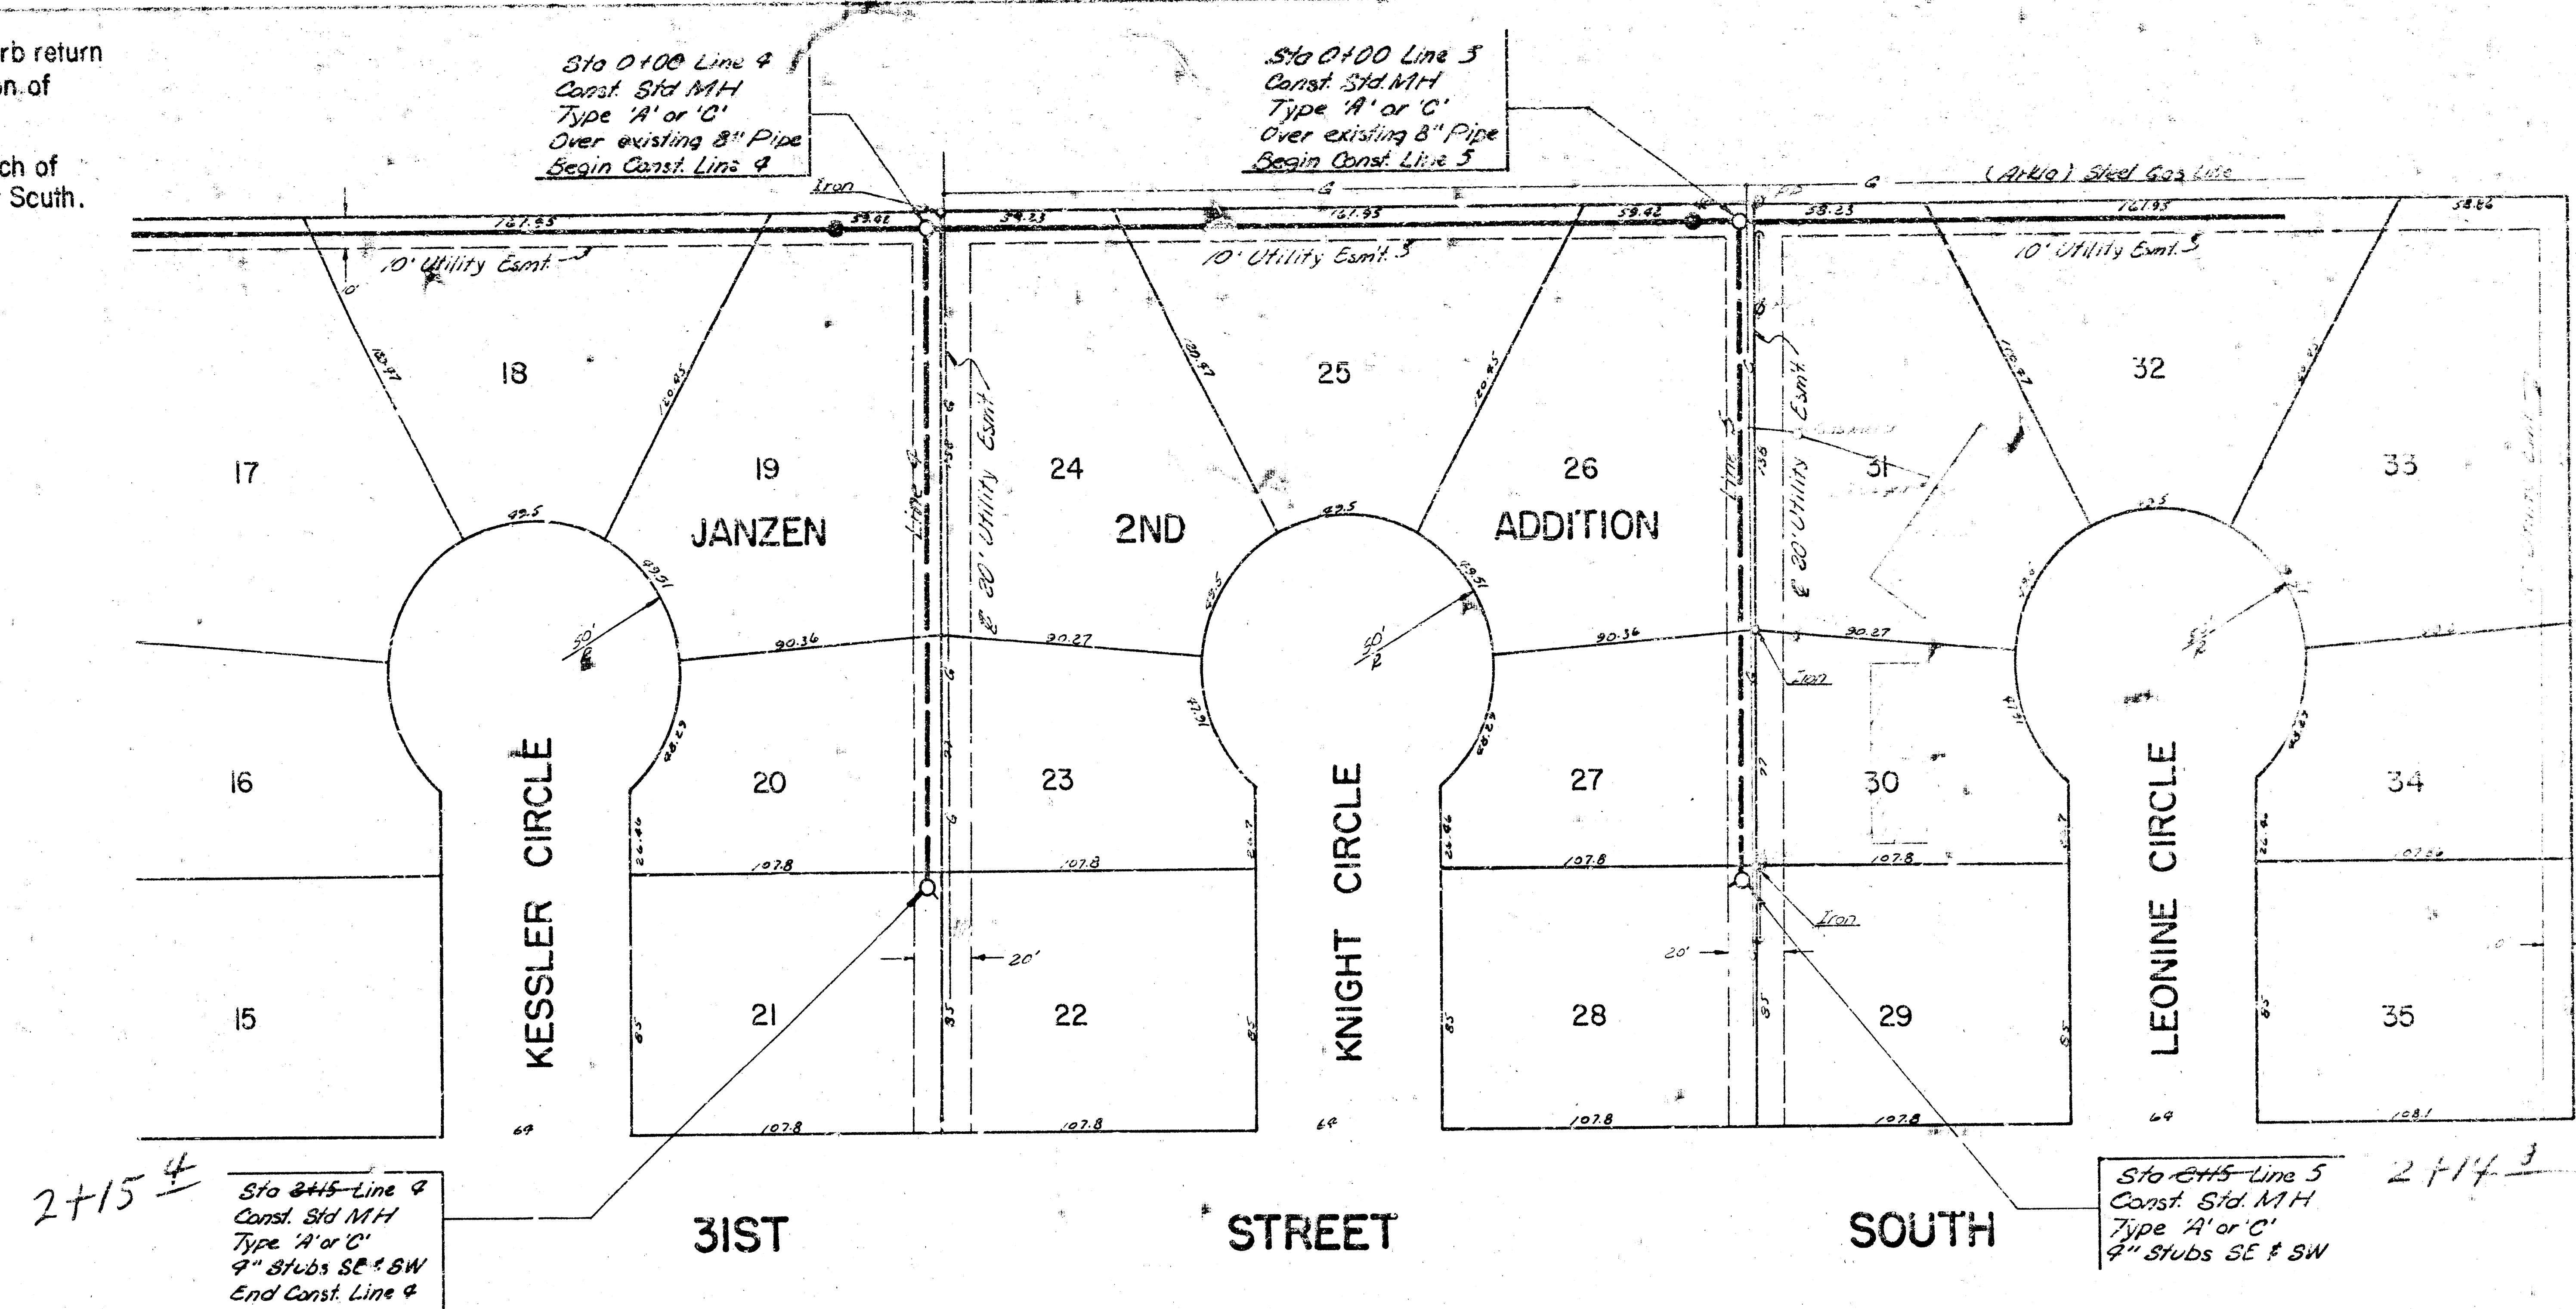

Plan Scale 1" = 40'
Profile Scale 1" = 40'
1" = 5'

