

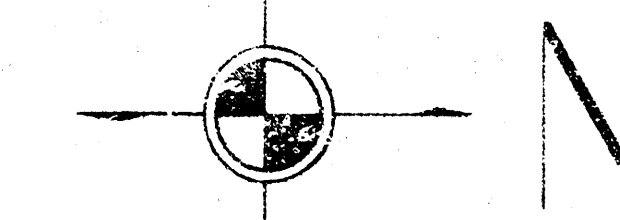
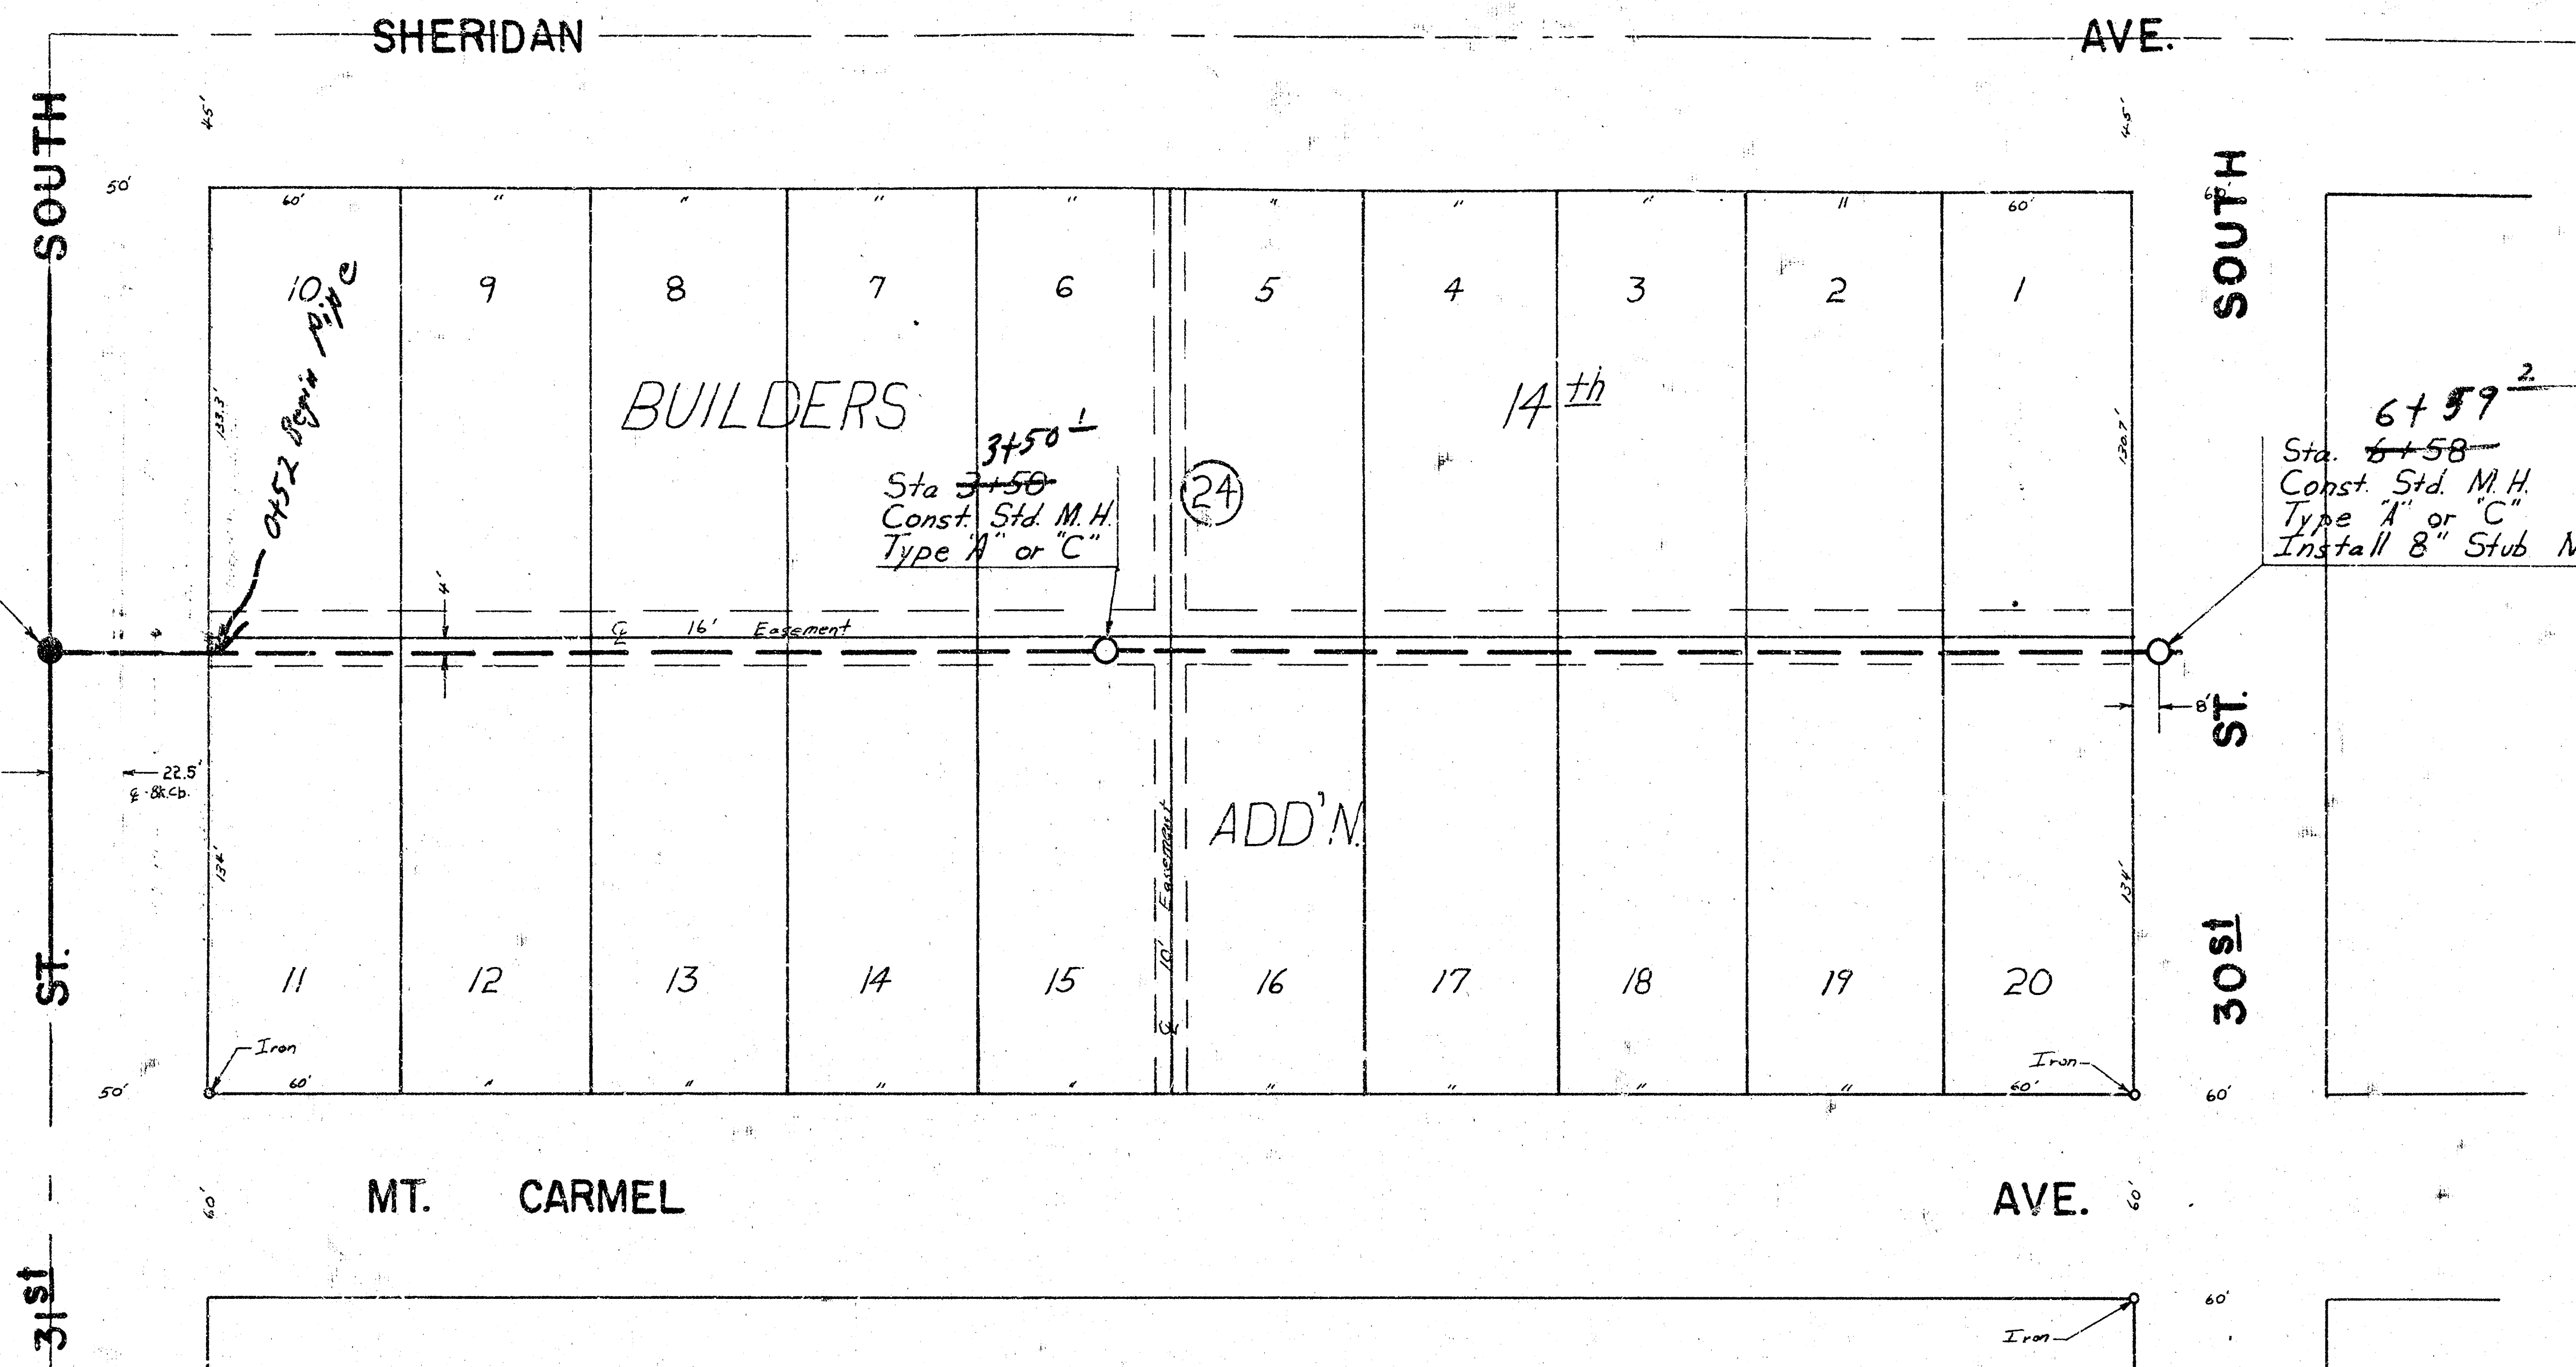


BM 103 City Sid. Top East End Handrail
to Reof Conc. Box at Sheridan & 31st

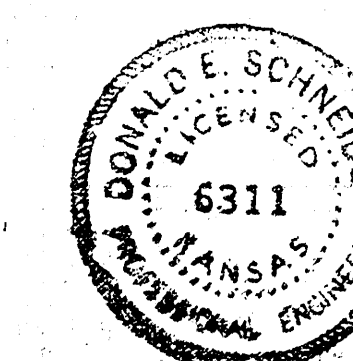

Plan Scale 1" = 40'
Profile Scale 1" = 40' Horiz.
1" = 5' Vert.

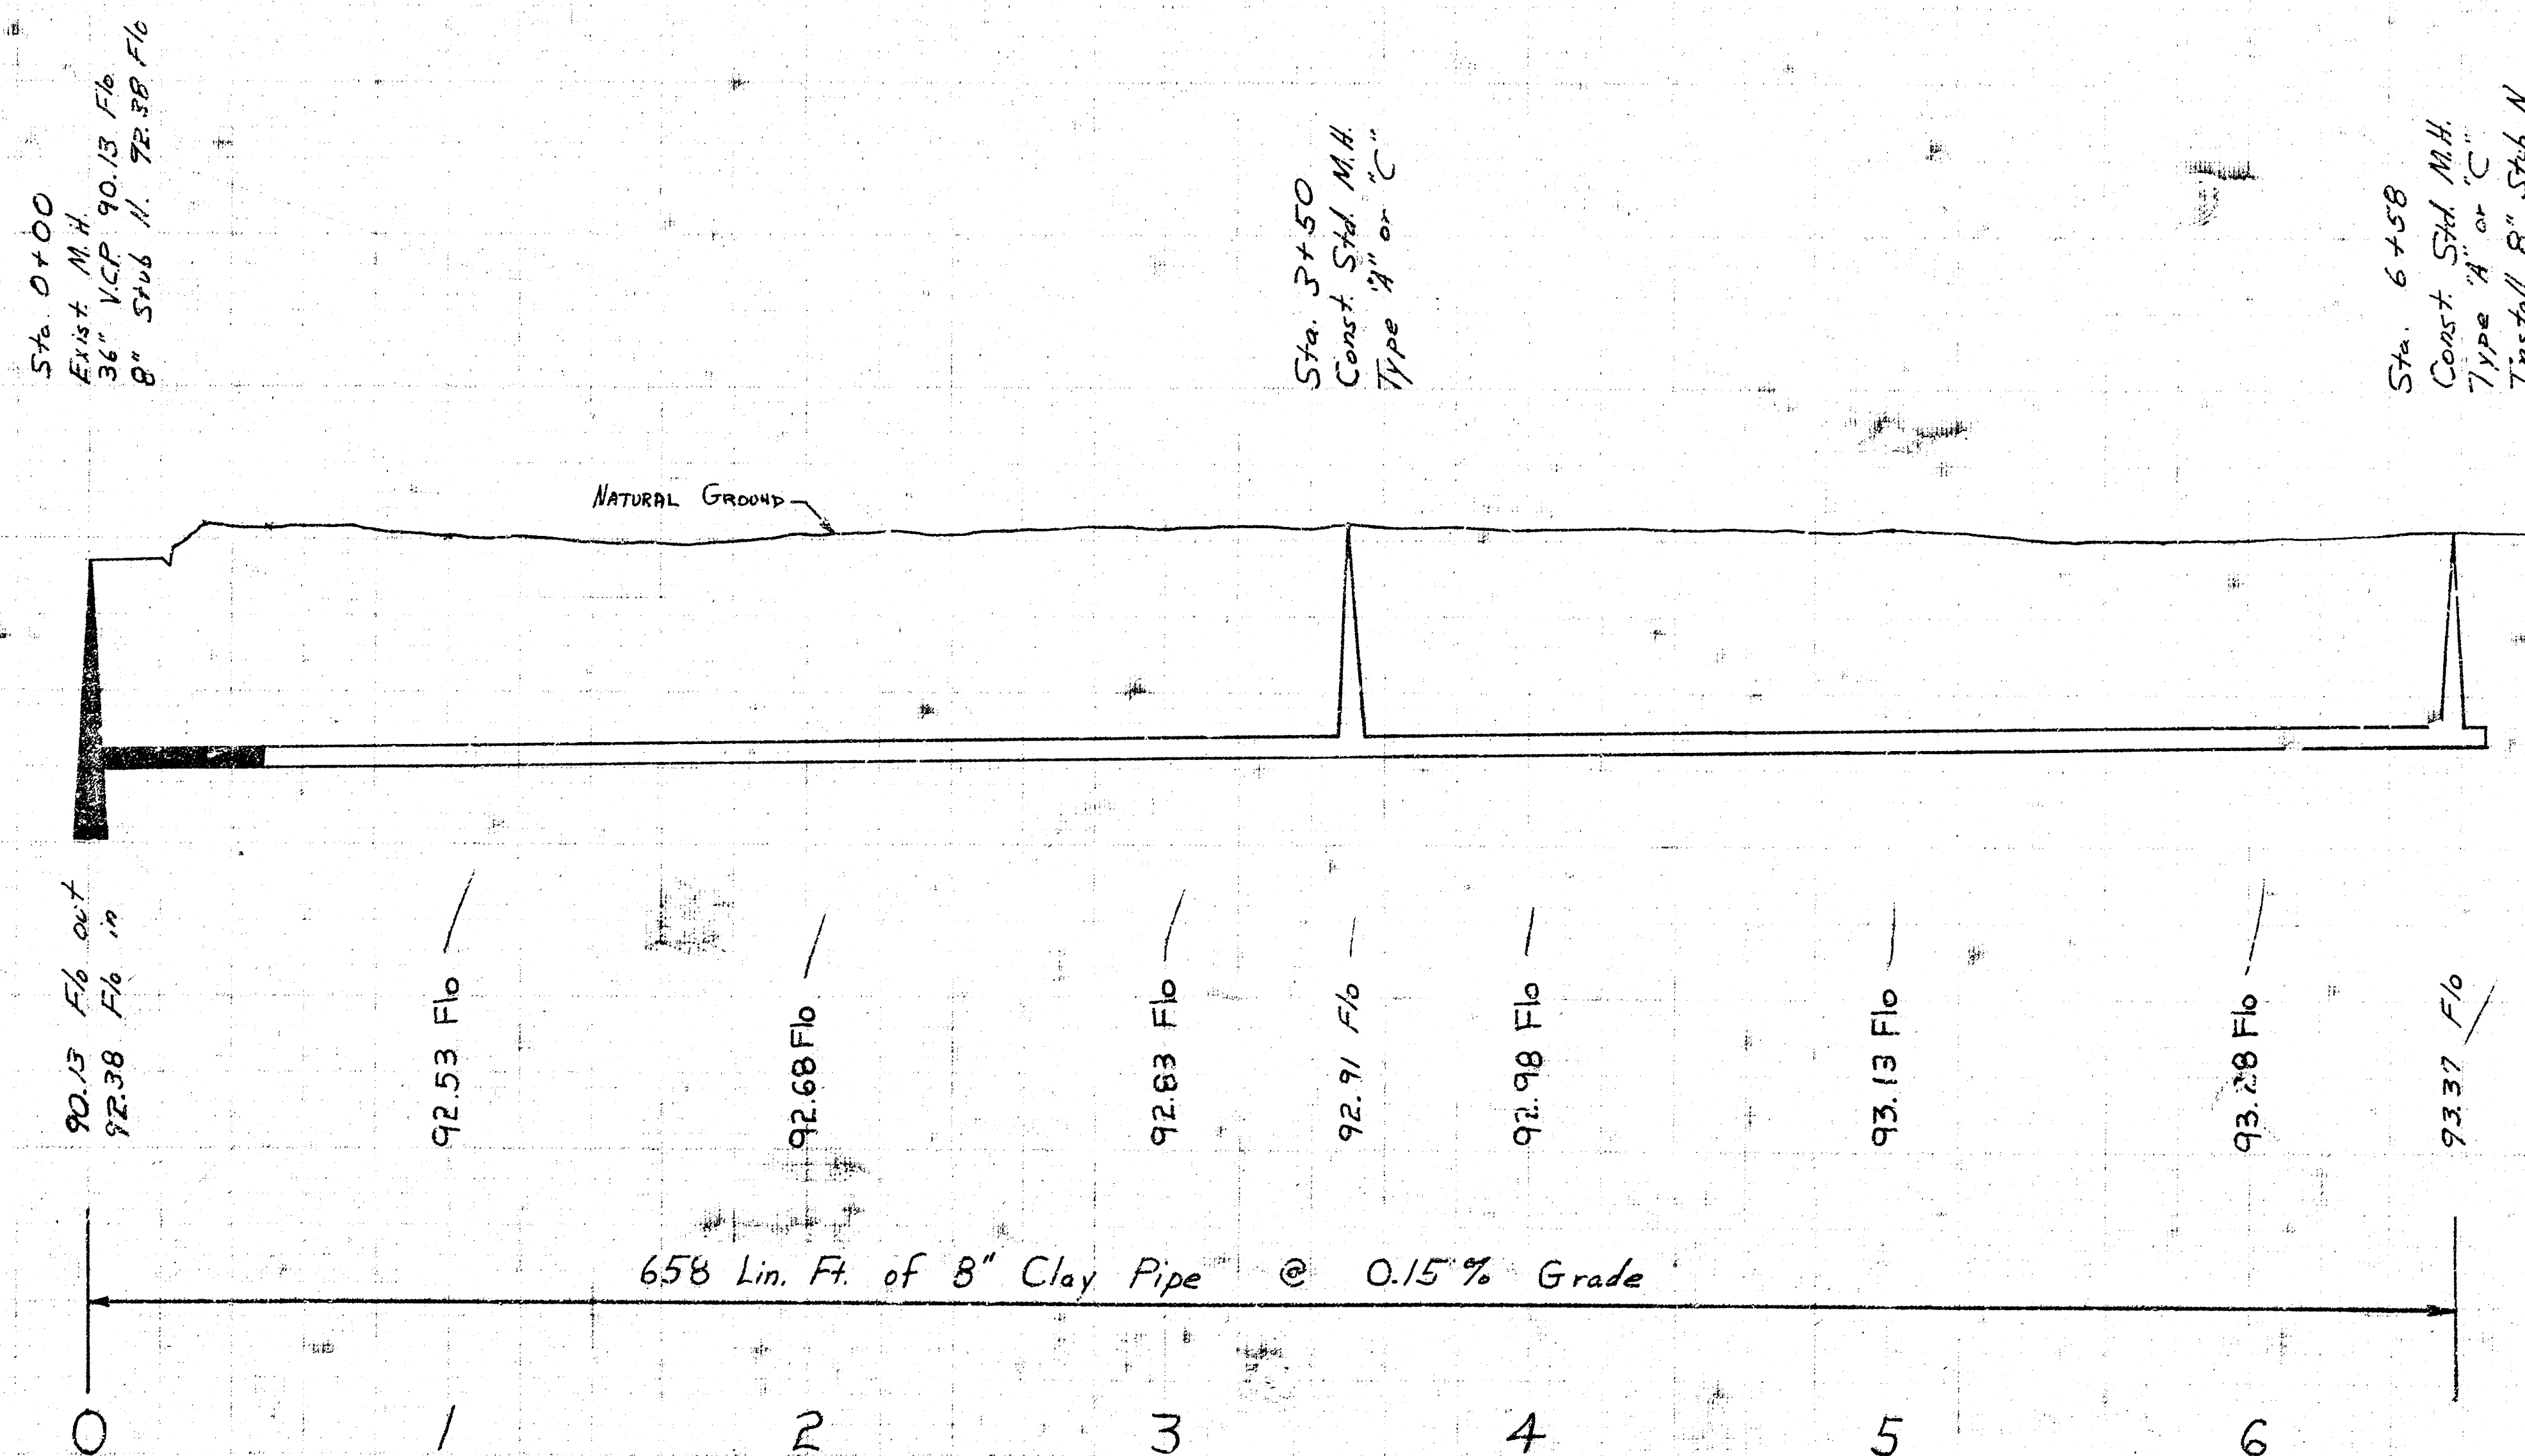

As Built 10-3-75

LAT. 129 S.S. NO. 22
CITY OF WICHITA, KANSAS
R. W. LINN — CITY ENGINEER
PROJECT NO. DBKL575029