


PLAN
 JPC:SZJ

PROFILE


Scale Plan 1" = 40'
 Profile 1" = 40' Horiz.
 1" = 5' Vert.

TURQUOISE

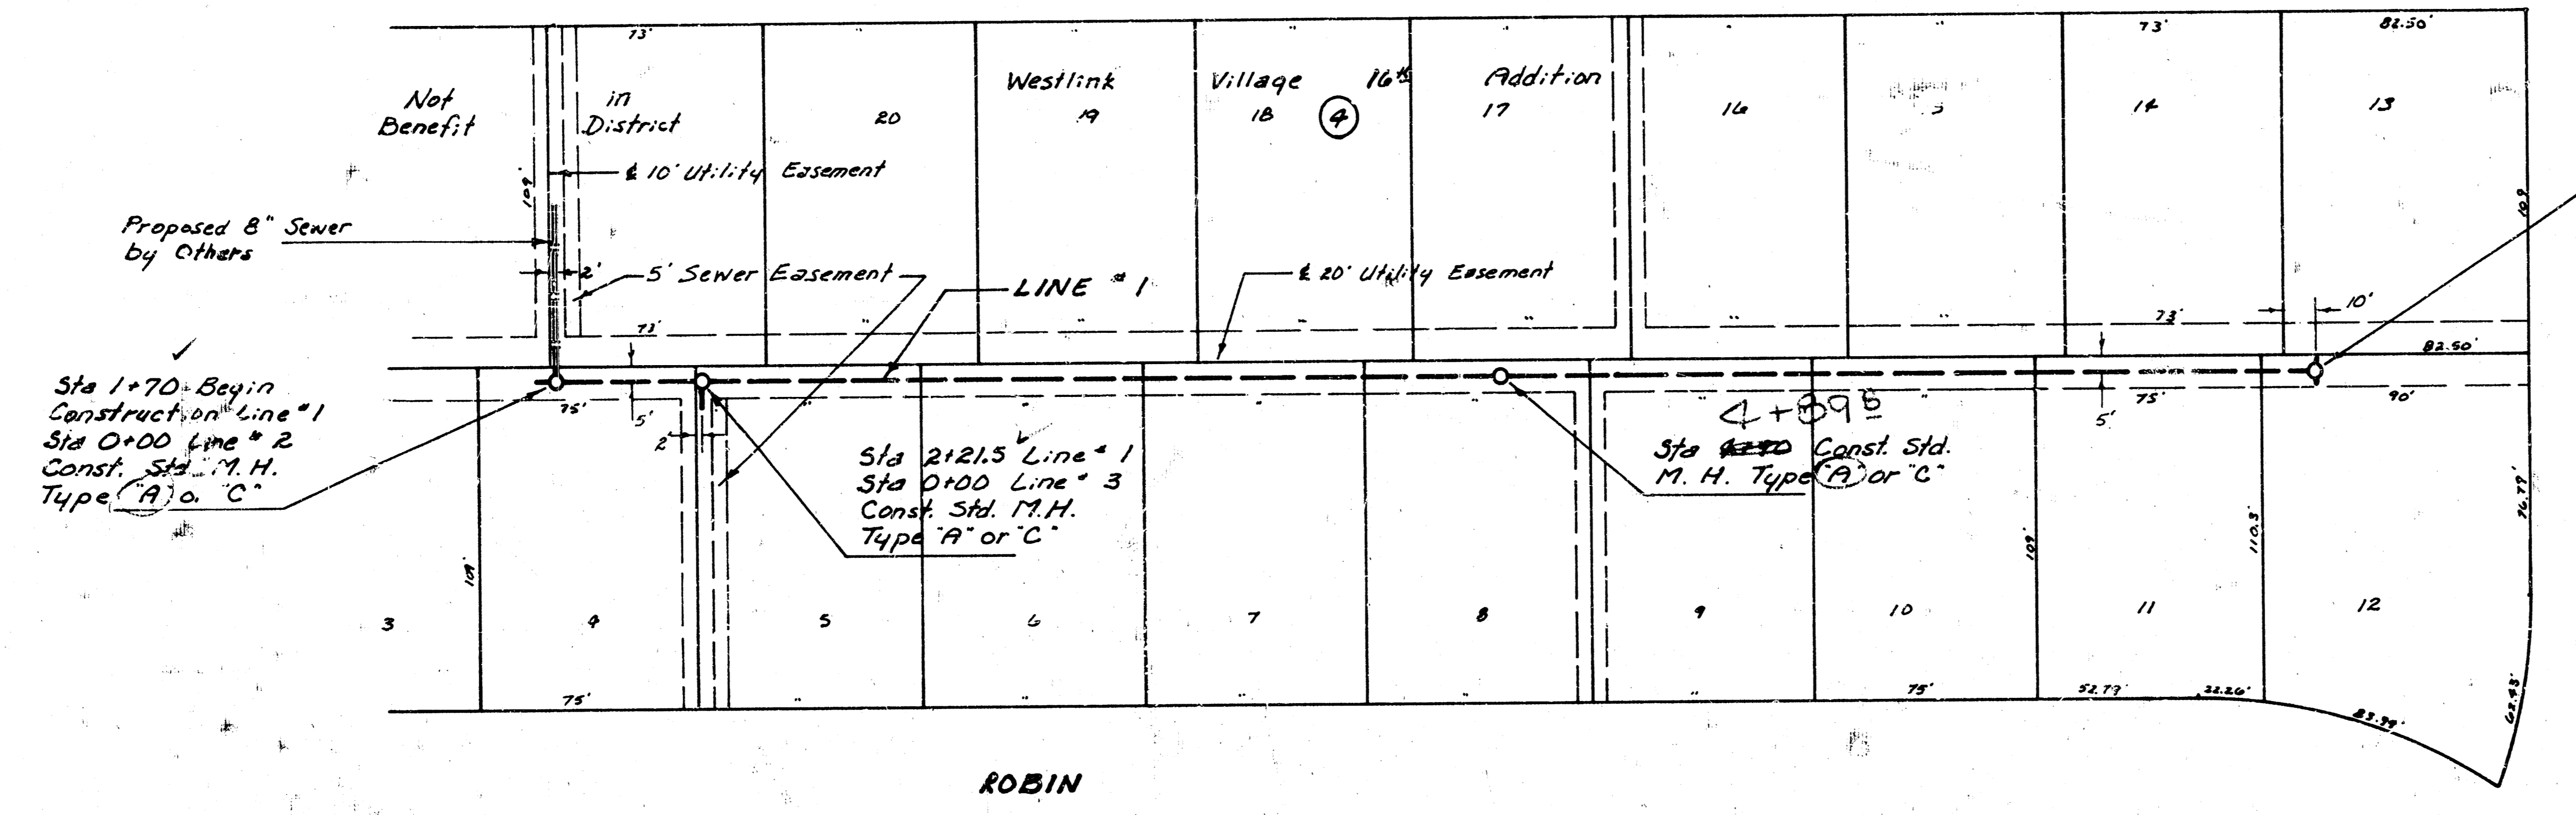

Sta 7+62 Const. Std. M.H. Type "A" or "C" Install 9" slabs E. & W.

B.M. 156.19 City Std. Disc. 42.3 ft. E & 44 ft. N. of 1/4 Sec. corner at County Acres Ave and 13th St.
 B.M. 172.48 City Std. Disc. 31 ft. S. and 36 ft. E. of 1/4 Sec. corner at Tyler Road and 17th St.

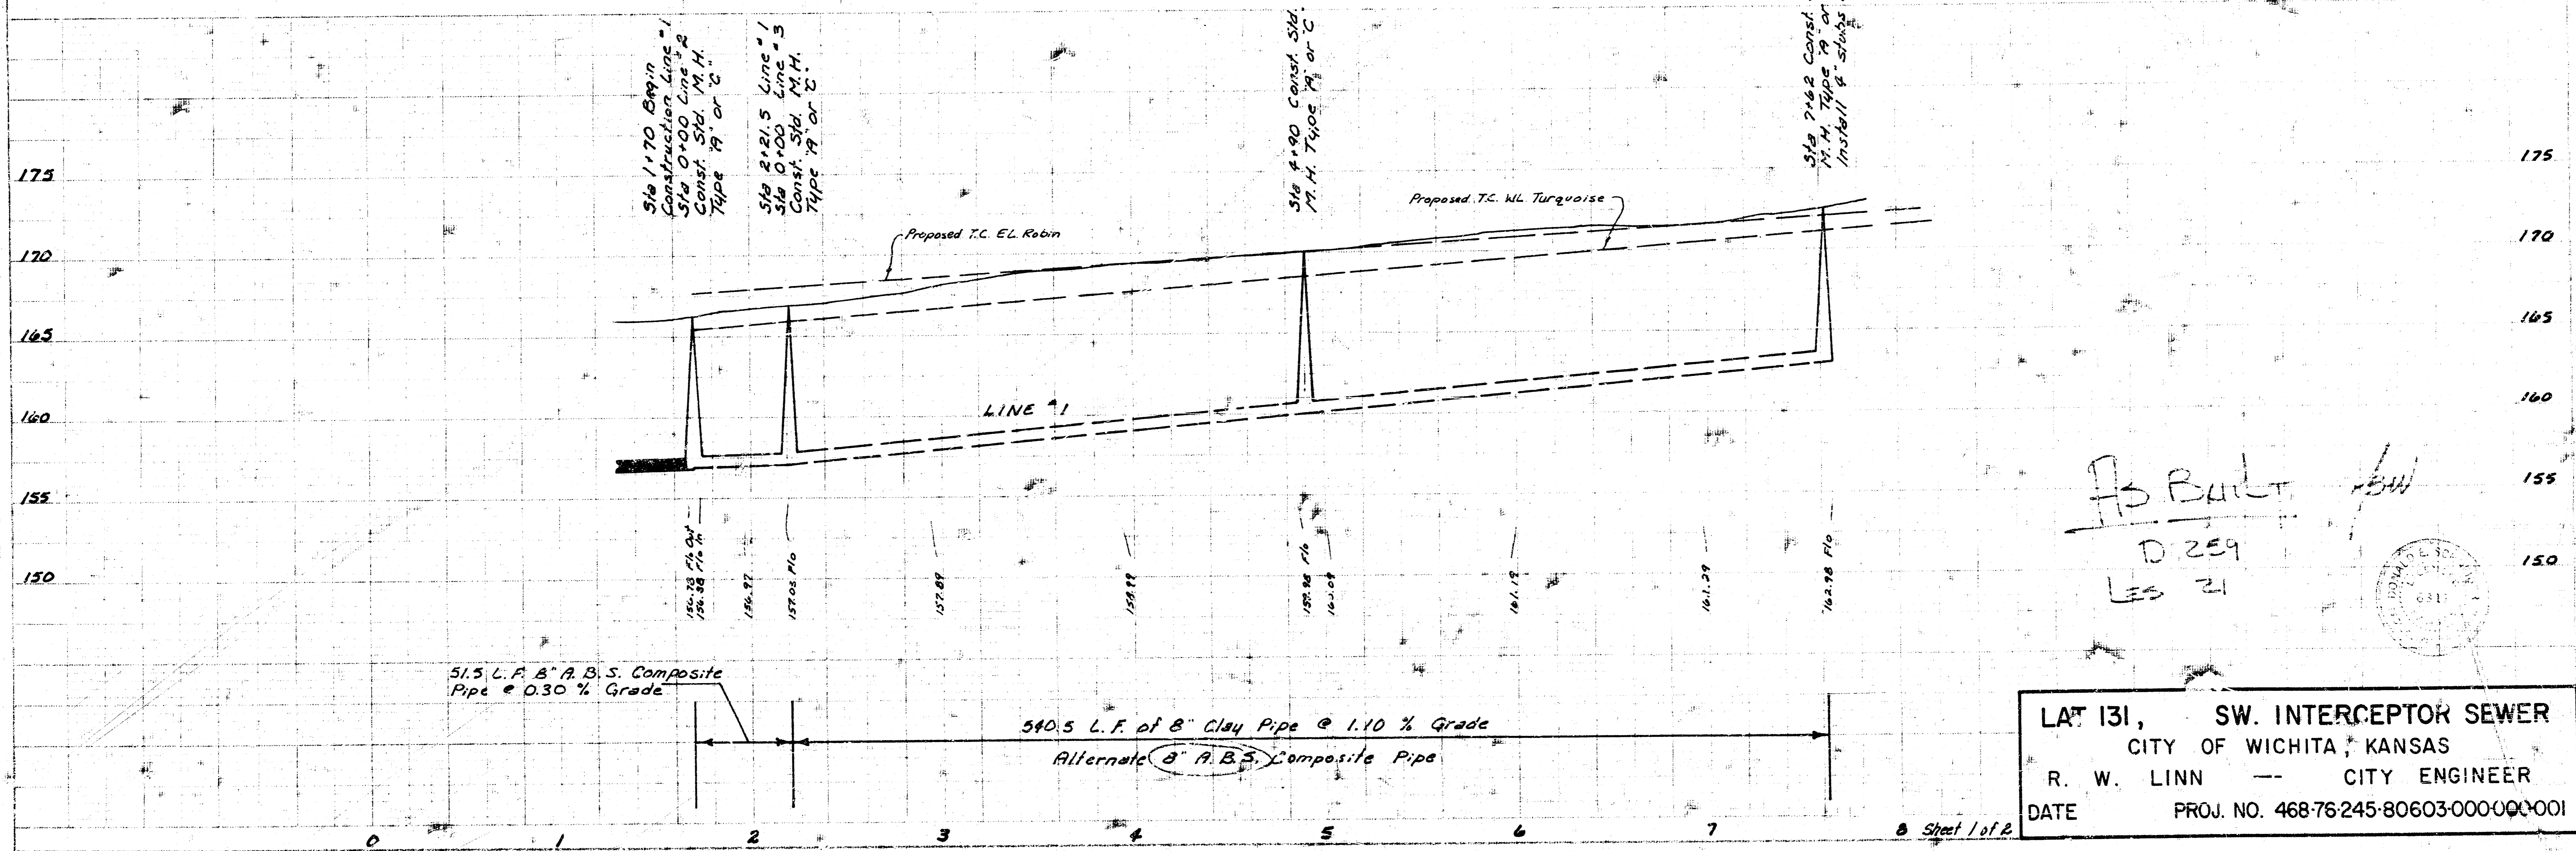


AS BUILT
 D 259
 LES 21


LAT 131, SW. INTERCEPTOR SEWER
 CITY OF WICHITA, KANSAS
 R. W. LINN — CITY ENGINEER
 DATE PROJ. NO. 468-76-245-80603-000-000-001

PLAN
 DATE: 10/15/14
 PROJECT: LAT 131 SW INTERCEPTOR

PROFILE
 DATE: 10/15/14
 PROJECT: LAT 131 SW INTERCEPTOR

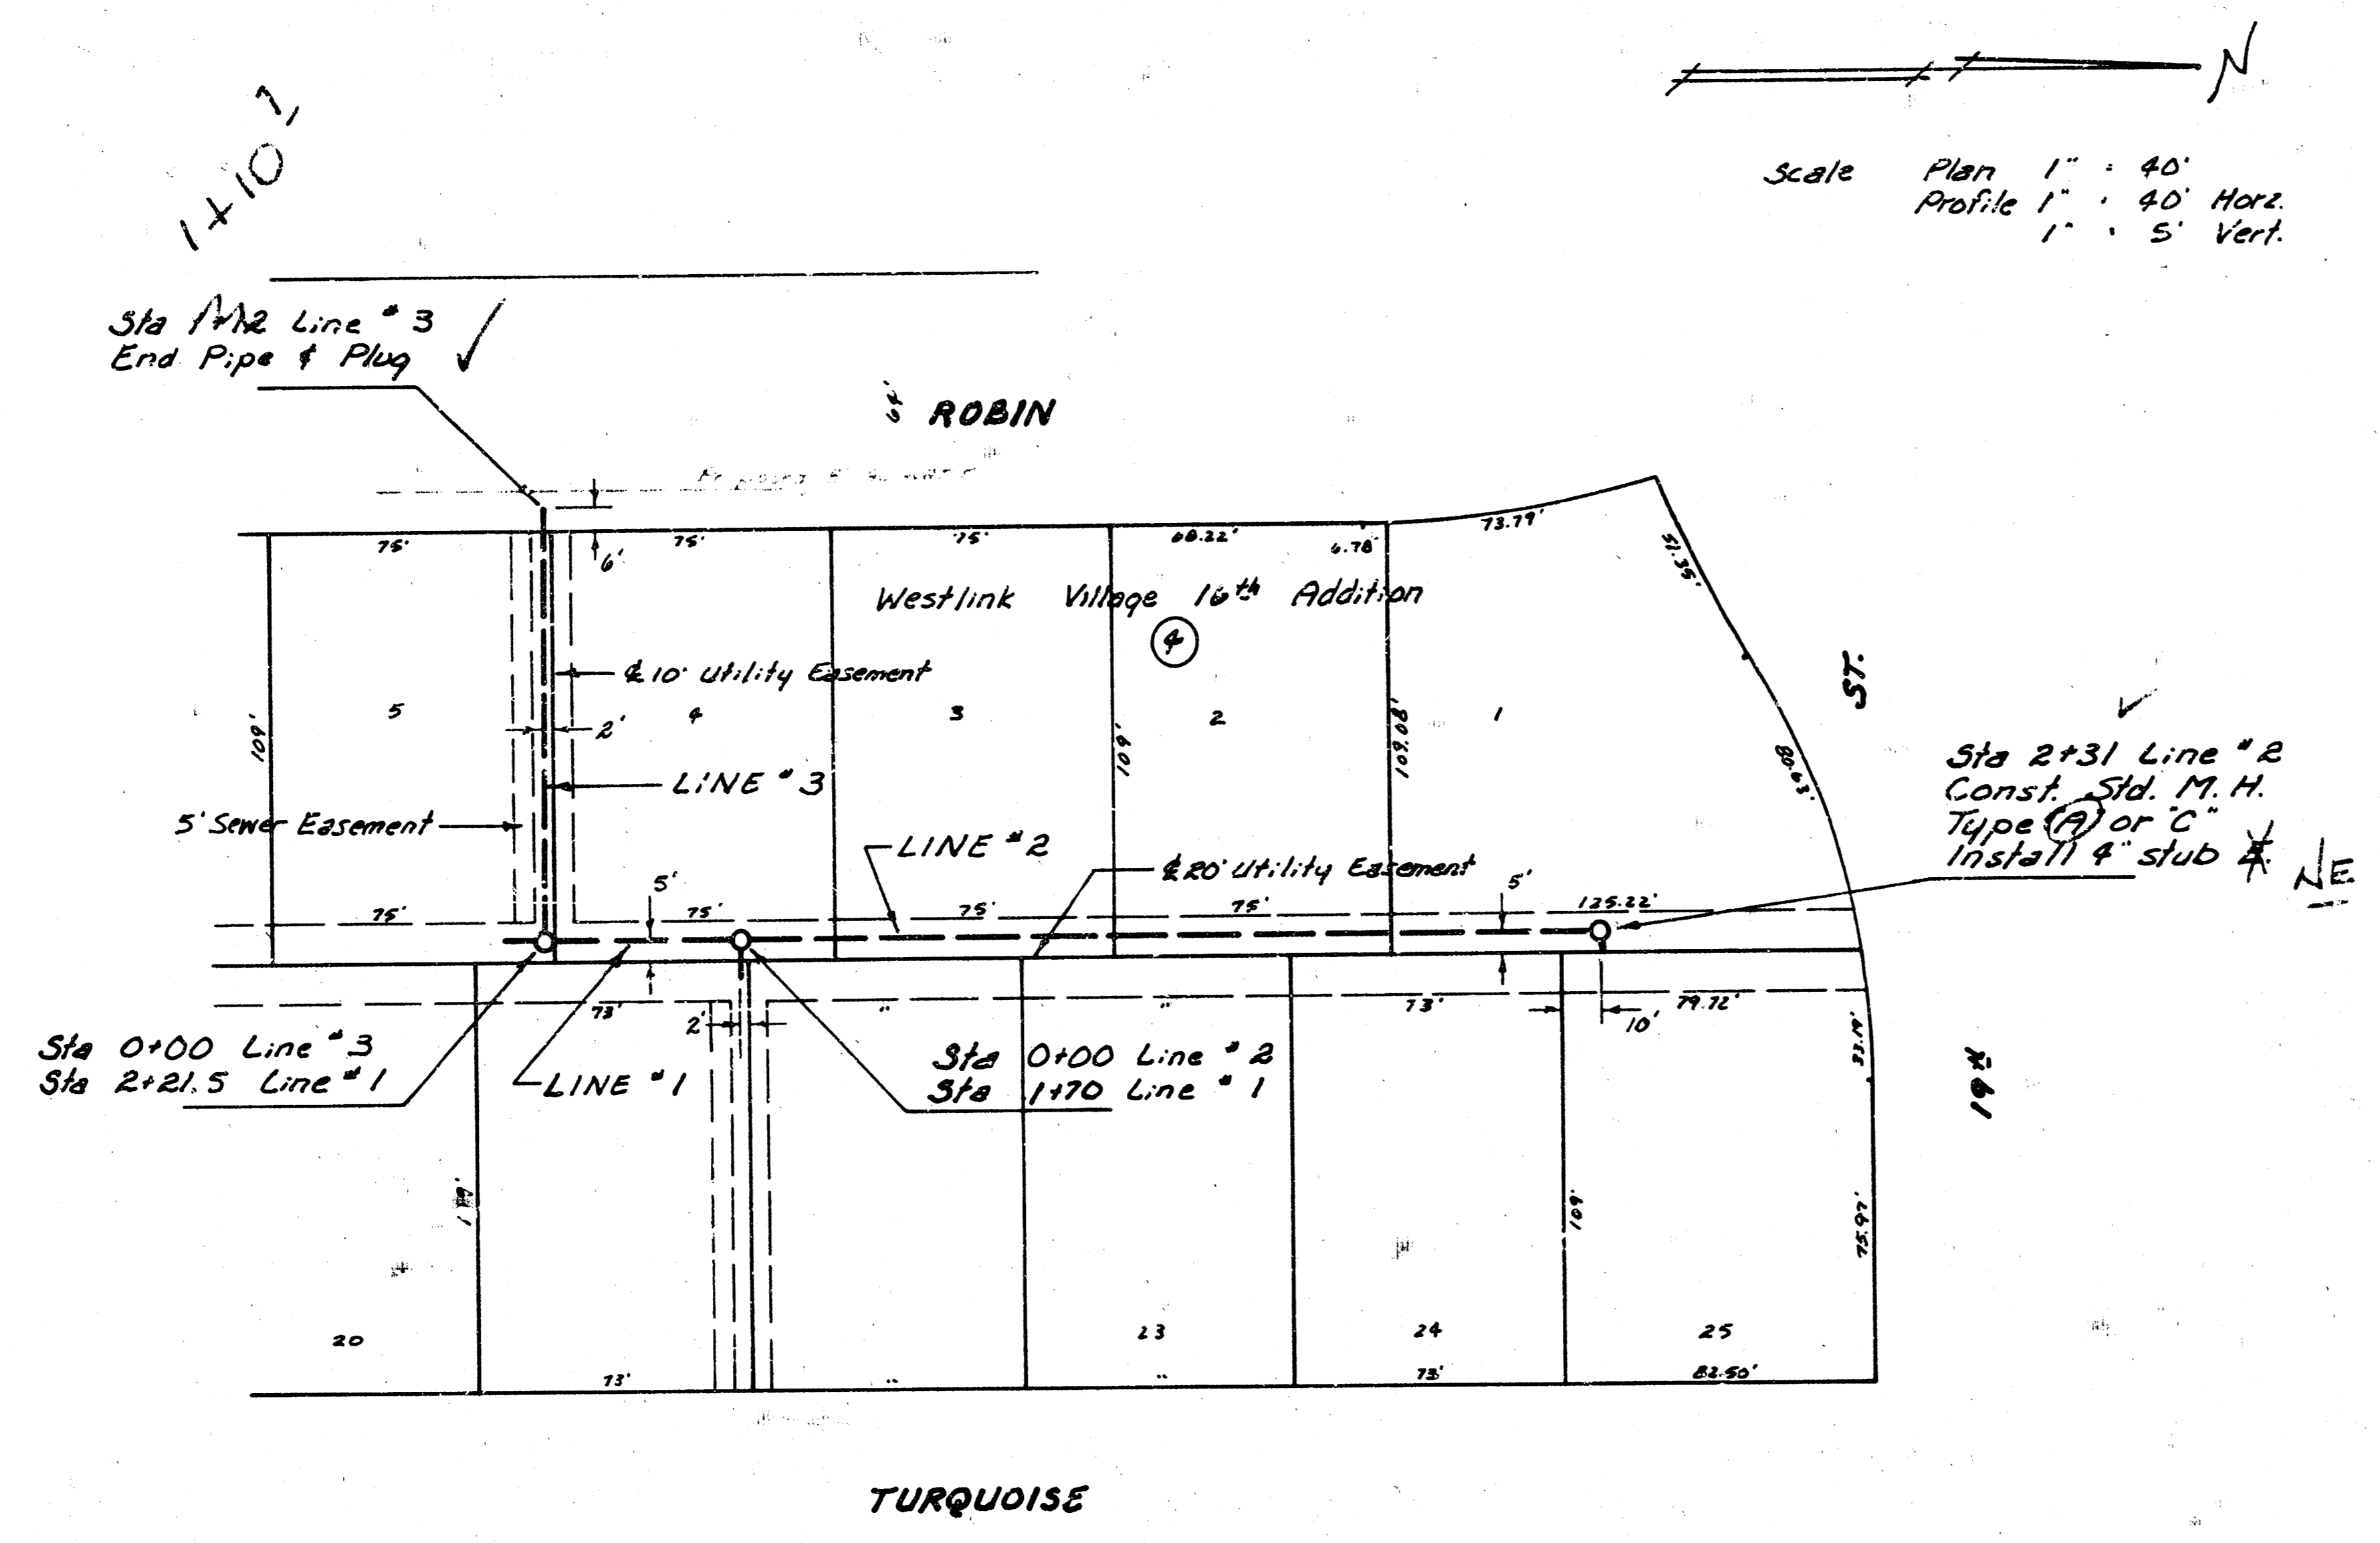

Scale Plan 1" = 40'
 Profile 1" = 40' Horiz.
 1" = 5' Vert.

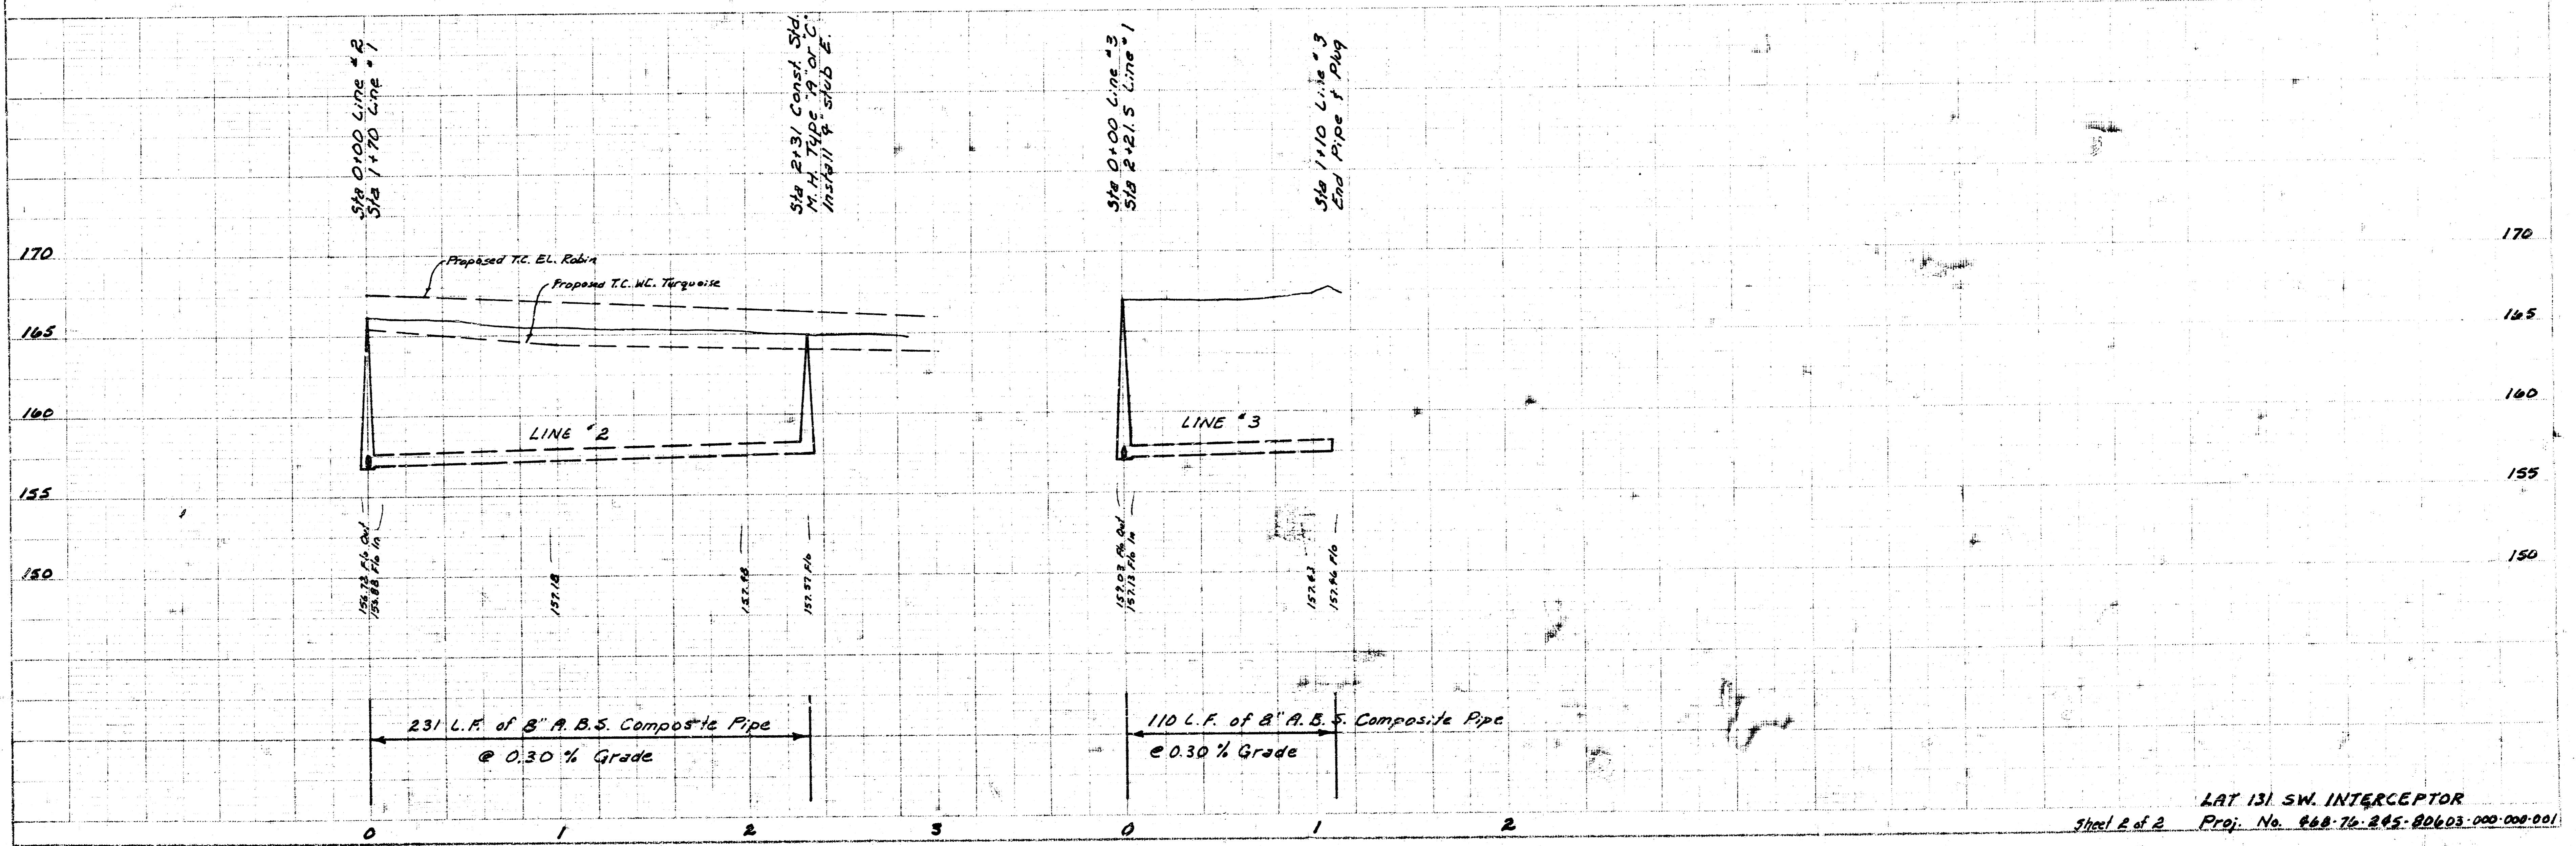

LAT 131 SW INTERCEPTOR
 Sheet 2 of 2 Proj. No. 468-76-245-02603-000-001

14-8-5-10

THE PLATE & PLAN PROFILE
 COMPANY & ENGINEERING CO.
 45 1024 MADE IN U.S.A.