

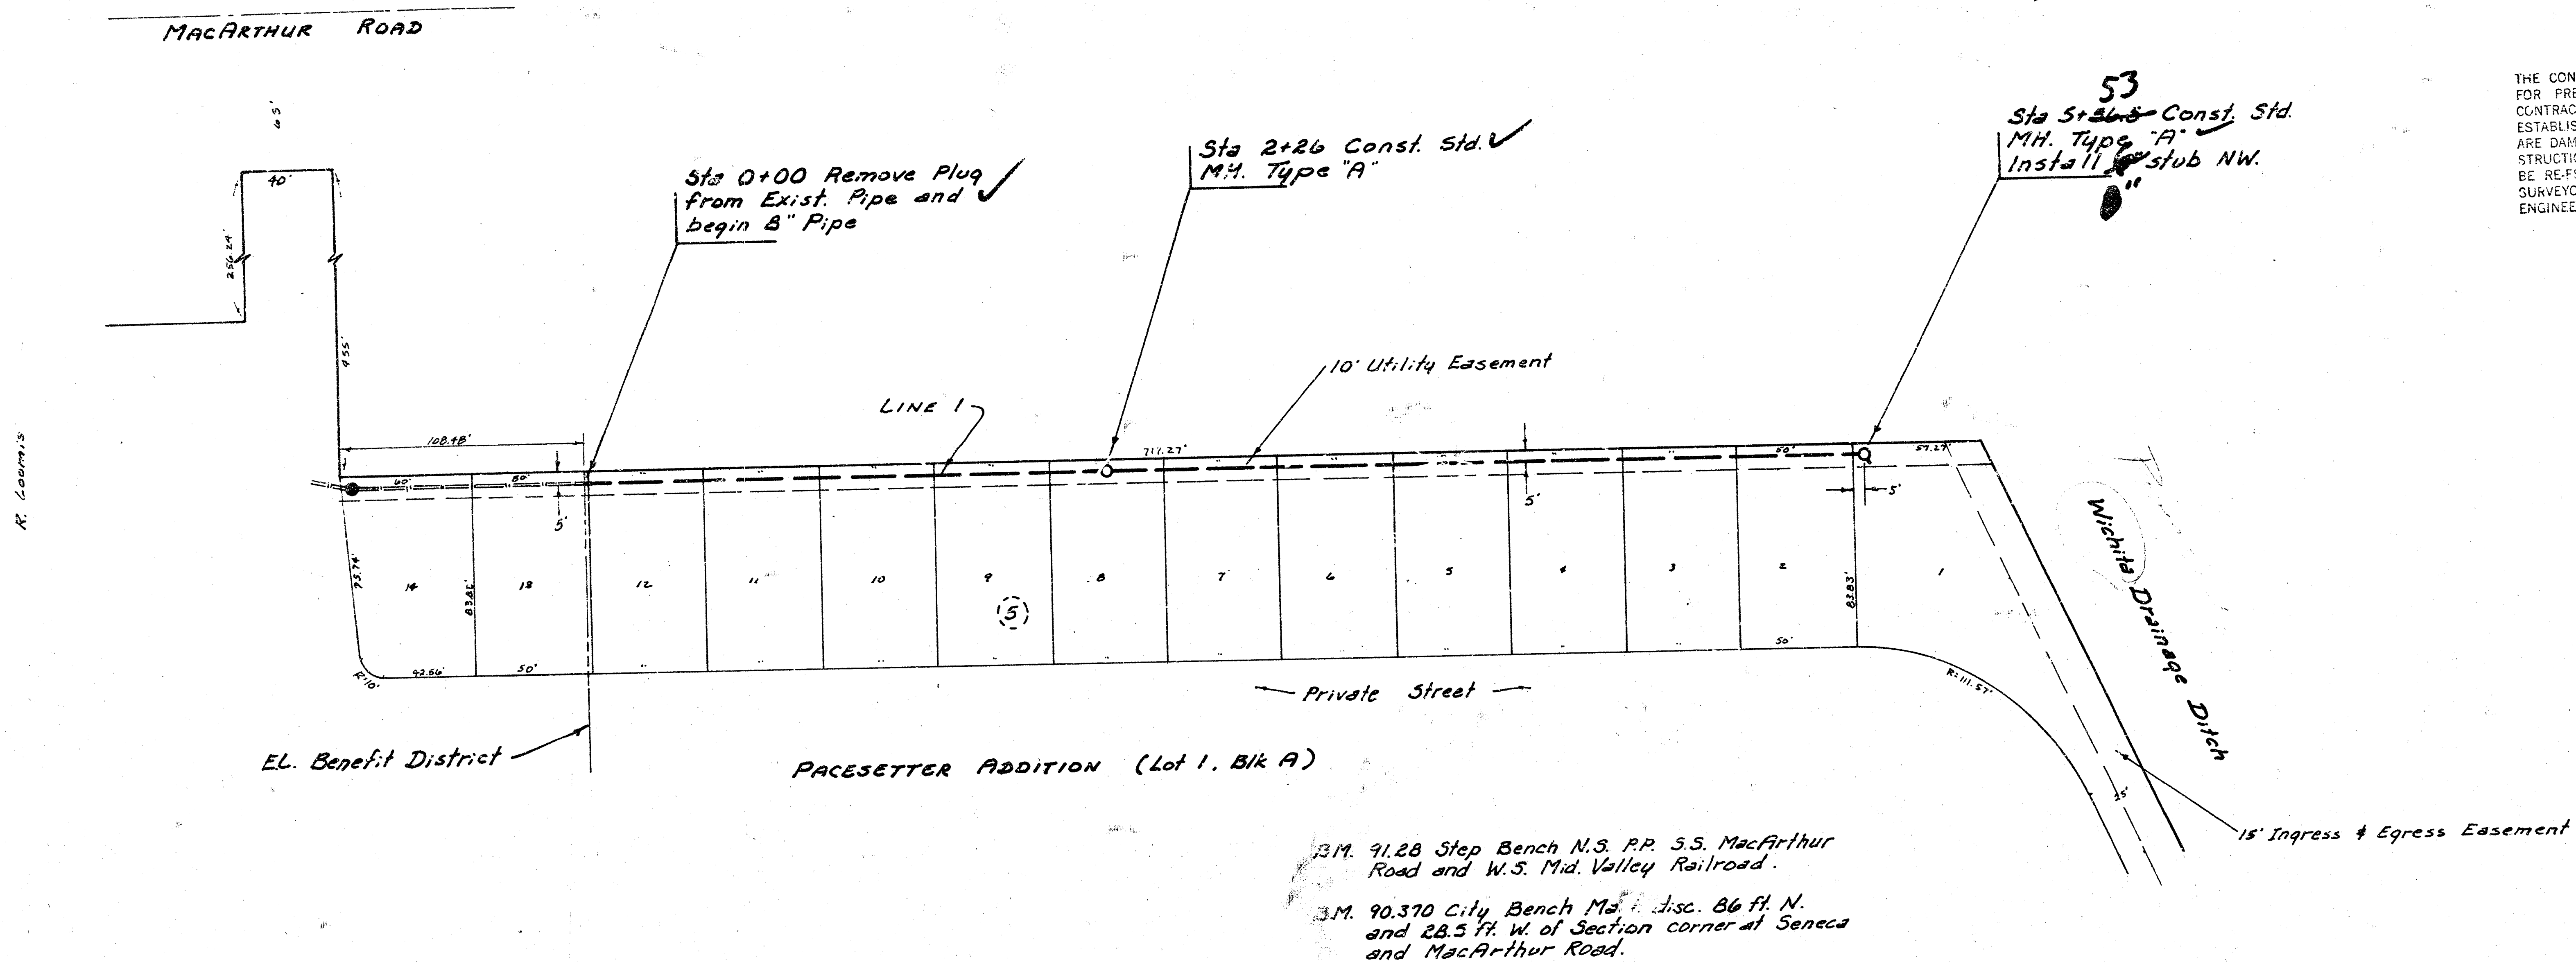


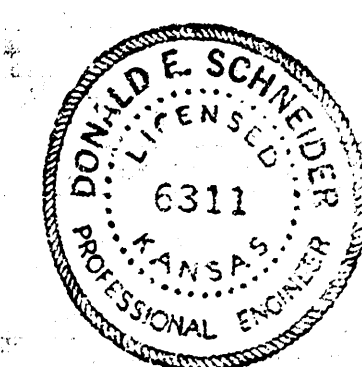

THE CONTRACTOR SHALL BE RESPONSIBLE FOR PRESERVING PROPERTY IRONS. THE CONTRACTOR SHALL BE REQUIRED TO RE-ESTABLISH ANY PROPERTY IRONS WHICH ARE DAMAGED OR DESTROYED BY HIS CONSTRUCTION OPERATIONS. SUCH IRONS SHALL BE RE-ESTABLISHED BY A LICENSED LAND SURVEYOR OR A LICENSED PROFESSIONAL ENGINEER IN ACCORDANCE WITH STATE LAWS.


Scale Plan 1" = 40' Horiz.
Profile 1" = 40' Horiz.
1" = 5' Vert.

As Built
11/8/

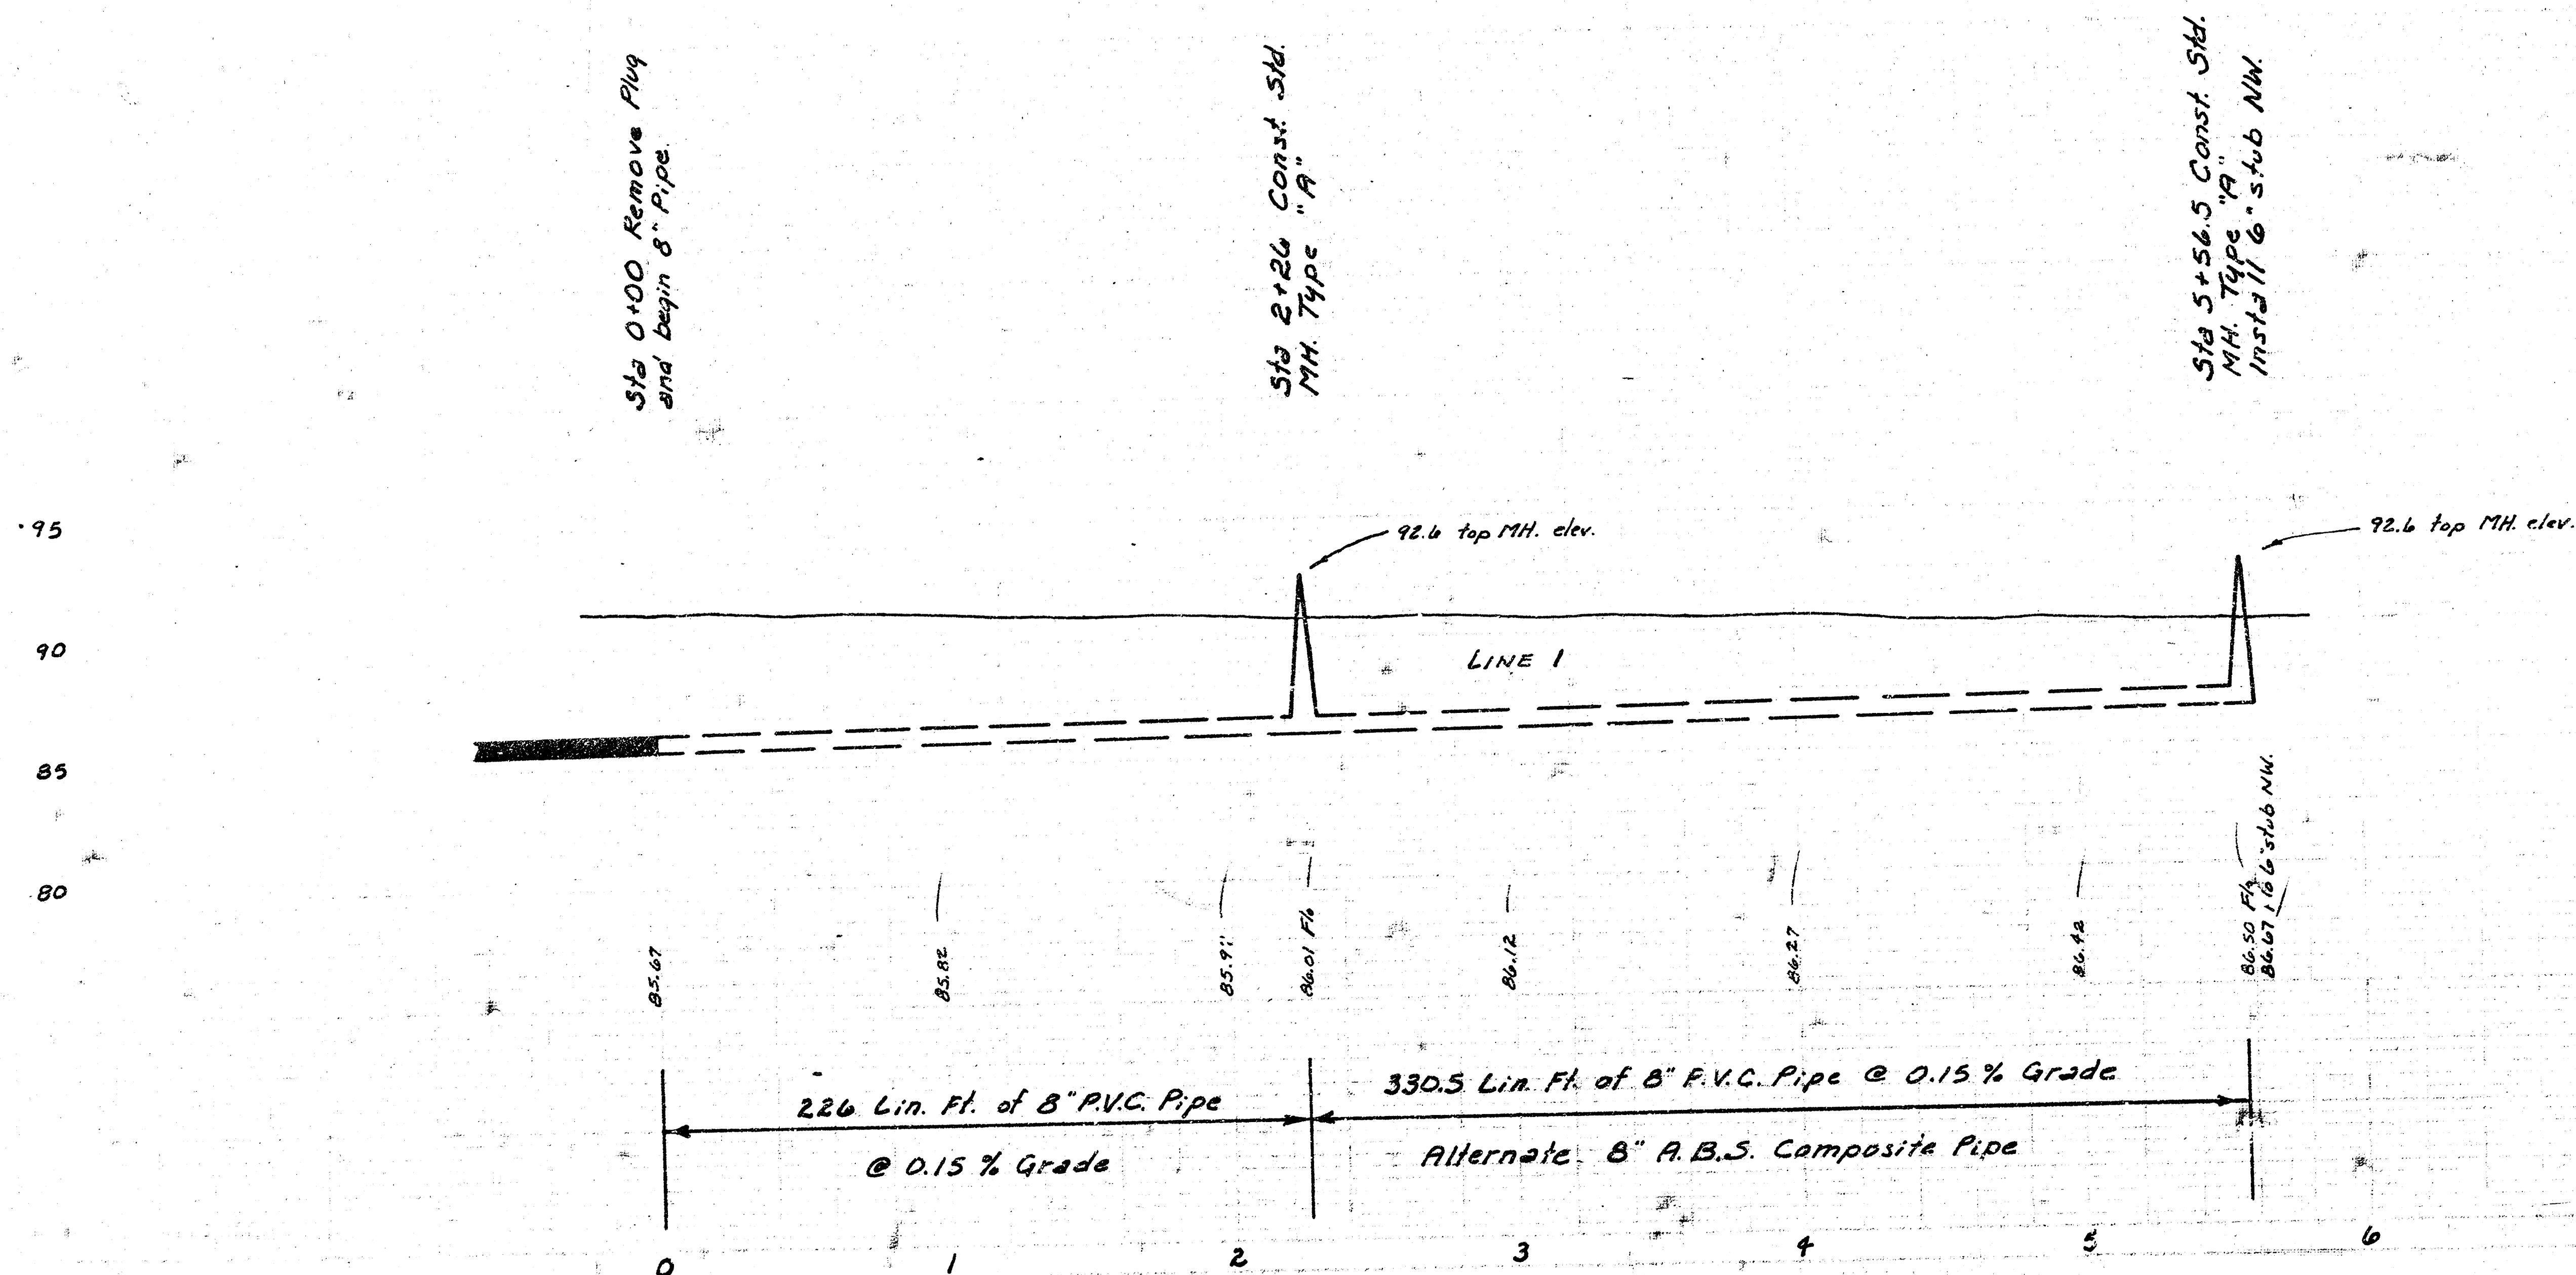


LAT 163, SW. INTERCEPTOR
CITY OF WICHITA, KANSAS
R.W. BRUGGEMAN
DIRECTOR OF ENGINEERING / CITY ENGINEER
PROJ. NO 468-76-245-81053-000-000-001

1/2

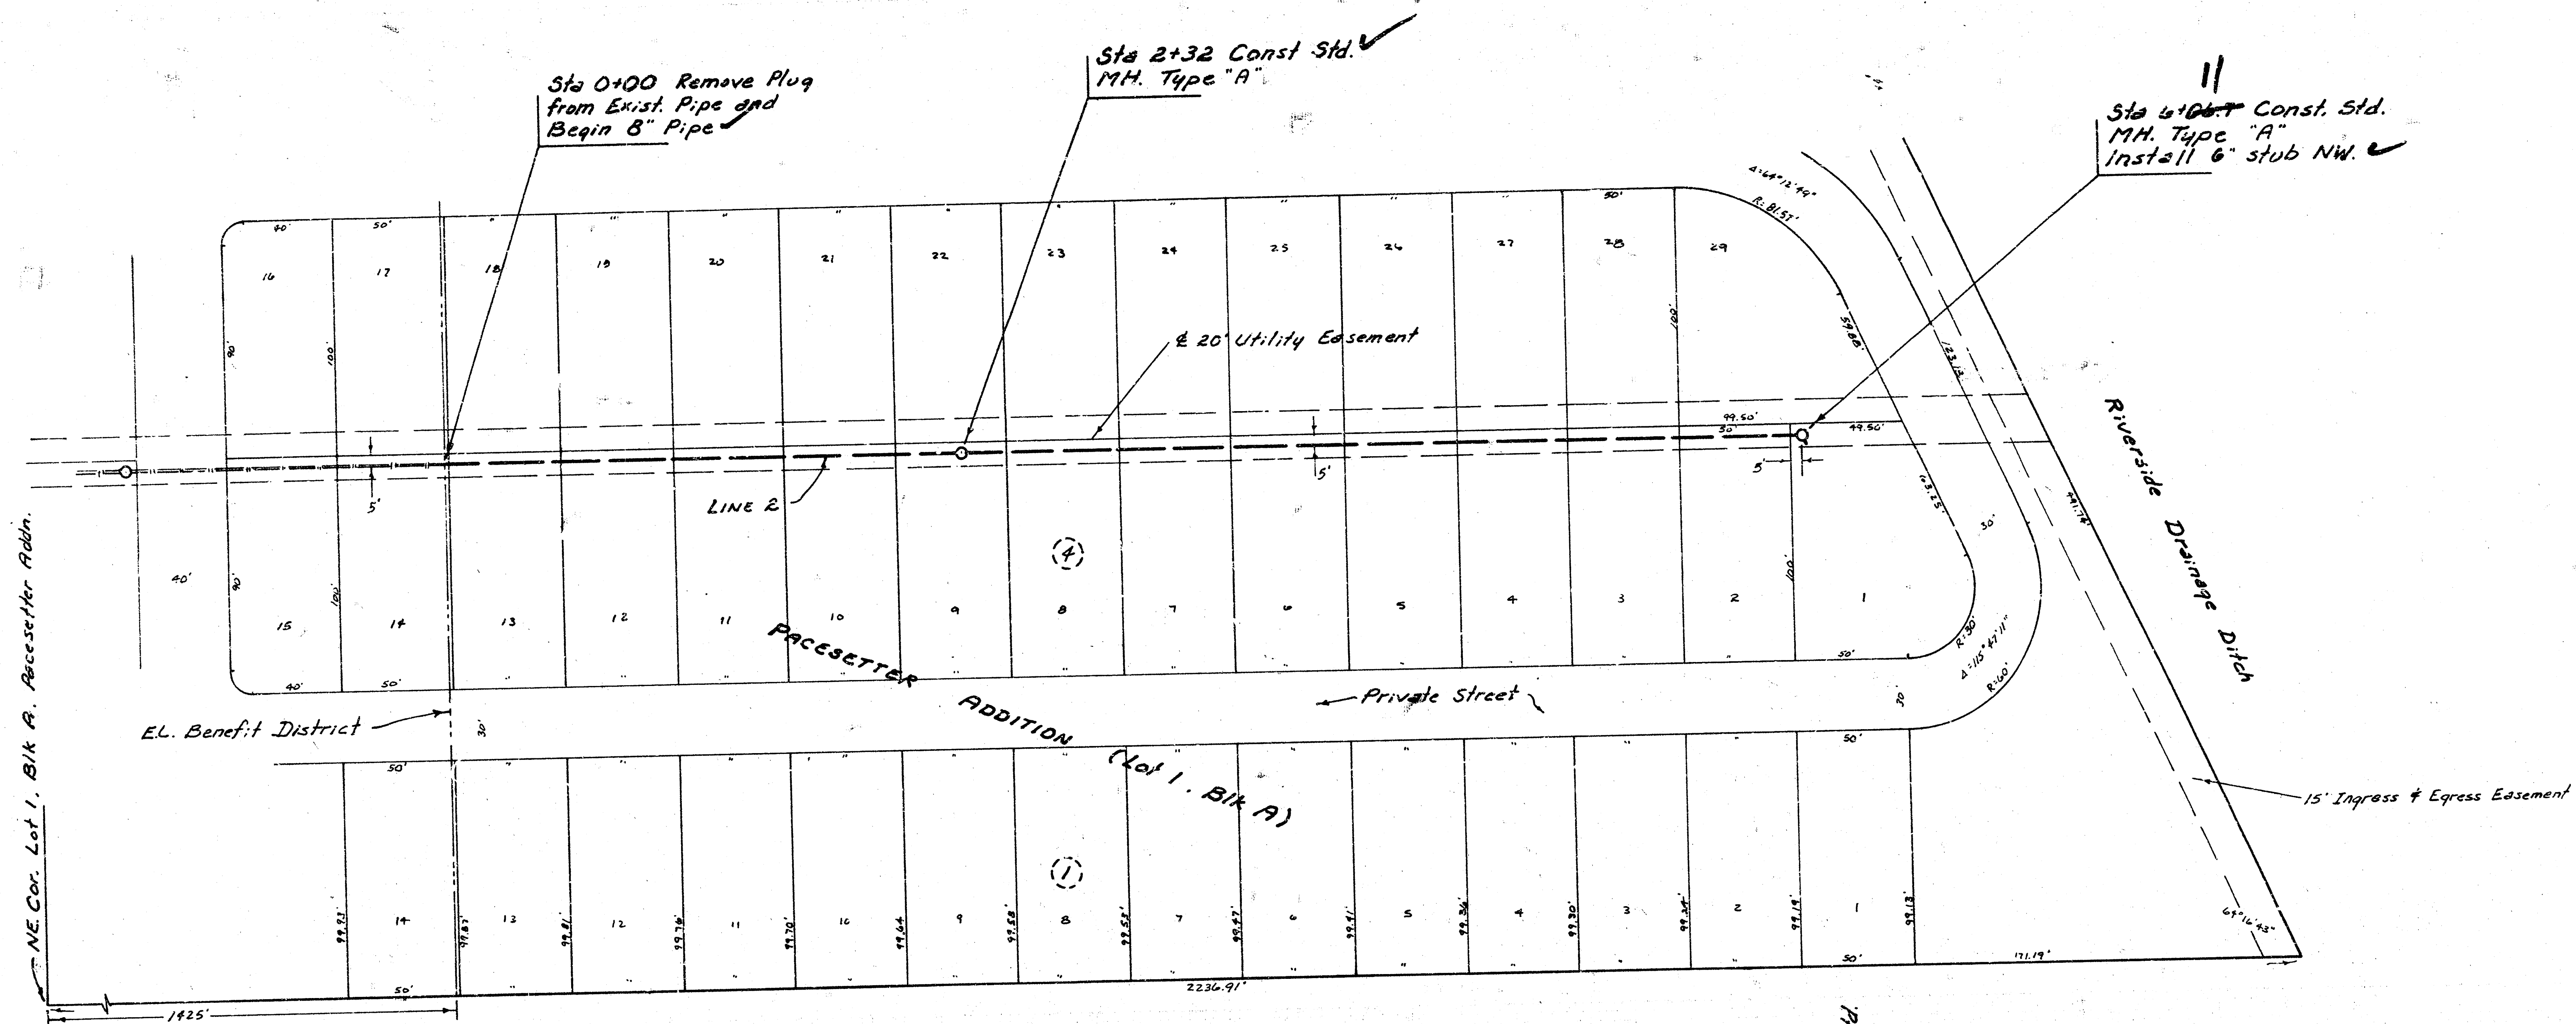

Scale Plan 1" = 40'
Profile 1" = 40' Horiz.
1" = 5' Vert.

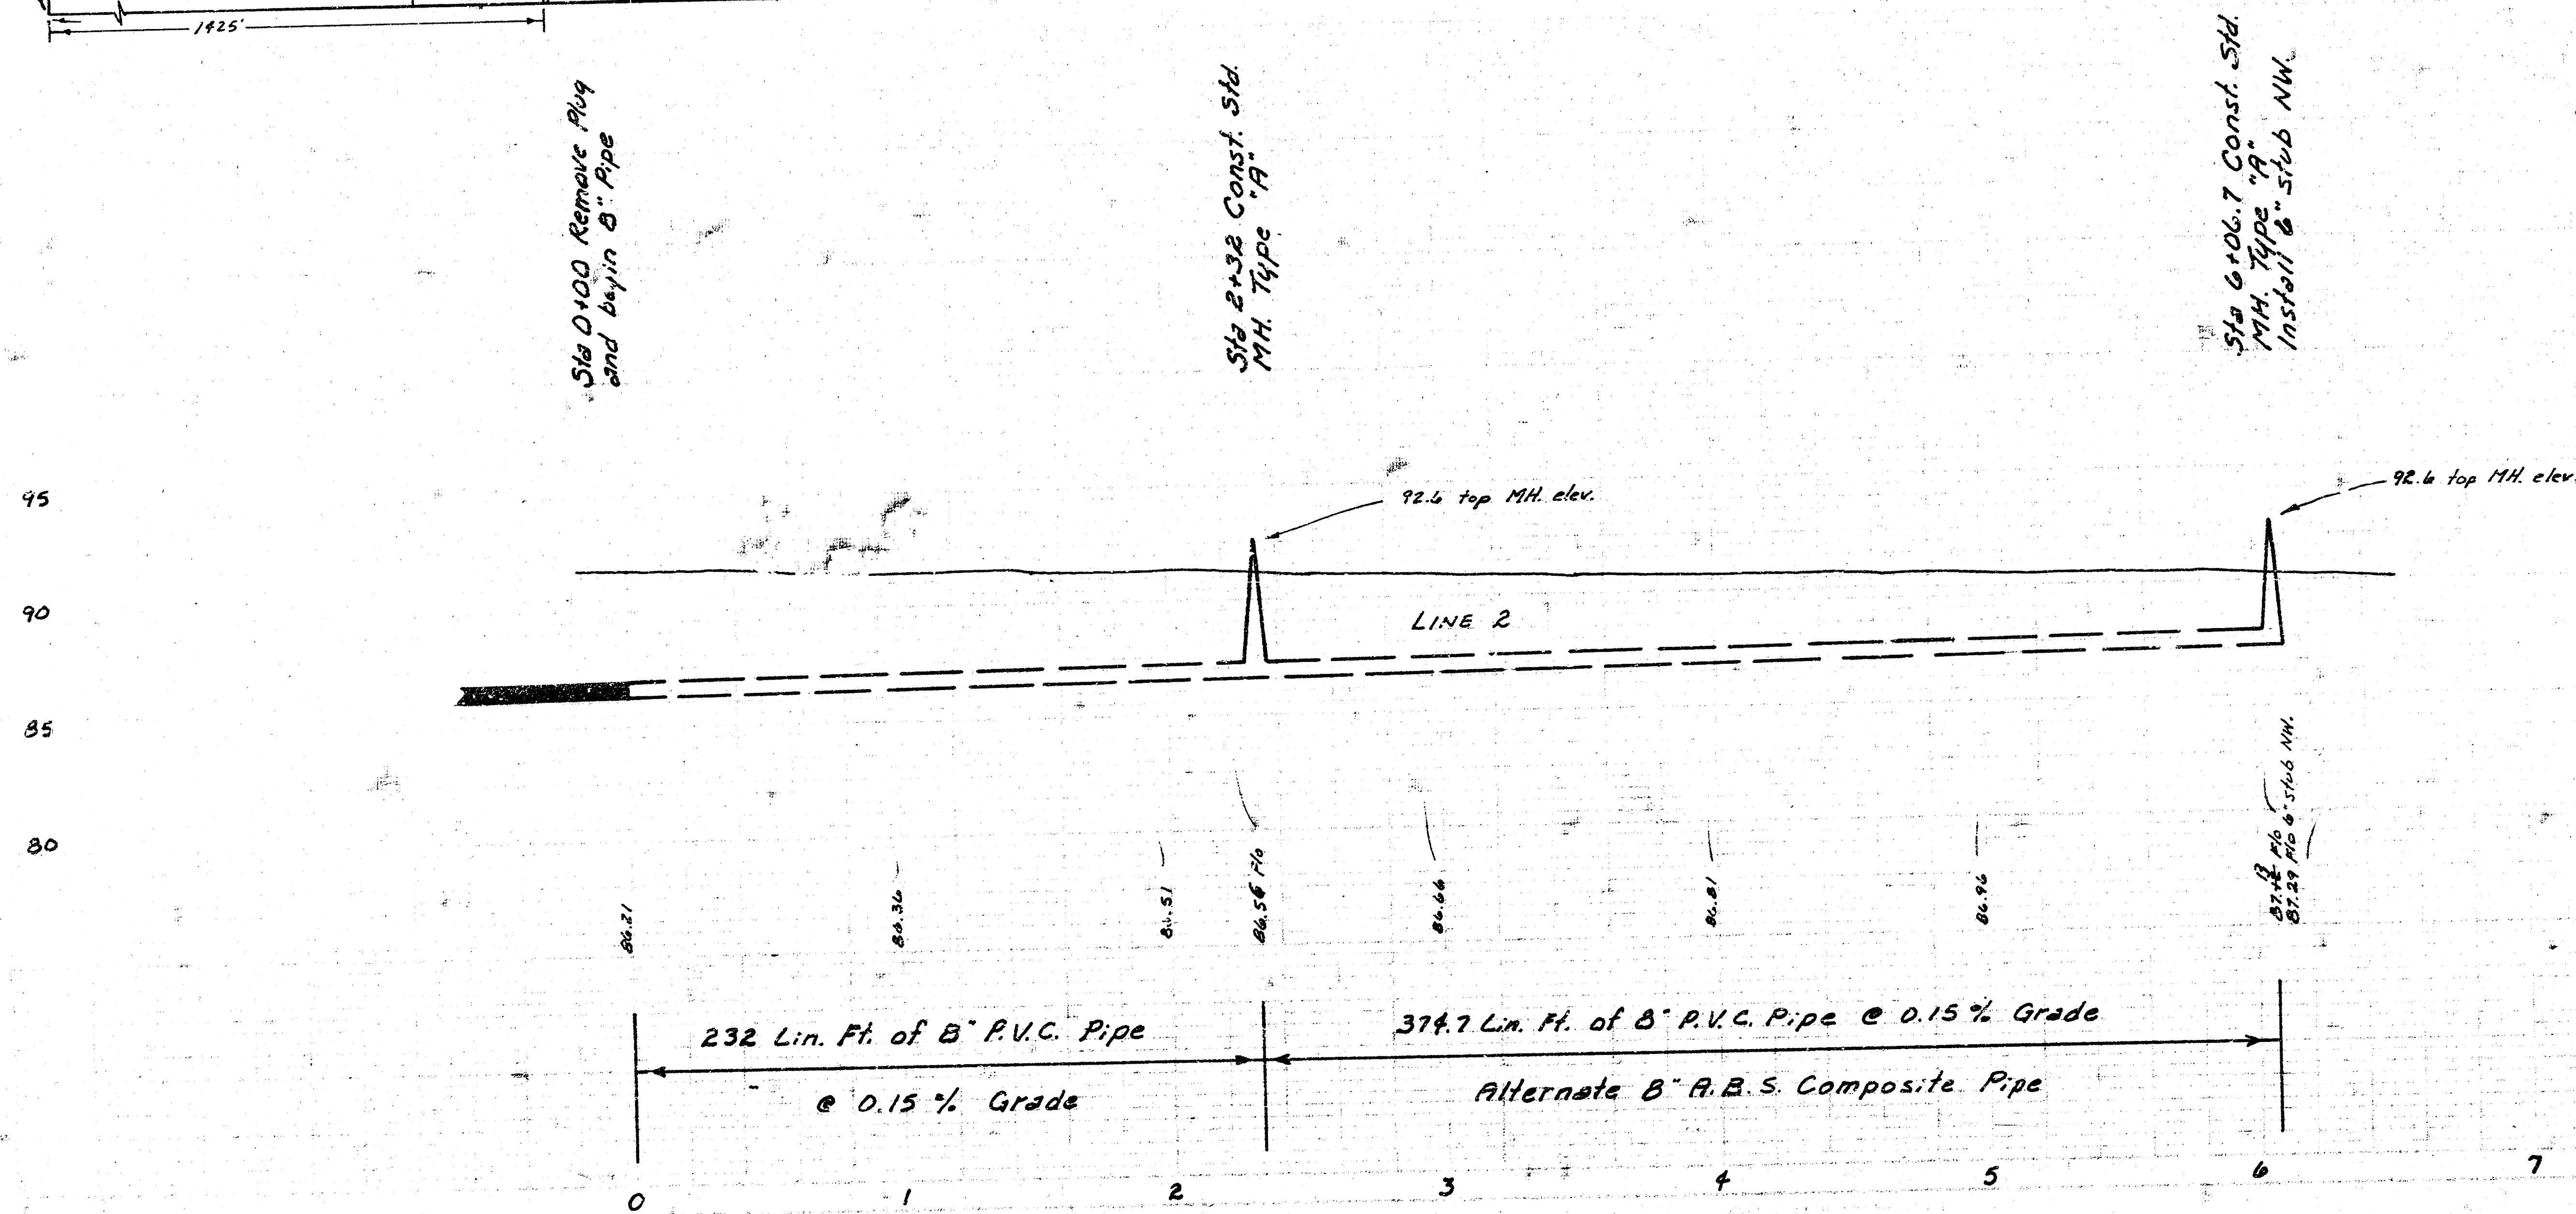

As Built
11/81
JEF

95
90
85
80

2/2

Lot 163 SW Interceptor Sewer
408-16 2+5-81053-000-000-001

10