


CONSTRUCTION PLANS FOR
LATERAL 184
OF THE
SOUTHWEST INTERCEPTOR SEWER

THE CITY OF WICHITA,
SEDGWICK COUNTY, KANSAS
MICHAEL E. LINDEBAK, P.E., CITY ENGINEER

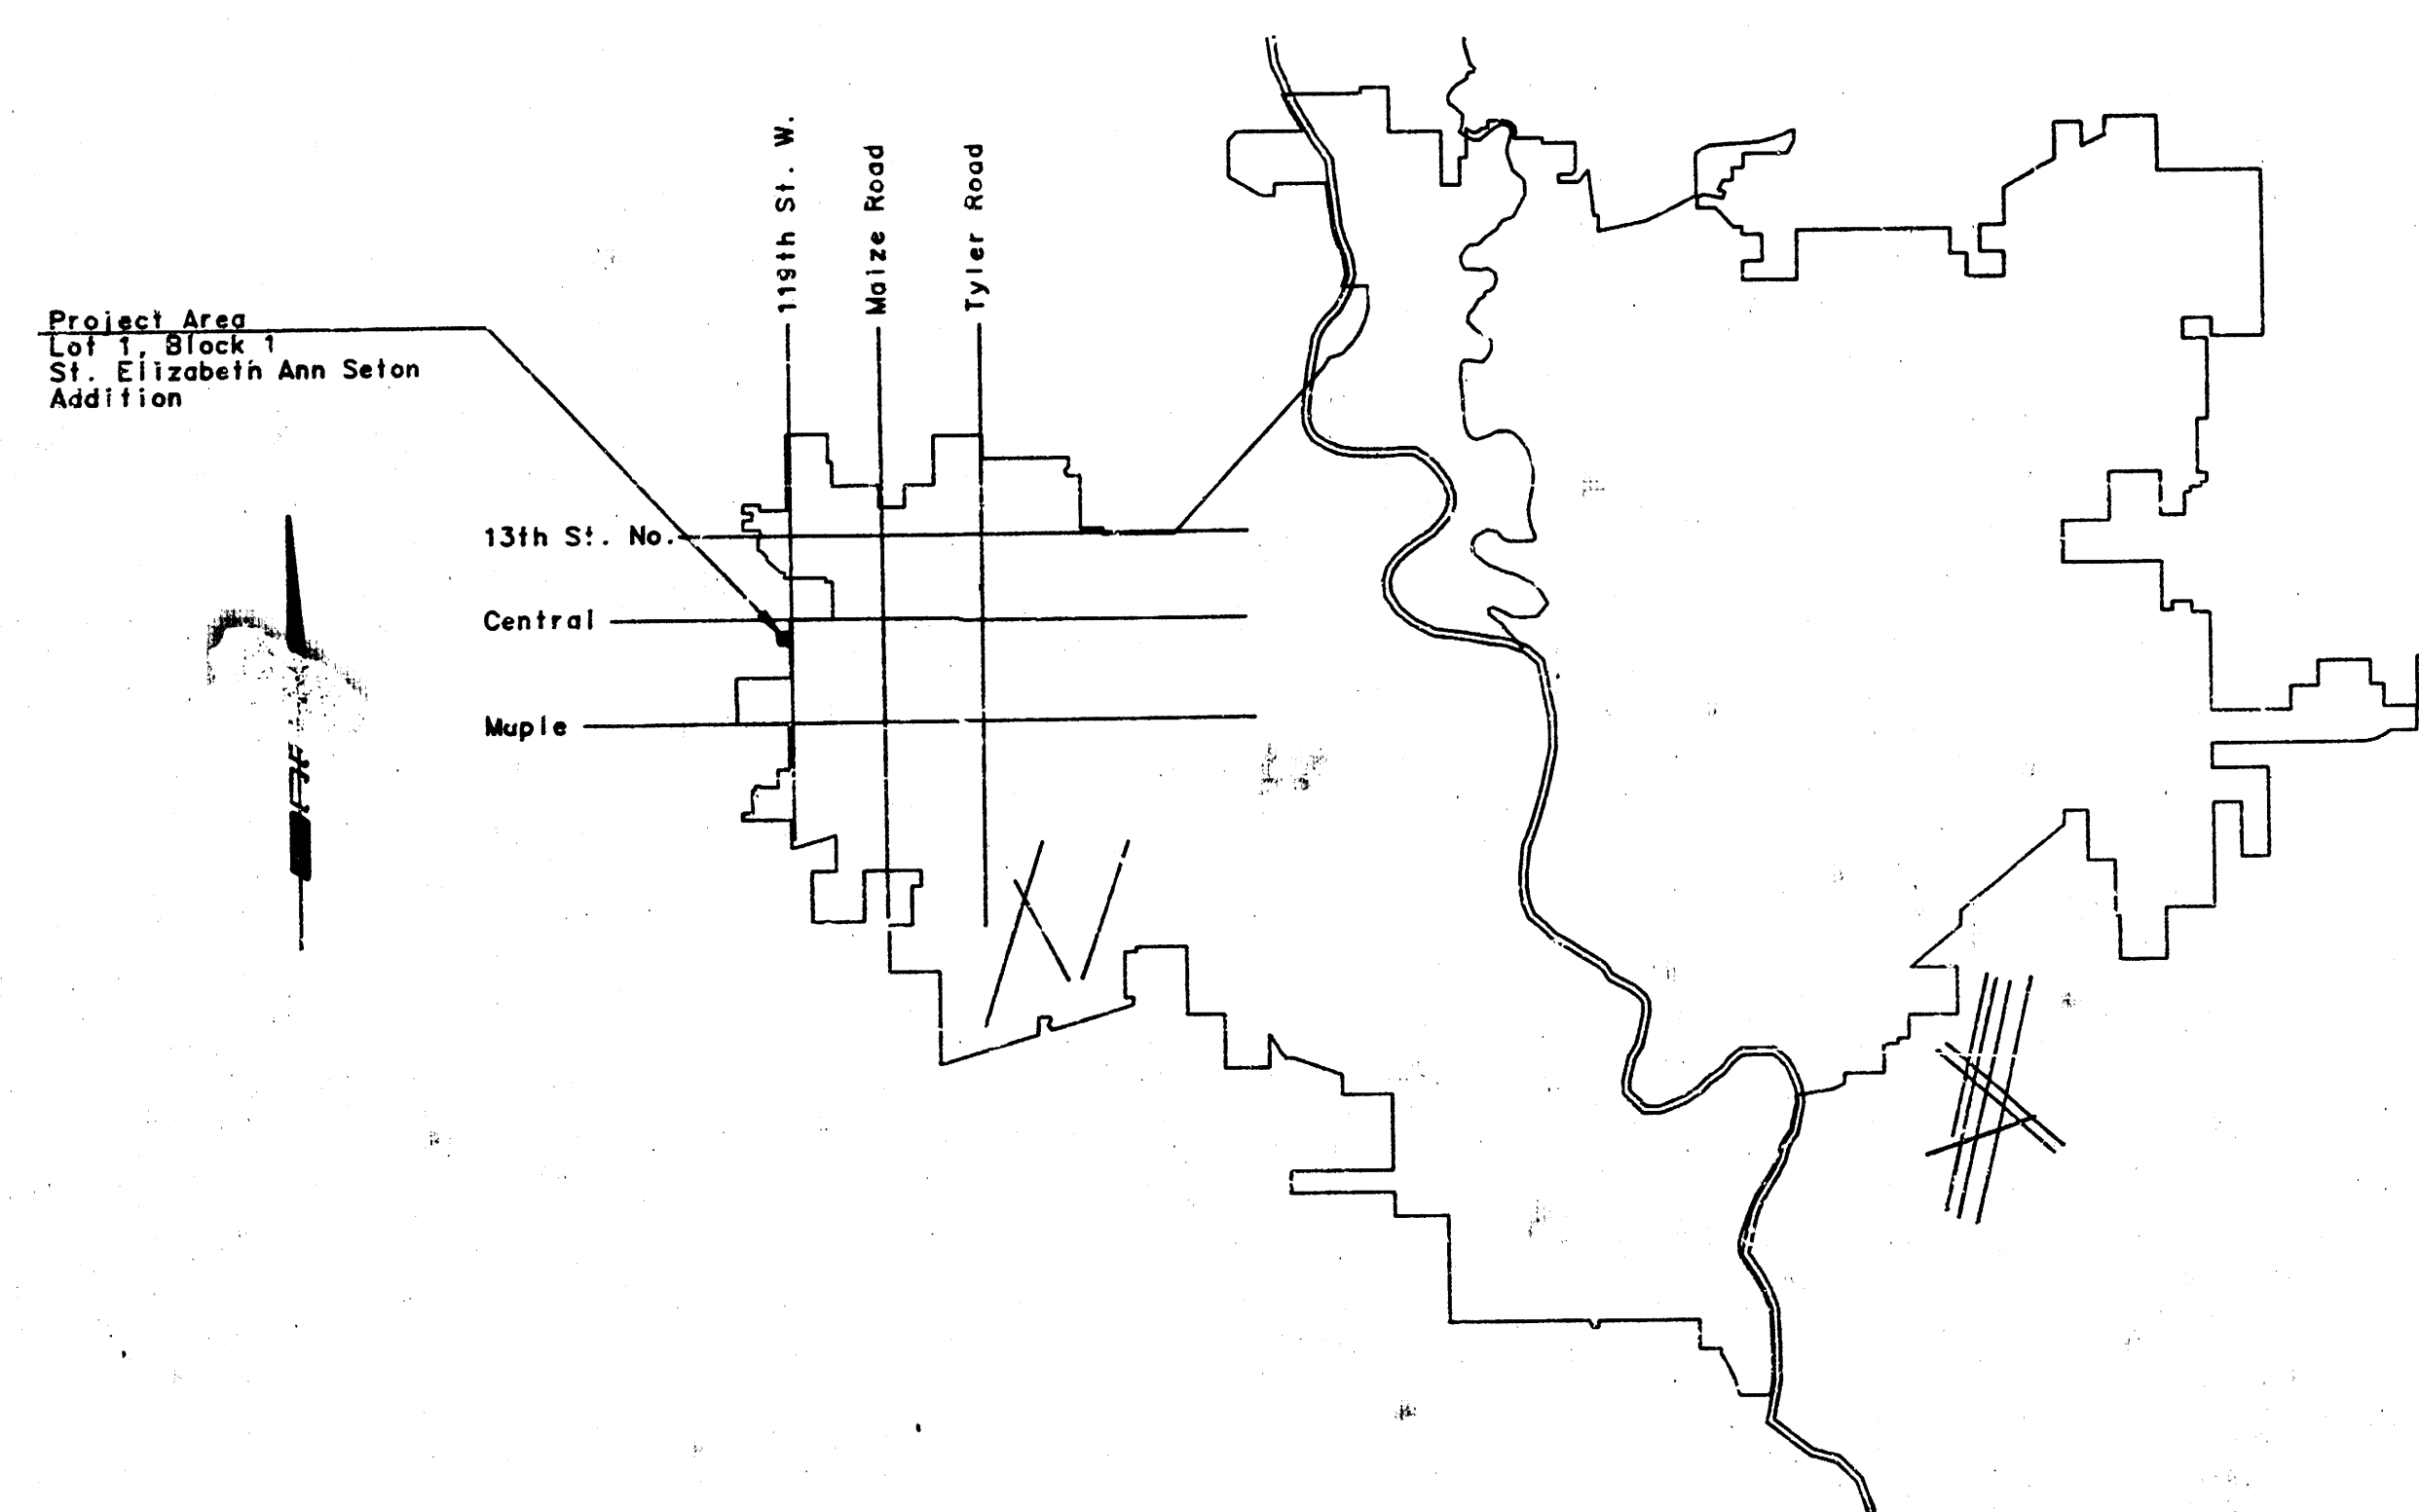


LOCATION MAP

CITY OF WICHITA PROJECT NO. 468-76-245-81364-000-000-001

SEPTEMBER, 1984

PLANS PREPARED BY




PROFESSIONAL ENGINEERING CONSULTANTS, P.A.
ENGINEERS
WICHITA, KANSAS

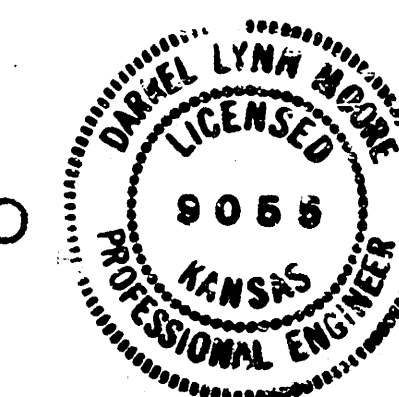

*As Built
3/85
CH*

1/2

PROFILE NOTE BOOK NO. _____	SURVIVED _____ PLOTTED _____ GRADES CHECKED _____ B. M. NOTED _____ STRUCTURE NOTATIONS (HARD) _____	BY _____ DATE _____
--	--	------------------------

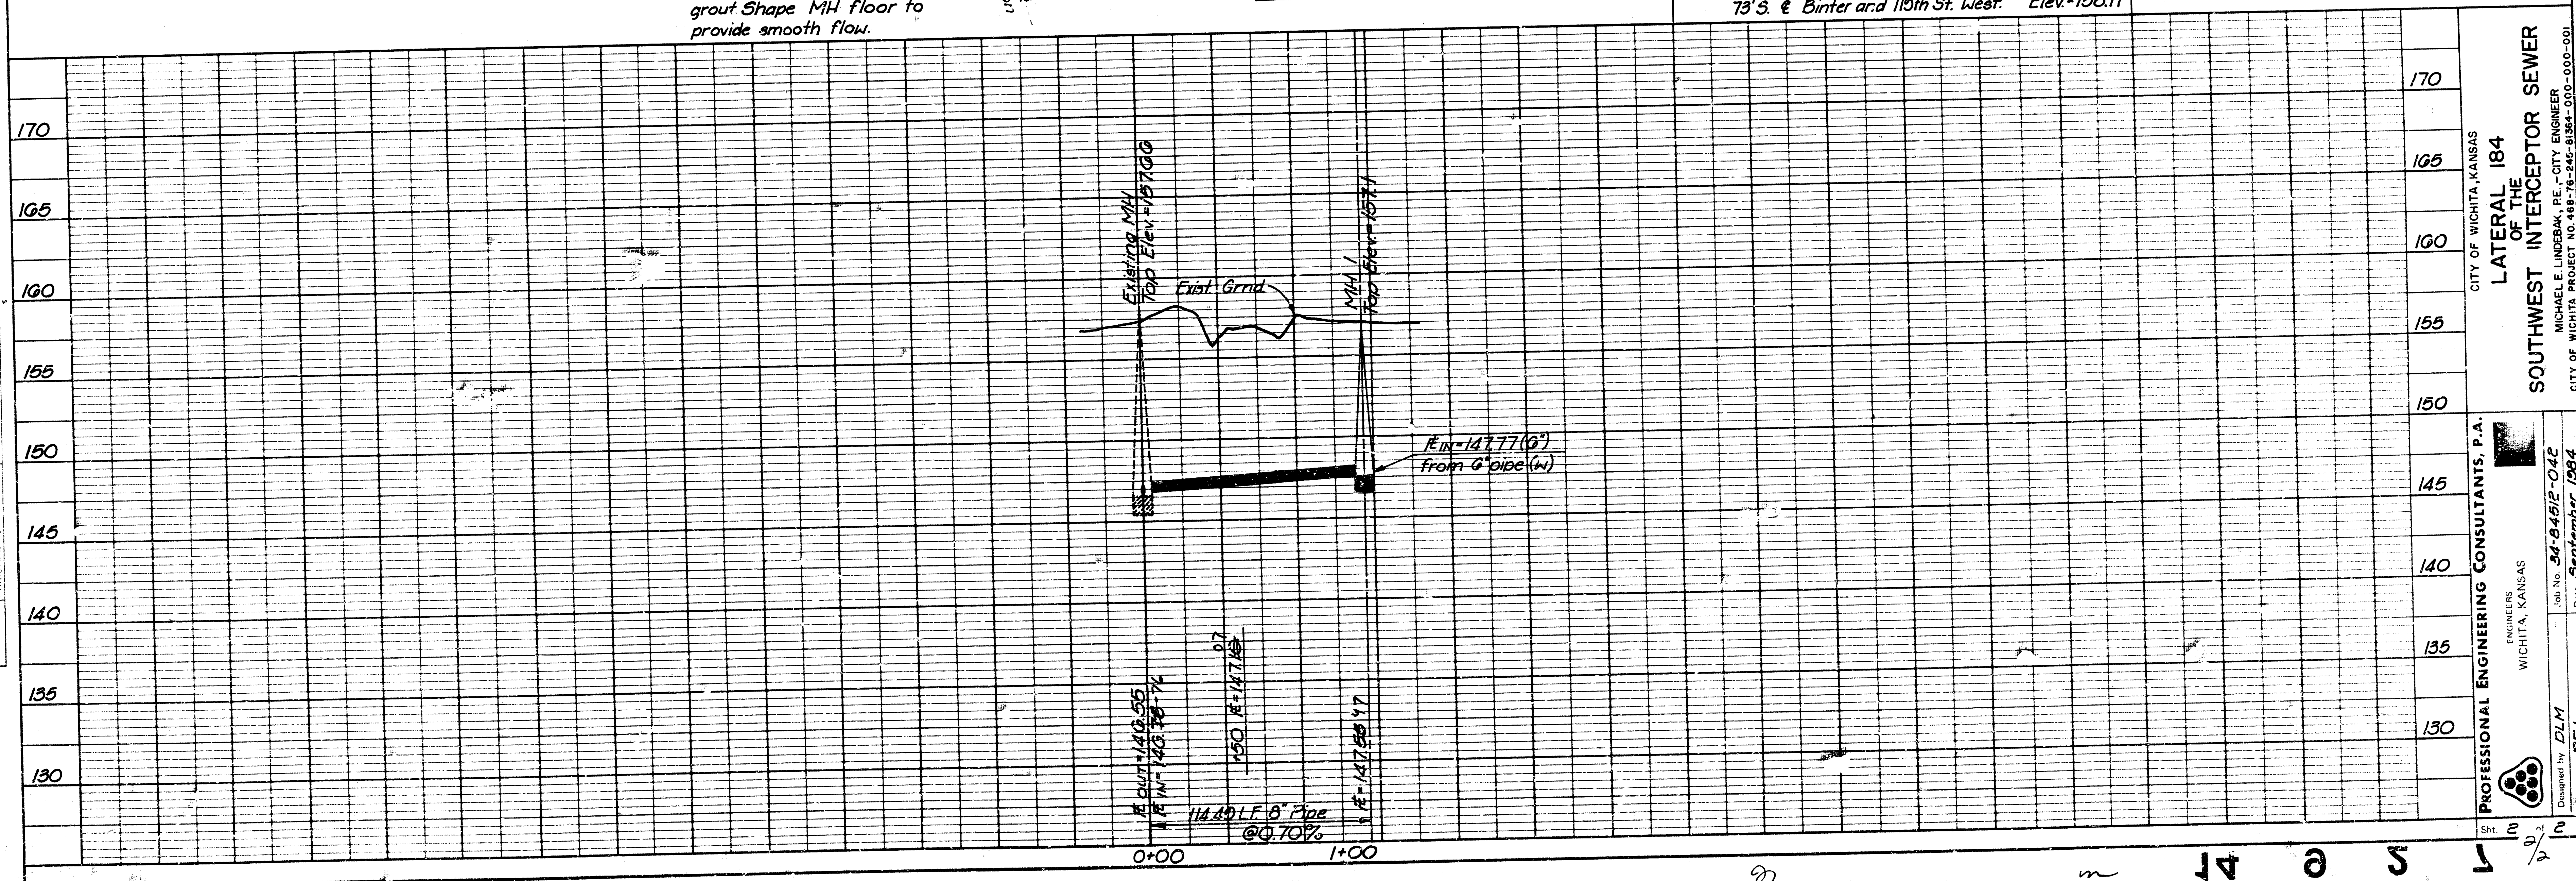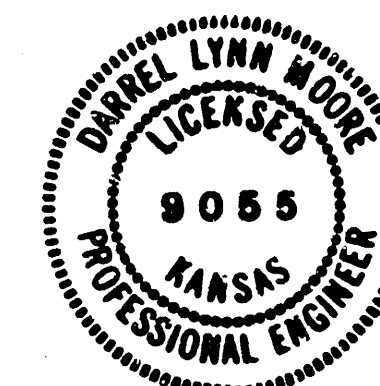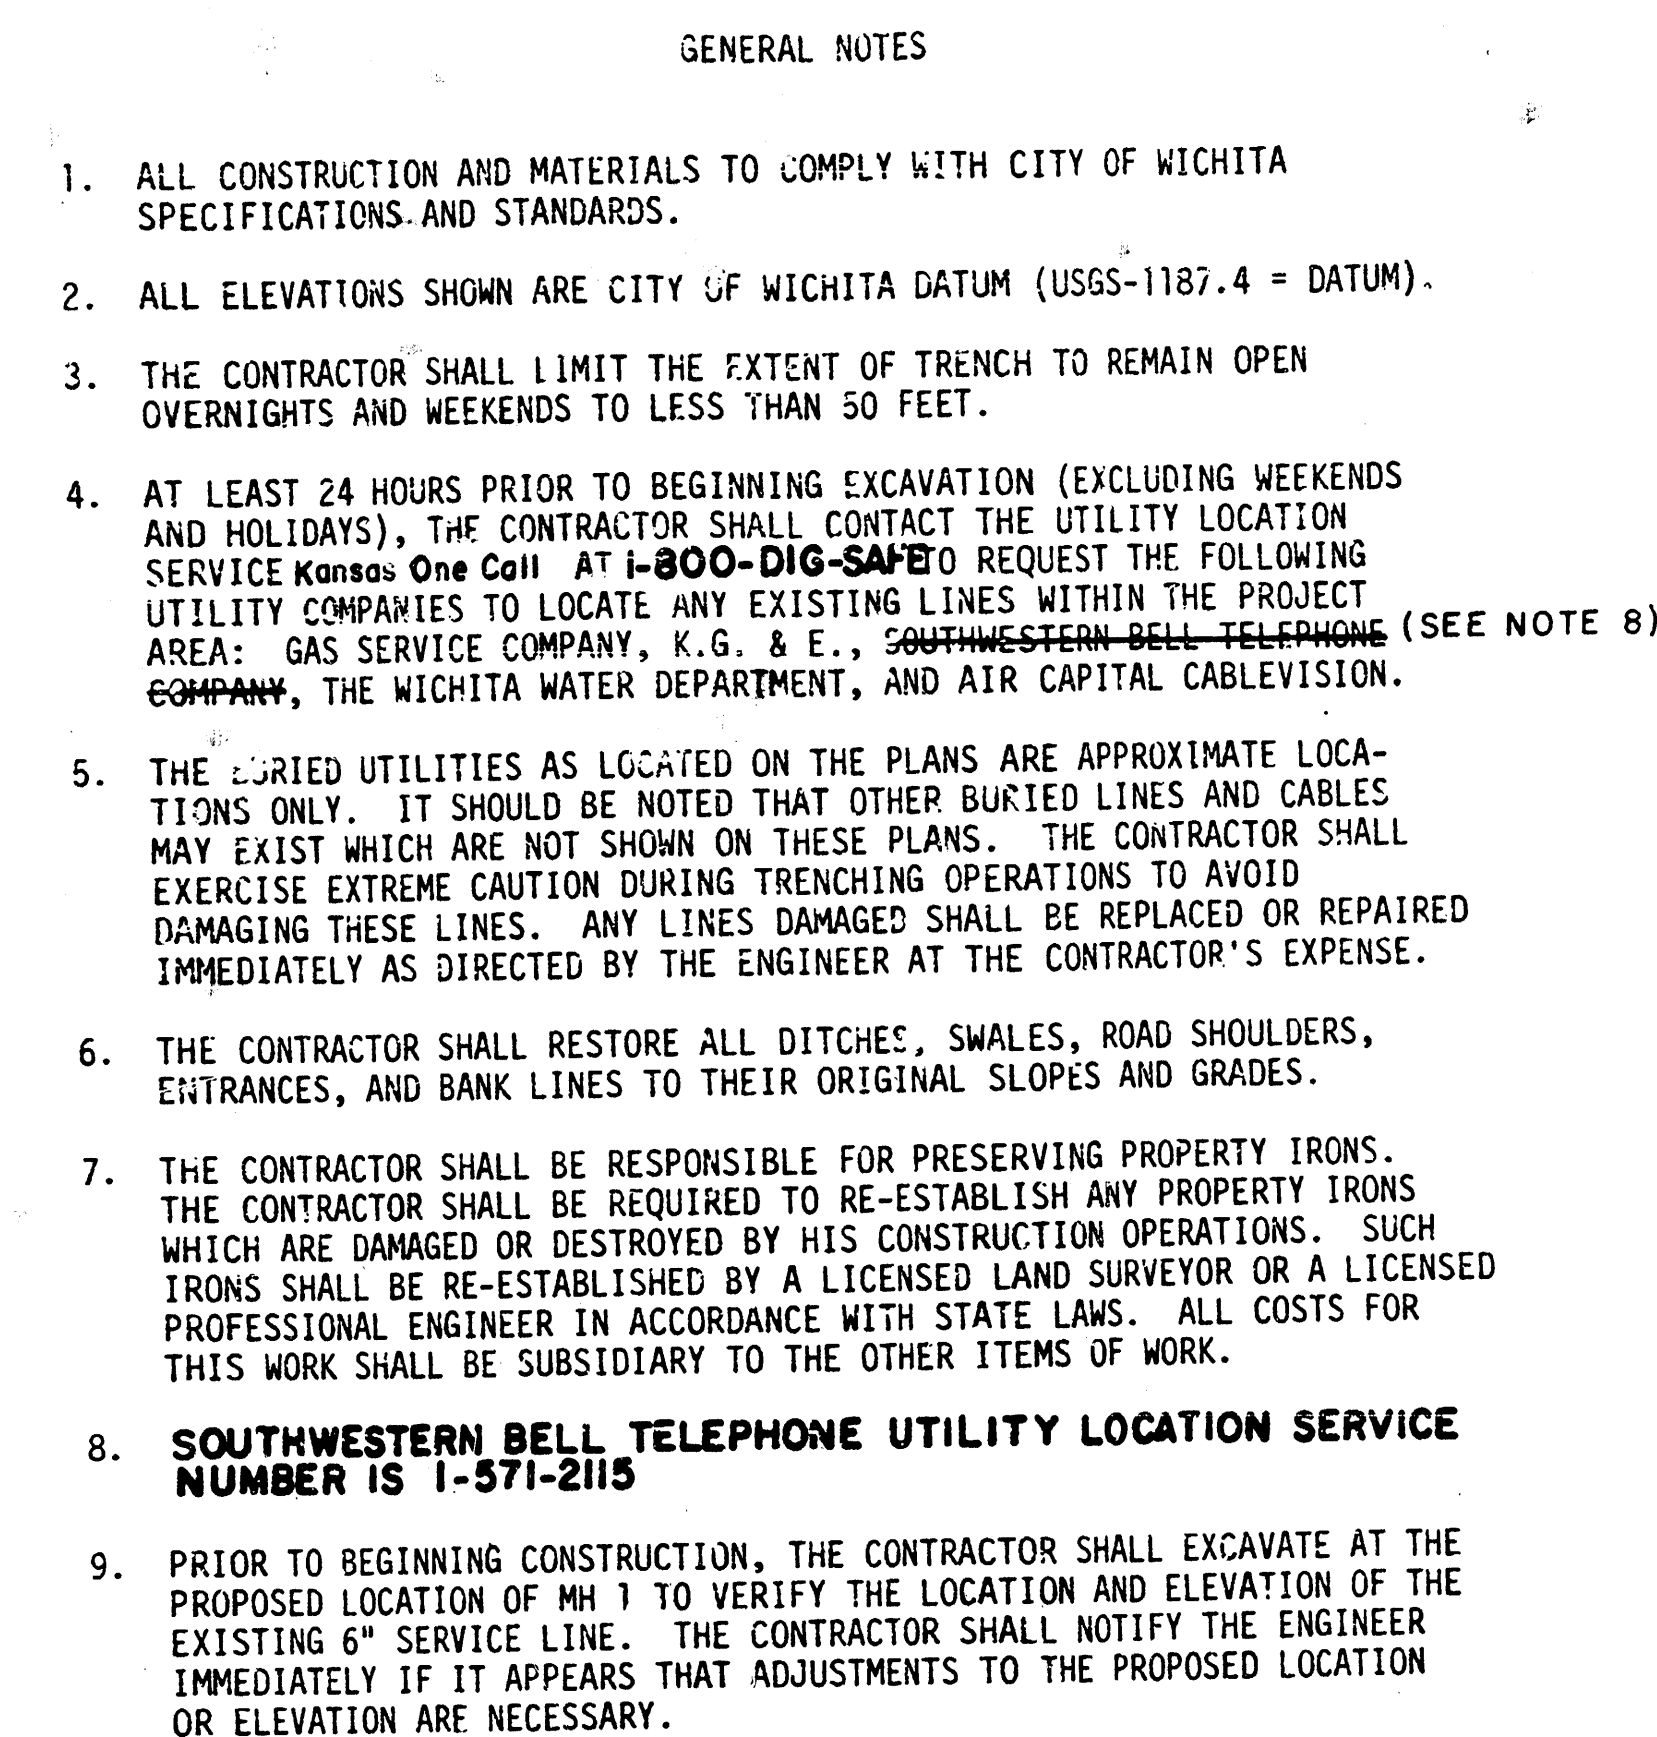

FILMED FROM THE BEST
AVAILABLE COPY