
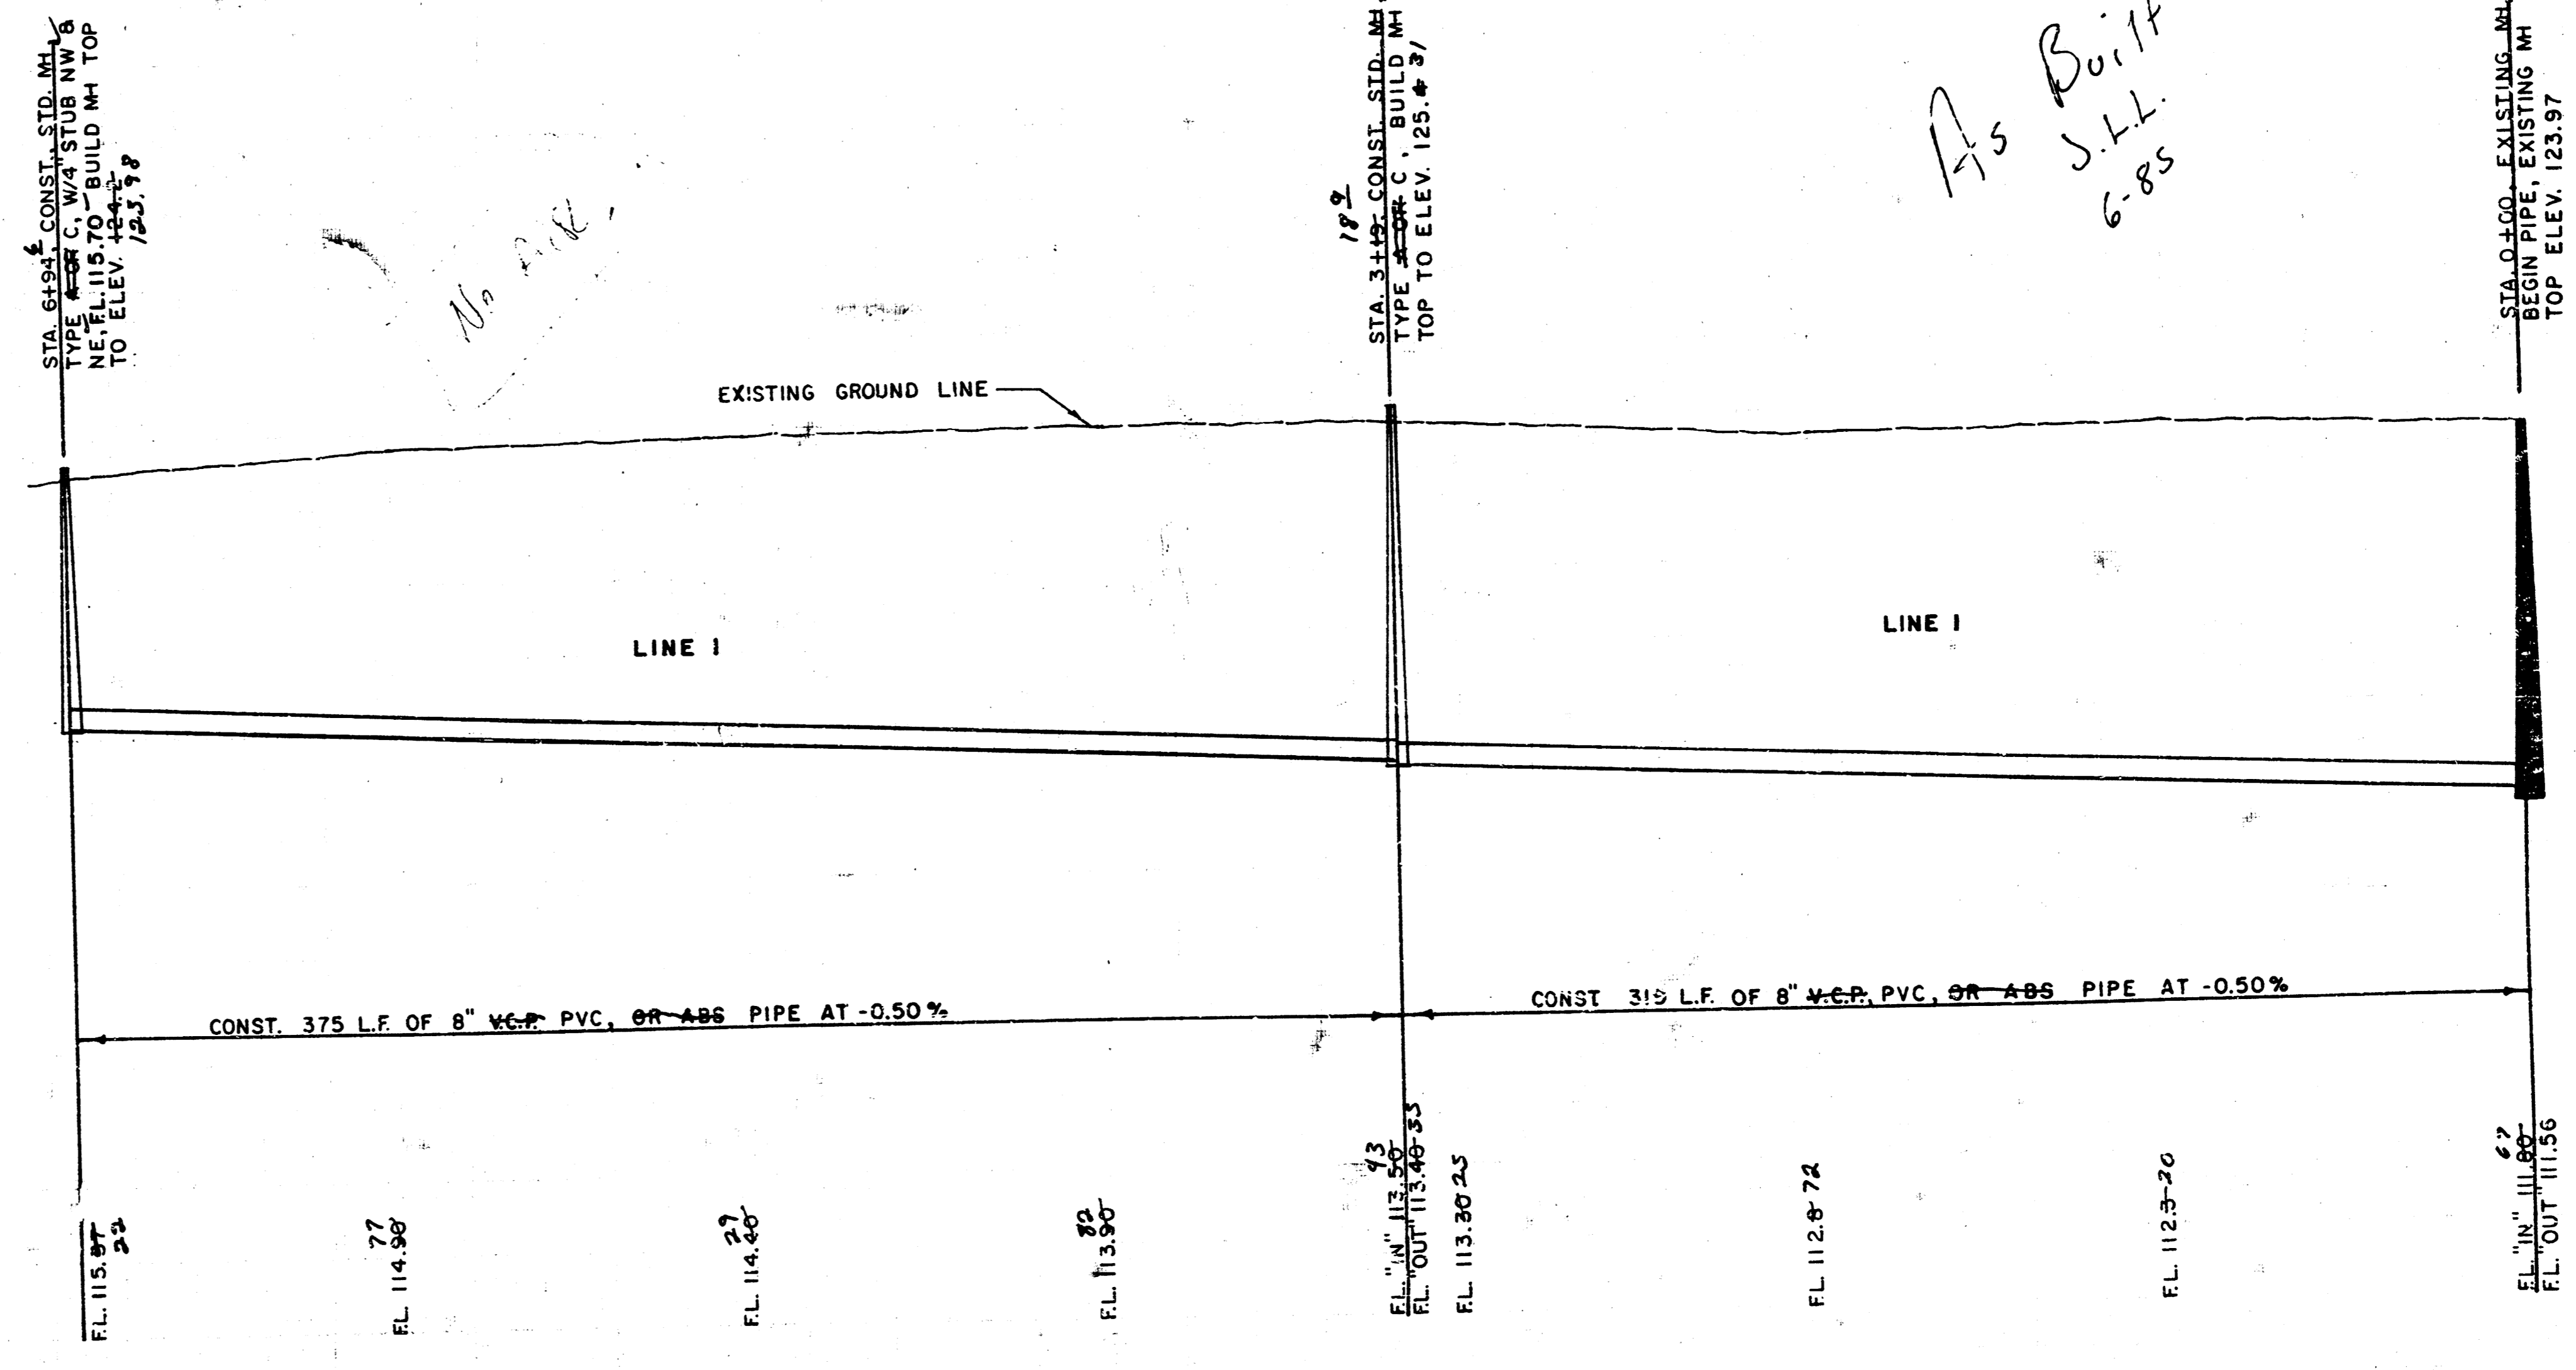


B.M. - WEST RIM OF M<sub>1</sub>, STA. 0+00, LINE 1,  
ELEV. 123.97

130  
125  
120  
115  
110

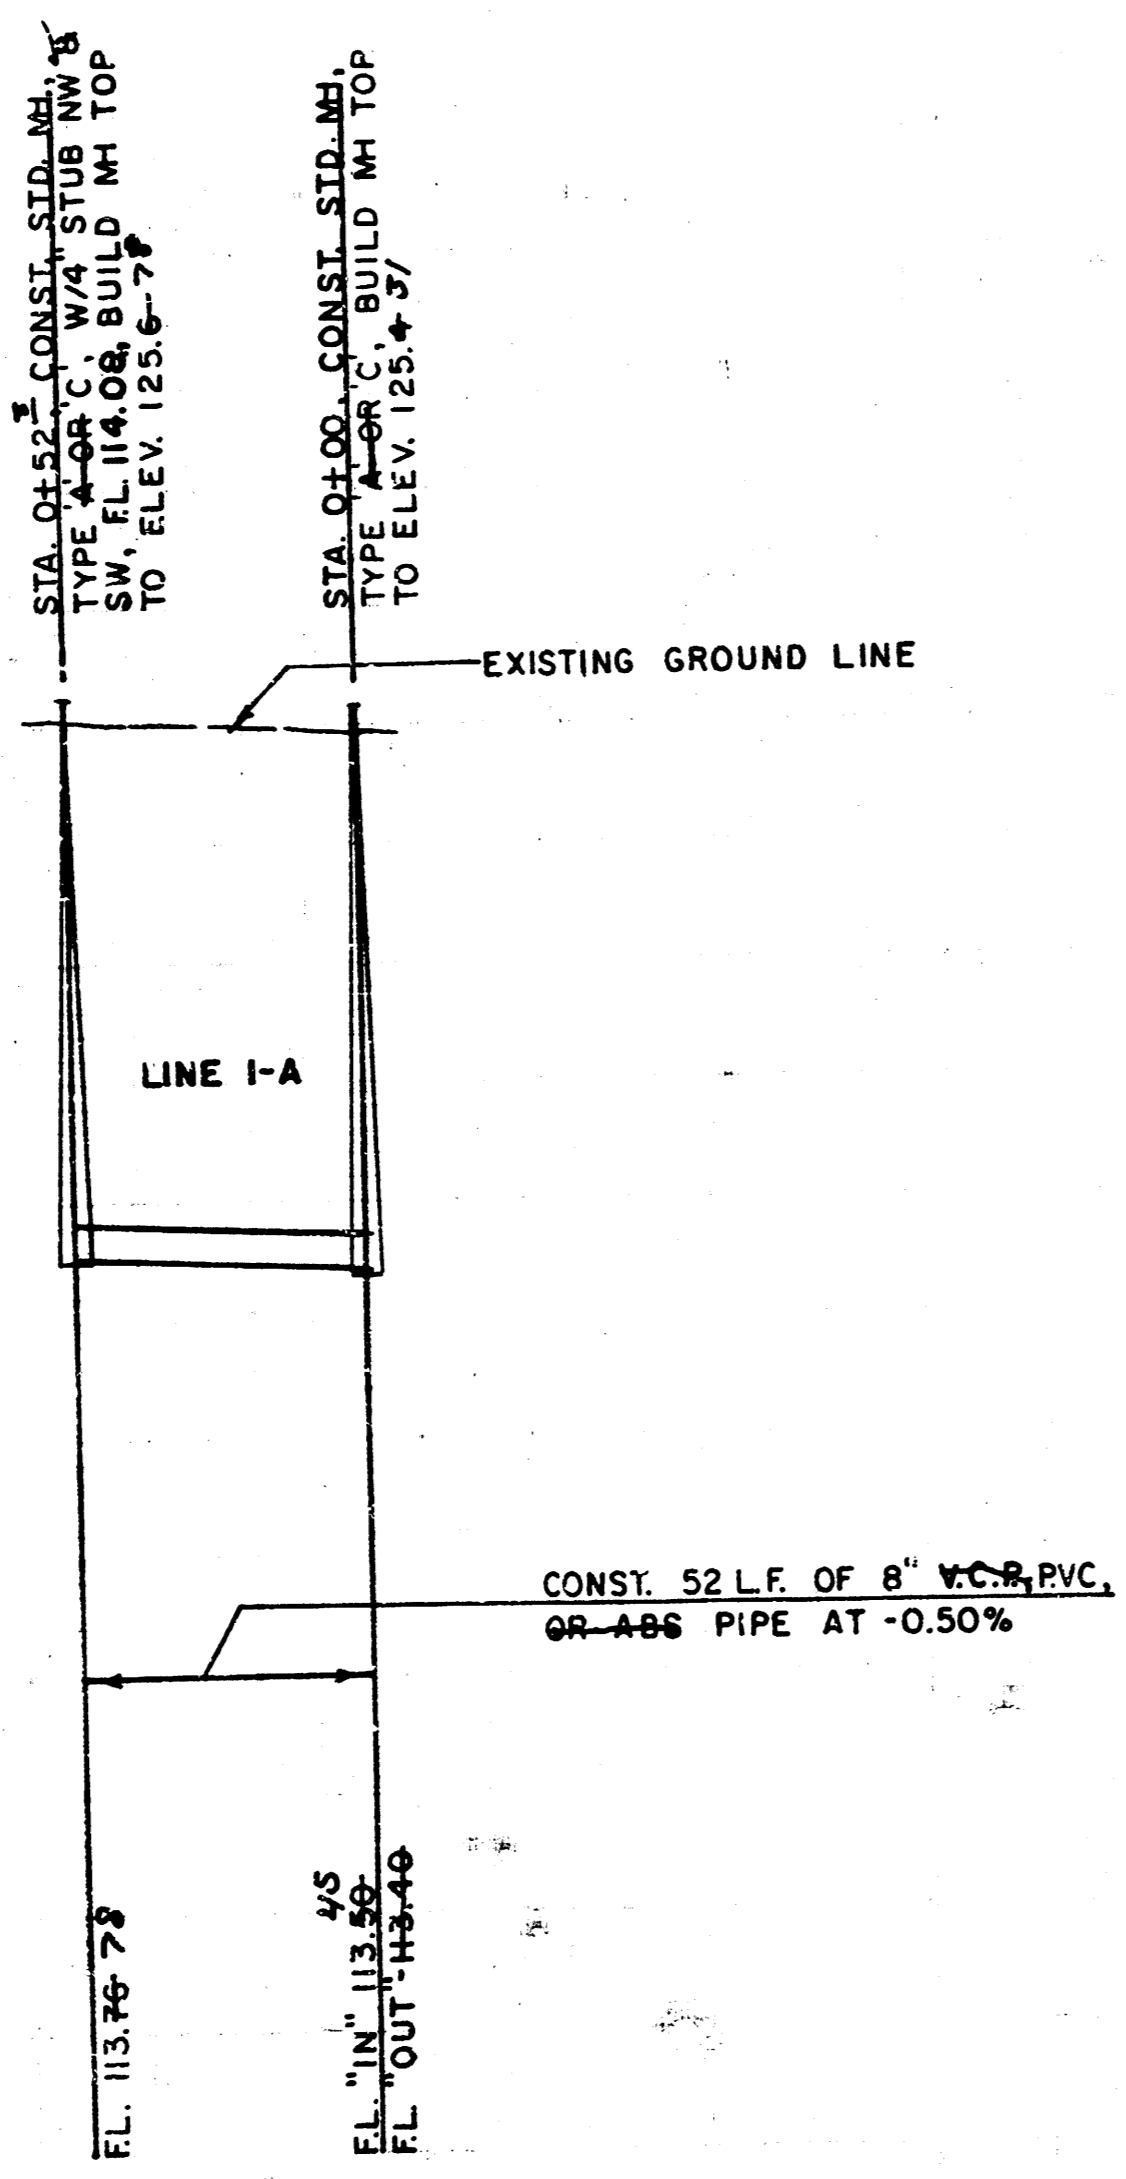


No. 111

As Built  
J.L.L.  
6-85

2/3 (2/3)



LAT 190, SHI

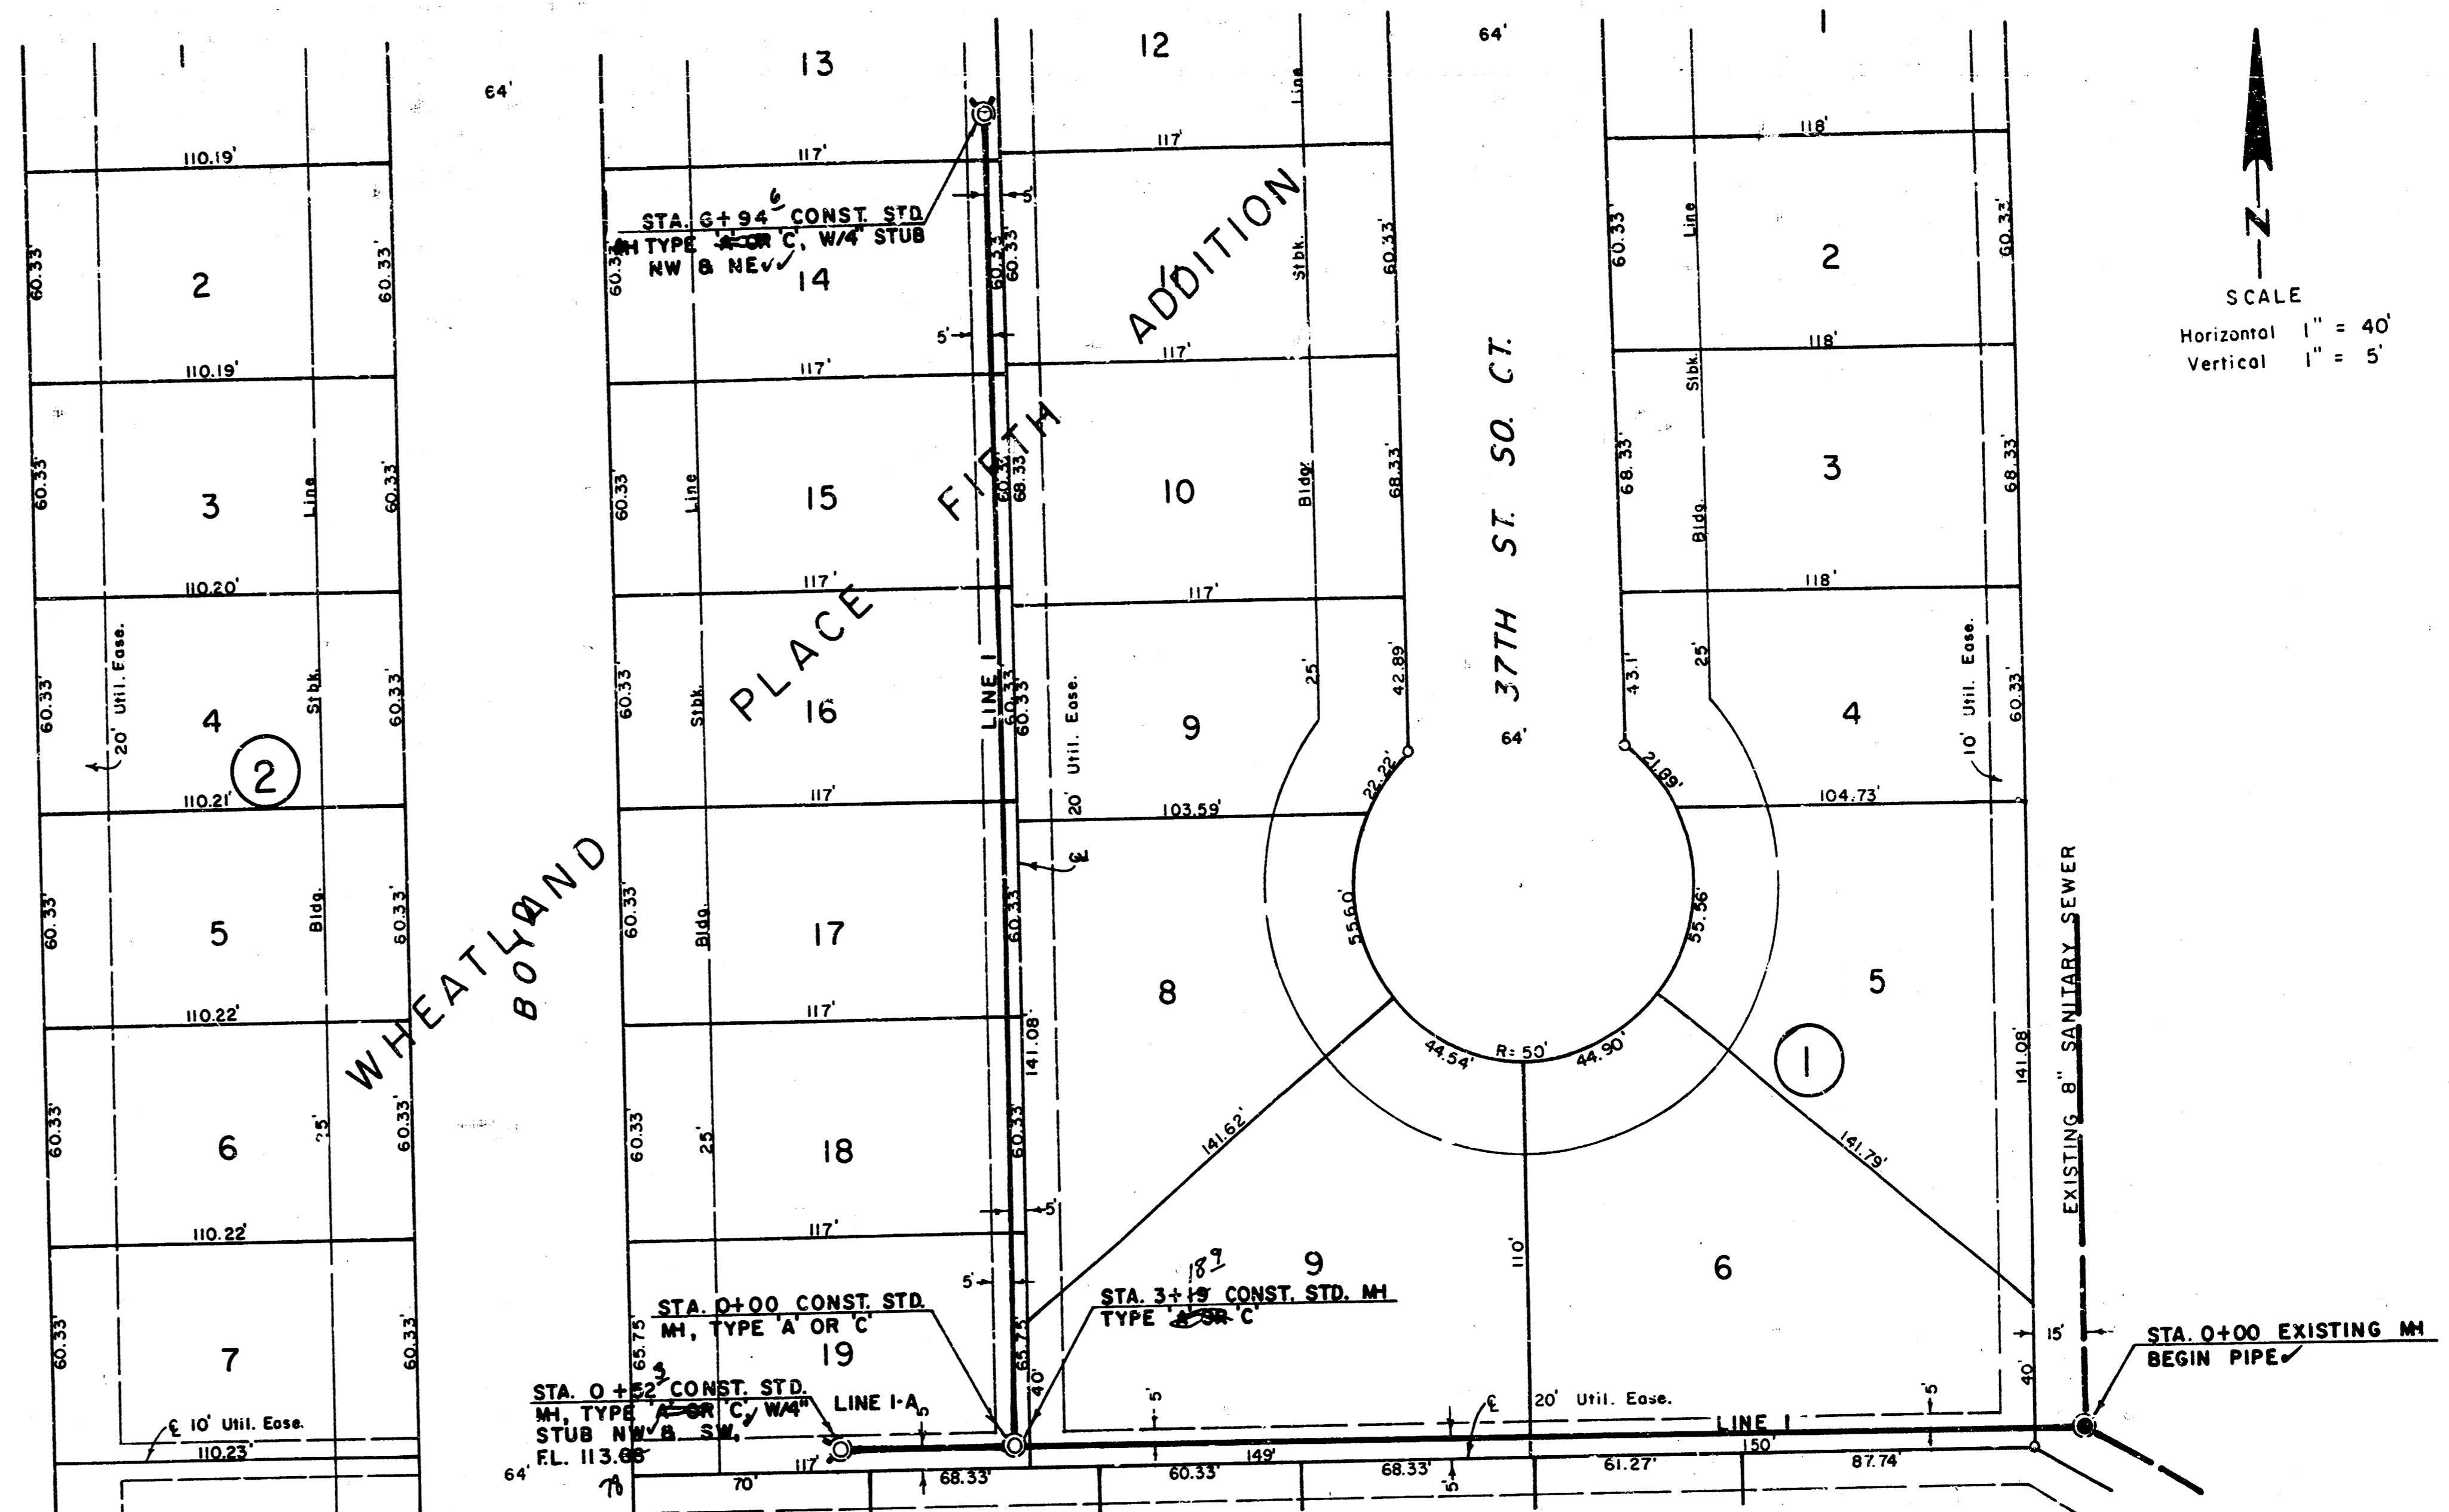

SCALE  
Horizontal 1" = 40'  
Vertical 1" = 5'

FILMED FROM THE BEST AVAILABLE COPY

SCALE  
 Horizontal 1" = 40'  
 Vertical 1" = 5'

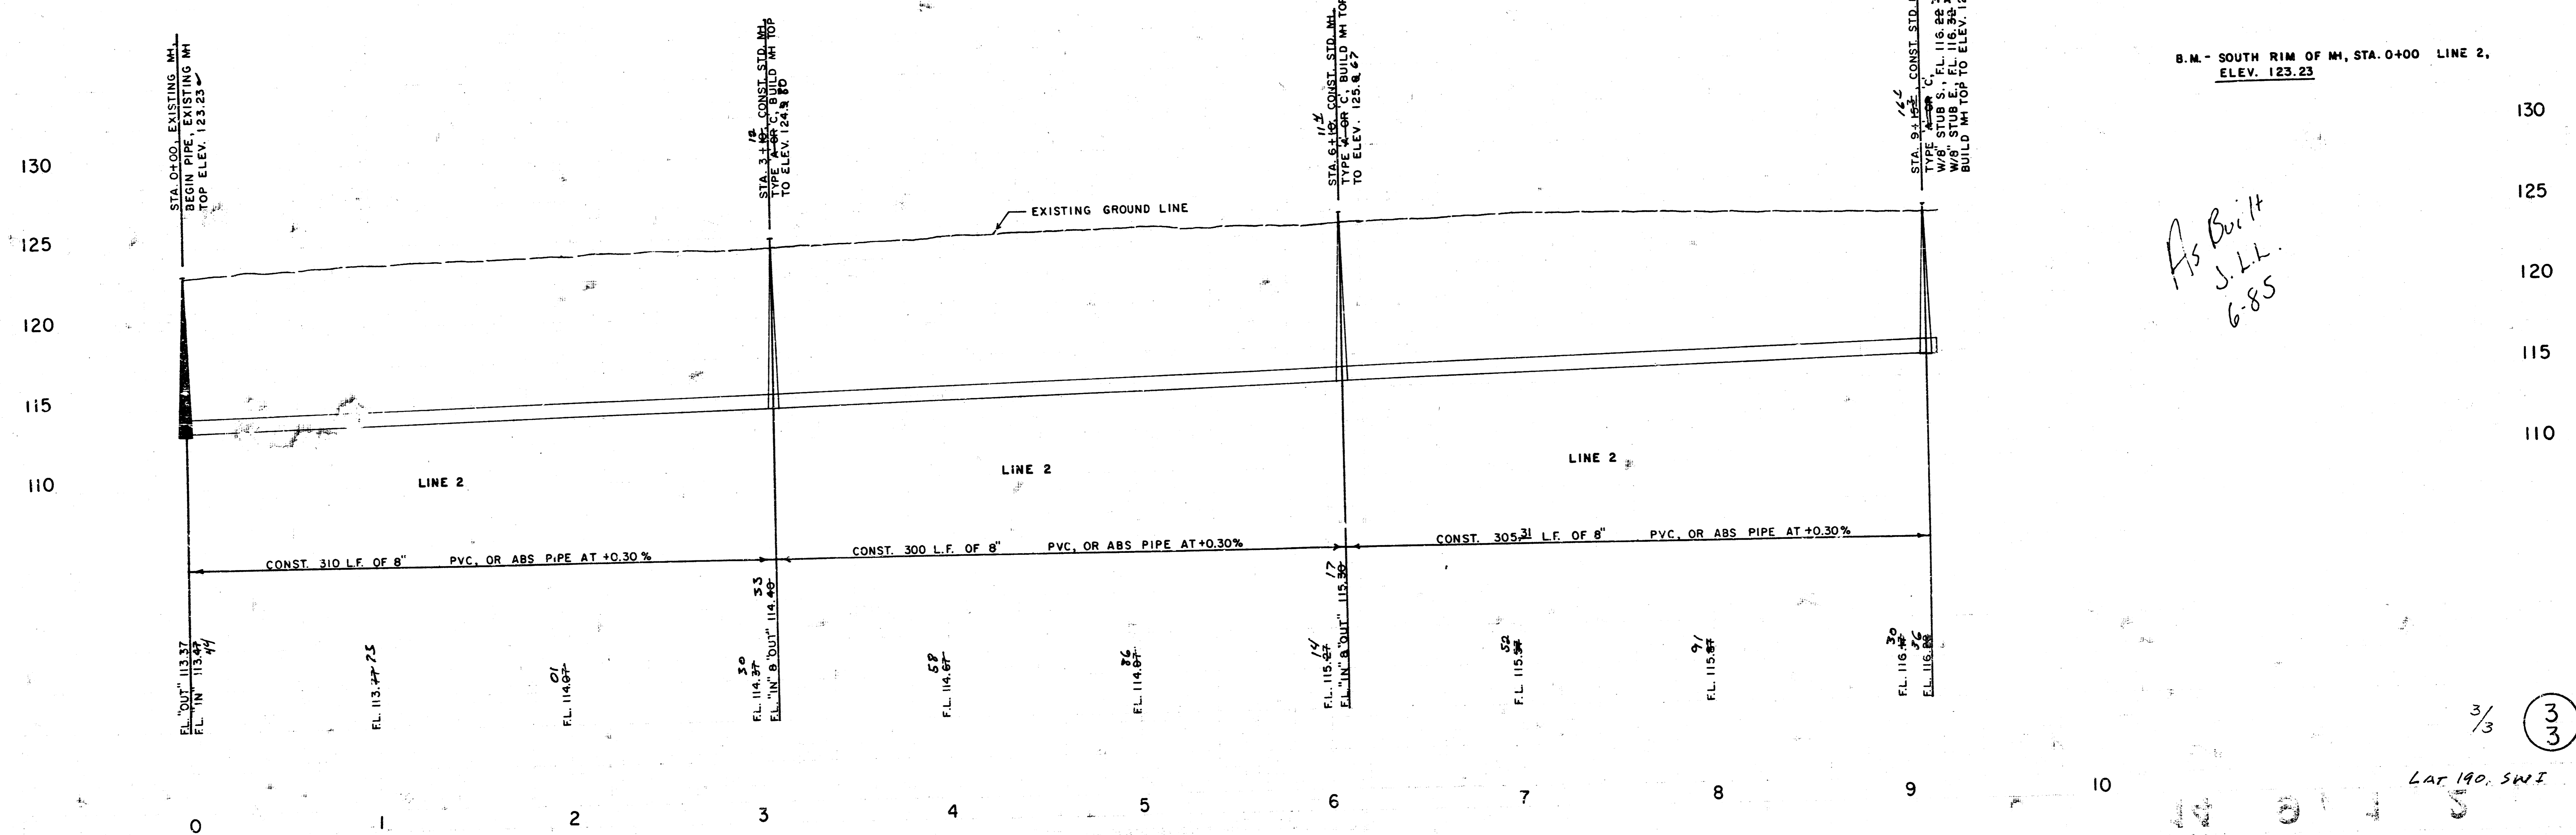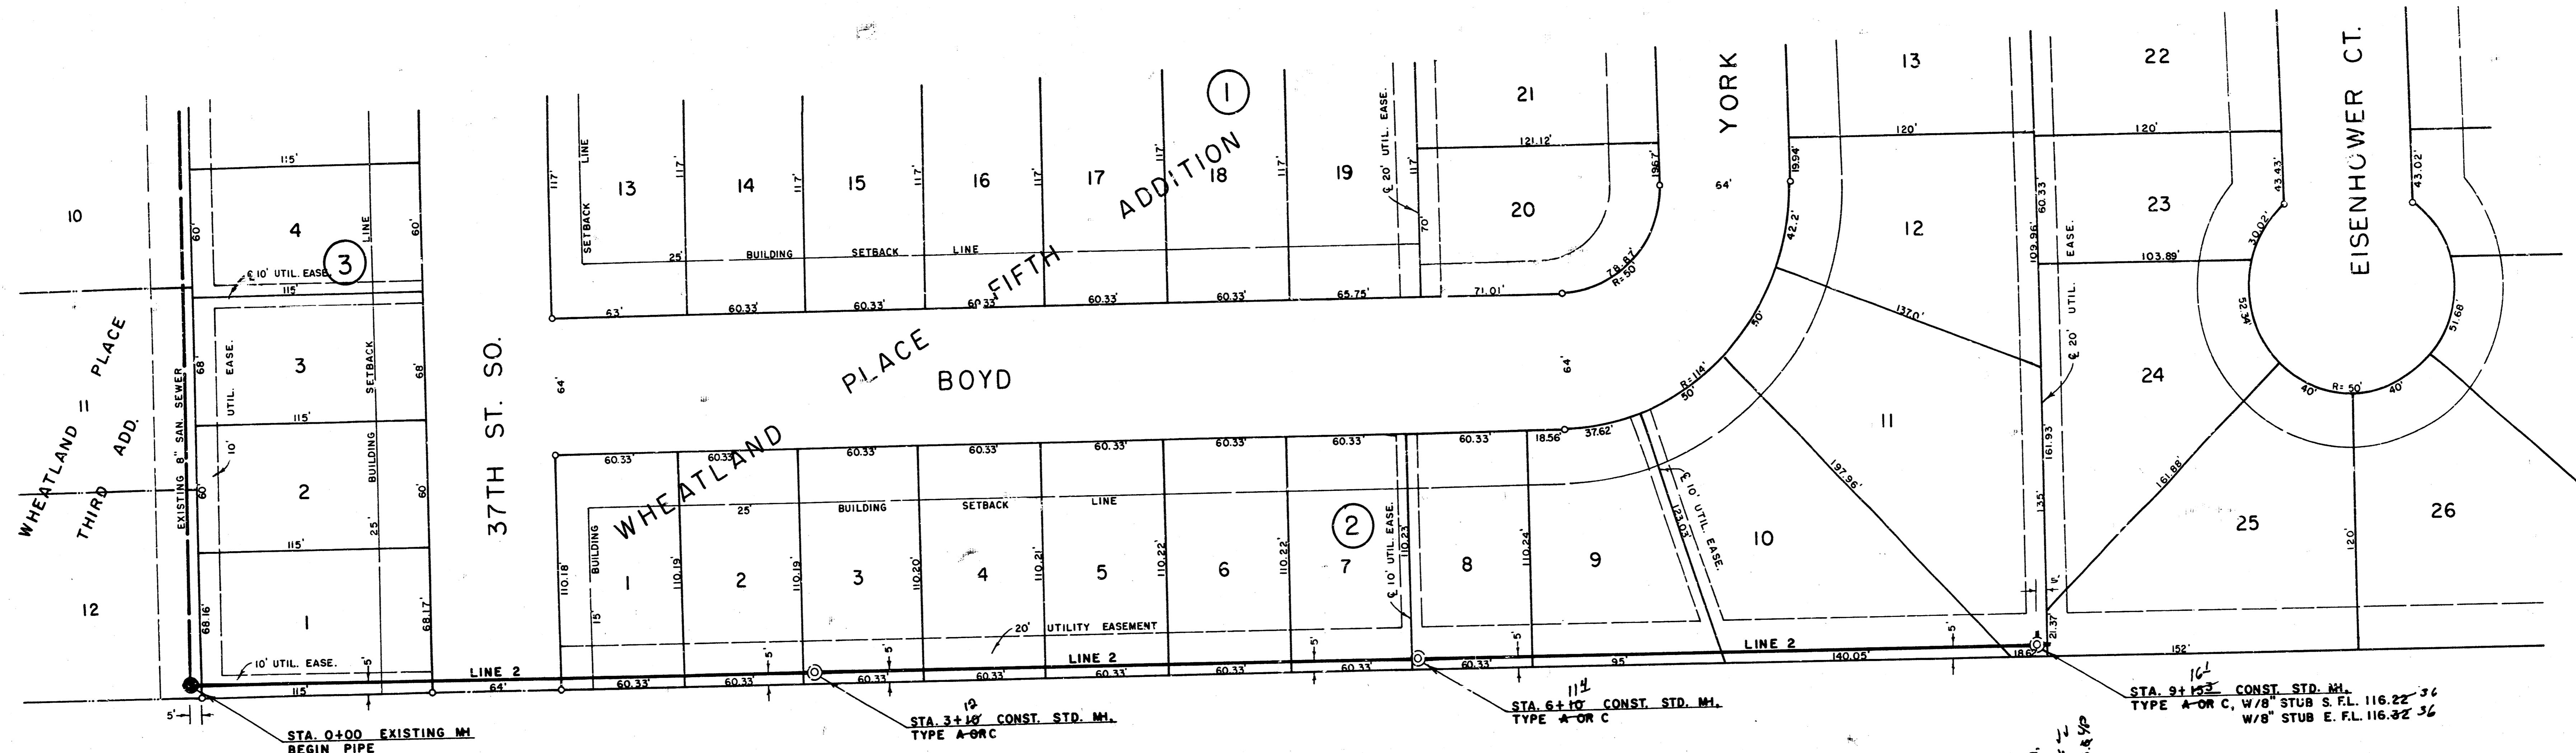

FILMED FROM THE BEST  
 AVAILABLE COPY.....