


CONSTRUCTION PLANS FOR
LATERAL 197
OF THE
SOUTHWEST INTERCEPTOR SEWER
THE CITY OF WICHITA,
SEDGWICK COUNTY, KANSAS
MICHAEL E. LINDEBAK, P.E. CITY ENGINEER

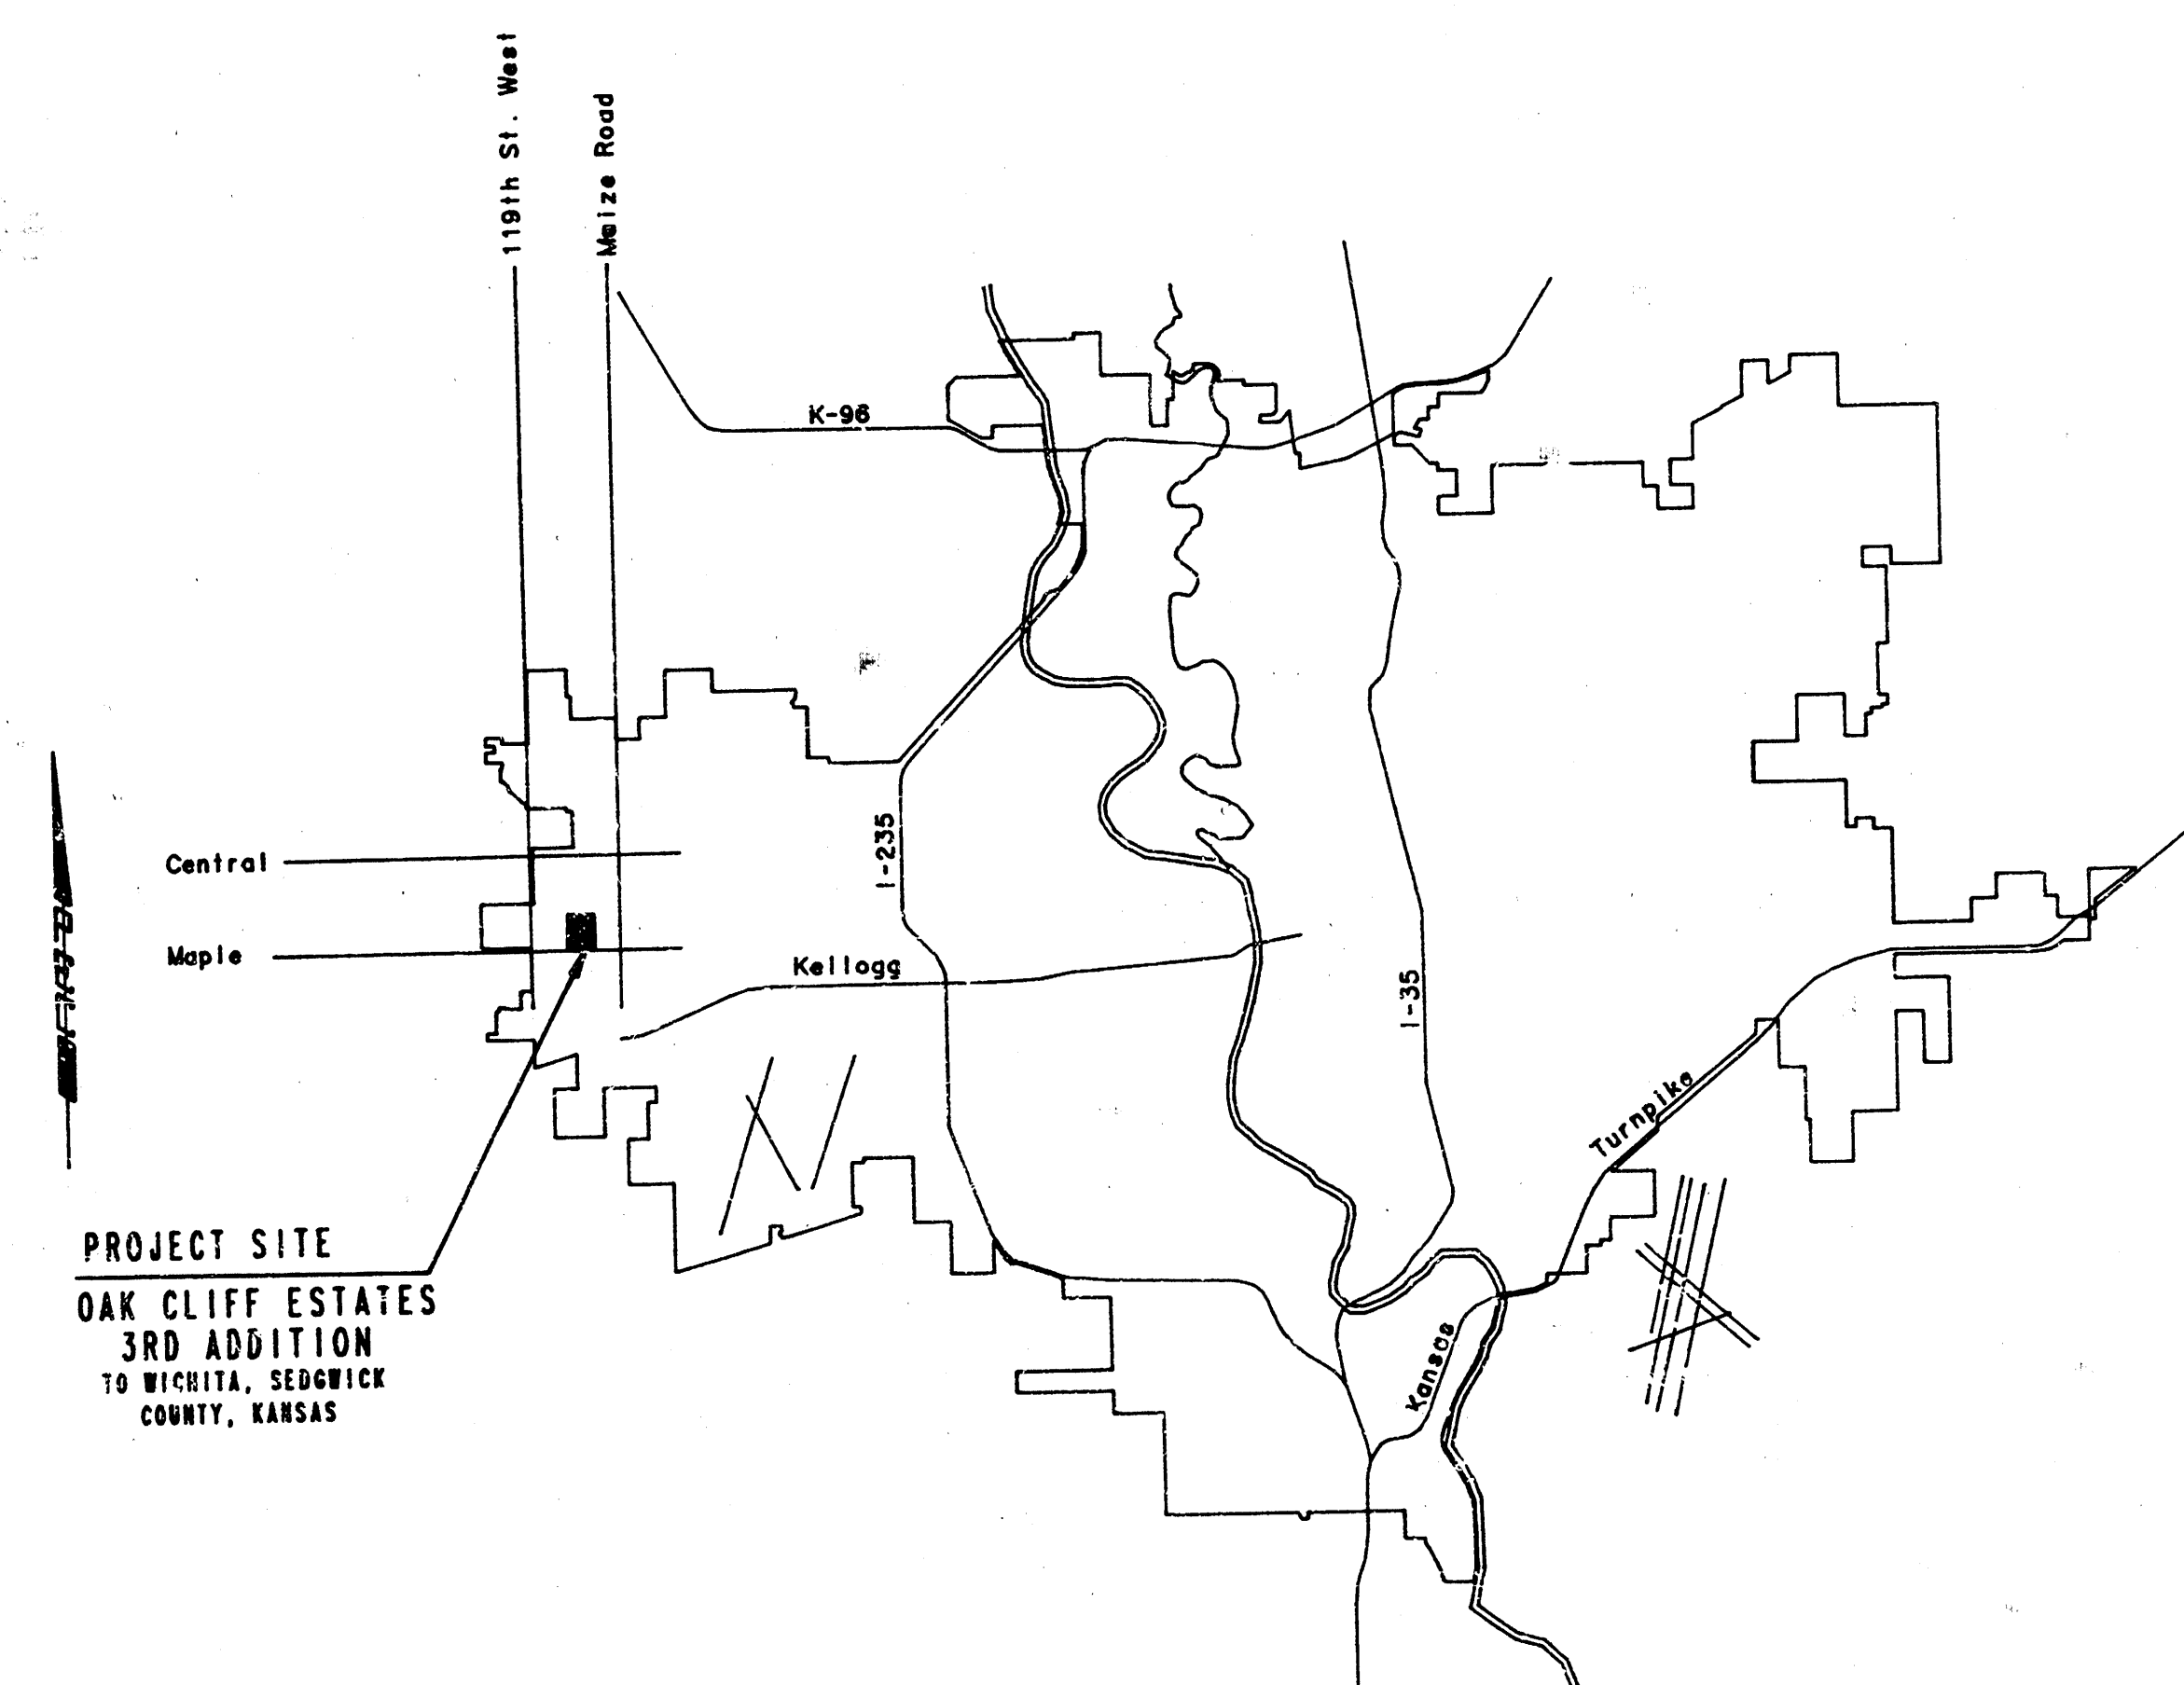

115 Built
S.L.
7-85



LOCATION MAP

CITY OF WICHITA PROJECT NO. 468-76-245-81416-000-000-001

MARCH, 1985

PLANS PREPARED BY
PROFESSIONAL ENGINEERING CONSULTANTS, P.A.,
ENGINEERS
WICHITA, KANSAS



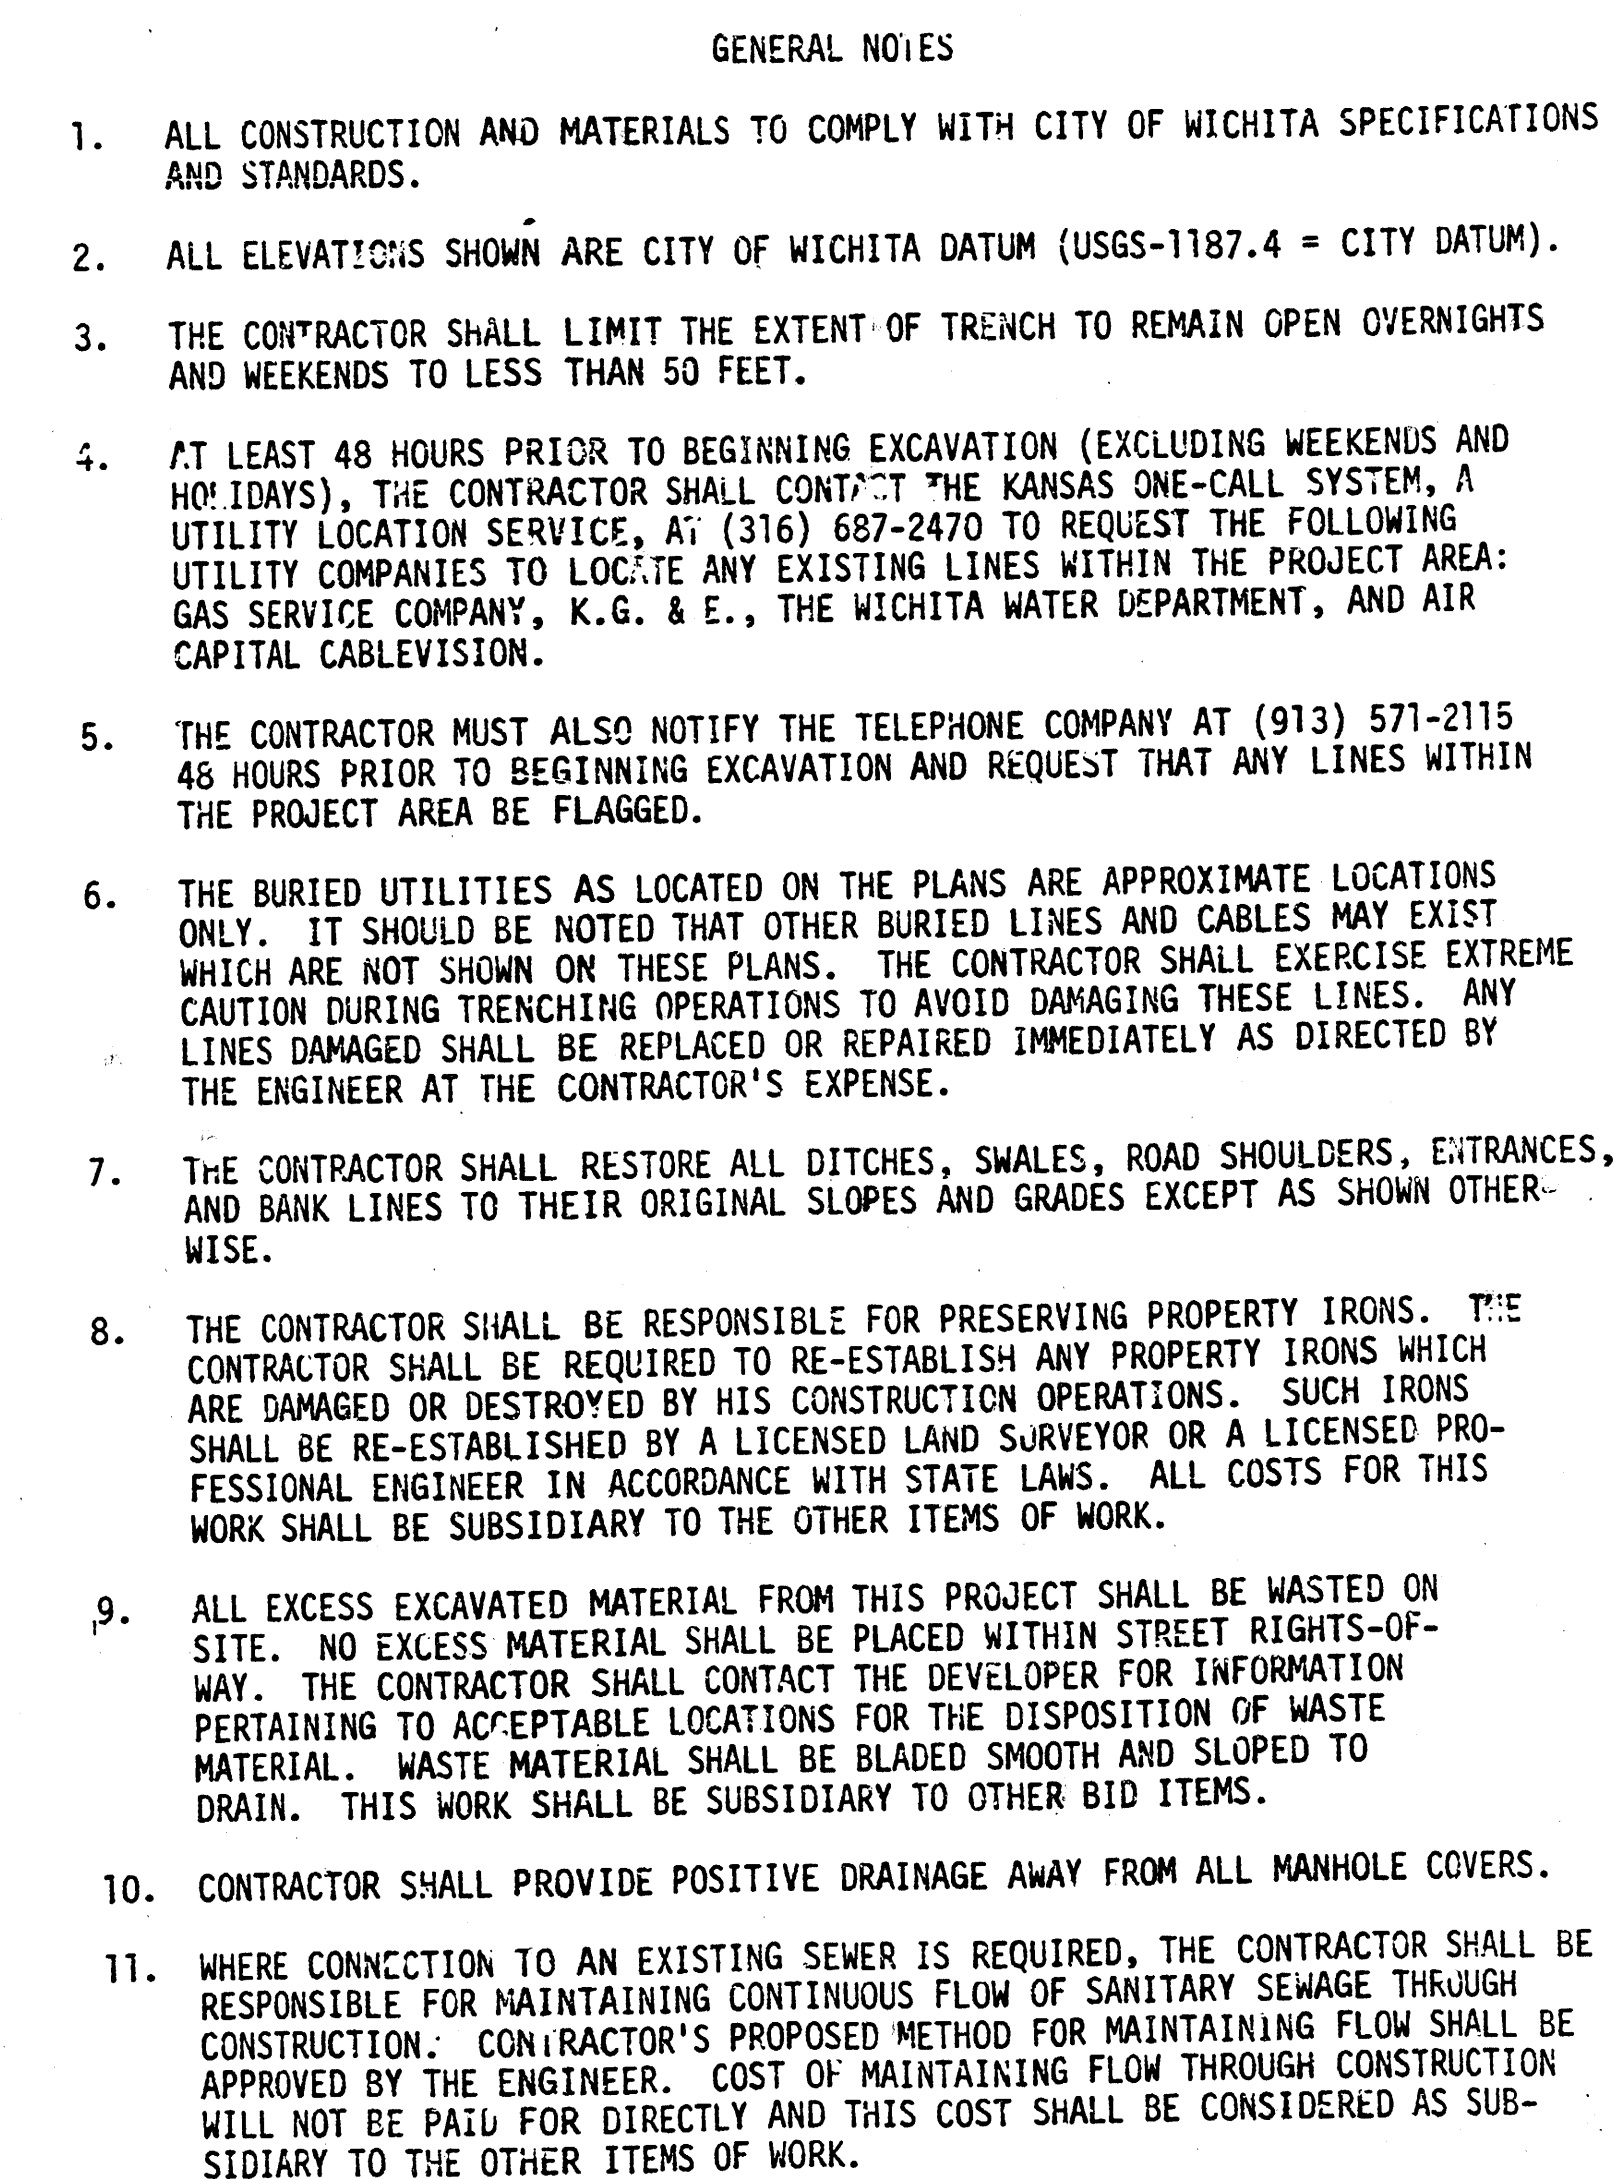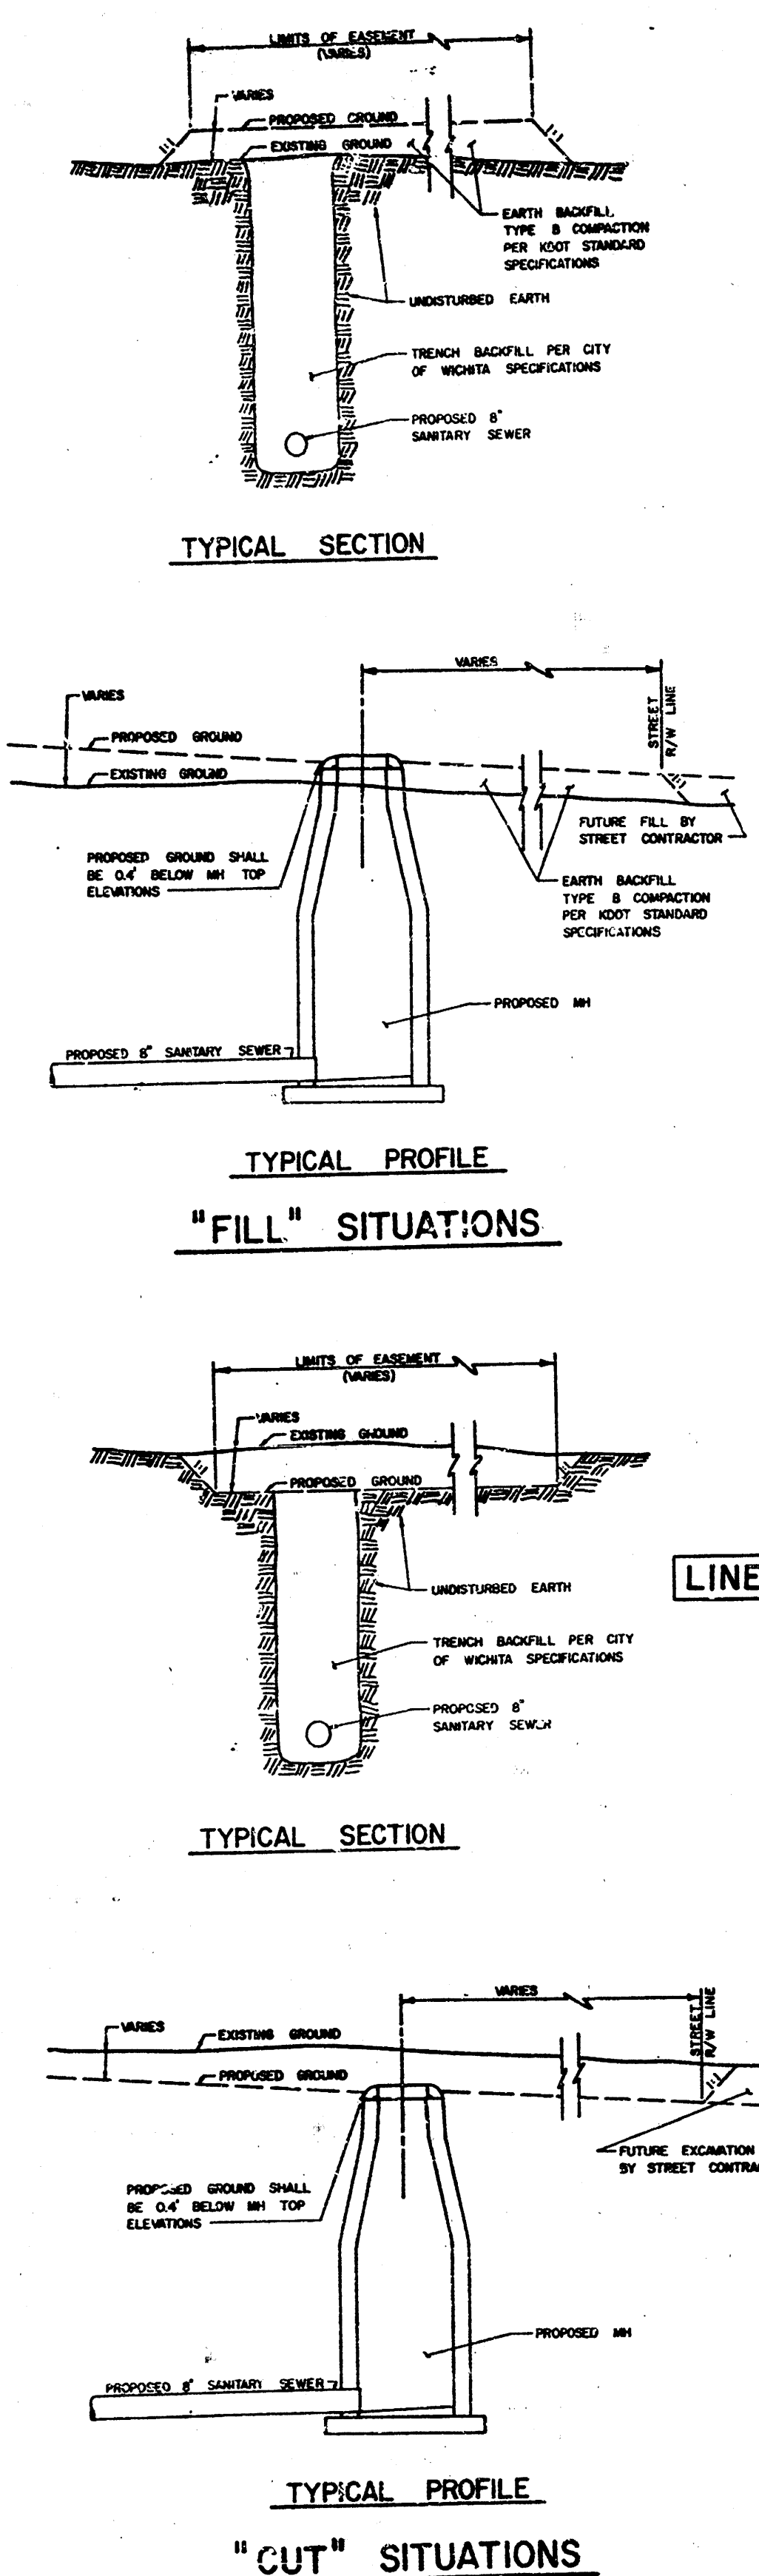

CONTRACTOR SHALL GRADE ALONG THE SANITARY SEWER ALIGNMENT TO THE ELEVATIONS SHOWN ABOVE. THE CONTRACTOR SHOULD VISIT THE SITE TO DETERMINE THE EXTENT OF GRADING PRIOR TO PREPARATION OF HIS BID. ALL COSTS FOR GRADING SHALL BE SUBSIDIARY TO THE PROJECT.

 Area to be Graded
● = Iron Found
○ = Iron to be Set

Bench Mark - Maize Road and Maple.
City of Wichita bench mark
disc, 43.5' south and 52.7'
east of C's both.
El. = 133.20 City Datum
1320.60 M.S.L.


MINIMUM PAD ELEVATIONS:
Minimum Pad Elevation for
Lots 1 through 11, Block
9, shall be 1324.0 M.S.L.
and for Lots 1 through 26,
Block 1, shall be 1333.0
M.S.L.

Scale: 1" = 100'

October 18, 1934

LINE SCHEDULE	
Line No.	Sheet No.
1	3
2	4
3	4

Scale: 1" = 100'

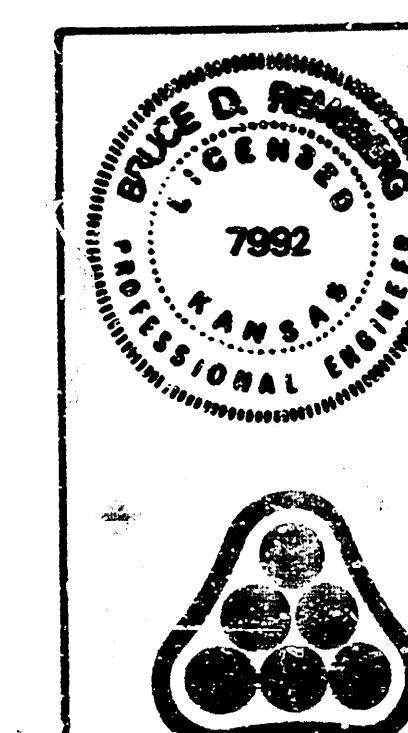

No.	Revision	By	Date

**LATERAL 197 OF THE
SOUTHWEST INTERCEPTOR SEWER**

KEY MAP

 MICHAEL E. LINDEBAK, P.E. CITY ENGINEER
 CITY OF WICHITA PROJECT NO. 468-76-245-81416-000-000-000
PROFESSIONAL ENGINEERING CONSULTANTS, P.A.
 ENGINEERS
 WICHITA, KANSAS

2 / 4

Designed by BDR, RFJ	Job No. 34-85039-2	Sht. 2 of 4
Designed by SM RFJ	Date March 1986	

FILMED FROM THE BEST
AVAILABLE COPY.....

PROFILE SURVEILLO PLOTTED GRADES CHECKED NOTE BOOK	BY		DATE
	[Signature] [Signature]		[Date] [Date]

