


- Notify the following companies prior to any excavation:
- |                       |                |
|-----------------------|----------------|
| Arkio Gas Company     | 942-8350       |
| Bell Telephone        | 268-2256       |
| Cablevision           | 269-3340       |
| Gas Service Company   | 263-7511       |
| Kansas Gas & Electric | 261-6375       |
| Kansas One-Call       | 1-800-341-7233 |

**GENERAL NOTES:**

1. Remove and replace asphalt and concrete pavement as necessary.
2. Remove and replace curb and gutter as necessary.
3. Remove and replace mail boxes.
4. Remove trees only if necessary and after approval by Engineer.
5. Properties within the project limits which have fencing in public right-of-way which conflict with new construction have been notified to remove such improvements. Contractor will be required to remove such improvements should they not be removed by their owner at the time of construction of the project. The Contractor will be required to salvage all fencing and give such material to their owner. All work in connection with fence removal shall be considered as subsidiary to the contract pay items of work.

*AS BUILT  
1-87*

Revised 11/14/86

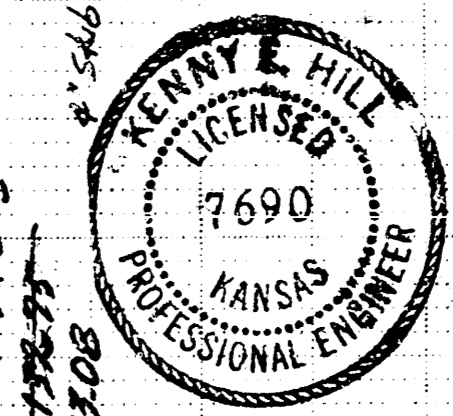

<b>dp</b>	CITY OF WICHITA LATERAL 223 SOUTHWEST INTERCEPTOR SEWER	
	PROJECT NO. 468-76-245-81585-000-000-001	
ENGINEER: K. HILL	LANGTECH B.F.	
DRAWN BY: P.V.	SCALE: As Noted	
DATE: Sept. 1986	SHEET: 1 OF 1	

**FILMED FROM THE BEST AVAILABLE COPY**