

PLAN VIEW

SEWAGE LINE

LOT OWNERS: CHRISTIAN, LOUIS, ADD'N., THOMAS D. CARLISLE, JAMES F. STEWART, CARROLL RAY COOKE, S. R. LUNDERMAN, G. R. GILBERT, JR., H. P. LOOF & B. L. LOOF, HAROLD C. PATTERSON, LEO D. ZIMMERMAN, MARVIN M. MAHER, CLOSTRINE ANDERSON, STEVE LEVINE, KENNETH WOYMAN, MILDRED L. O'KEEFE.

STATIONING: 0+00, 1+00, 2+00, 3+00, 4+00, 5+00, 6+00, 7+00, 8+00, 9+00, 10+00.

MANHOLES: 1, 2, 3, 4, 5, 6, 7, 8, 9, 10, 11, 12, 13, 14, 15, 16, 17, 18.

PROPOSED SEWER LINE: 8" ABS COMPOSITE PIPE @ 0.20% GRADE.

EXISTING SEWER LINE: 8" CLAY PIPE @ 0.20% GRADE.

ENCASEMENT: 11.7 LF OF 8" CLAY PIPE W/ 1" OF REINFORCED CONCRETE ENCASEMENT @ 0.20% GRADE.

CONCRETE ENCASEMENT: 4.50 LF OF EXISTING 8" CLAY PIPE W/ 1" OF REINFORCED CONCRETE ENCASEMENT. EXISTING 11" @ 0.20% GRADE.

STATION 0+00: EXIST'G M.H. W/ 8" STUB WEST 45°.

STATION 0+36.7: CONST'G STD. TYPE 'A' OR 'C' M.H. AND CONCRETE ENCASEMENT OF 8" SEWER.

STATION 1+00: BEGIN 8" SAN SEWER W/ 8" REINFORCED CONCRETE ENCASEMENT.

STATION 3+00: CONST'G STD. M.H. TYPE 'A' OR 'C'.

STATION 5+00: CONST'G STD. M.H. TYPE 'A' OR 'C'.

STATION 7+00: CONST'G STD. M.H. TYPE 'A' OR 'C'.

STATION 9+00: CONST'G STD. M.H. TYPE 'A' OR 'C'.

STATION 10+00: EXIST'G M.H. W/ 8" STUB WEST 45°.

PROFILES: 11.7 LF, 36.5 LF, 4.50 LF.


GRADES: 0.20%.

VEGETATION: 10' x 10'.

ADDITIONAL NOTES: 1. 11.7 LF OF 8" CLAY PIPE W/ 1" OF REINFORCED CONCRETE ENCASEMENT @ 0.20% GRADE. 2. 36.5 LF OF 8" ABS COMPOSITE PIPE @ 0.20% GRADE. 3. 4.50 LF OF EXISTING 8" CLAY PIPE W/ 1" OF REINFORCED CONCRETE ENCASEMENT. EXISTING 11" @ 0.20% GRADE.

[illegible]

PLAN SCALE 1"=40'
PROFILE SCALE 1"=40' HORIZ.
1"=4' VERT.

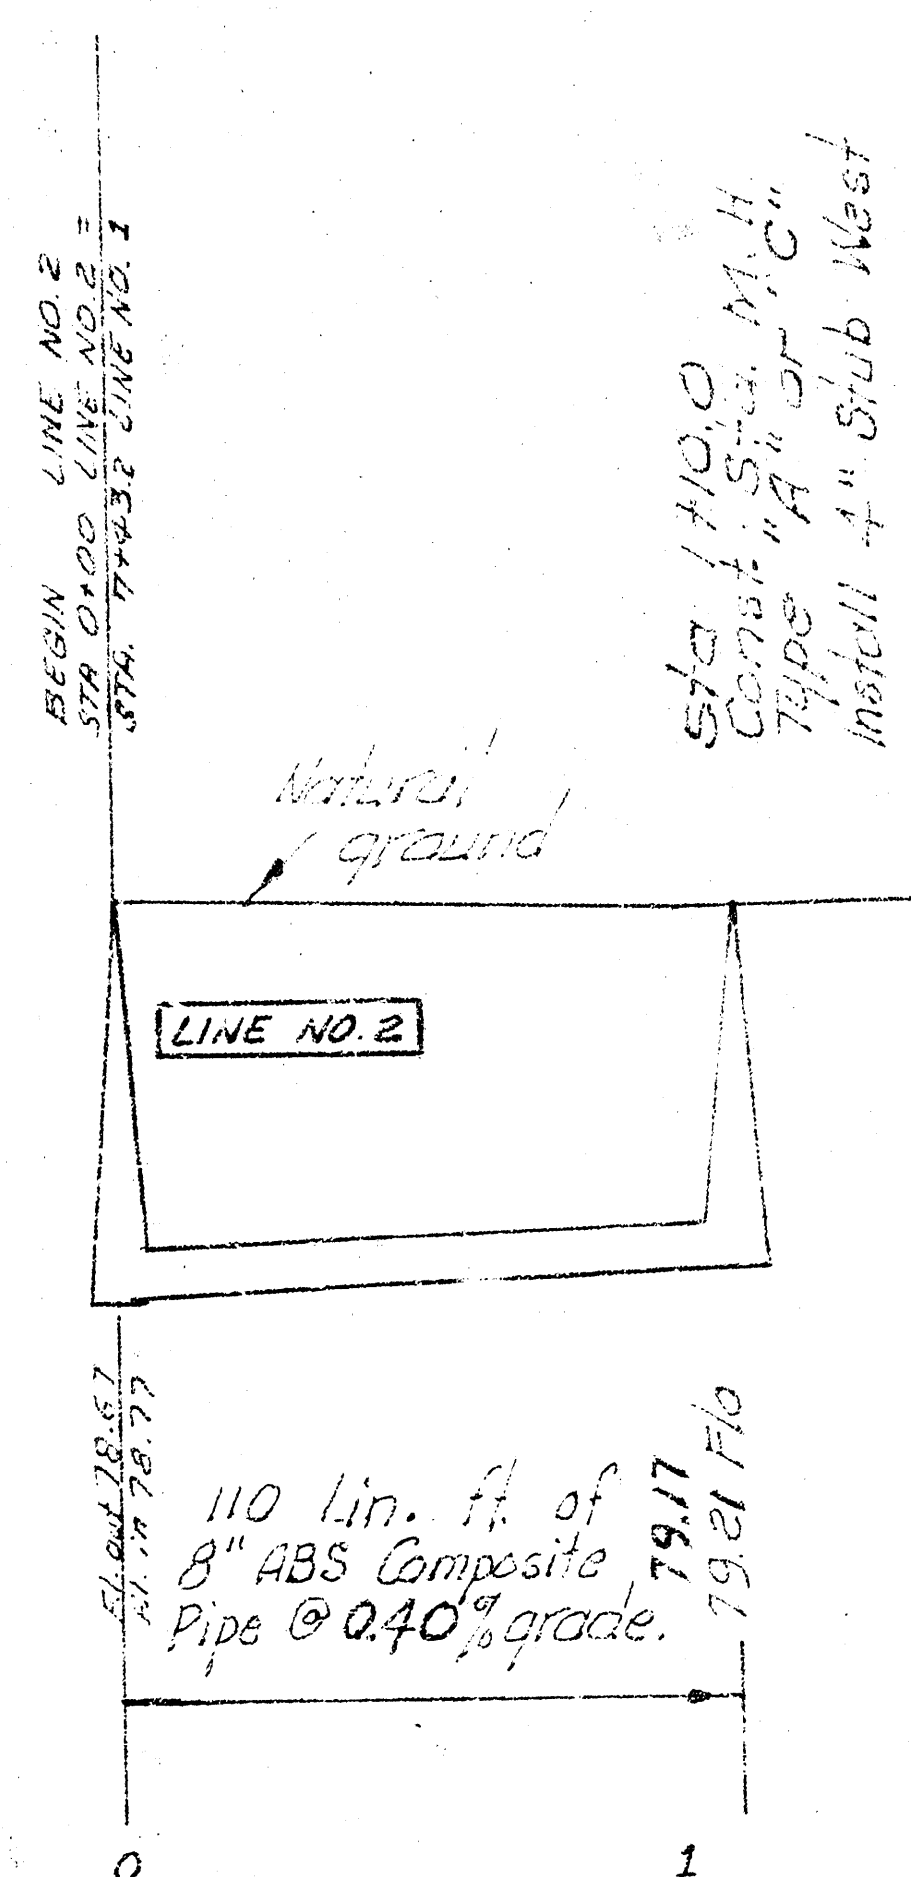

As Built 11-30-76

LAT. 18, SUB. I, S. W. INTER.
CITY OF WICHITA, KANSAS
R. W. LINN, CITY ENGINEER
DATE:
PROJ. NO. DBKL570041

B. M. 87.40 "+" N.W. Cor. Conc. Sign Base S.W. Mac Arthur & Hydraulic.

NOTE: FIELD ENGINEER TO TAKE TIES TO EXISTING IRONS & REPLACE AFTER CONSTRUCTION.

PLAN SCALE 1"=40' HOR.
PROFILE SCALE 1"=4' VERT.

LAT. 18, SUB. 1, S. W. INTER.
CITY OF WICHITA, KANSAS
R. W. LINN, CITY ENGINEER
DATE: 10/1/77
PROJ. NO. DBKL 70041