


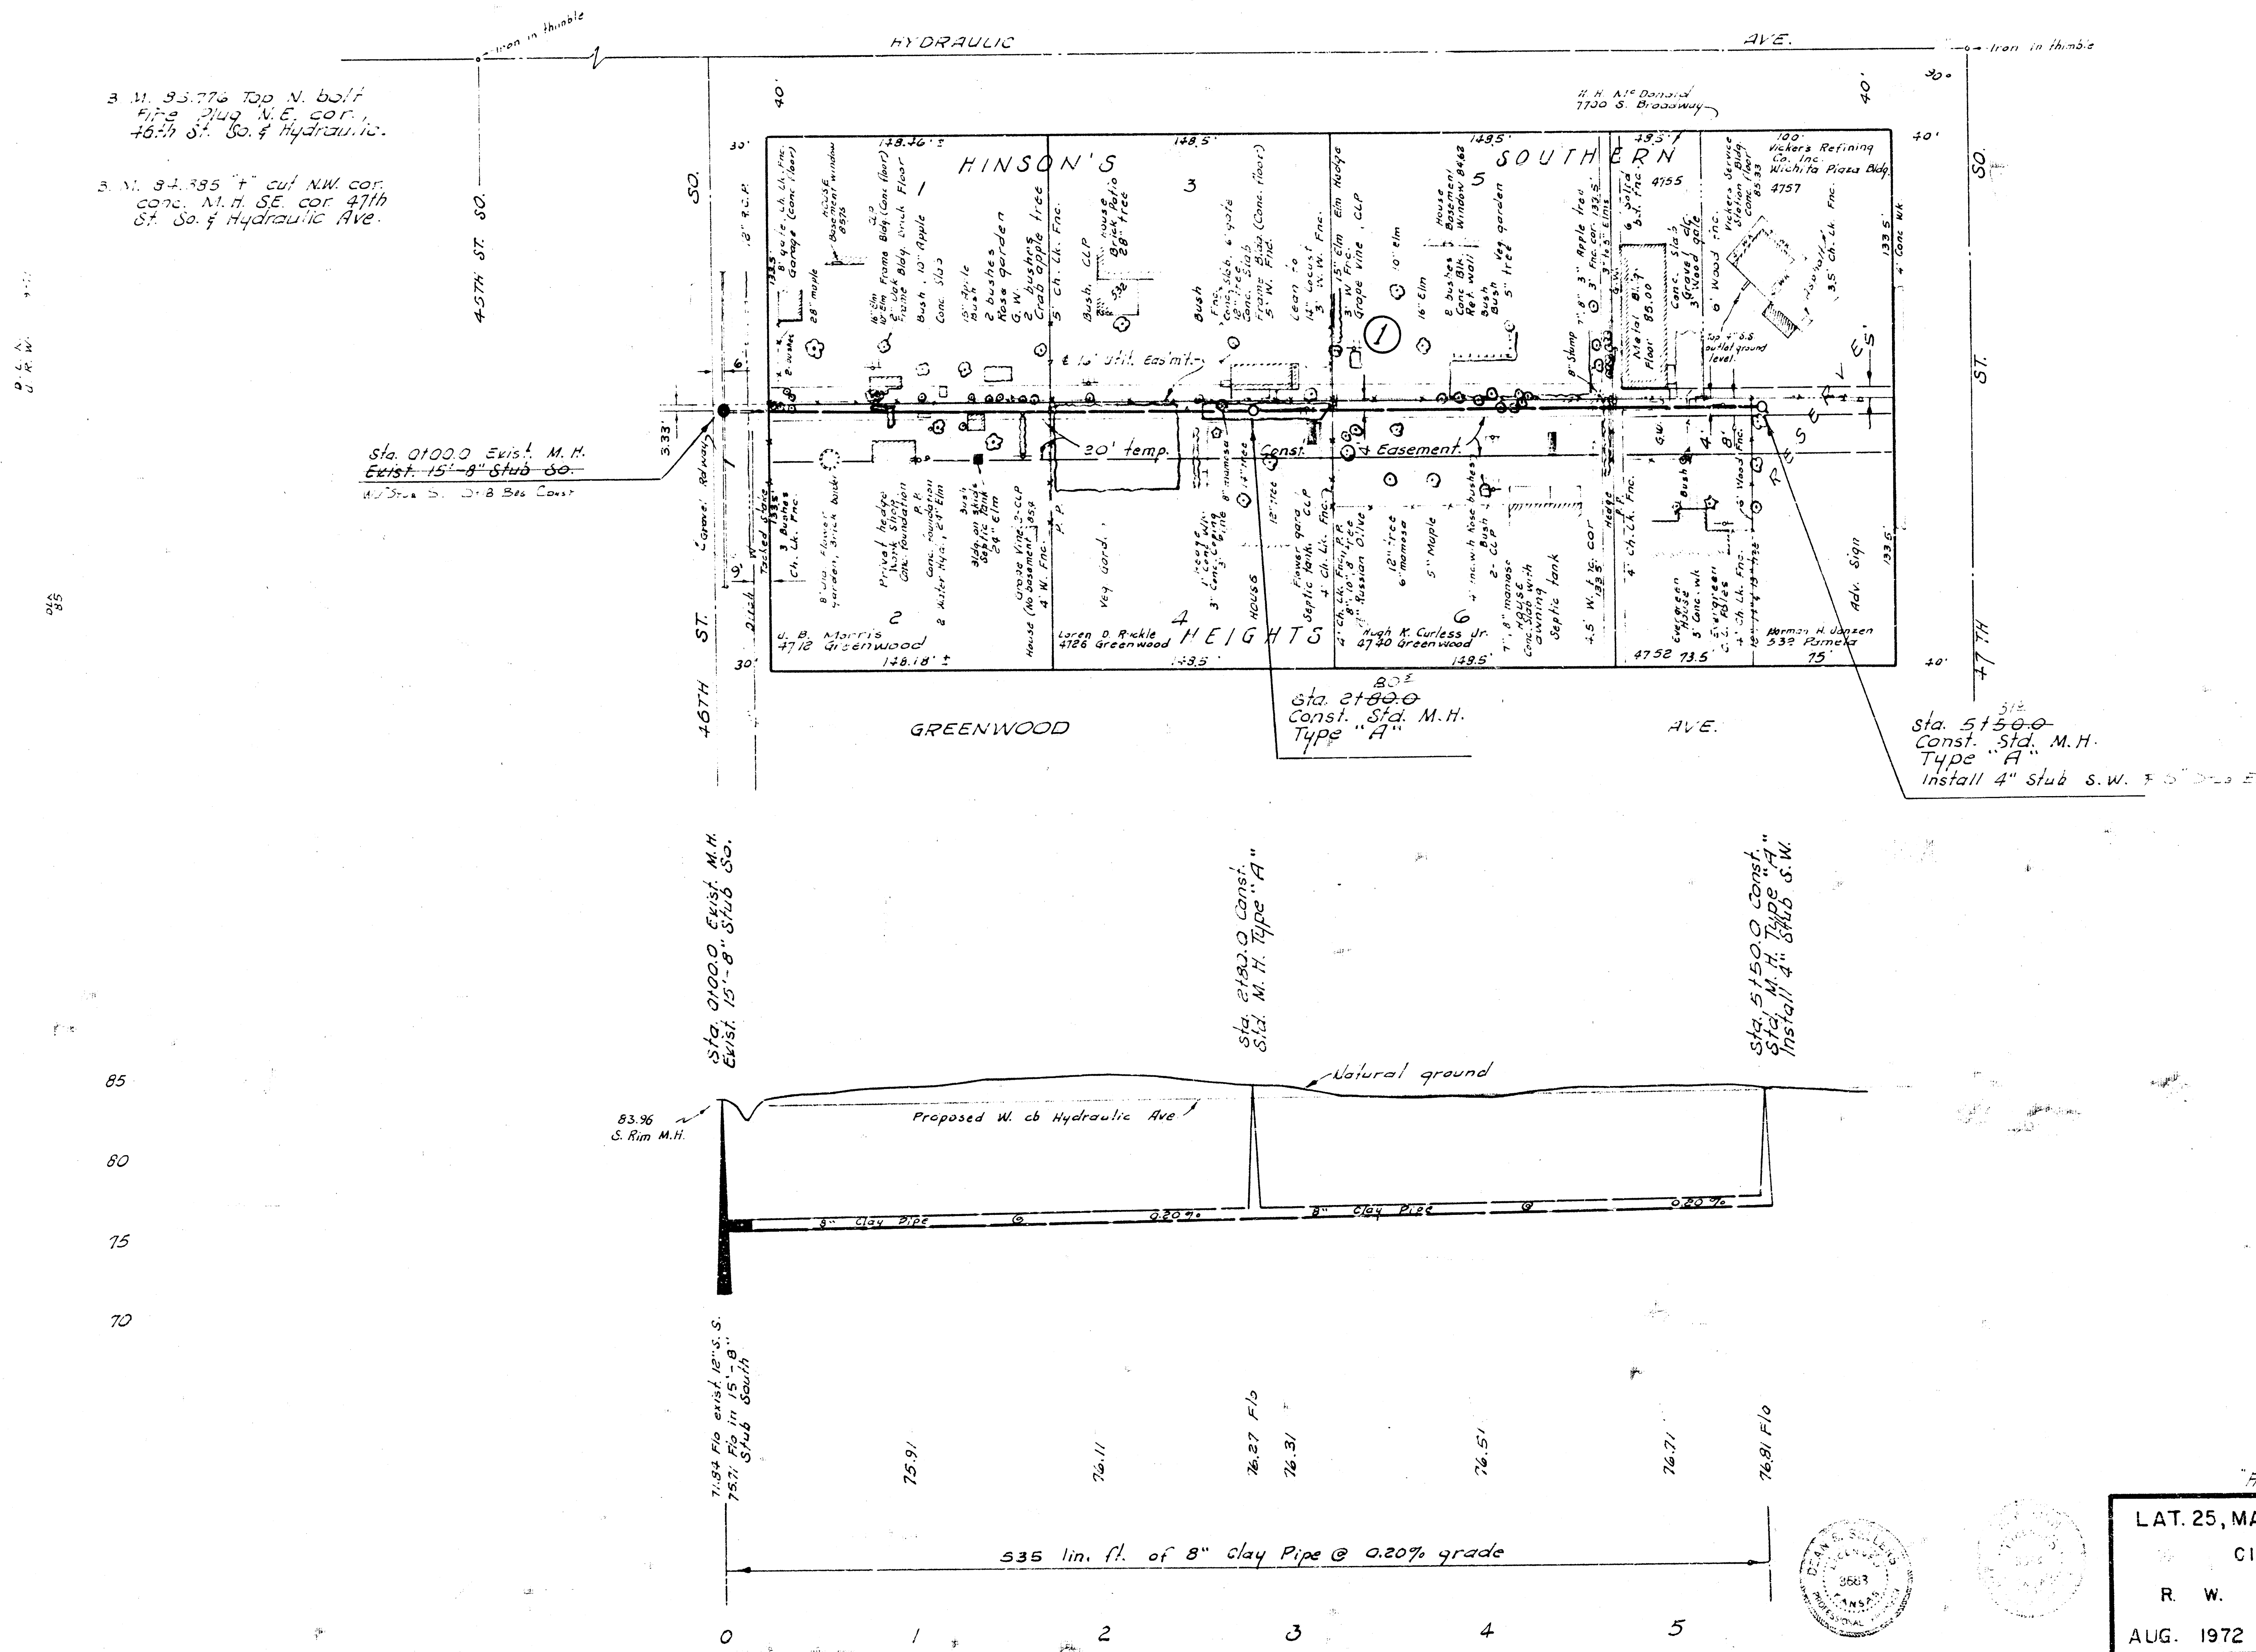

Plan Scale 1" = 40'
Profile Scale 1" = 10'

"As Built" Final Map Sheet 267-Y
LAT. 25, MAIN I, S. W. INTERCEPTOR SEWER
CITY OF WICHITA, KANSAS
R. W. LINN — CITY ENGINEER
AUG. 1972 PROJECT NO. DBKL 5 71008