

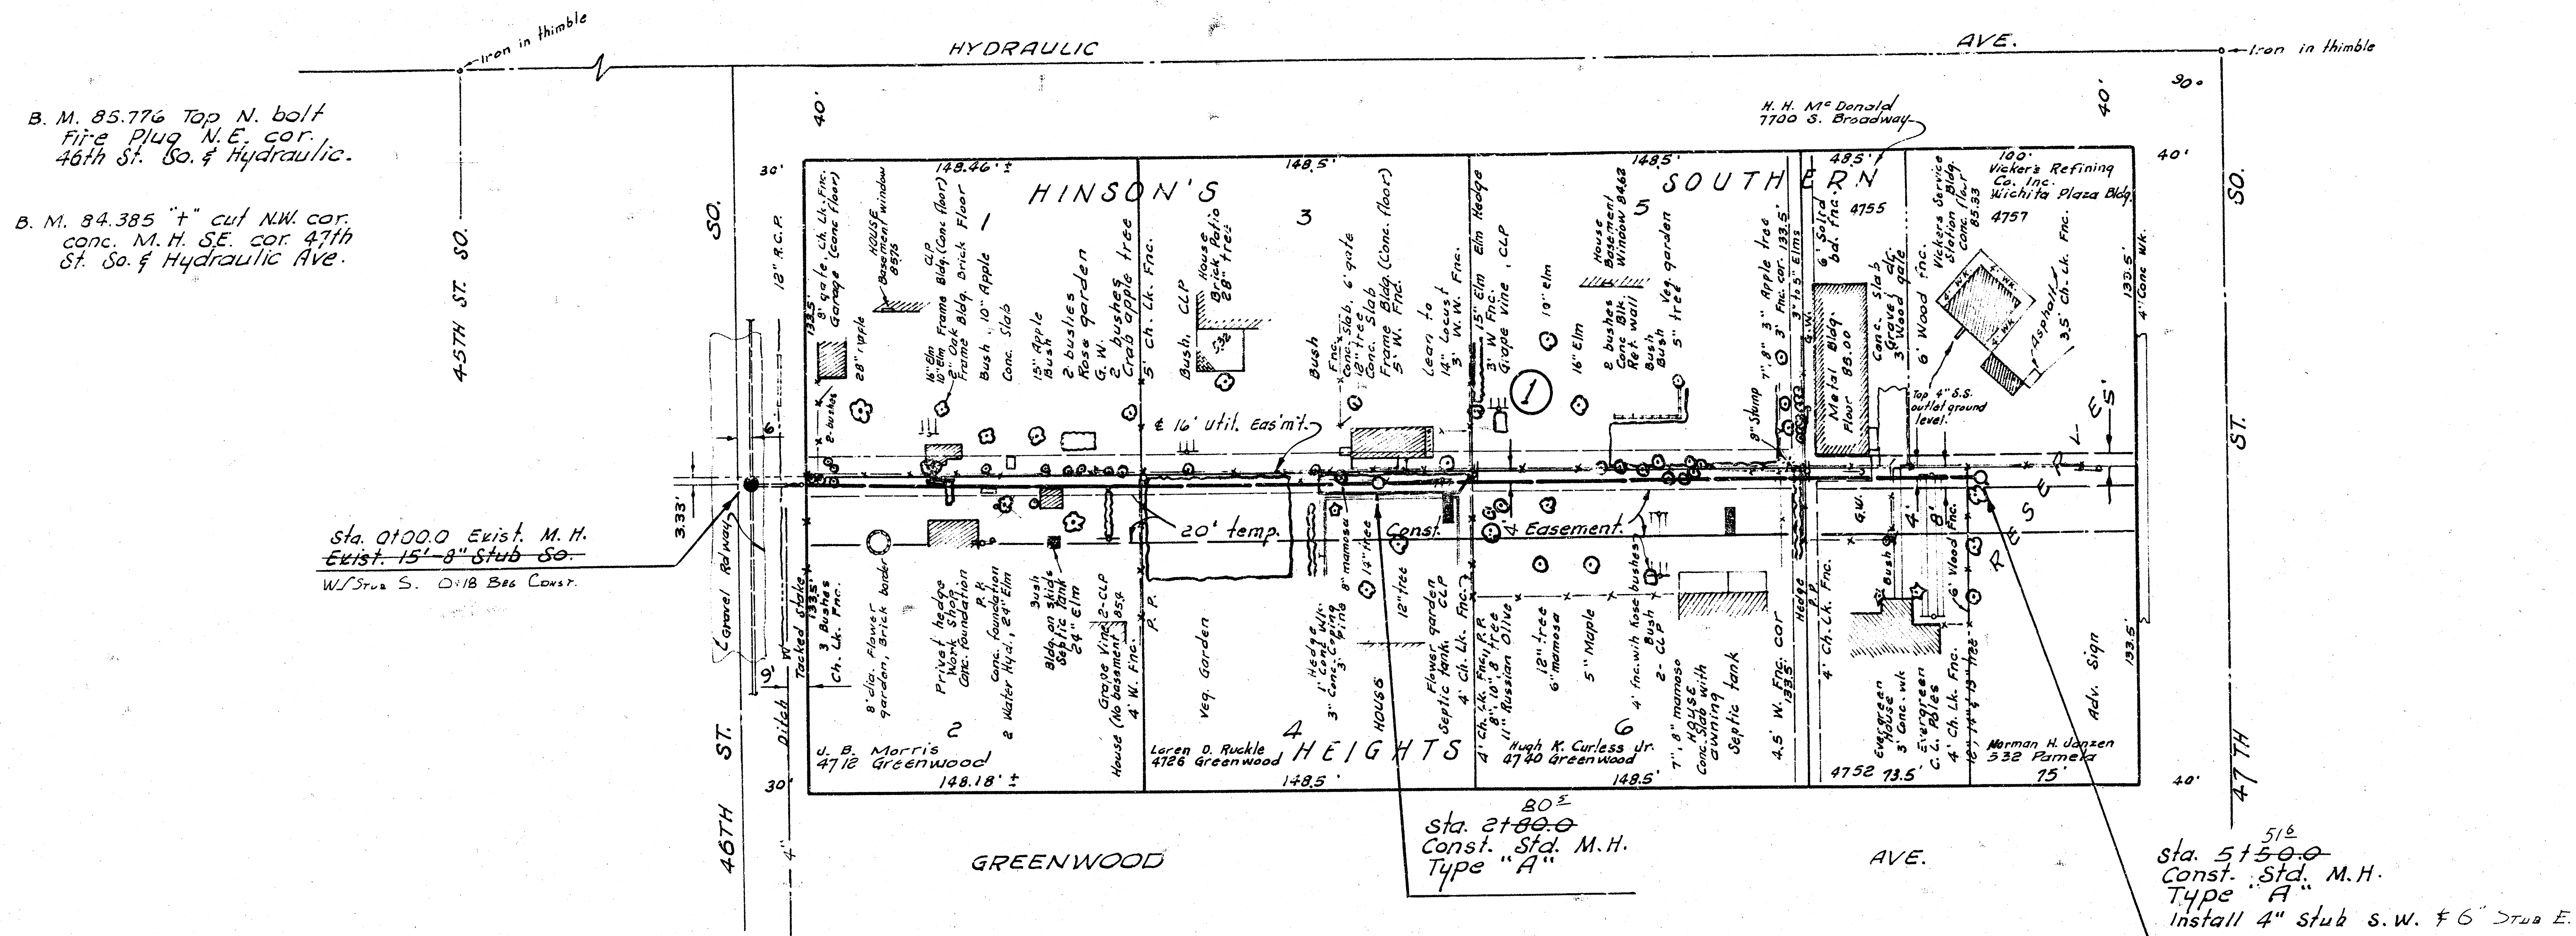


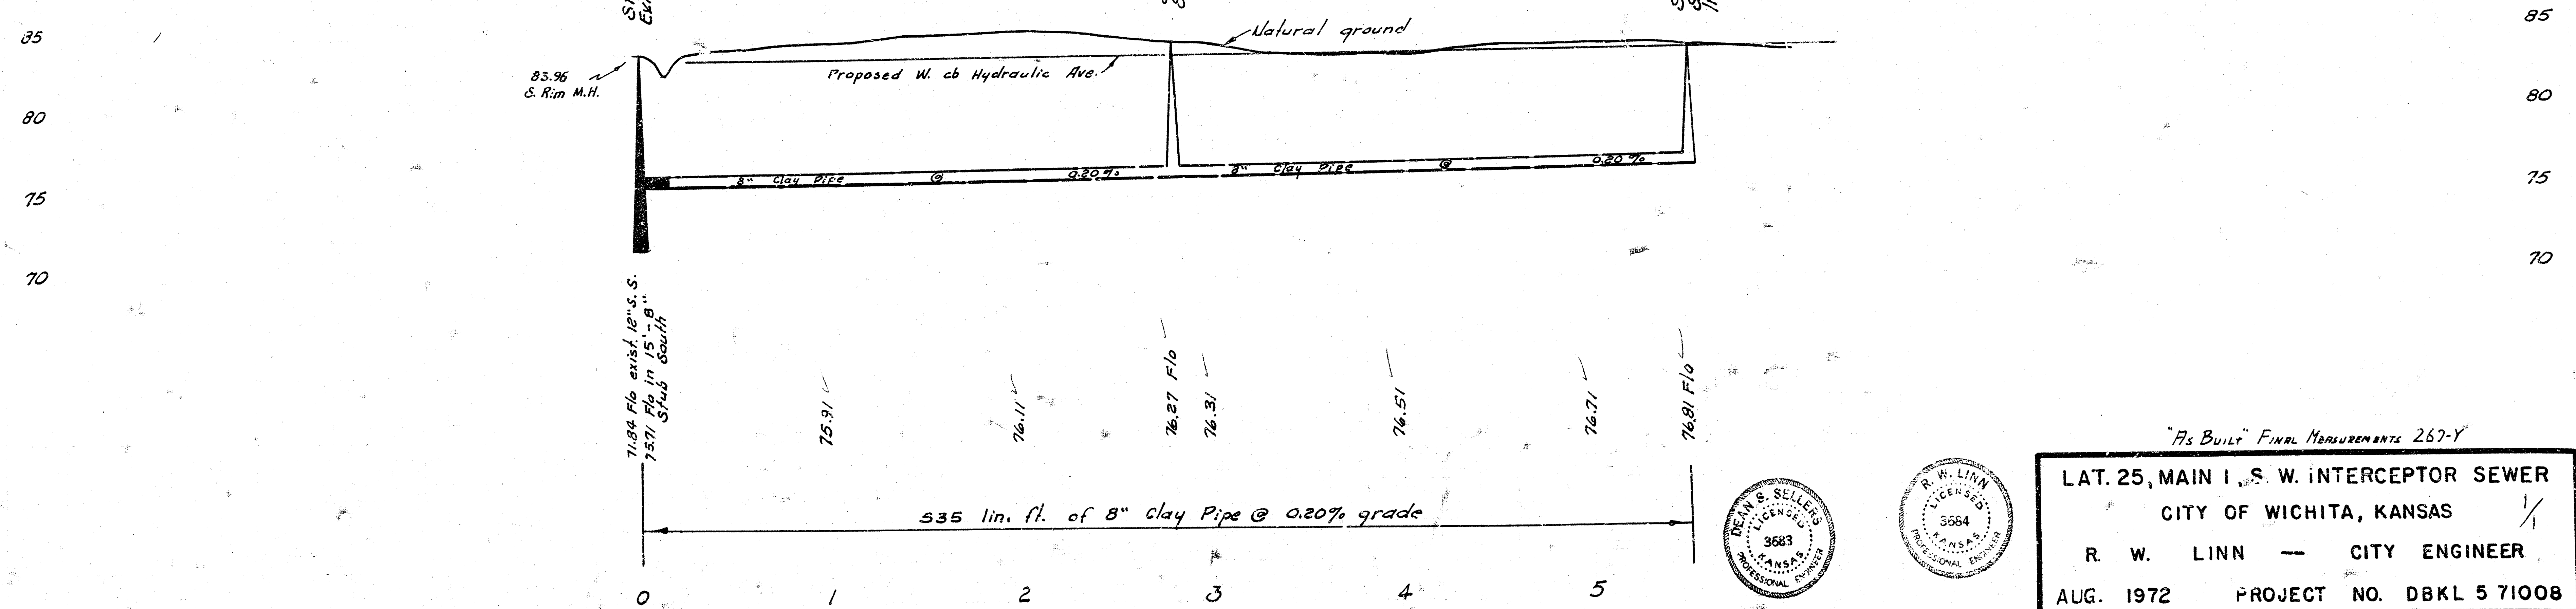

Plan Scale 1" = 40'
Profile Scale 1" = 5' Vert.

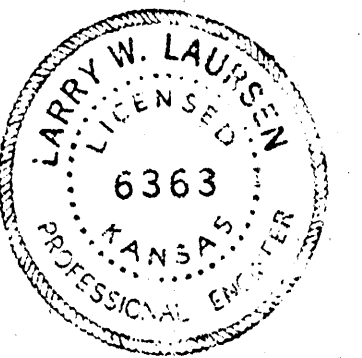

"As Built" Final Measurements 267-Y

LAT. 25, MAIN I. S. W. INTERCEPTOR SEWER
CITY OF WICHITA, KANSAS

R. W. LINN — CITY ENGINEER

AUG. 1972 PROJECT NO. DBKL 5 71008

FILMED FROM THE BEST AVAILABLE COPY