


B.M. 85.78 Top N. Bolt Fire Hyd. NE. Cor. 46th + Hydraulic
 B.M. 86.86 S.E. Bolt Top Flange Fire Hyd. NE. Cor. Lulu + 46th St. South
 B.M. 84.51 R.R. Spk. S. Side RR between Pattie + Lulu N. Side 46th St. S.

Plan Scale 1" = 40'
 Profile Scale 1" = 40' Horiz.
 1" = 5' Vert.

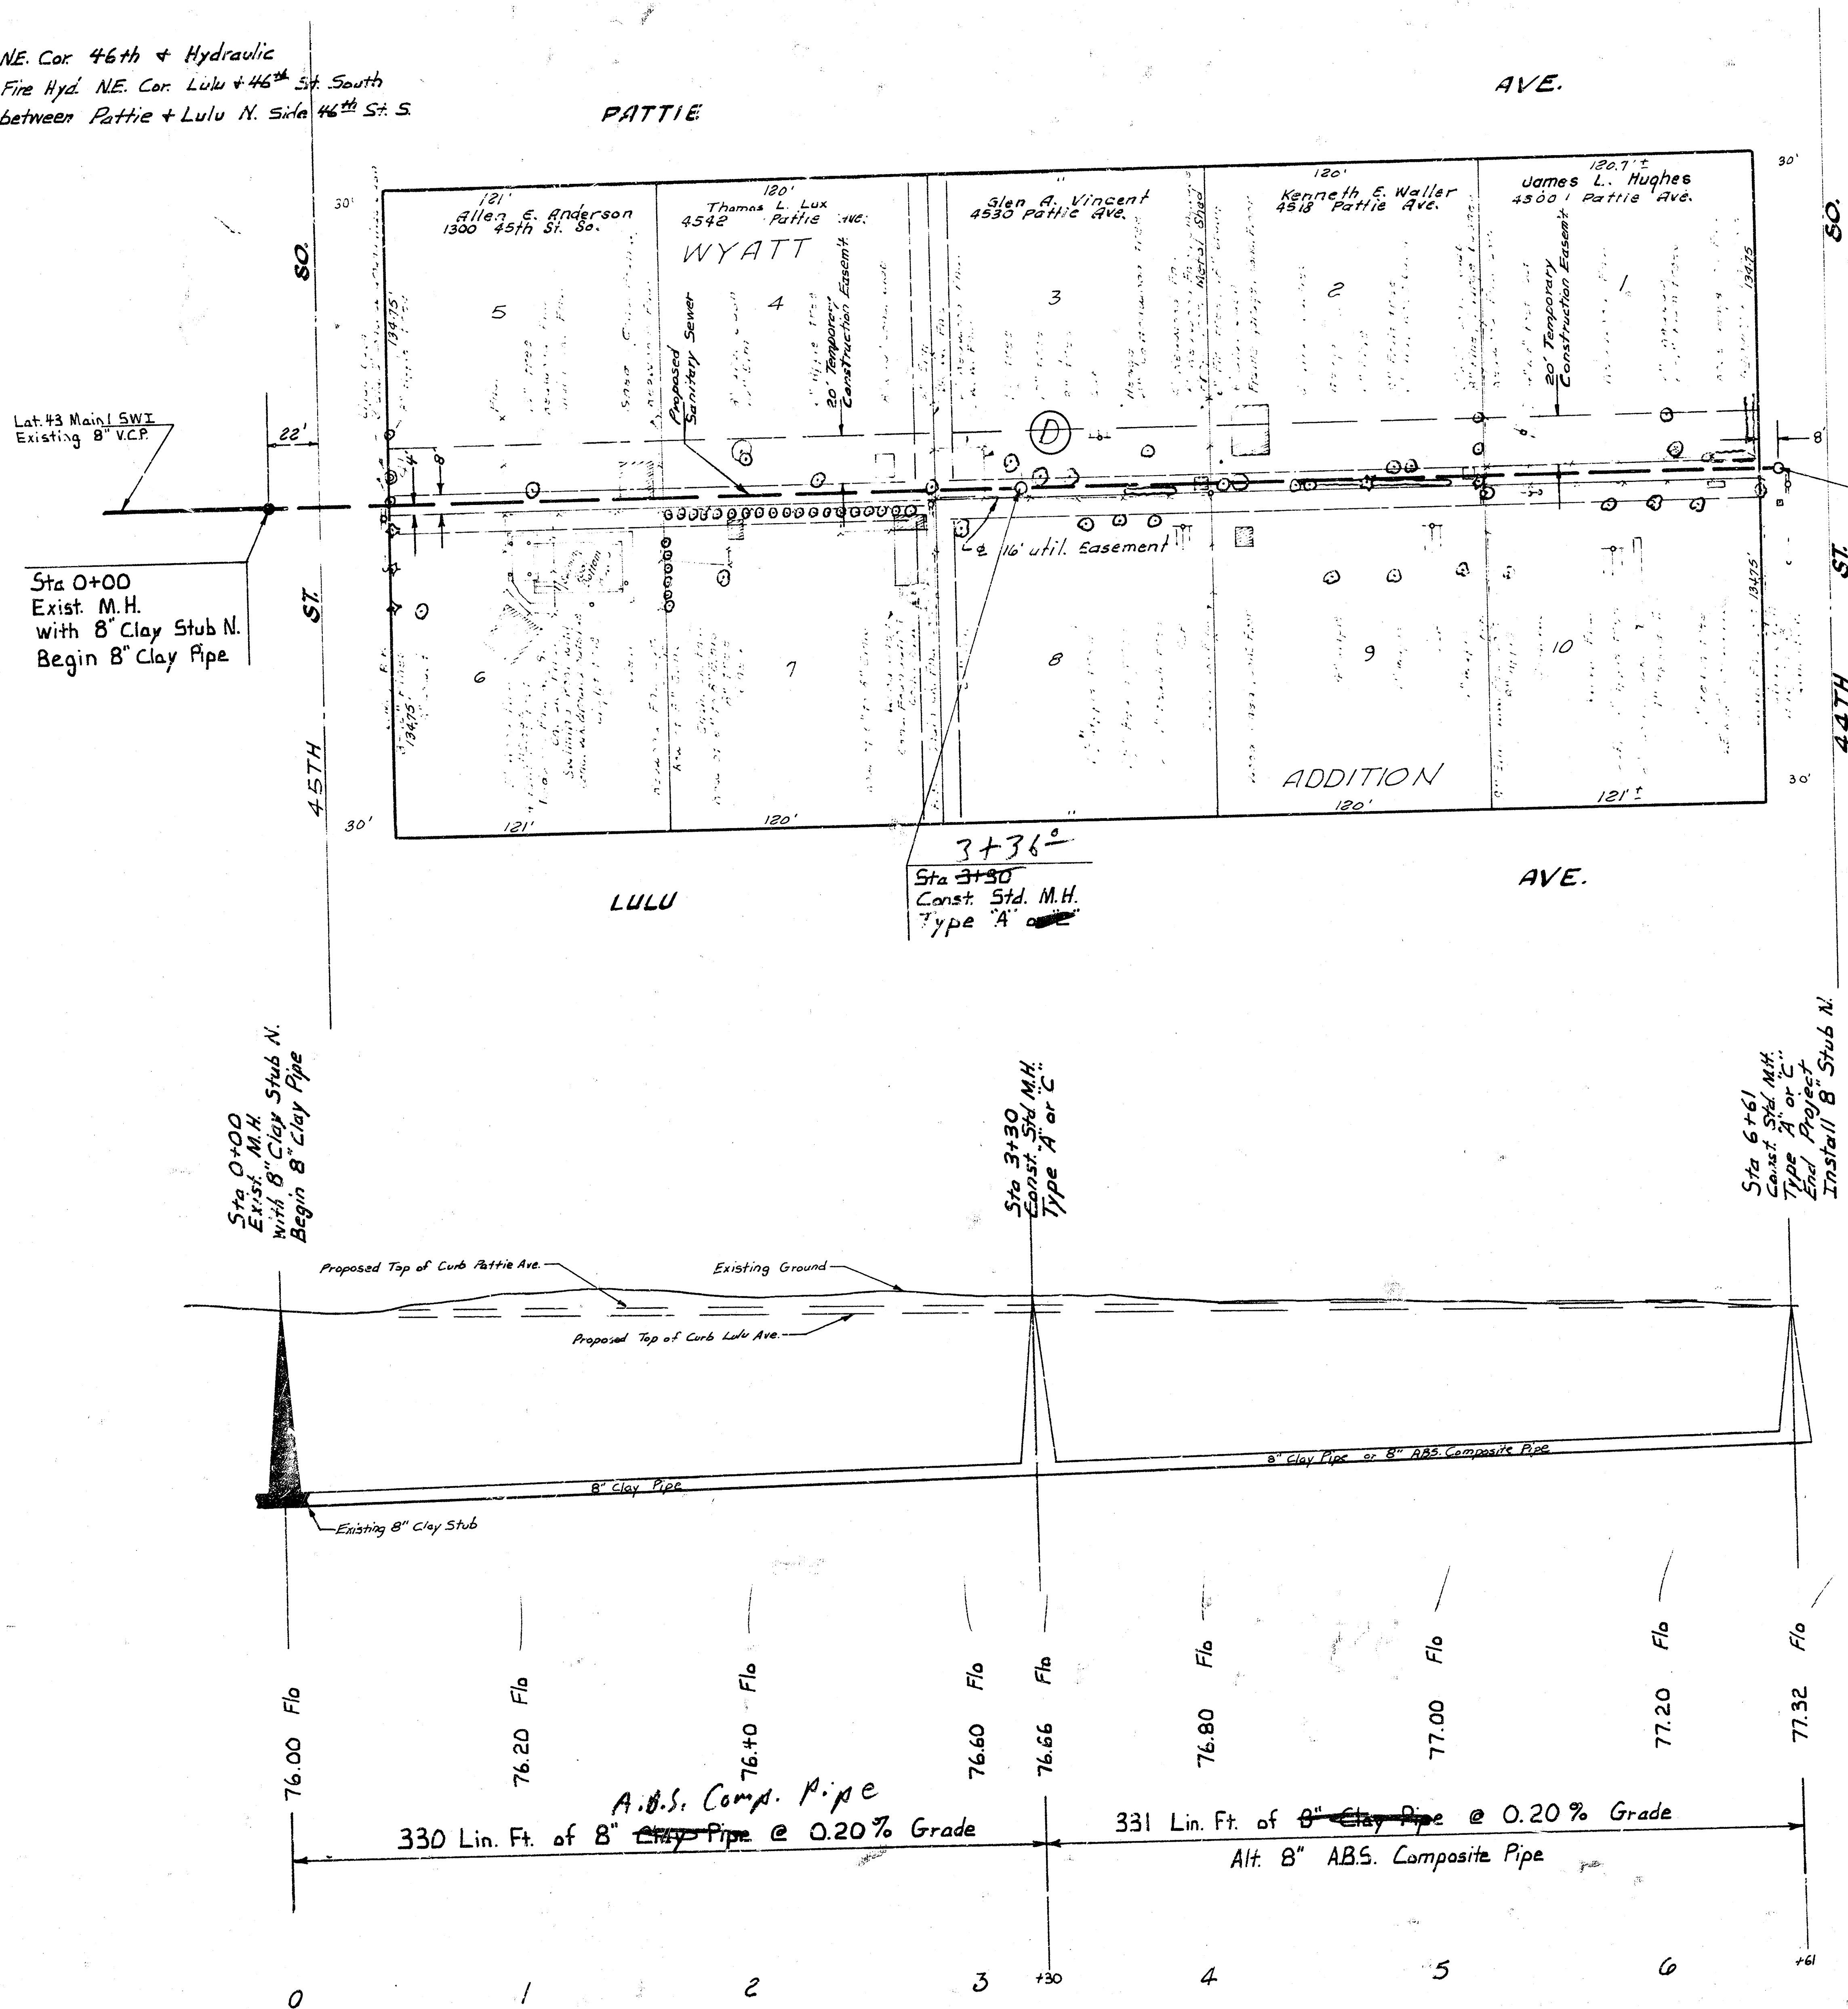

NOTE: CONTRACTOR SHALL GIVE ALL PROPERTIES AFFECTED BY THE CONSTRUCTION OF THIS PROJECT A MINIMUM OF 24 HOURS ADVANCE NOTICE PRIOR TO STARTING CONSTRUCTION. CONDITIONS OF RIGHT-OF-WAY ACQUISITION REQUIRES THE CONTRACTOR TO SECURE ANY EVIDENCE THAT IS DAMAGED AS A RESULT OF THE CONSTRUCTION OF THIS SEWER.

As built 11-16-77

LAT. 27, MAIN I, S. W. INTERCEPTOR SEWER
 CITY OF WICHITA, KANSAS
 R. W. LINN — CITY ENGINEER
 DATE: PROJECT NO. DBKL571 1/2

