

B.M. 85.92 Head of east
bolt Fire Hydrant, S.W.
cor. Alta & Hydraulic.

NOTE: SOUTH RIVERSIDE BAPTIST
CHURCH WANTS THE SEWER
COMPLETED ON THEIR PROPERTY
BETWEEN MONDAY AND FRIDAY
SO THEY CAN USE THE PARKING
ON SUNDAY.

NOTE: START PROJECT AT
EXISTING M.H. - NEW FLO. IN
ELE. 75.00


NOTE: CONTRACTOR TO REPLACE ALL FENCES THAT
ARE REMOVED TO FACILITATE CONSTRUCTION OF THE
SEWER. FENCES TO BE REPLACED IN A CONDITION
EQUAL TO OR BETTER THAN THE ORIGINAL.

NOTE: WATER WELL LOCATED ON LOT 14 IS TO BE
PROTECTED DURING CONSTRUCTION OF SEWER TO
PREVENT ANY DAMAGE.

NOTE:
Plug opening in
manhole with
brick and mortar
plug.

GRADE ELEV'S
RAISED 1" BY
CITY ENGR.

LAT. 28, MAIN I, S. W. INTERCEPTOR SEWER
CITY OF WICHITA, KANSAS
W. LINN - CITY ENGINEER
1974 PROJECT NO. DBKL 571033

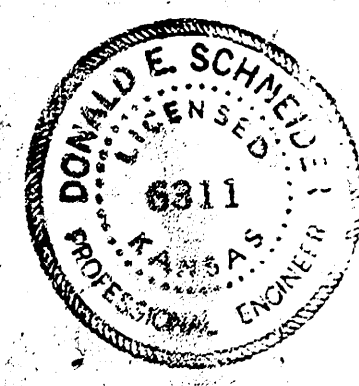

D. L. K.
W. R. W.

0690


85

80

75

70

65

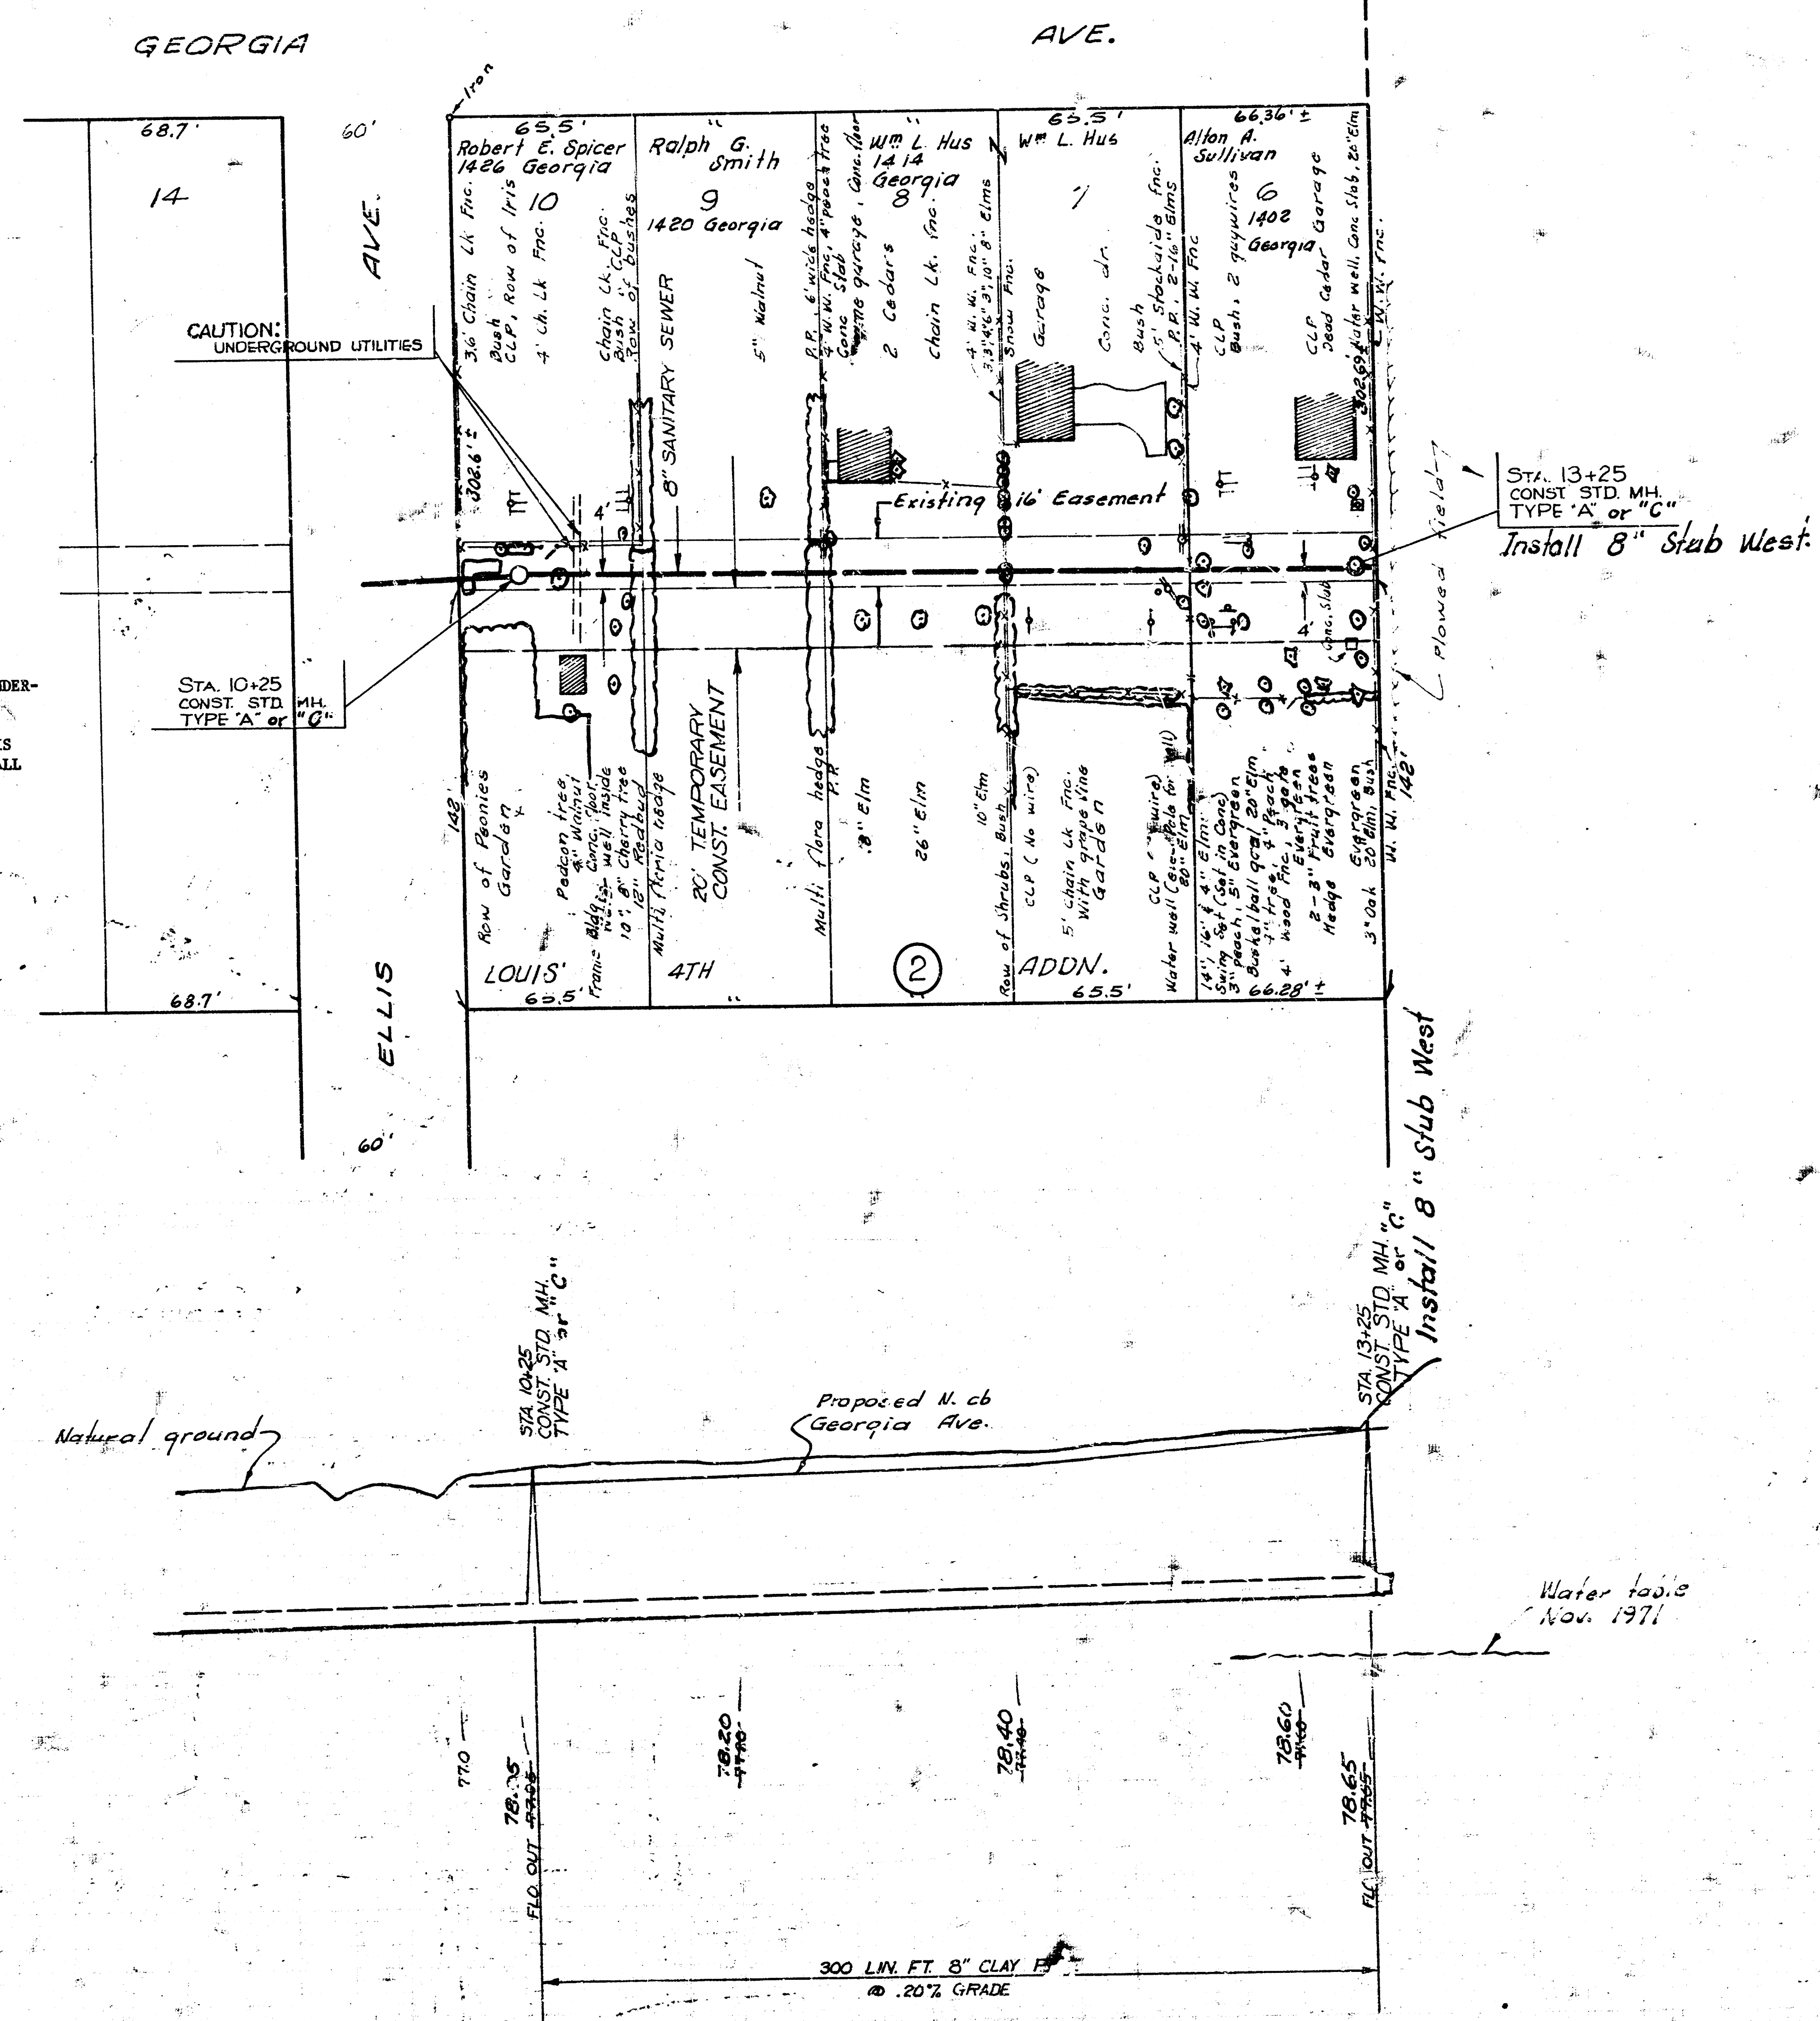

85

80

75

70

65