



B. M. 86.195 60 penny nail N-face P.P.
W. L. Ellis 190' N. of & Alta.

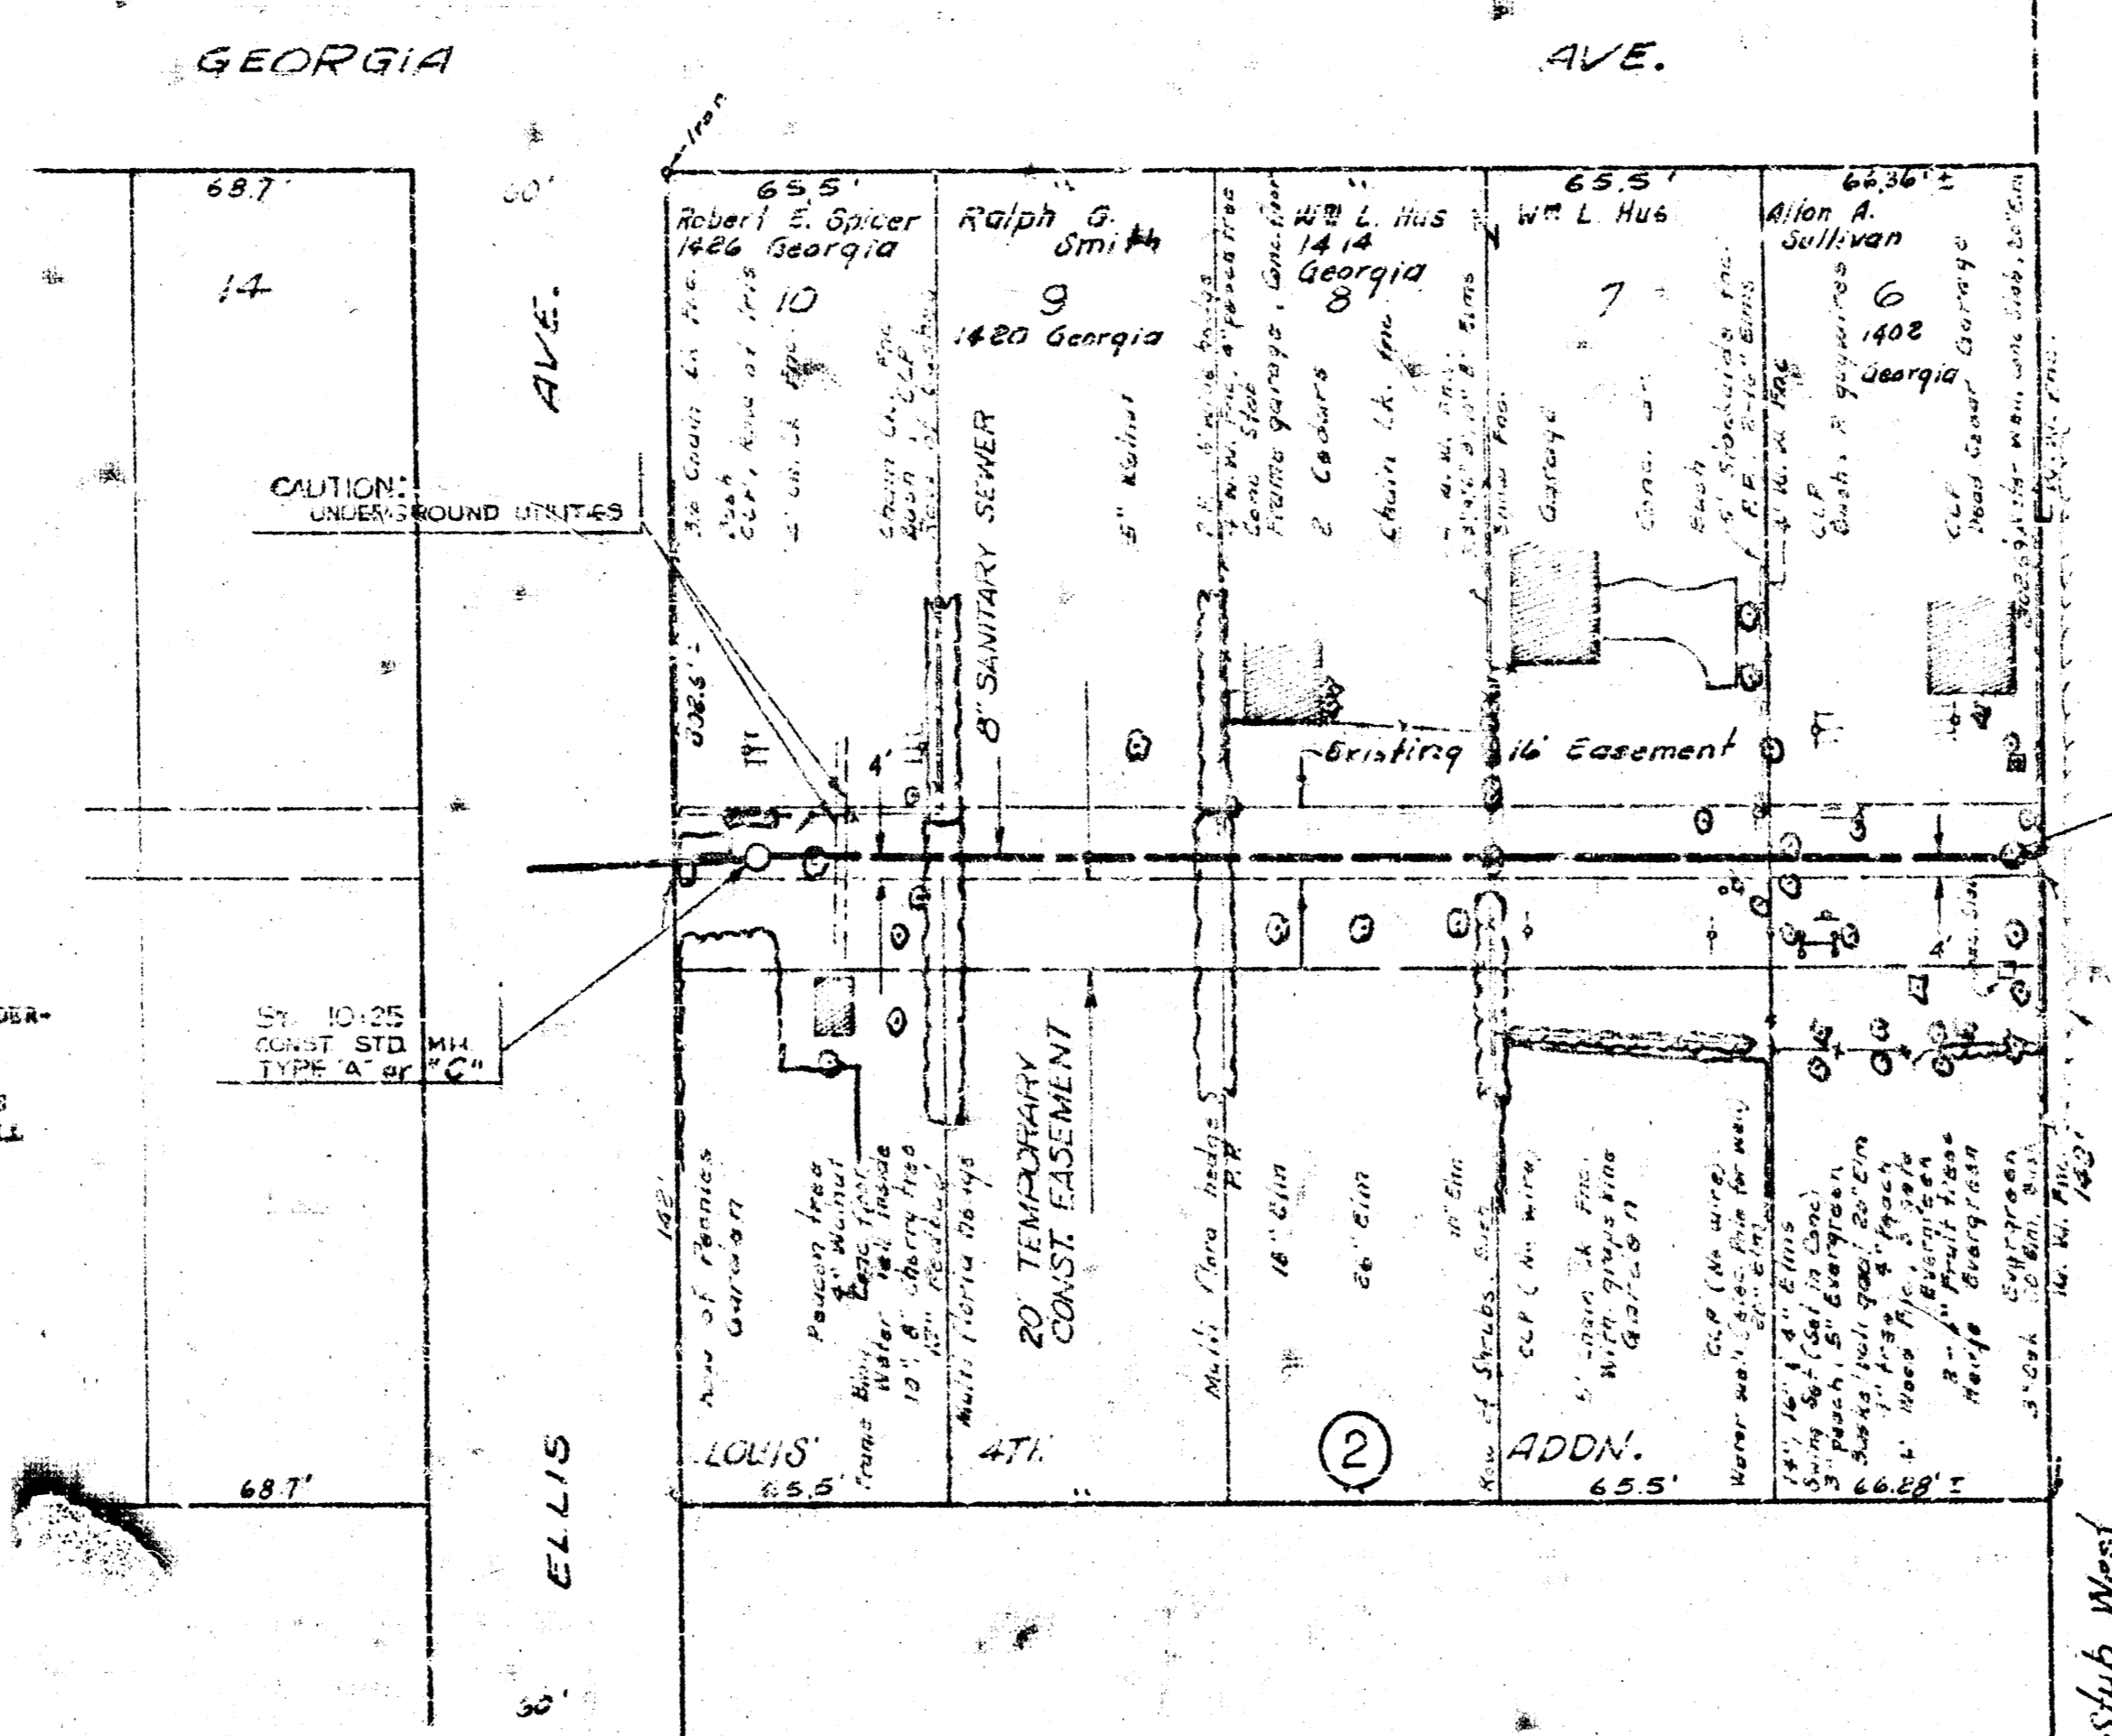

NOTE: CONTRACTOR TO REMOVE AND REPLACE UNDERGROUND WATER LINE AND ELECTRIC LINE AT APPROXIMATELY STA. 10+25 AS NECESSARY TO FACILITATE CONSTRUCTION OF THE SEWER. THIS WORK WILL NOT BE PAID FOR DIRECTLY AND SHALL BE CONSIDERED AS INCIDENTAL TO THE OTHER ITEMS OF WORK.

STA. 13+25
CONST. STD. MH.
TYPE "A" OR "C"
Install 8" Slab West.

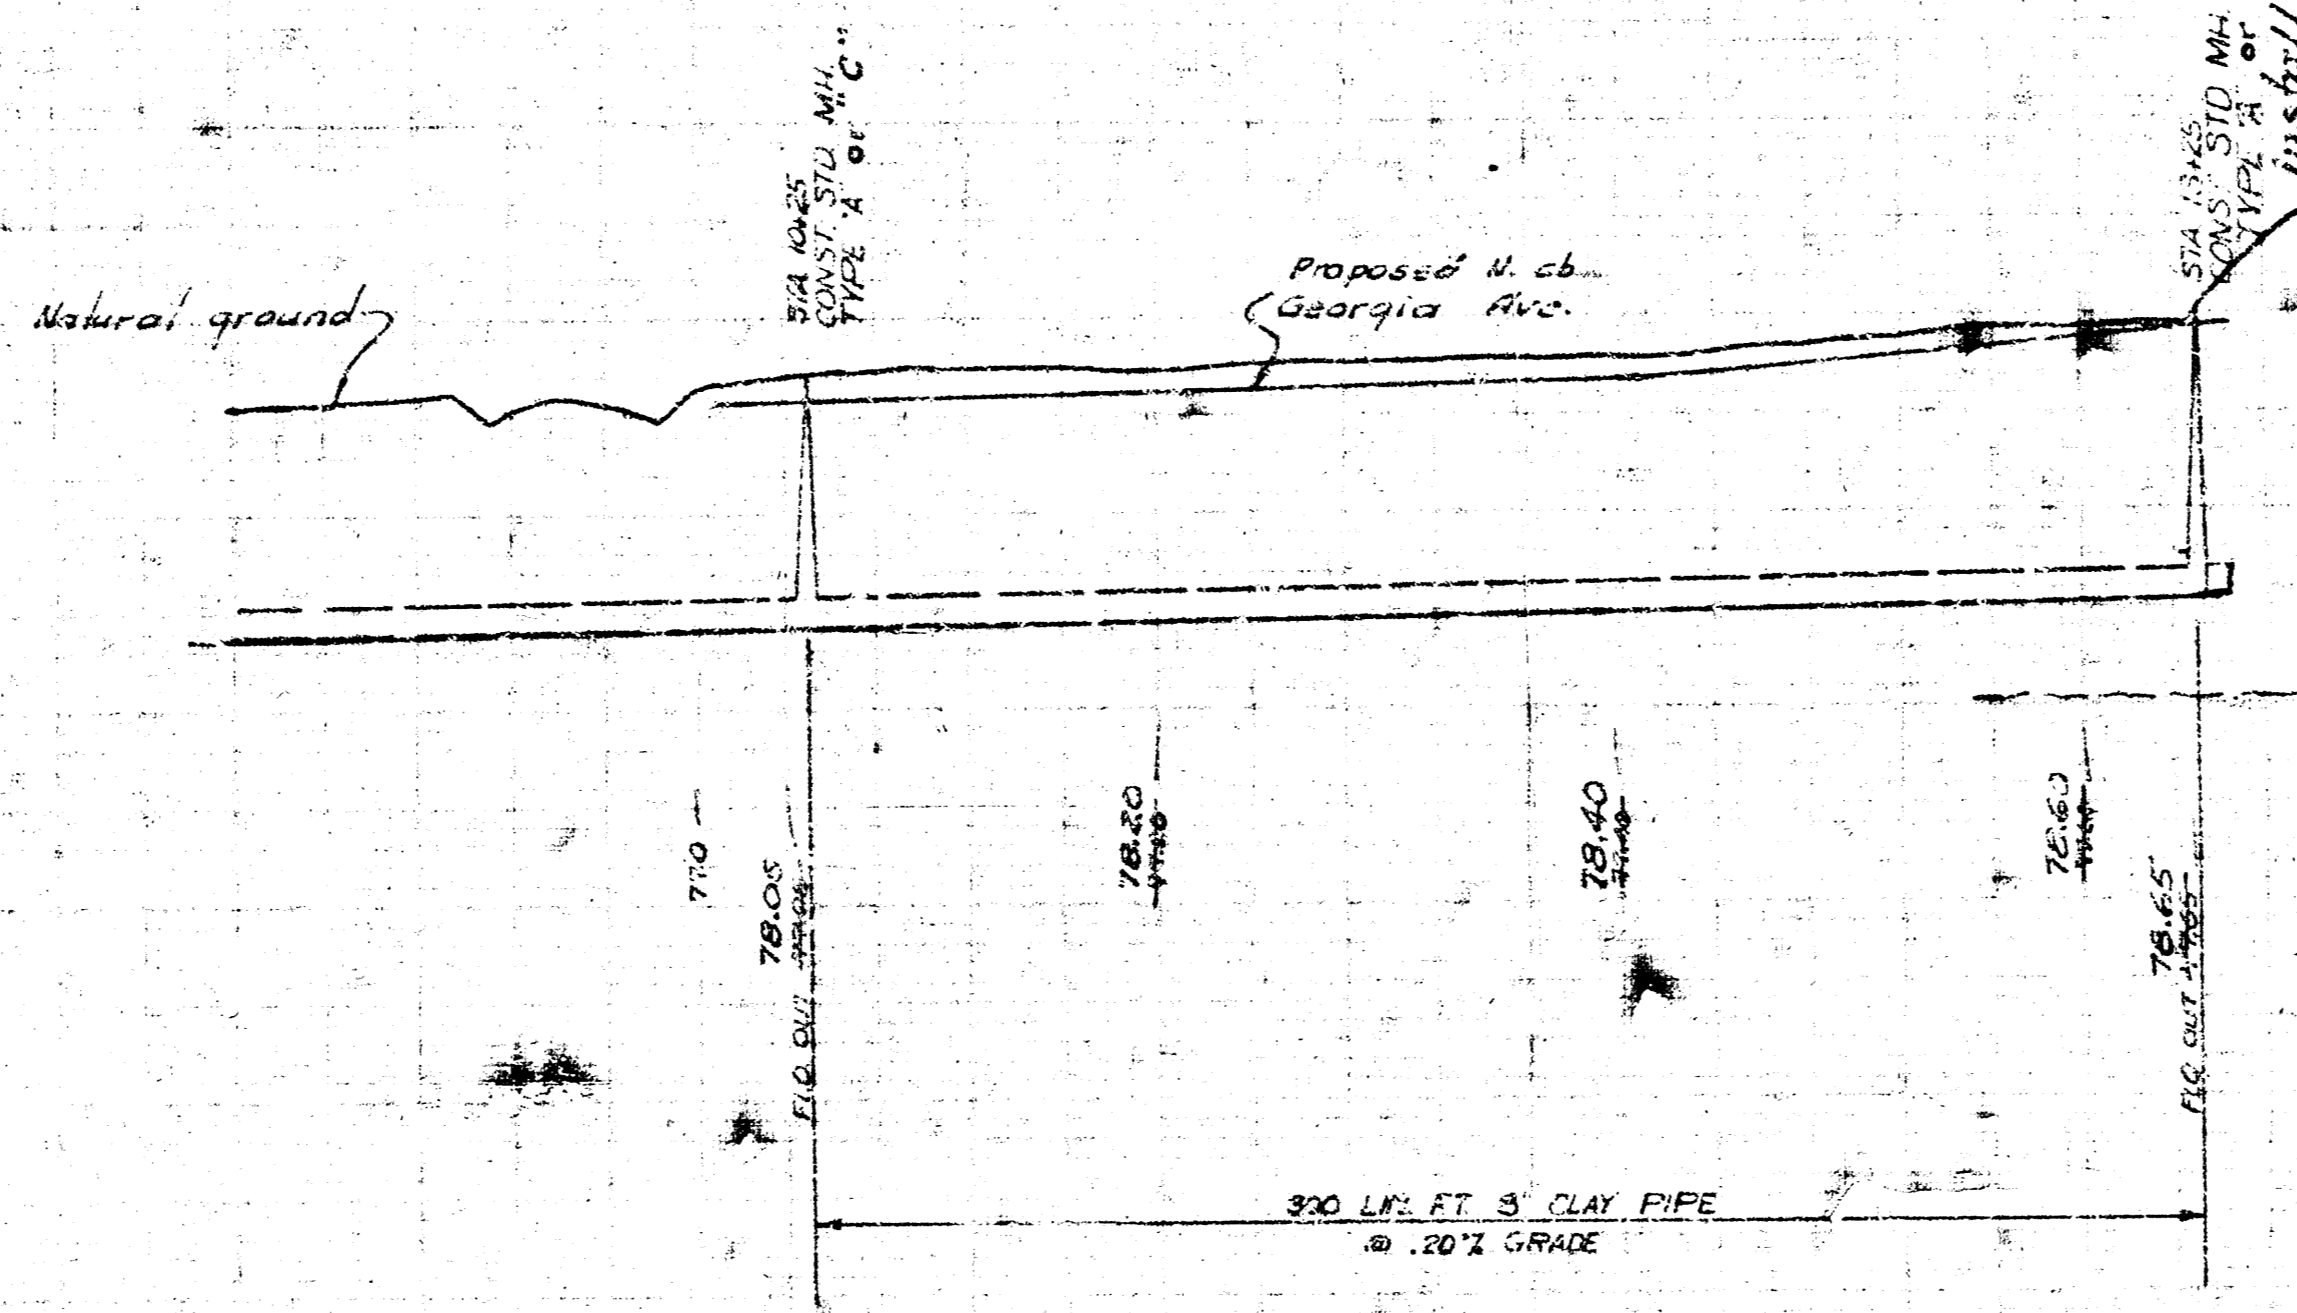

LAT. 28, MAIN L. S. W. INTERCEPTOR SEWER
PROJECT NO. DBKL 5 71033

41 5 5 ②