



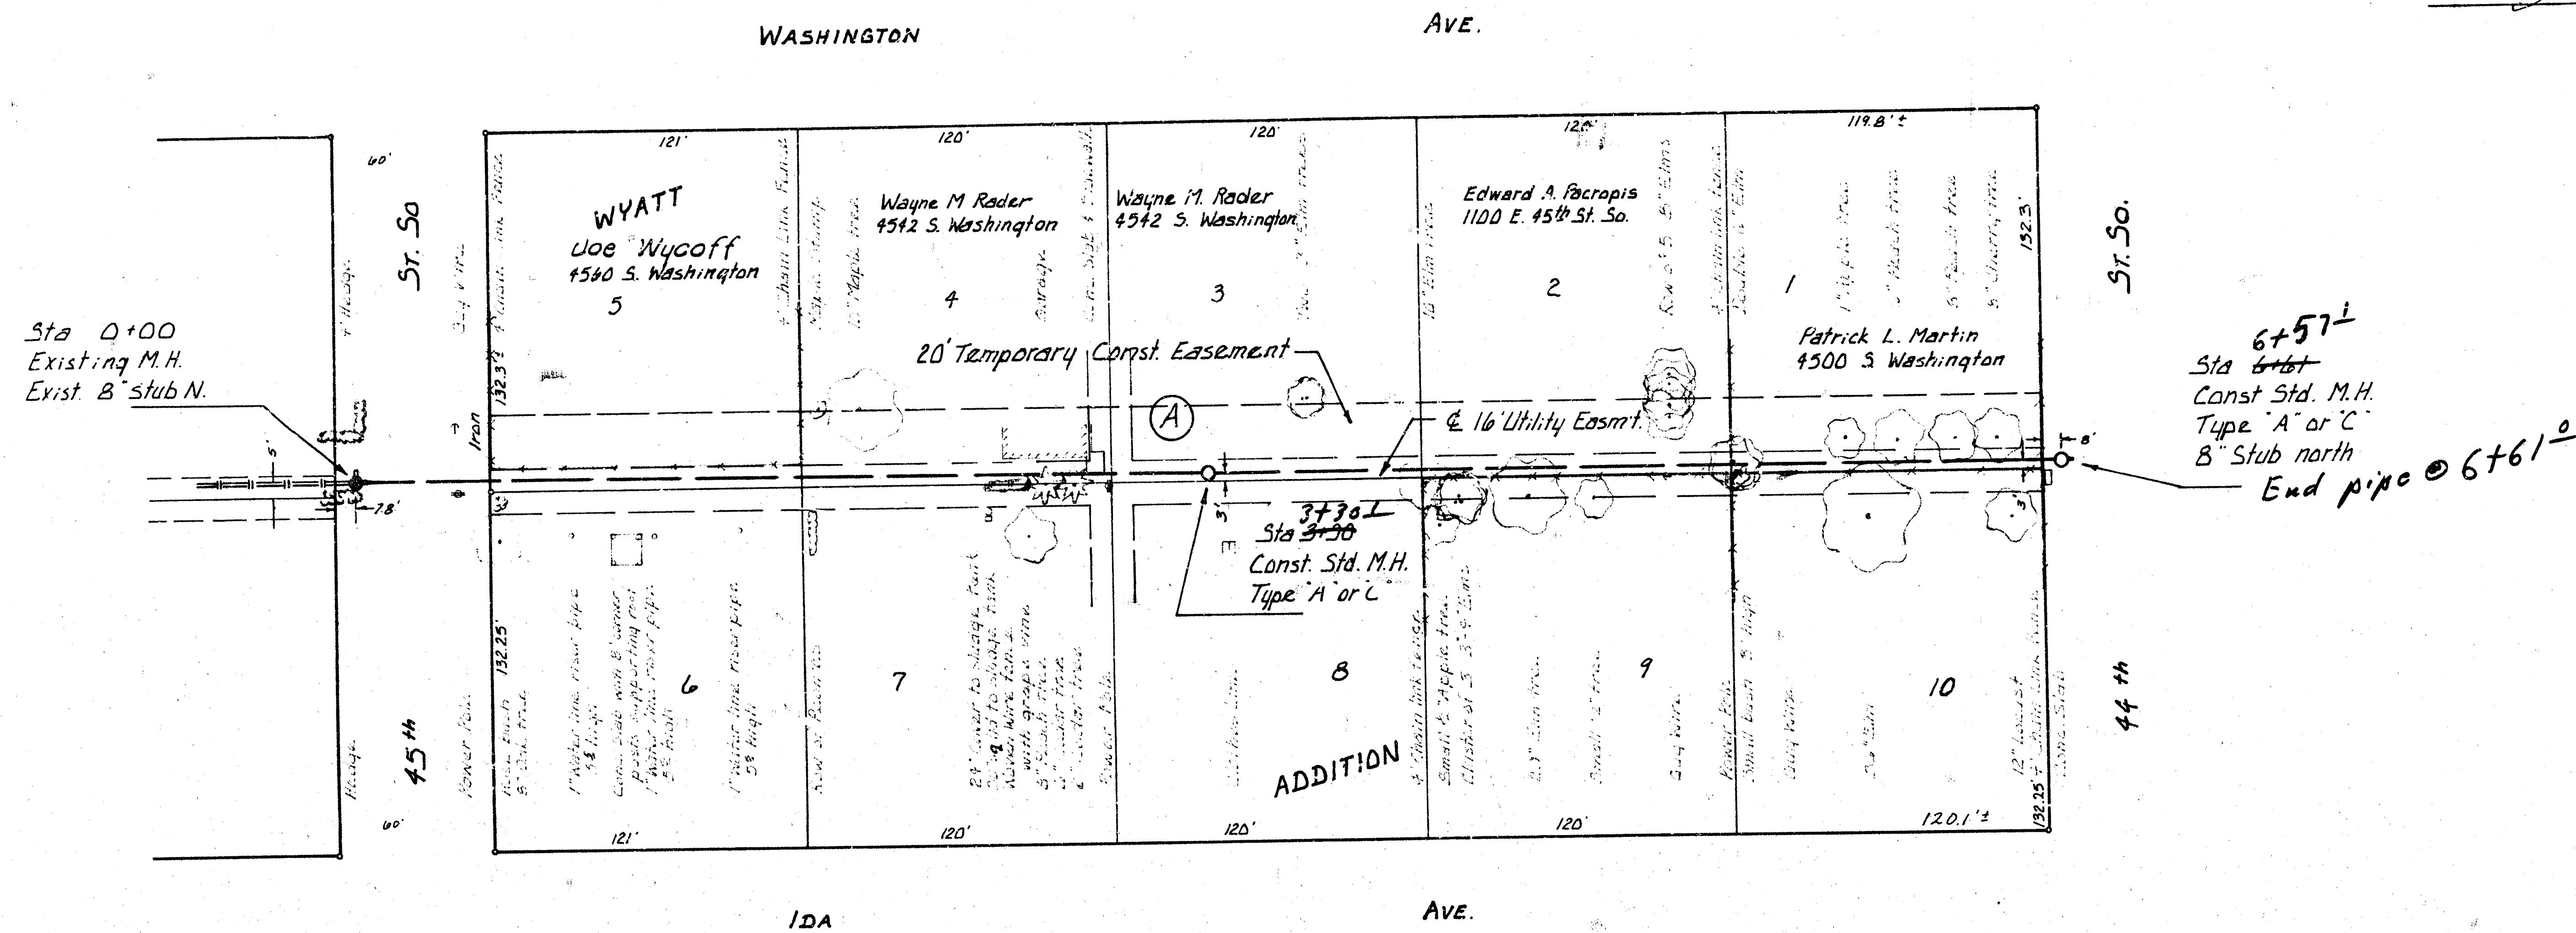

B.M. 82.53 City Std disc 2' South & 6' East of the N.E. corner of Ida & 47th St. So.

B.M. 86.93 S.E. corner lower conc. step on South Side of house at 4555 Ida.

Plan Scale 1"=40'
Profile Scale 1"=40' Horiz.
1"=5' Vert.

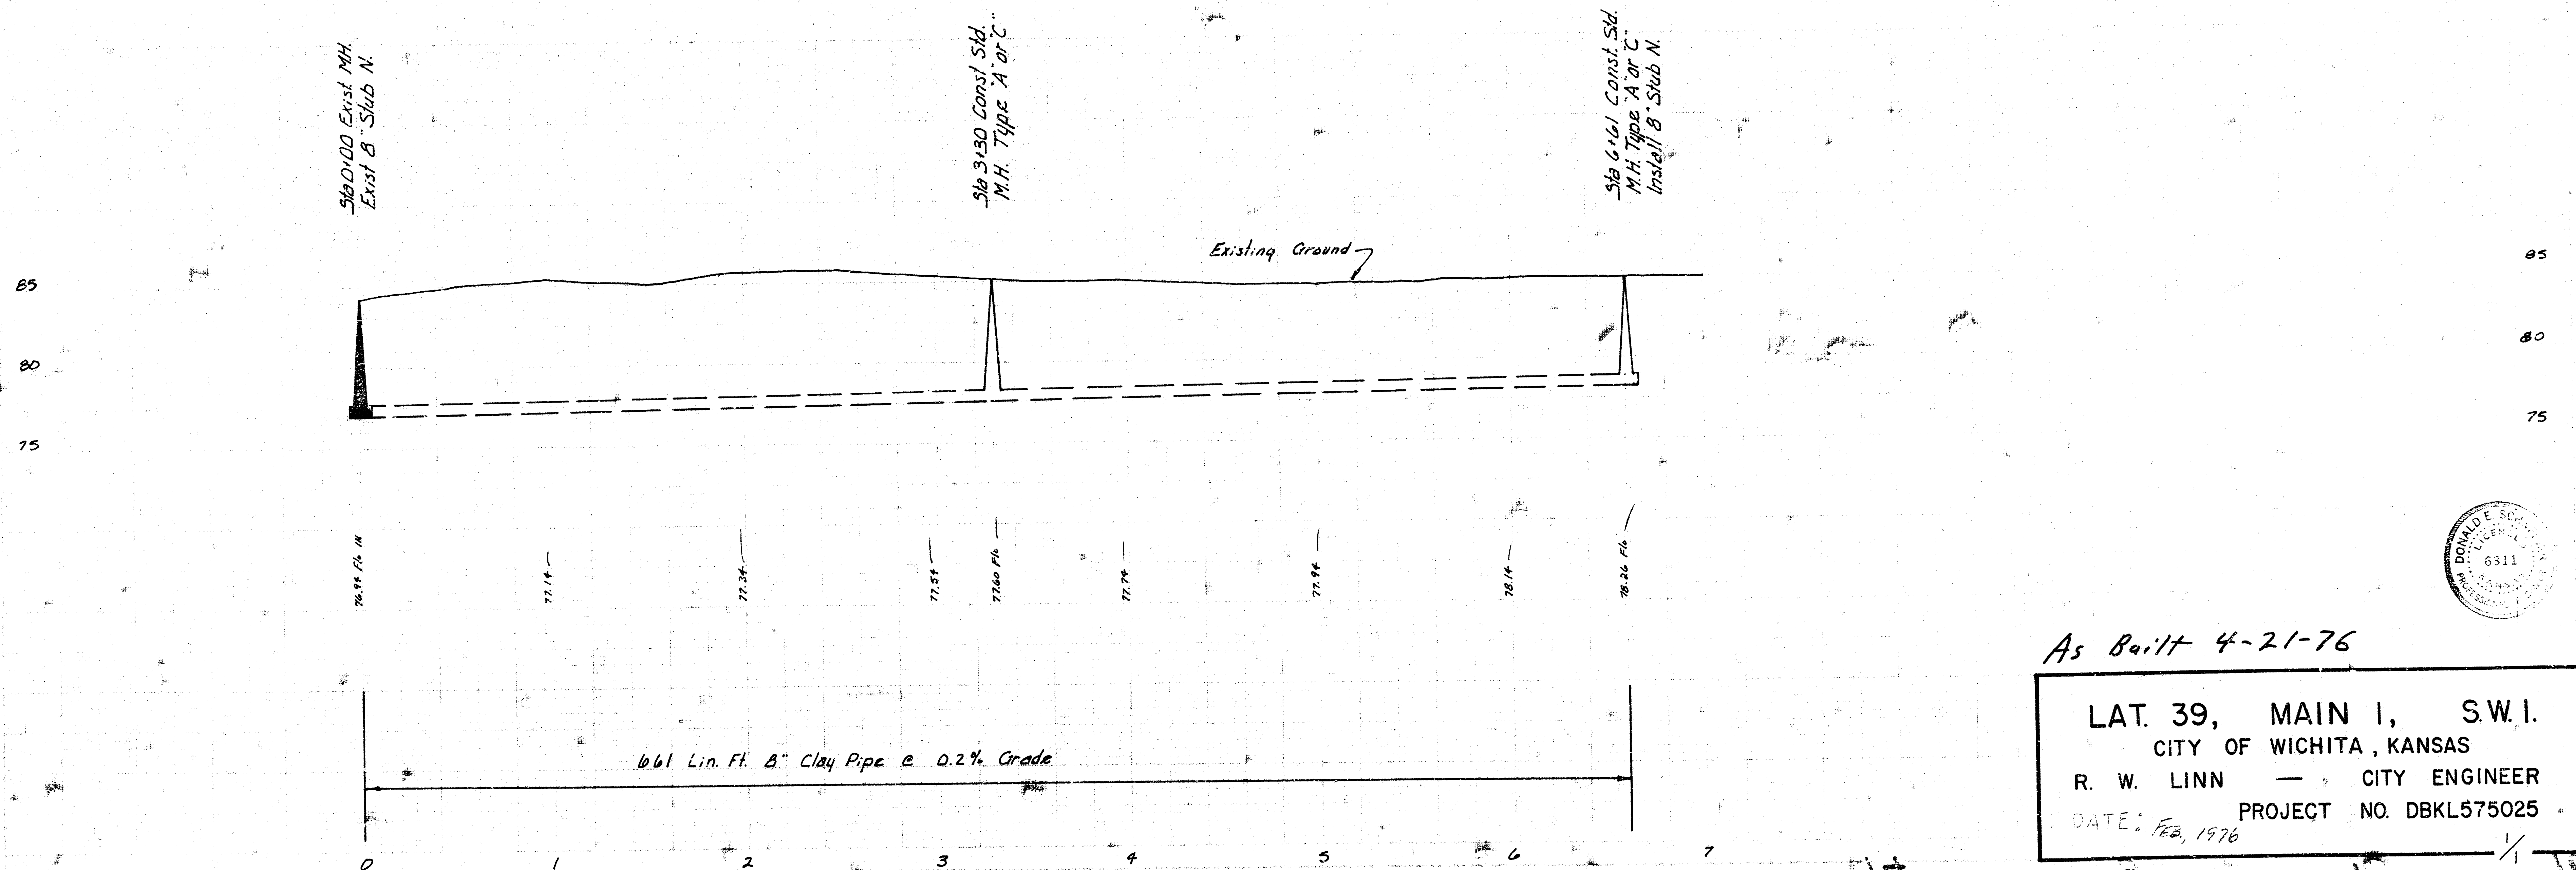

As Built 4-21-76

LAT. 39, MAIN 1, S.W.I.
CITY OF WICHITA, KANSAS
R. W. LINN — CITY ENGINEER
DATE: Feb, 1976 PROJECT NO. DBKL575025

