



PLAN  
 11/20/55  
 98-2-55

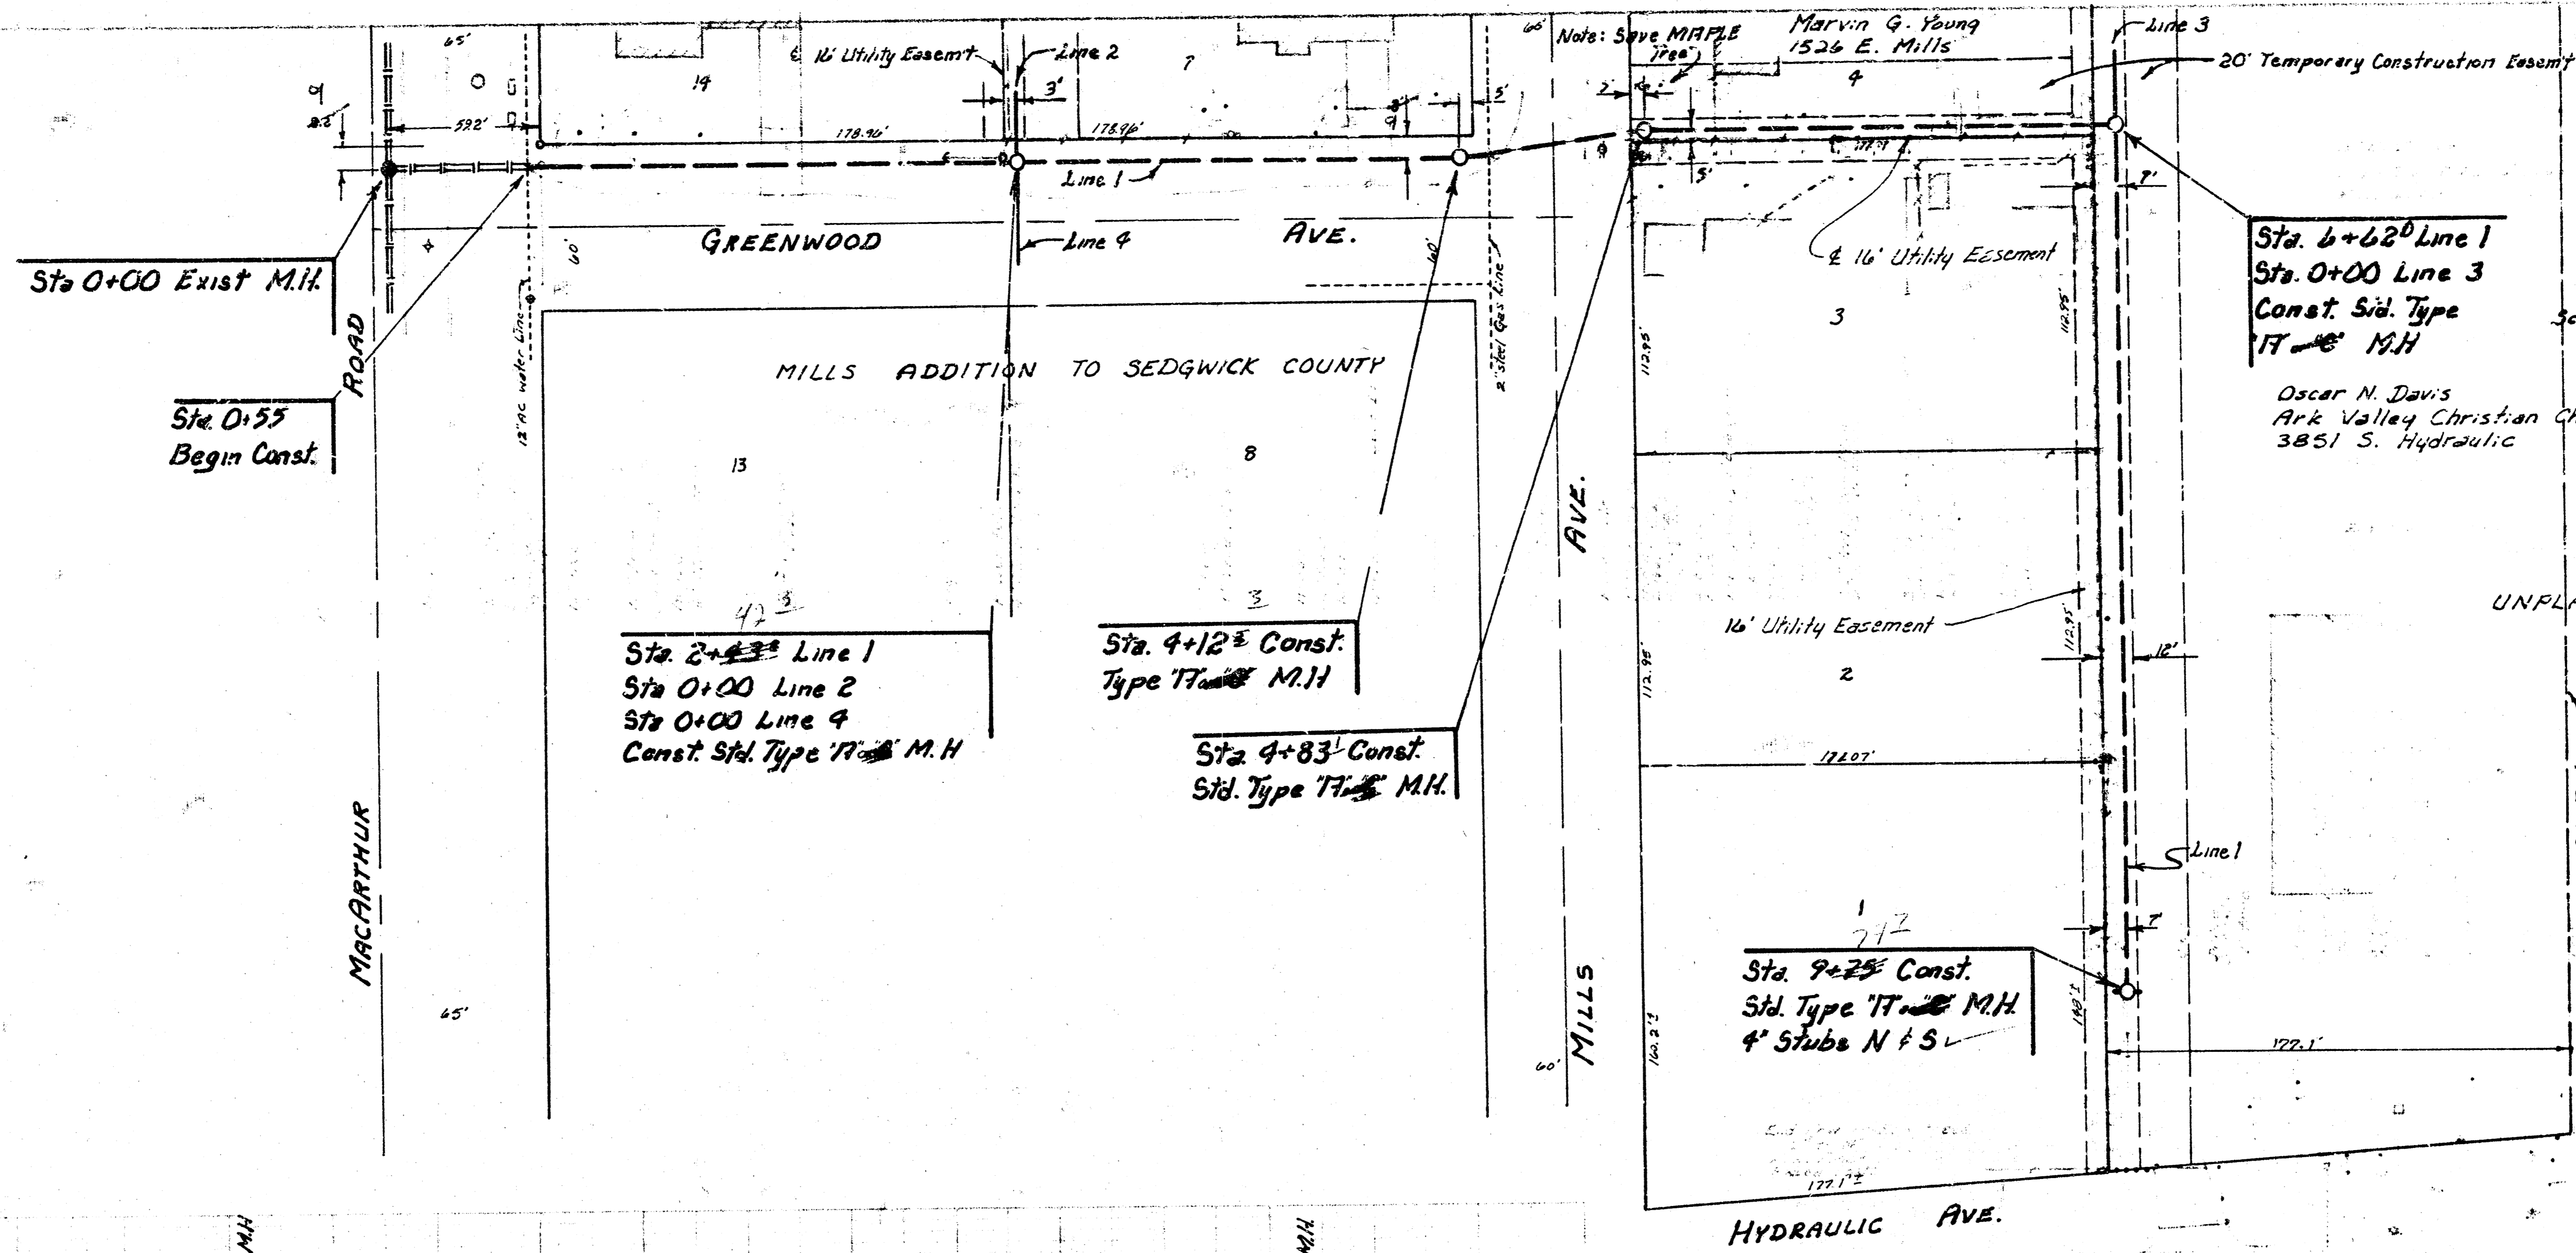

Scale Plan 1" = 40'  
 Profile 1" = 40' Horiz.  
 1" = 5' Vert.

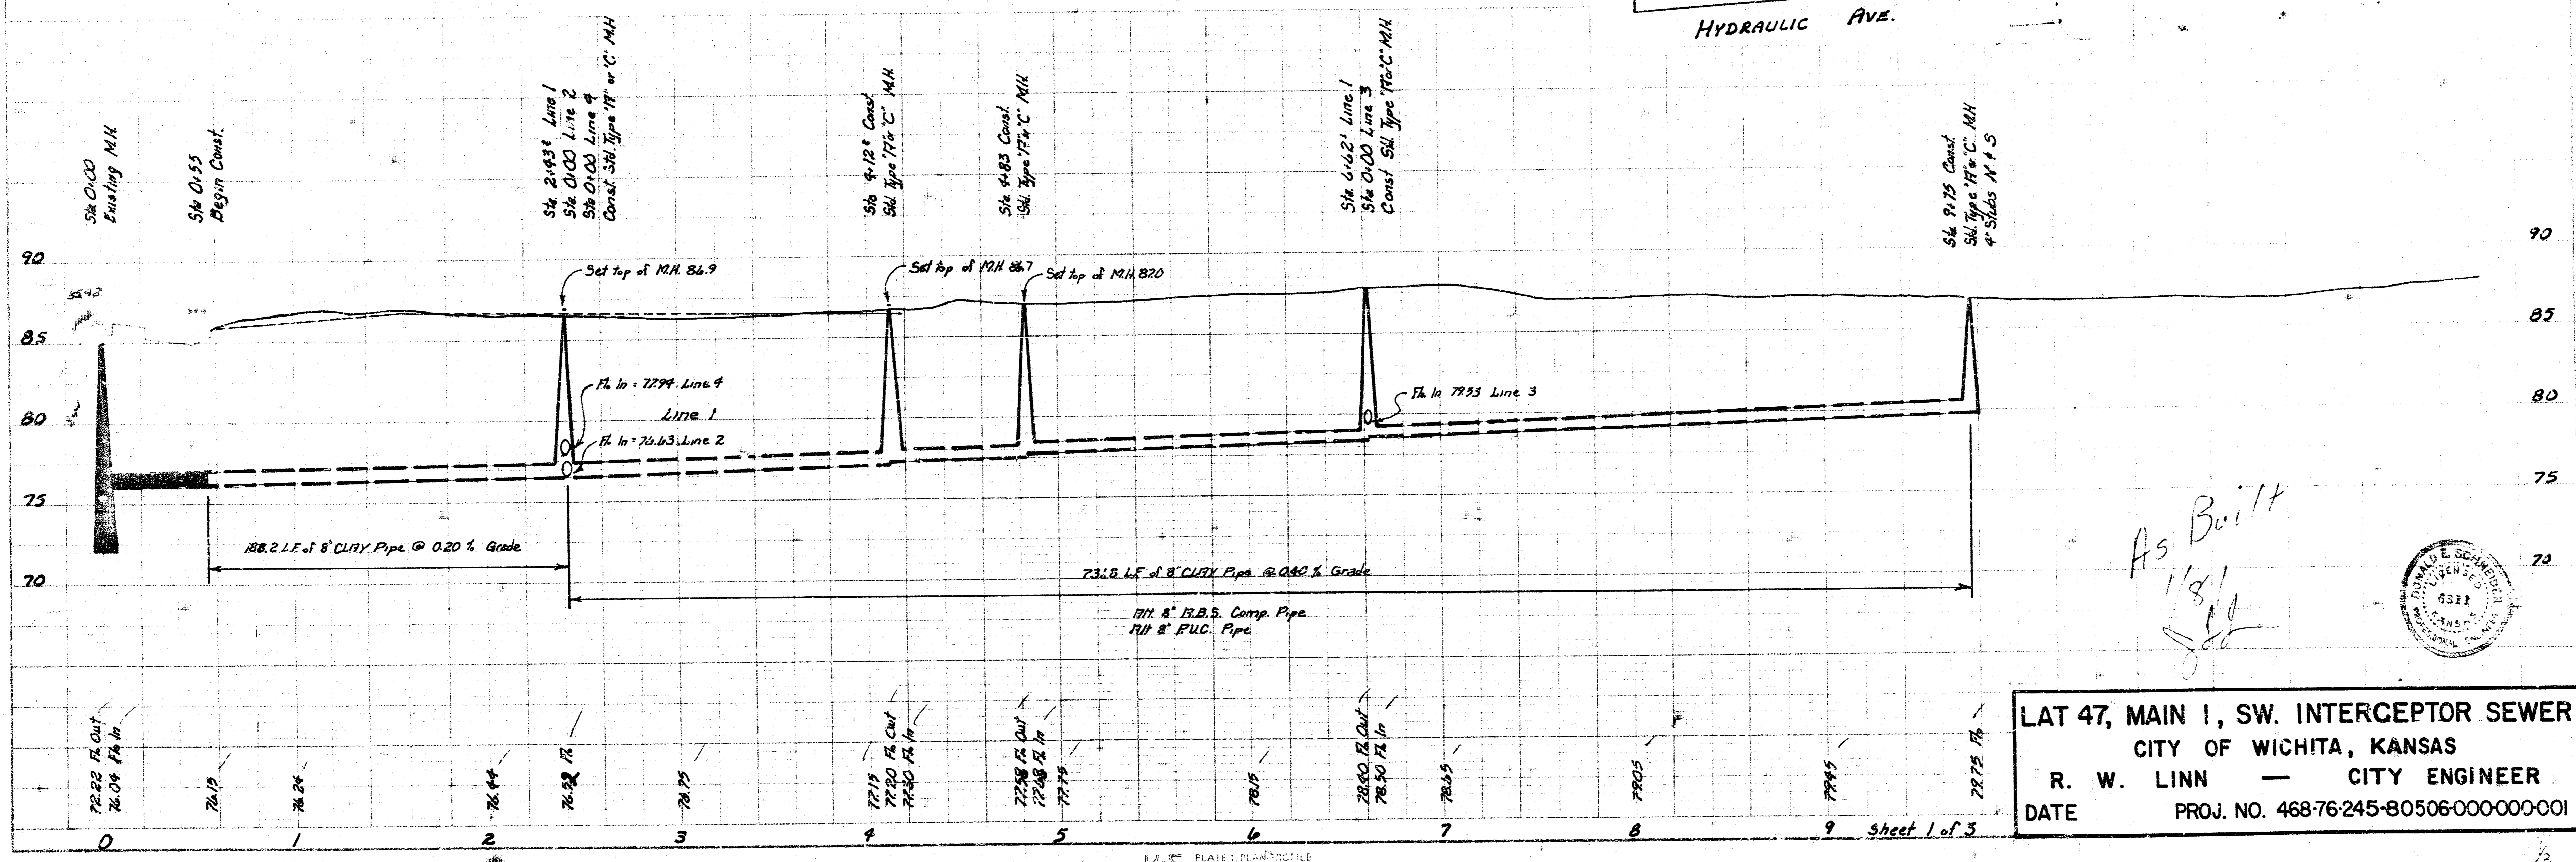

As Built  
 1/8/56  
 J.C.C.



LAT 47, MAIN I, SW. INTERCEPT SEWER  
 CITY OF WICHITA, KANSAS  
 R. W. LINN — CITY ENGINEER  
 DATE \_\_\_\_\_ PROJ. NO. 468-76-245-80506-000-000-001



