



BM 8420 City Sta. 44'E and 52' N of # HYDRULIC and 47th St Sa
 BM 8254 RR Spk. E-face PP NW Cor. HYDRULIC and FERNWOOD (West)

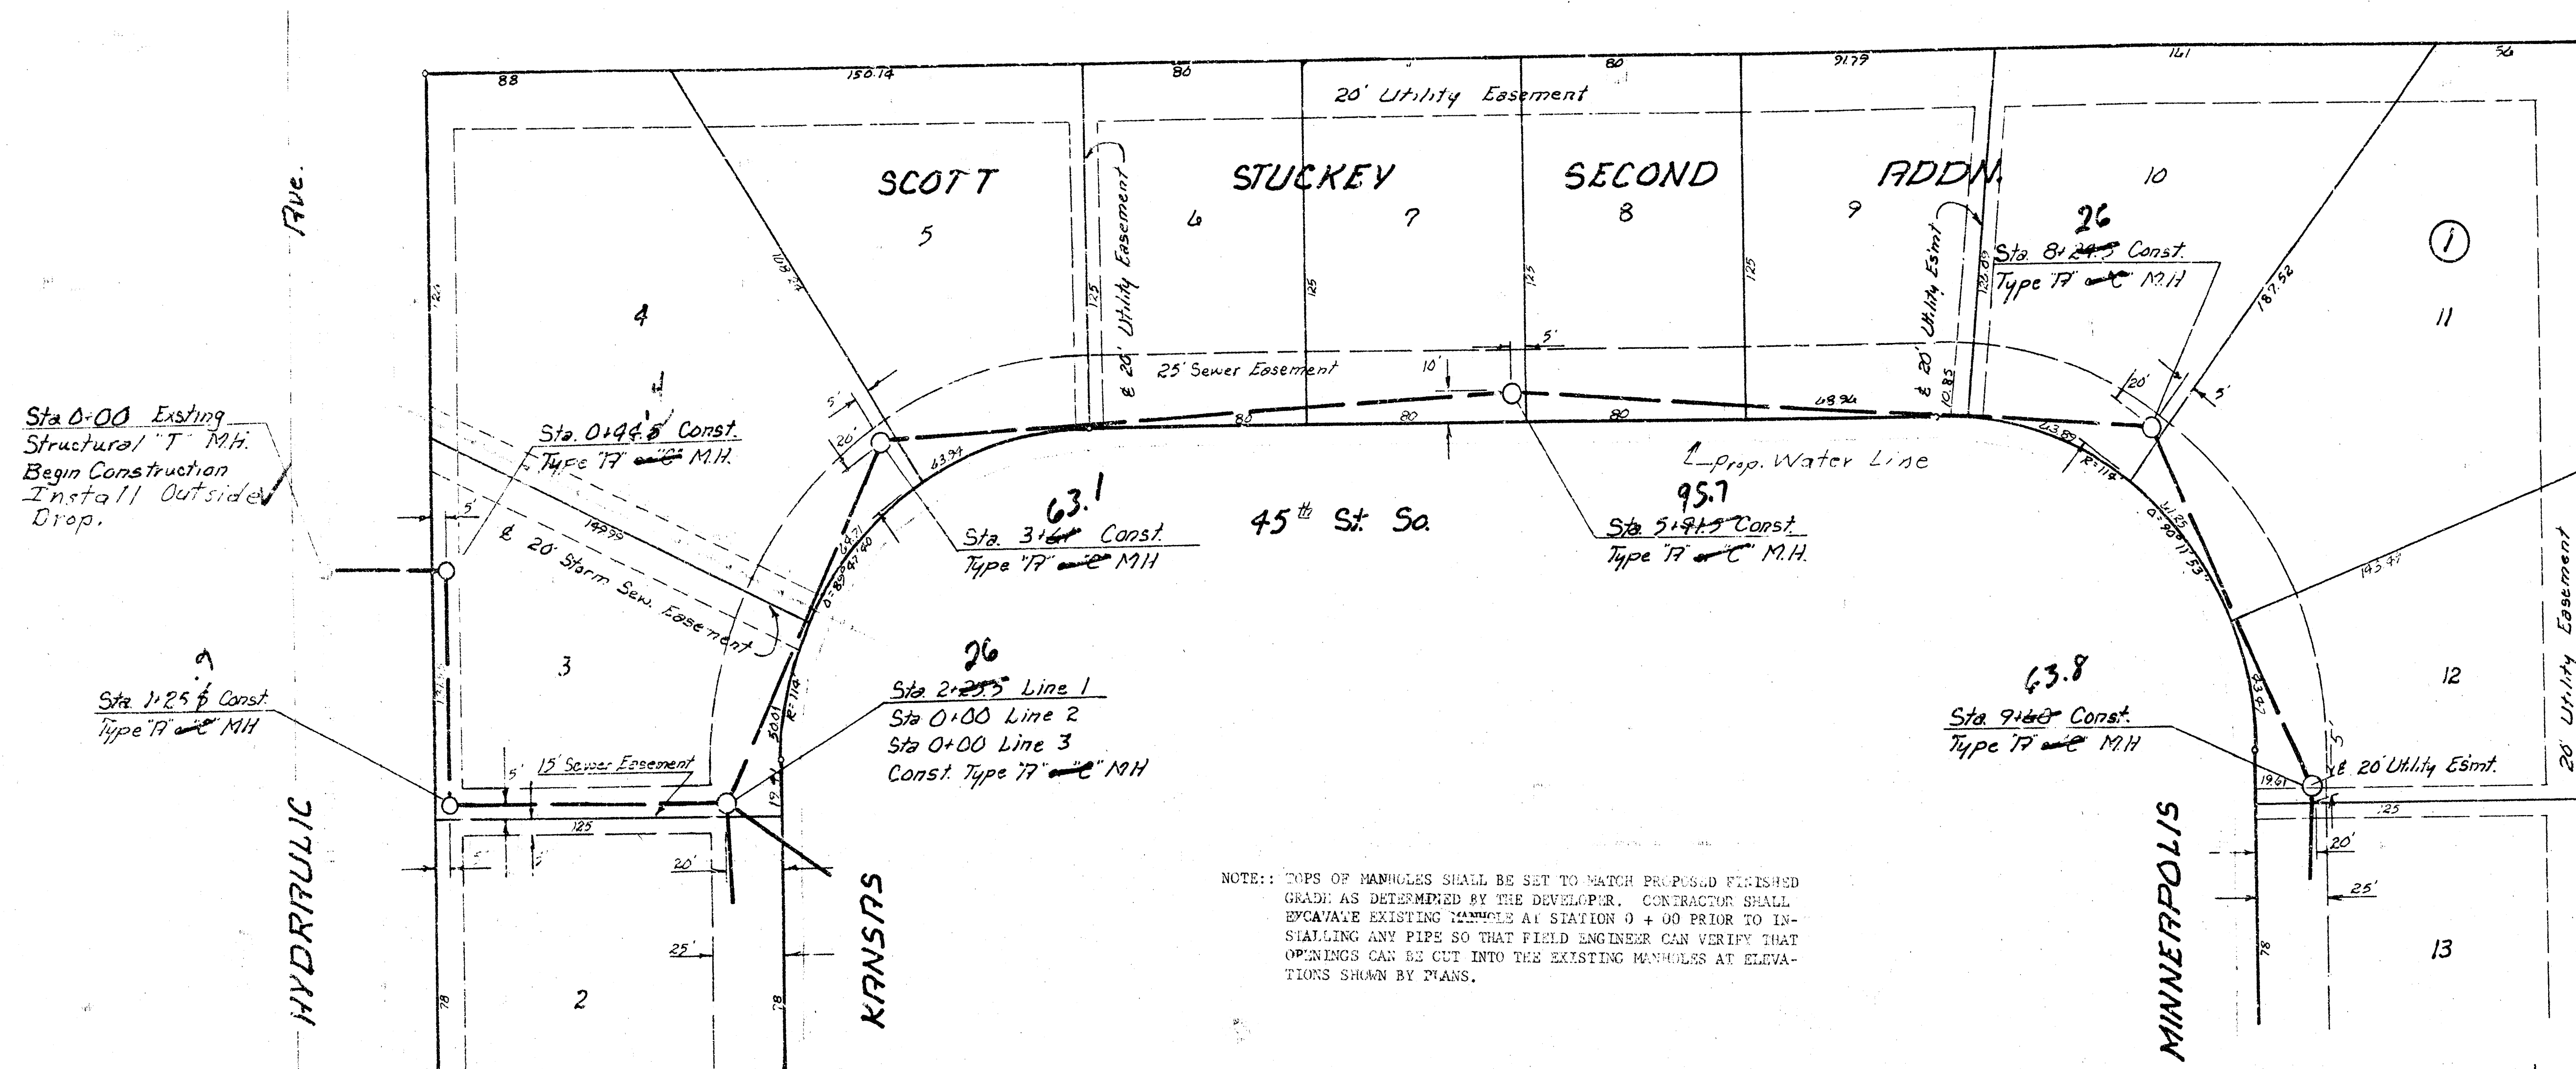


NOTE: TOPS OF MANHOLES SHALL BE SET TO MATCH PROPOSED FINISHED GRADE AS DETERMINED BY THE DEVELOPER. CONTRACTOR SHALL REEVALUATE EXISTING MANHOLES AT STATIONS 0 + 00 PRIOR TO INSTALLING ANY PIPE SO THAT FIELD ENGINEER CAN VERIFY THAT OPENINGS CAN BE CUT INTO THE EXISTING MANHOLES AT ELEVATIONS SHOWN BY PLANS.

SCALE


PLAN 1" = 40'
 PROFILE 1" = 40'
 Horiz. 1" = 40'
 Vert. 1" = 5'

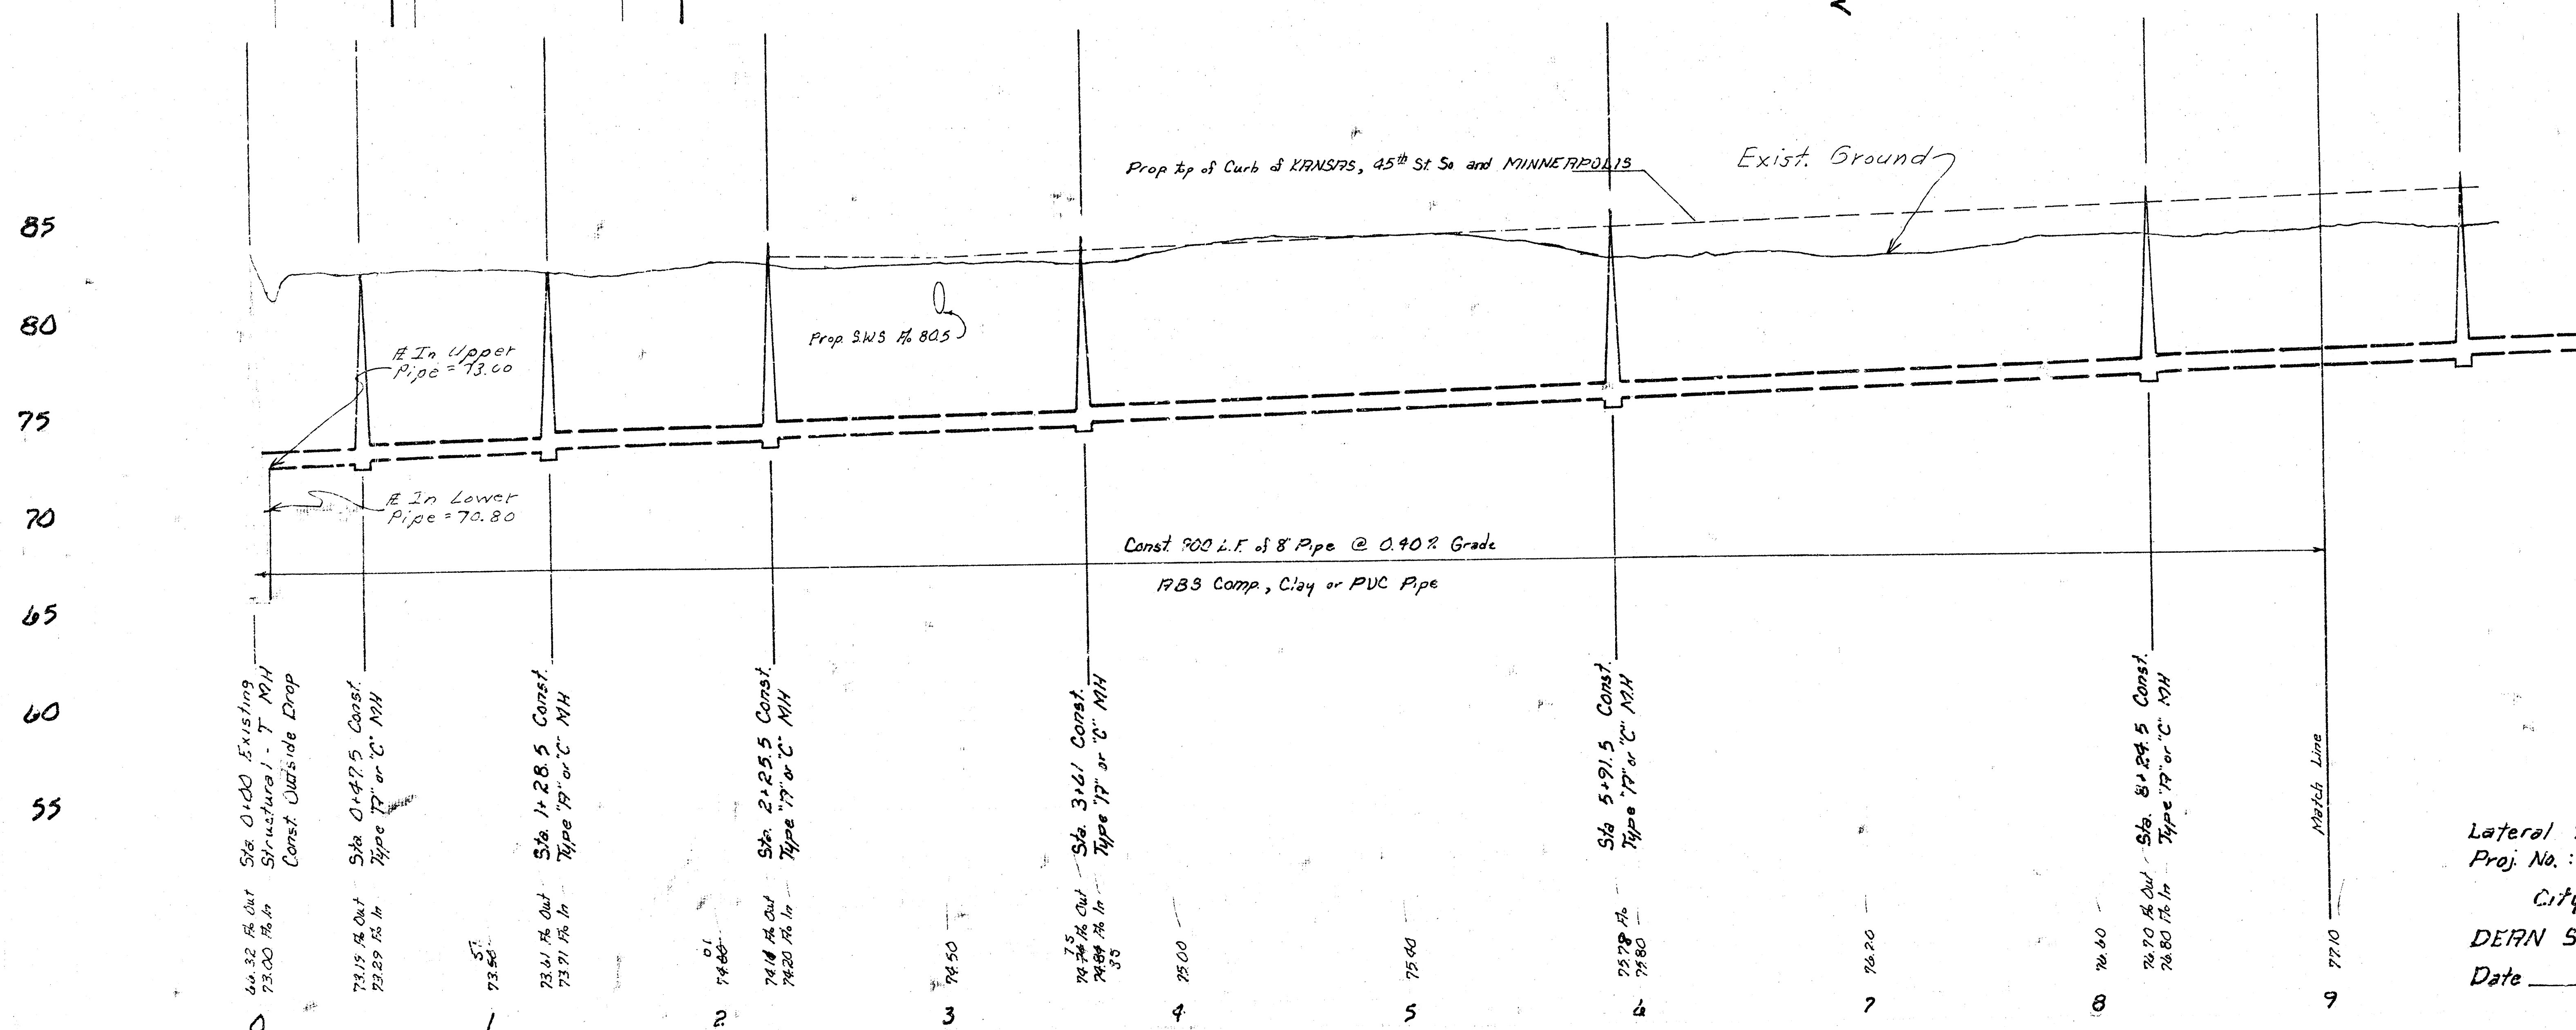


As Built
 11/8/1
 188

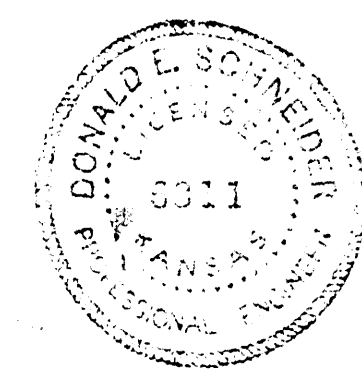


Lateral 57, Main 1, Southwest Interceptor Sewer
 Proj. No.: 448-76-245-80901-000-000-001
 City of WICHITA, KANSAS
 DERN SELLERS - Acting CITY ENGINEER
 Date _____

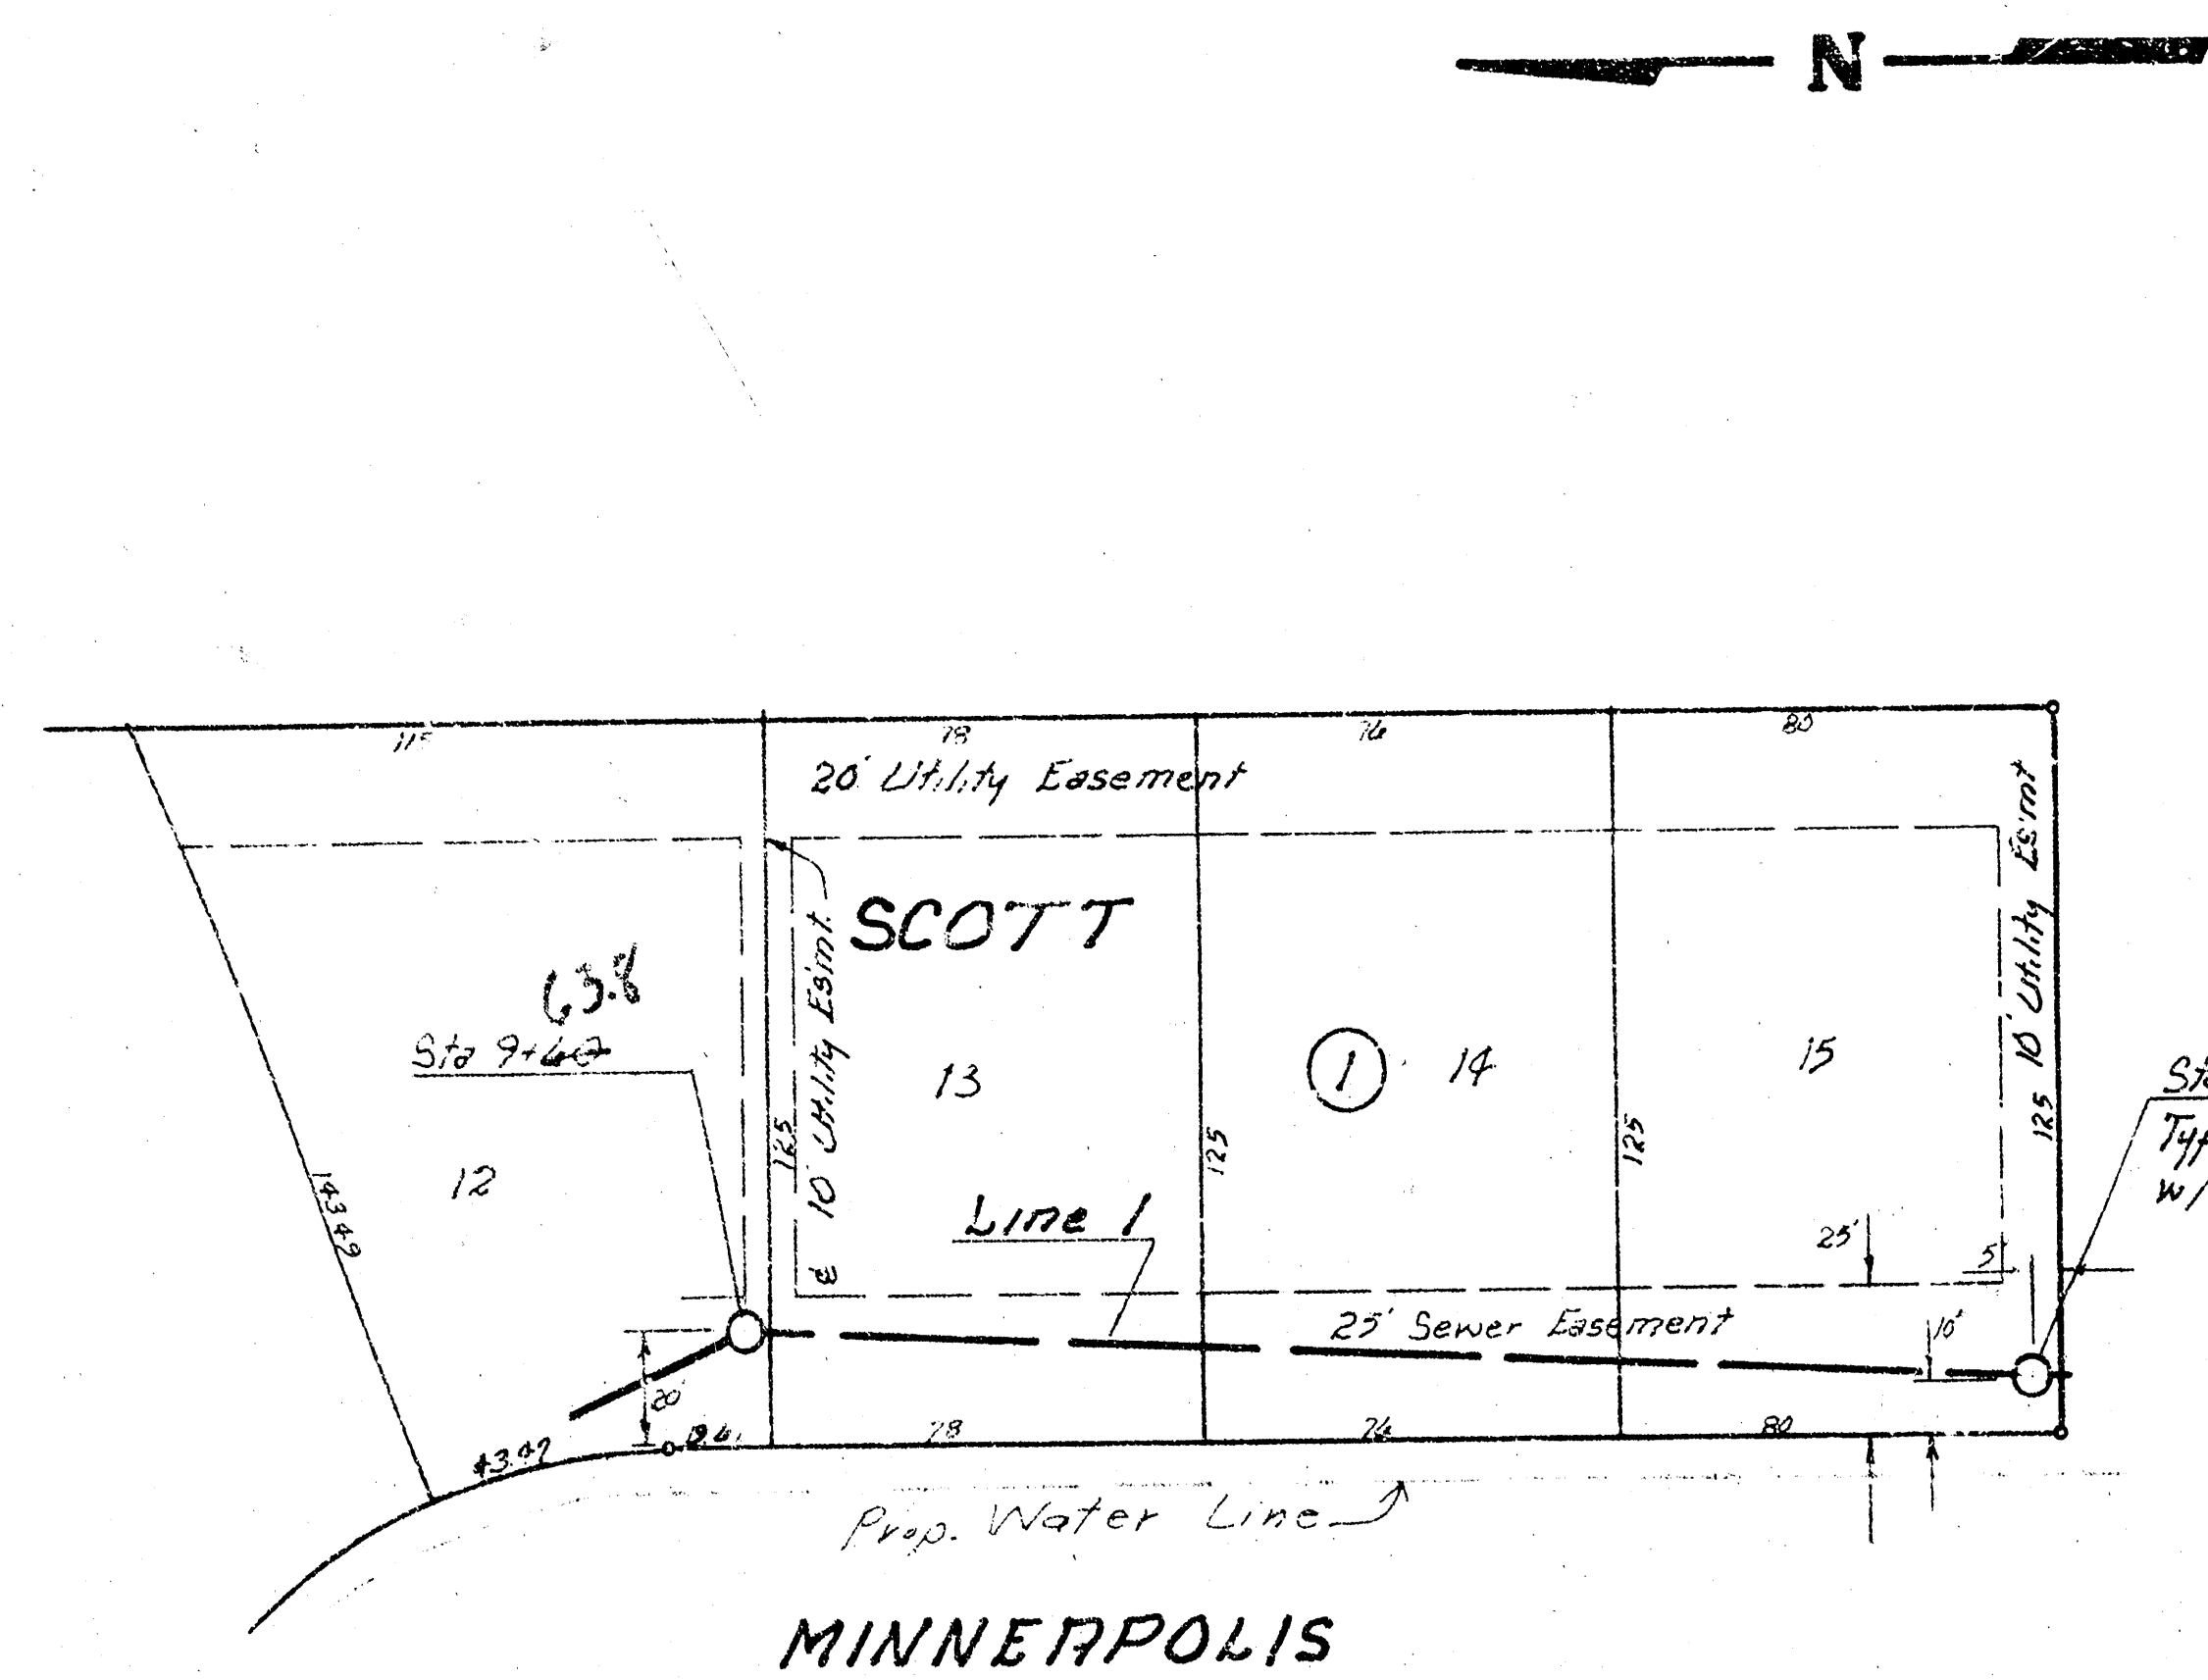

96.3
Sta 11+94 Const.
Type 'R' or 'C' M.H.
w/ 8" Stubs S.

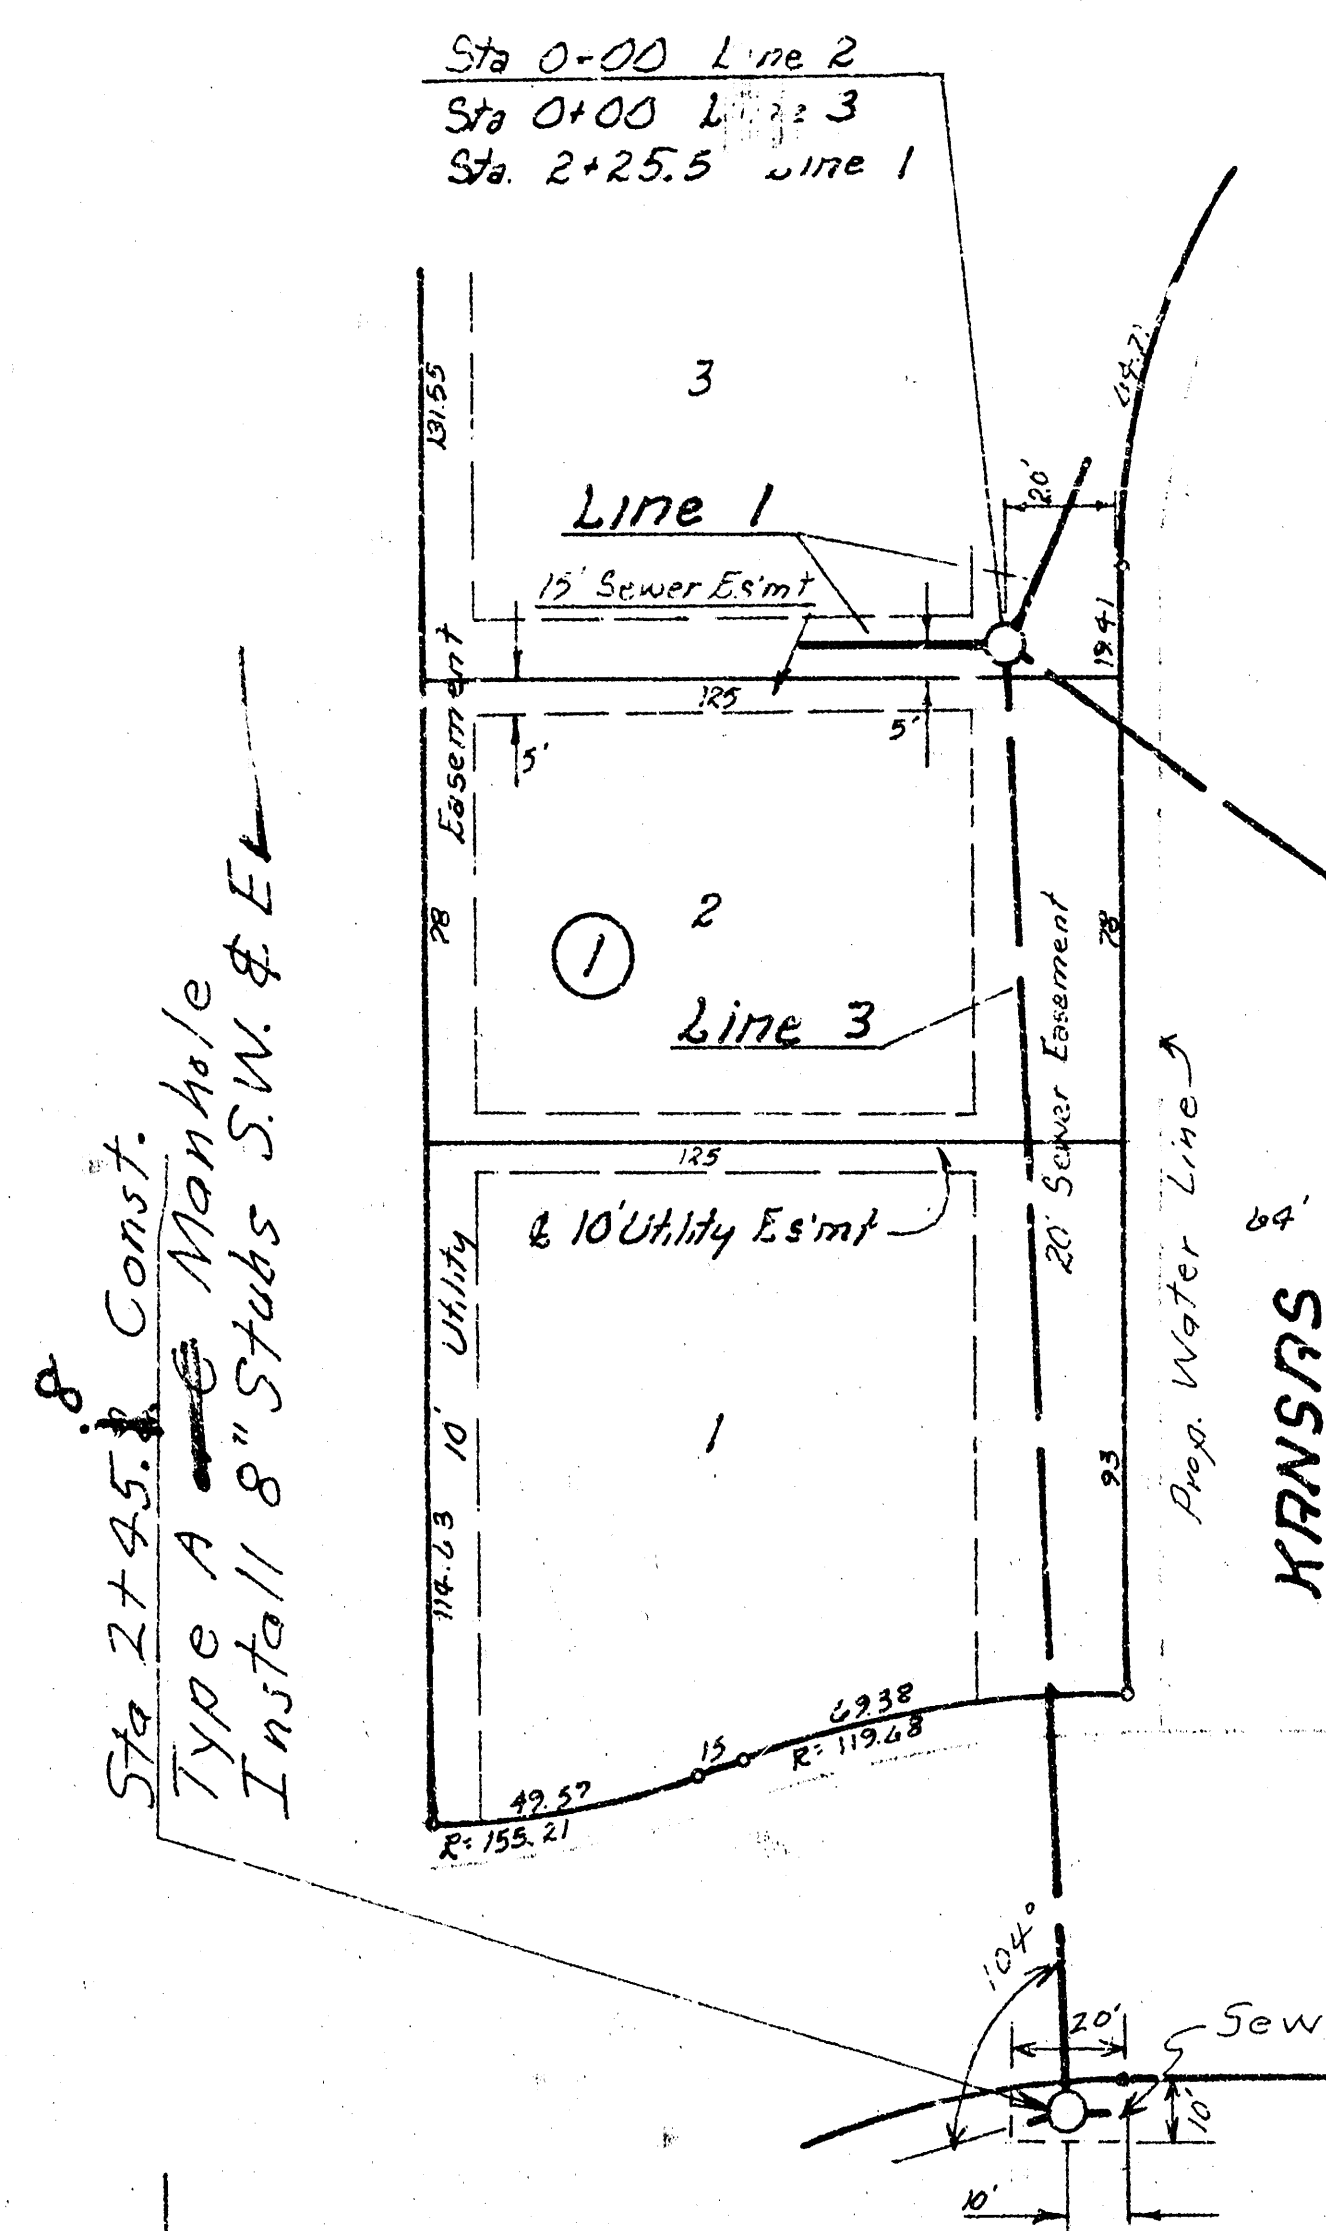




Sta 2+45.8 Const.
Type 'A' Manhole
Install 8" Stubs SW & E

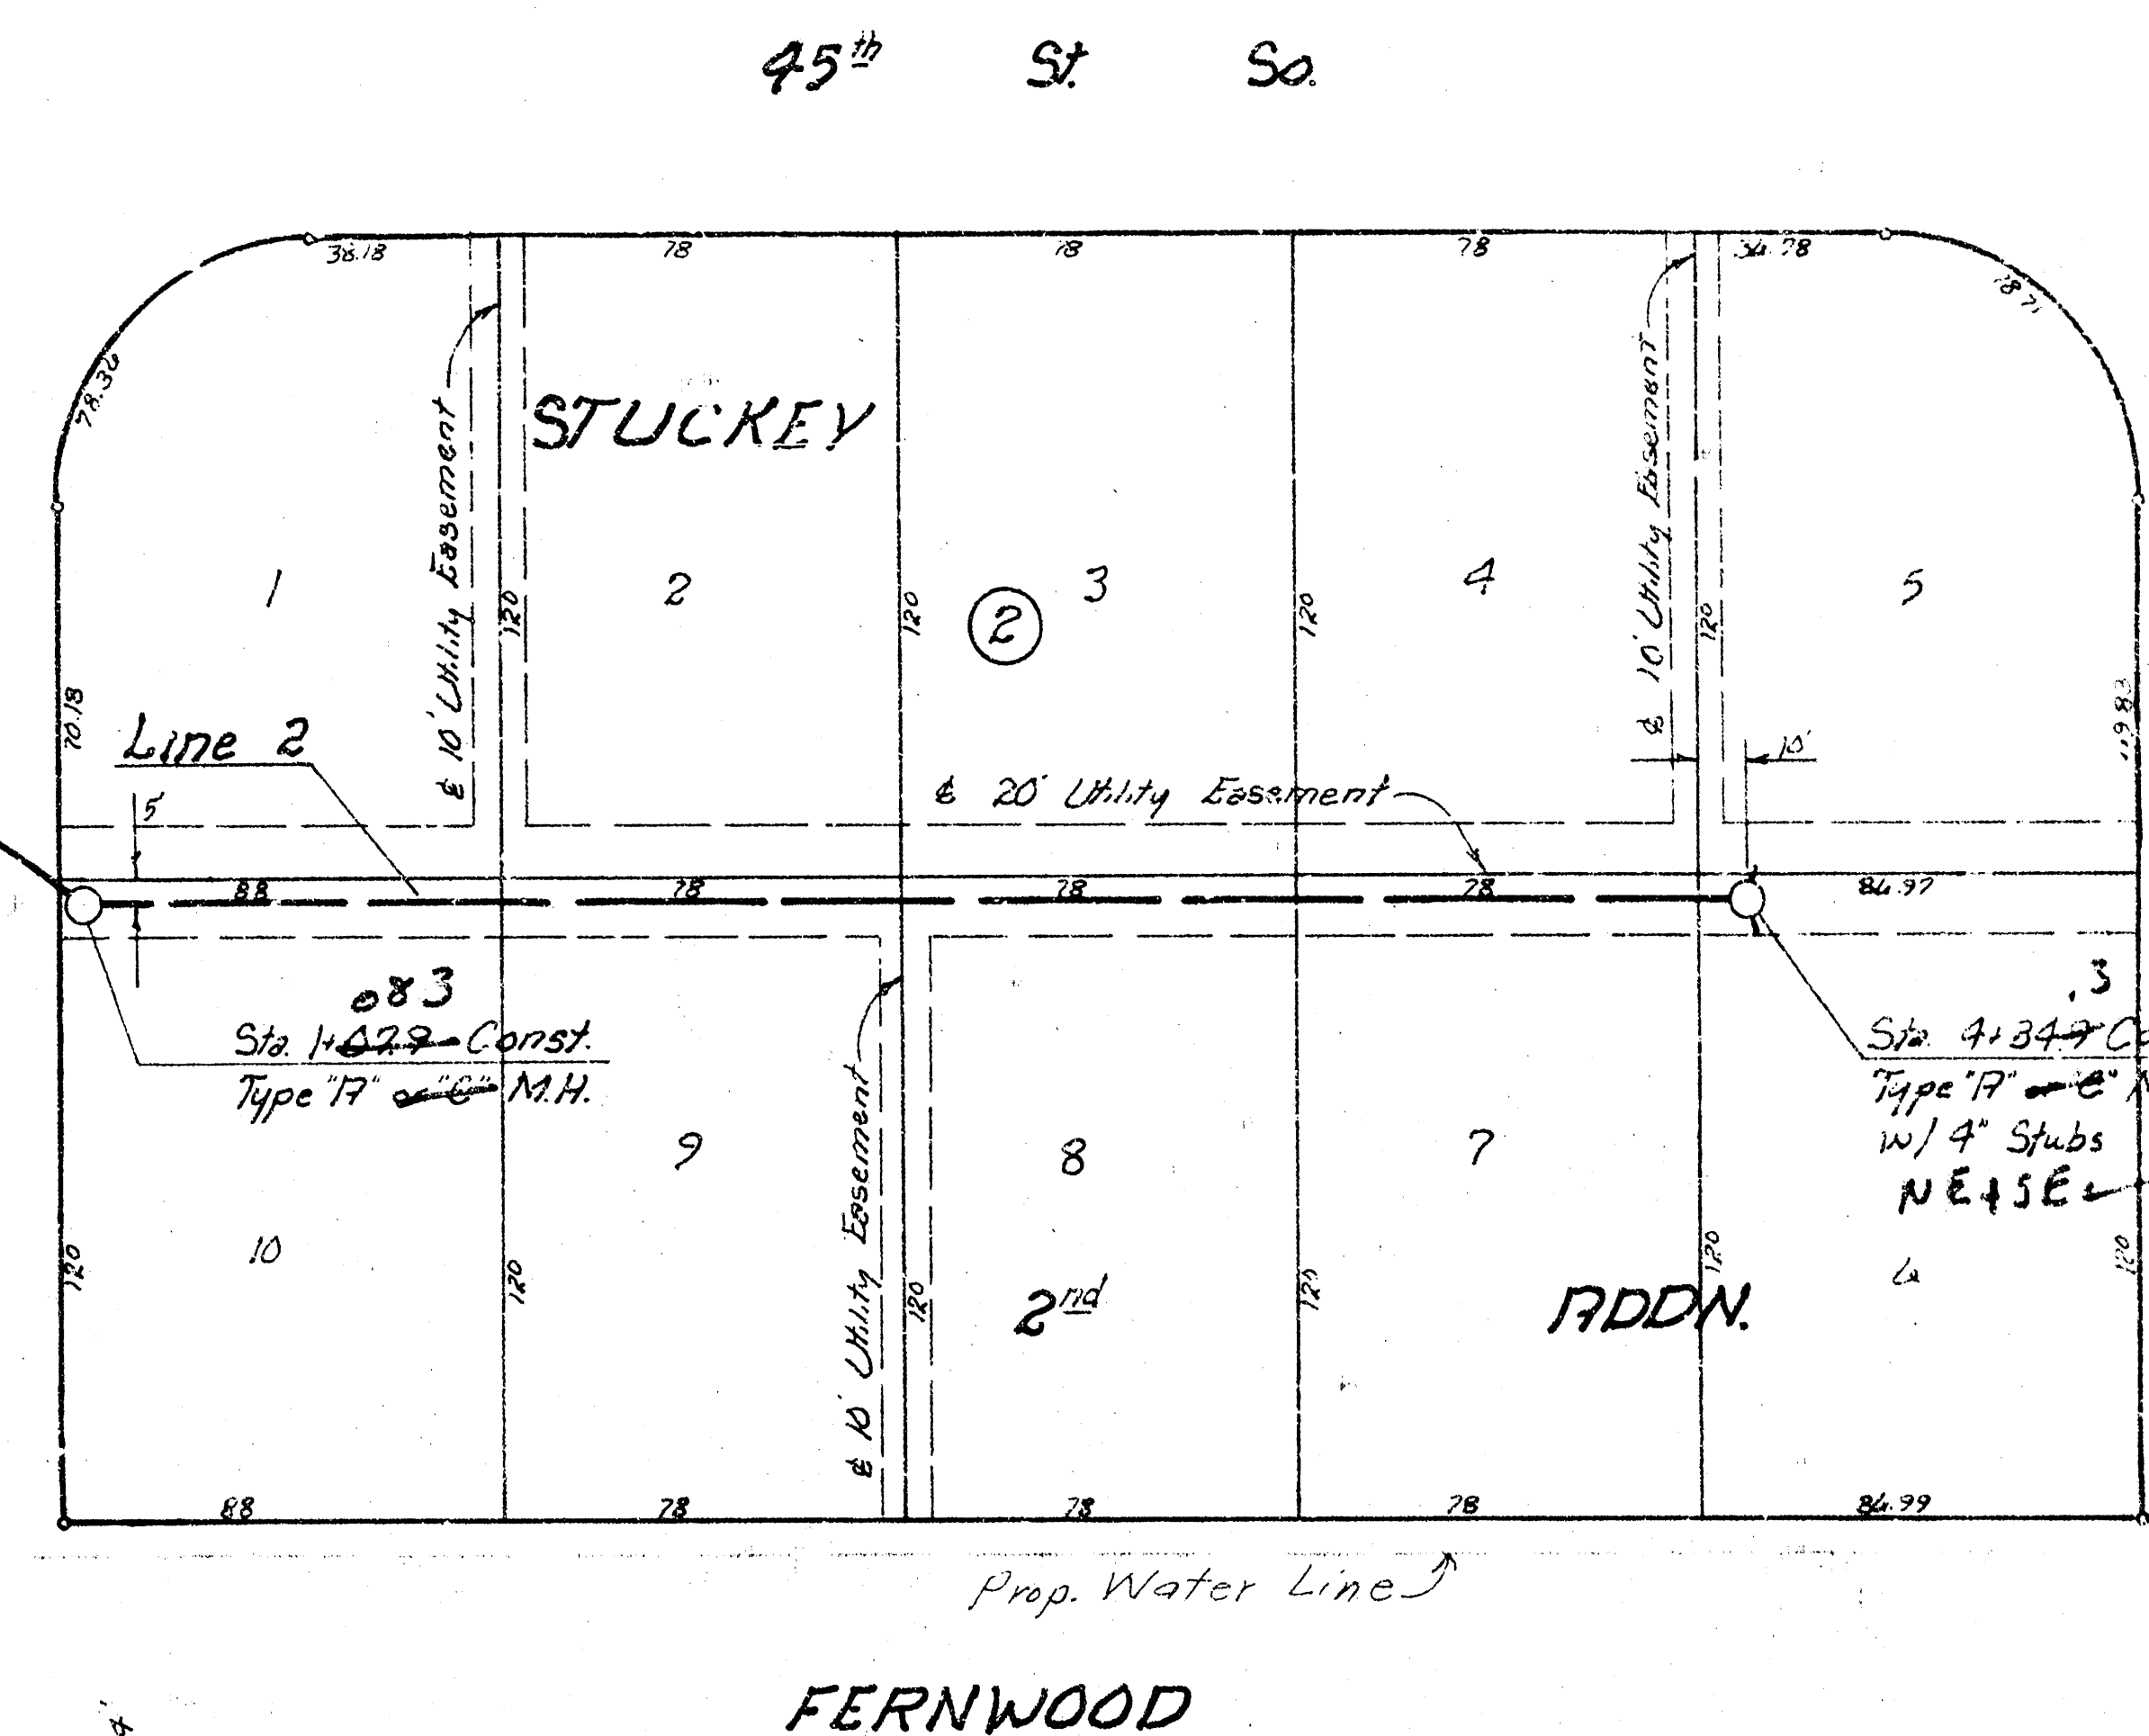

Sta 1+62.2 Const.
Type 'R' or 'C' M.H.
w/ 8" Stubs NE & SE

SCALE

Plan 1" = 40'
Profile 1" = 40'
Horz. 1" = 40'
Vert. 1" = 5'

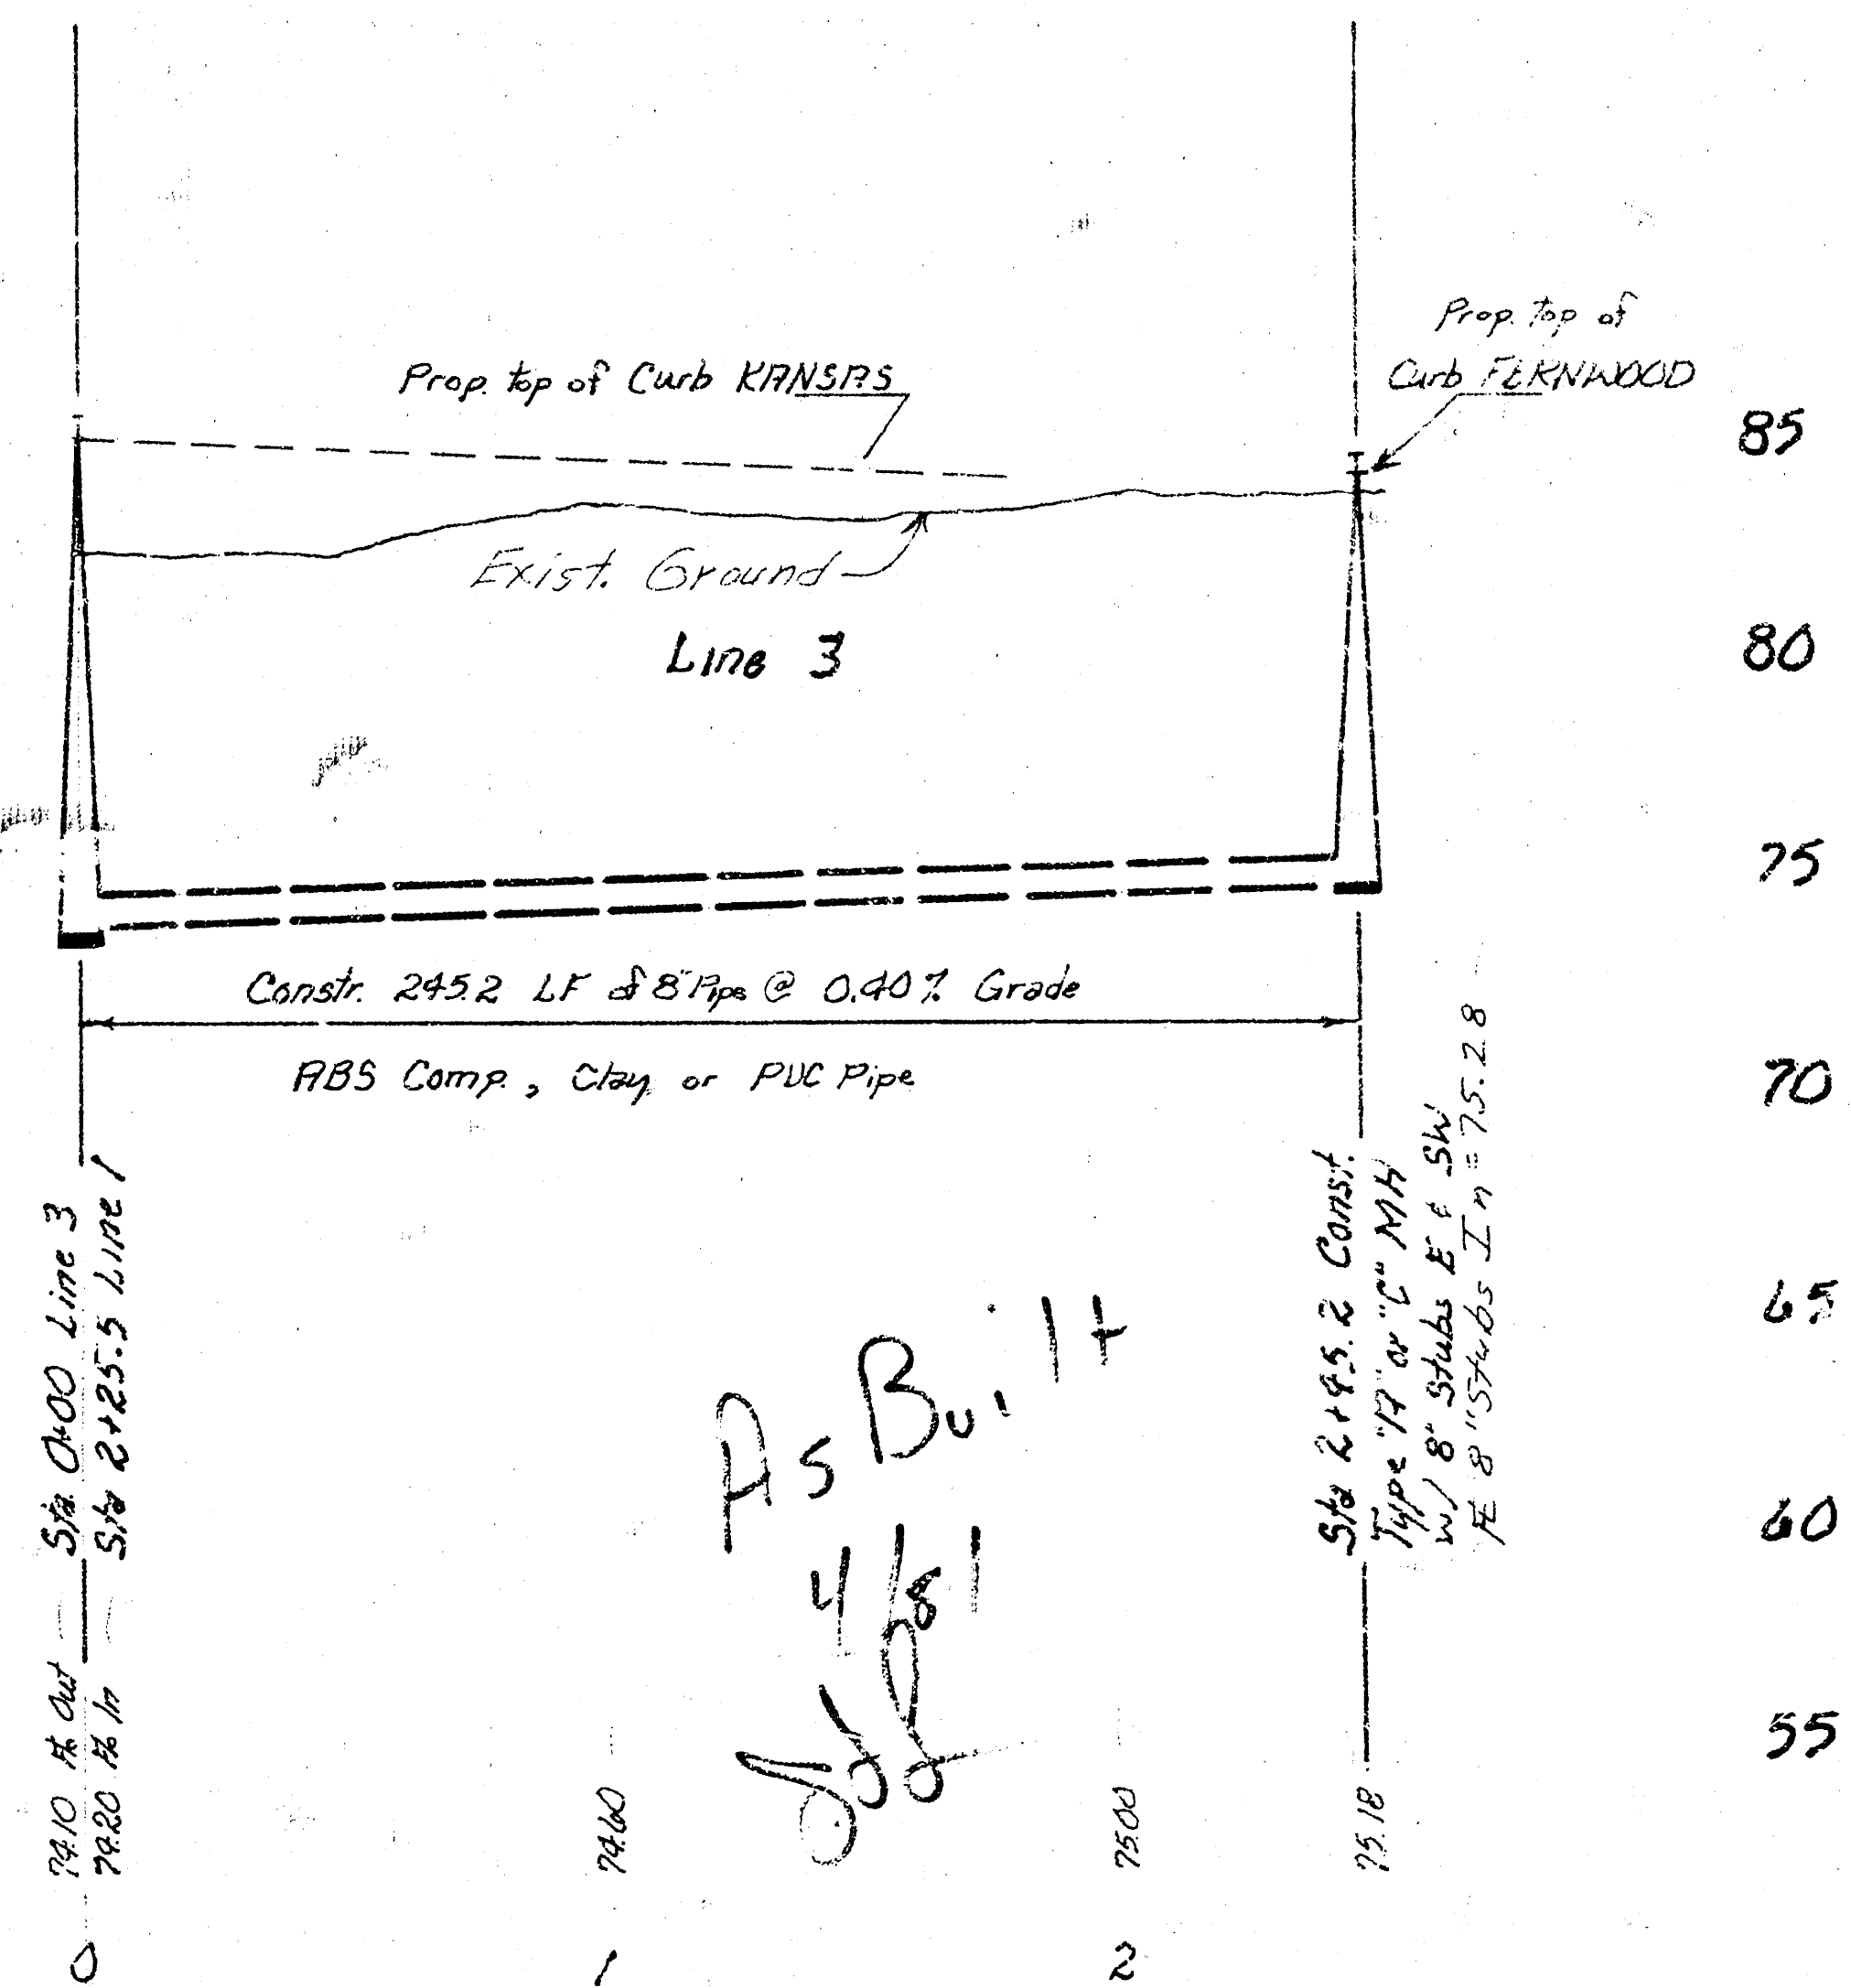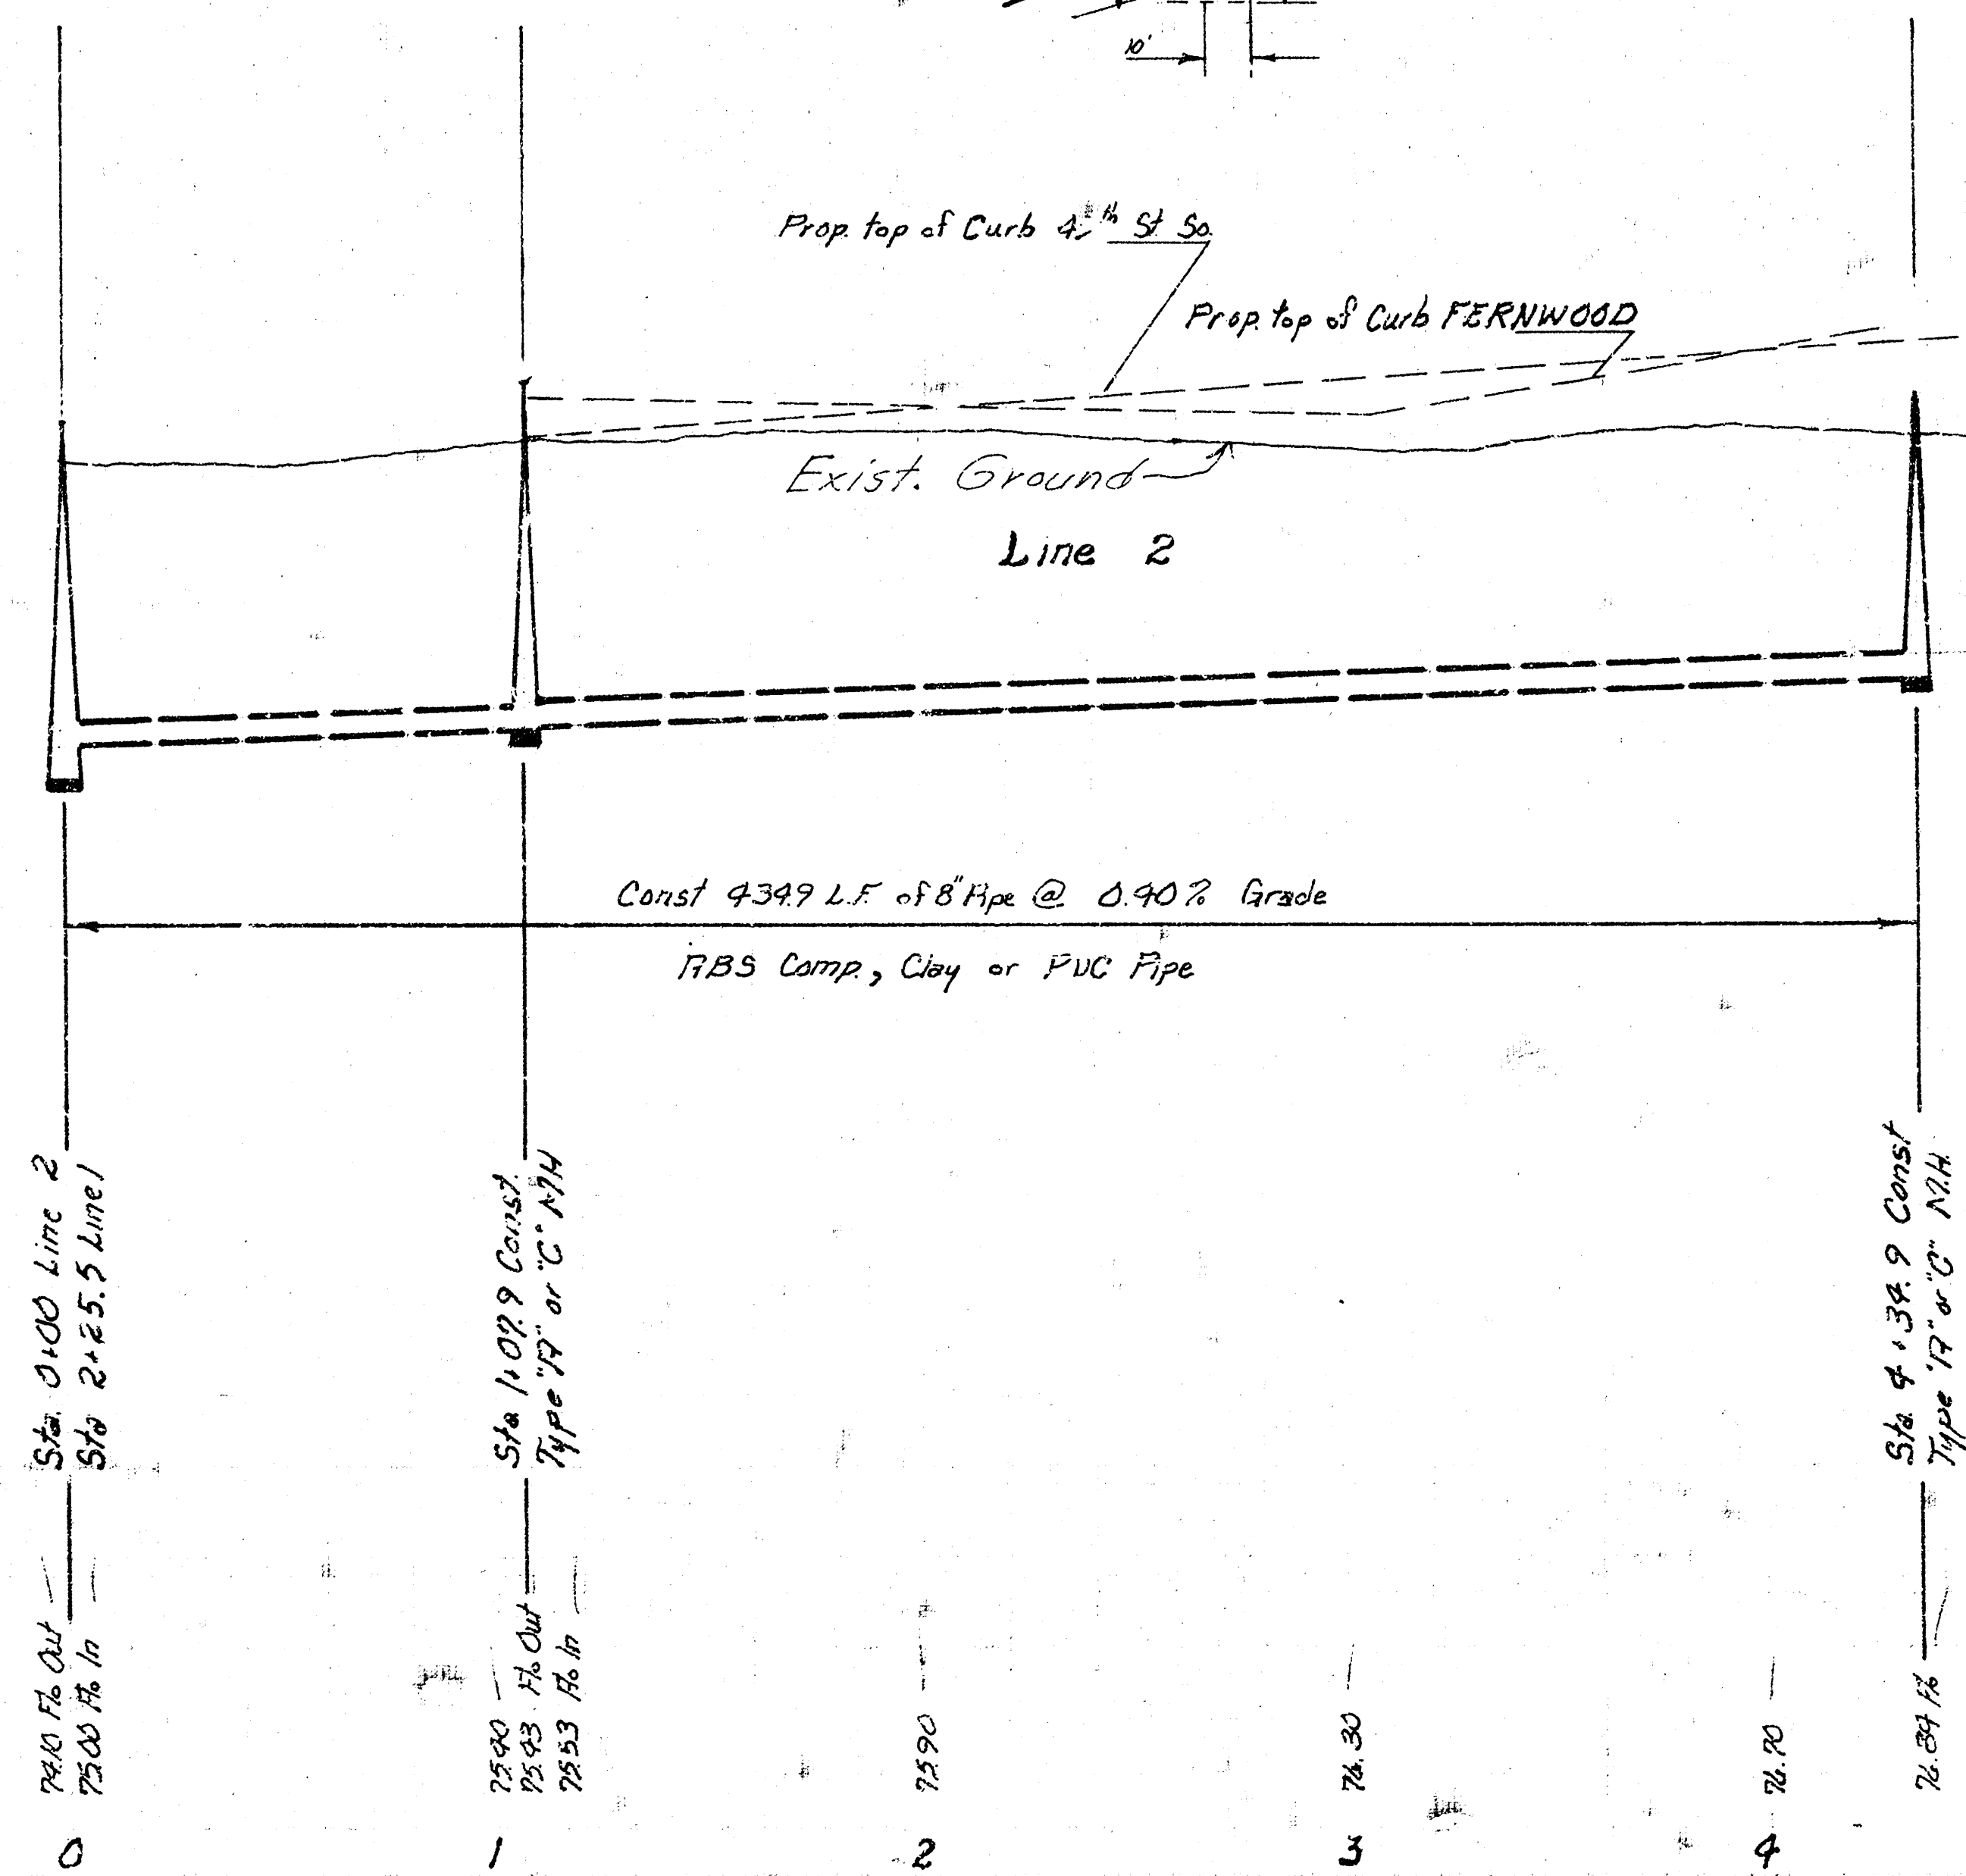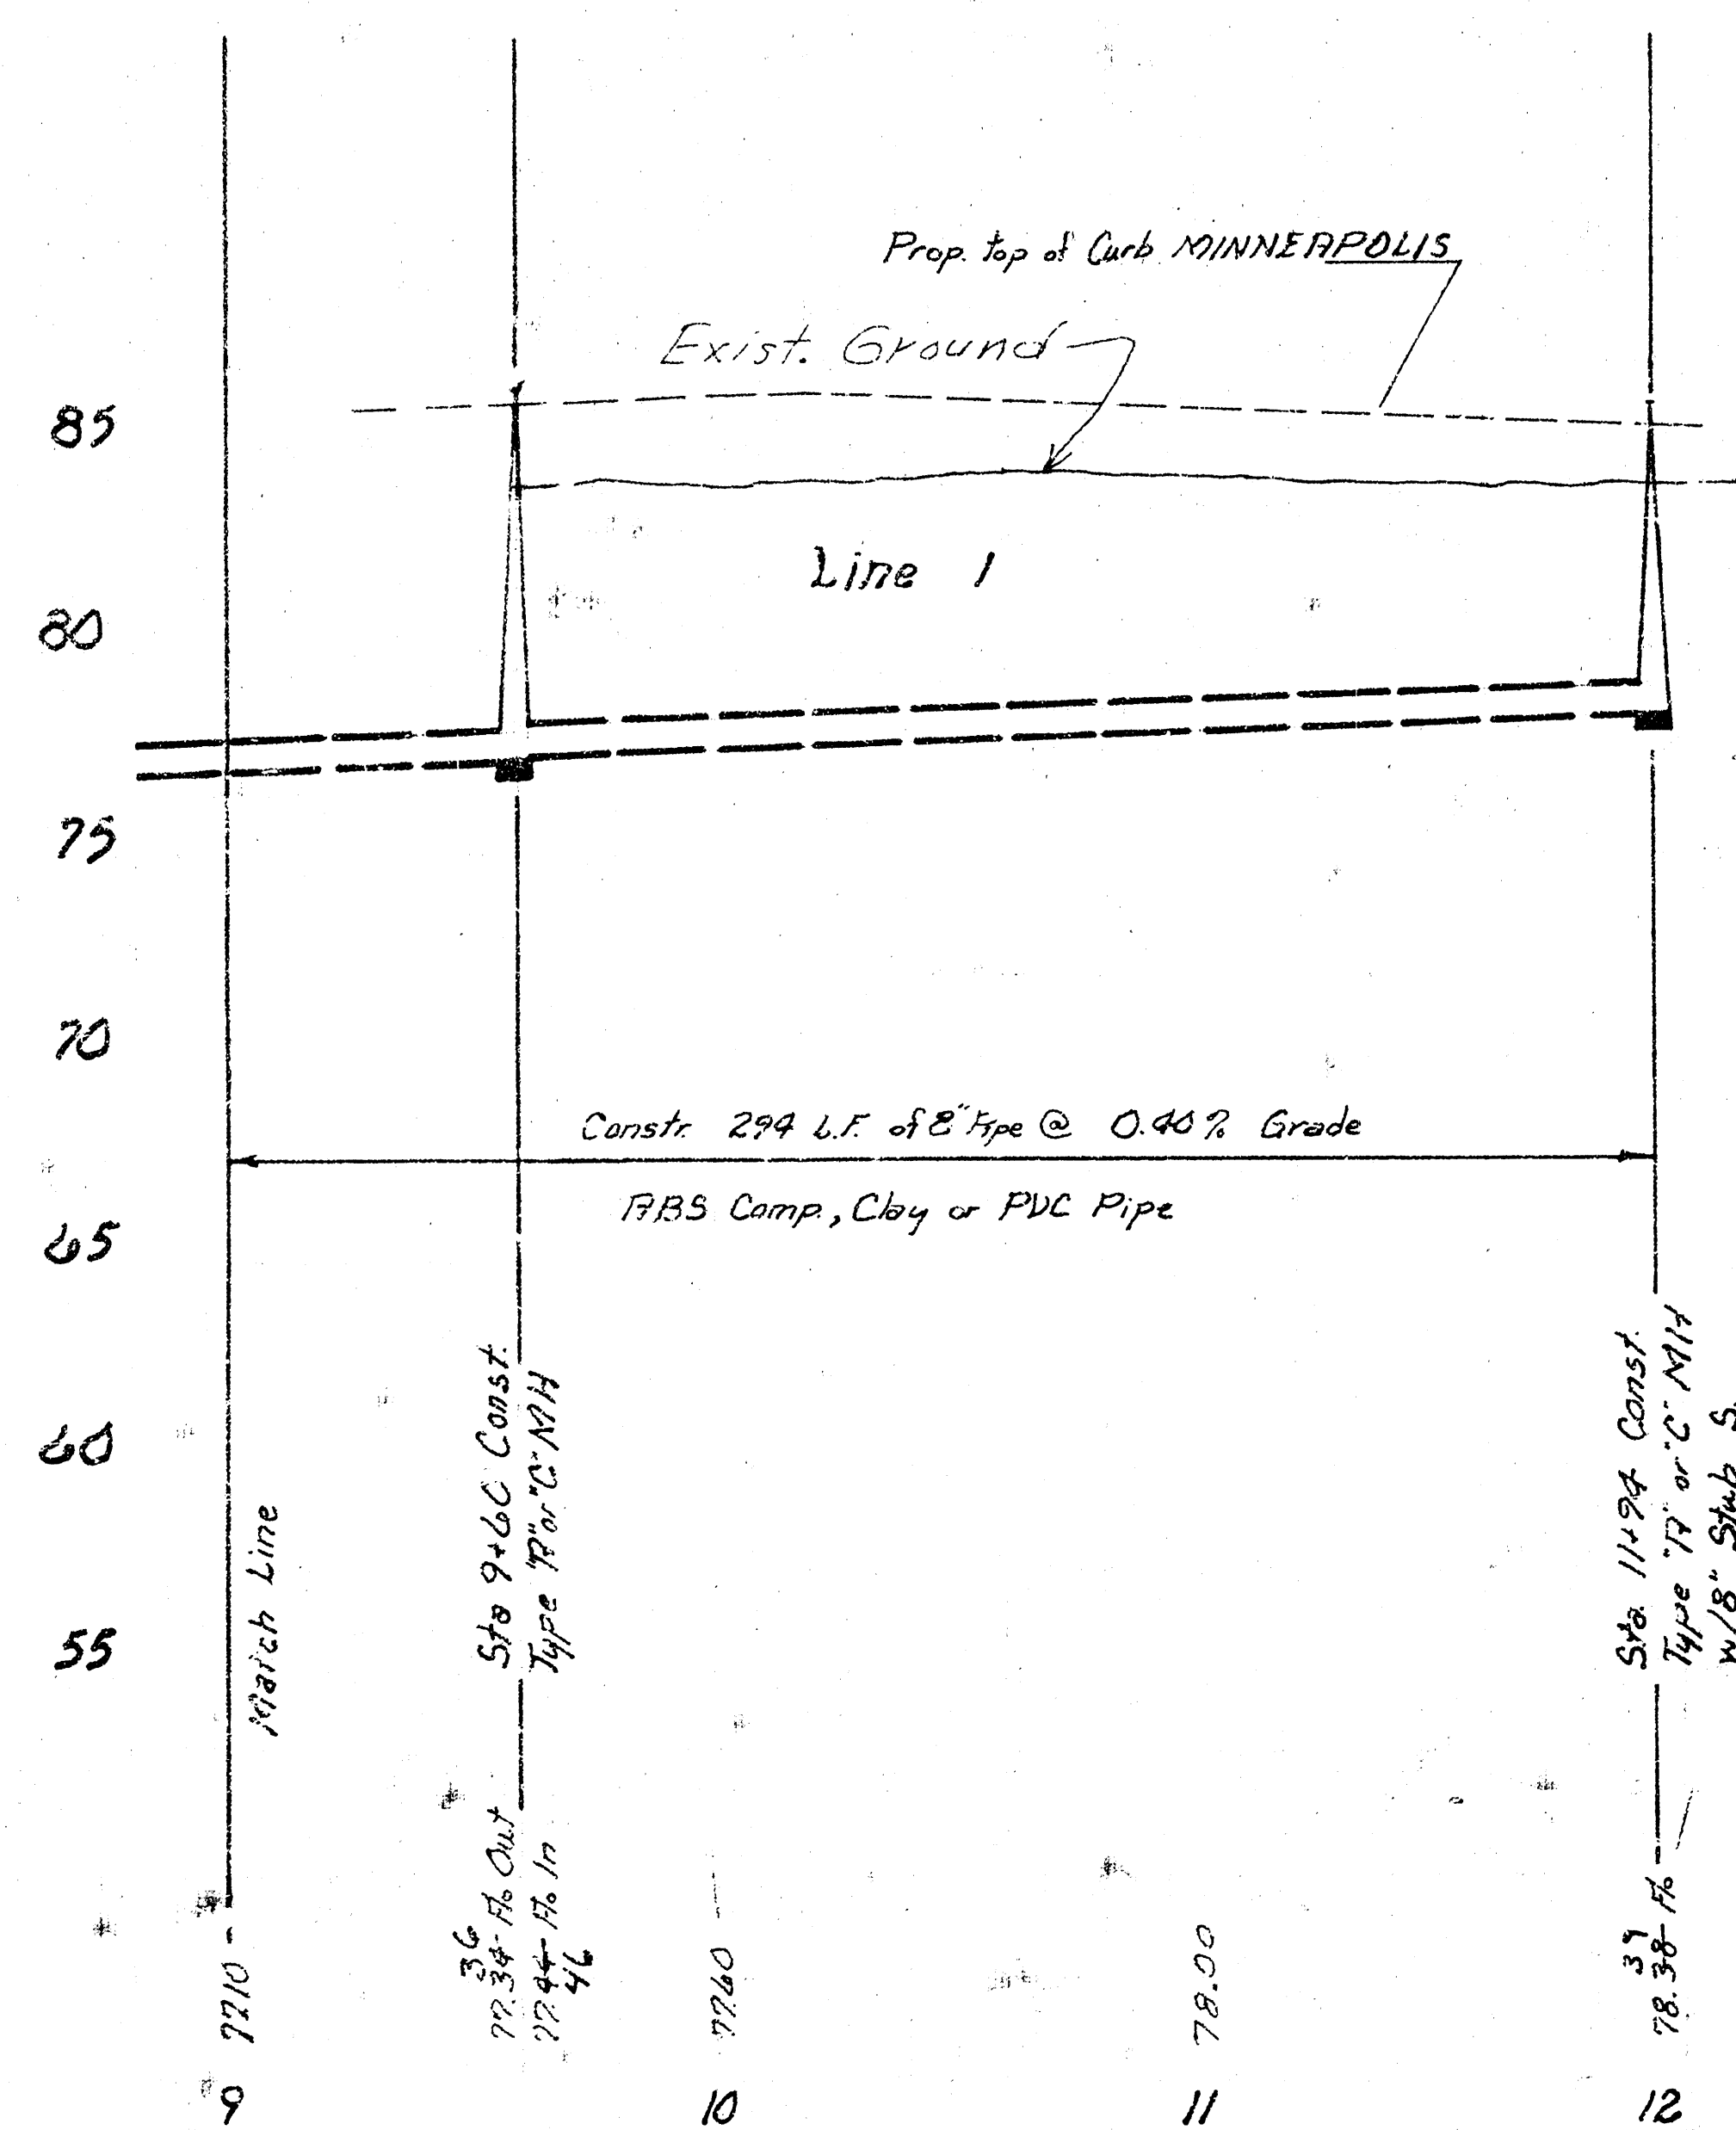

As Built
4/16/11
JSS

Lateral 57, Main 1, Southwest Interceptor Sewer
Proj. No: 448-24-245-80901-000-000-001

