




Scale:
1" = 40' Plan
1/8" = 40' Horiz. Profile
1" = 5' Vert.

Bench Marks: 56.195 - 62" Nail on N. Face of Power Pole, W. R. Ellis and 190 ± N. of & Alt. A.
Establish: 87.92 - 109.4 W. of & Ellis, N. Side of MacArthur Rd. 3 R.R. Spk. on N. Face. R.G. & E. Power Pole.


CAUTION
UNDERGROUND UTILITIES
Please check with K.C. & E. or Southwestern Bell Telephone Co. for Location

THE CONTRACTOR SHALL BE RESPONSIBLE FOR PRESERVING PROPERTY IRONS. THE CONTRACTOR SHALL BE REQUIRED TO RE-INSTALL ANY PROPERTY IRONS WHICH ARE DAMAGED OR DESTROYED BY HIS CONSTRUCTION OPERATIONS. SUCH IRONS SHALL BE RE-INSTALLED BY A LICENSED LAND SURVEYOR OR A LICENSED PROFESSIONAL ENGINEER IN ACCORDANCE WITH STATE LAWS.



SOUTH FIELD ADDITION

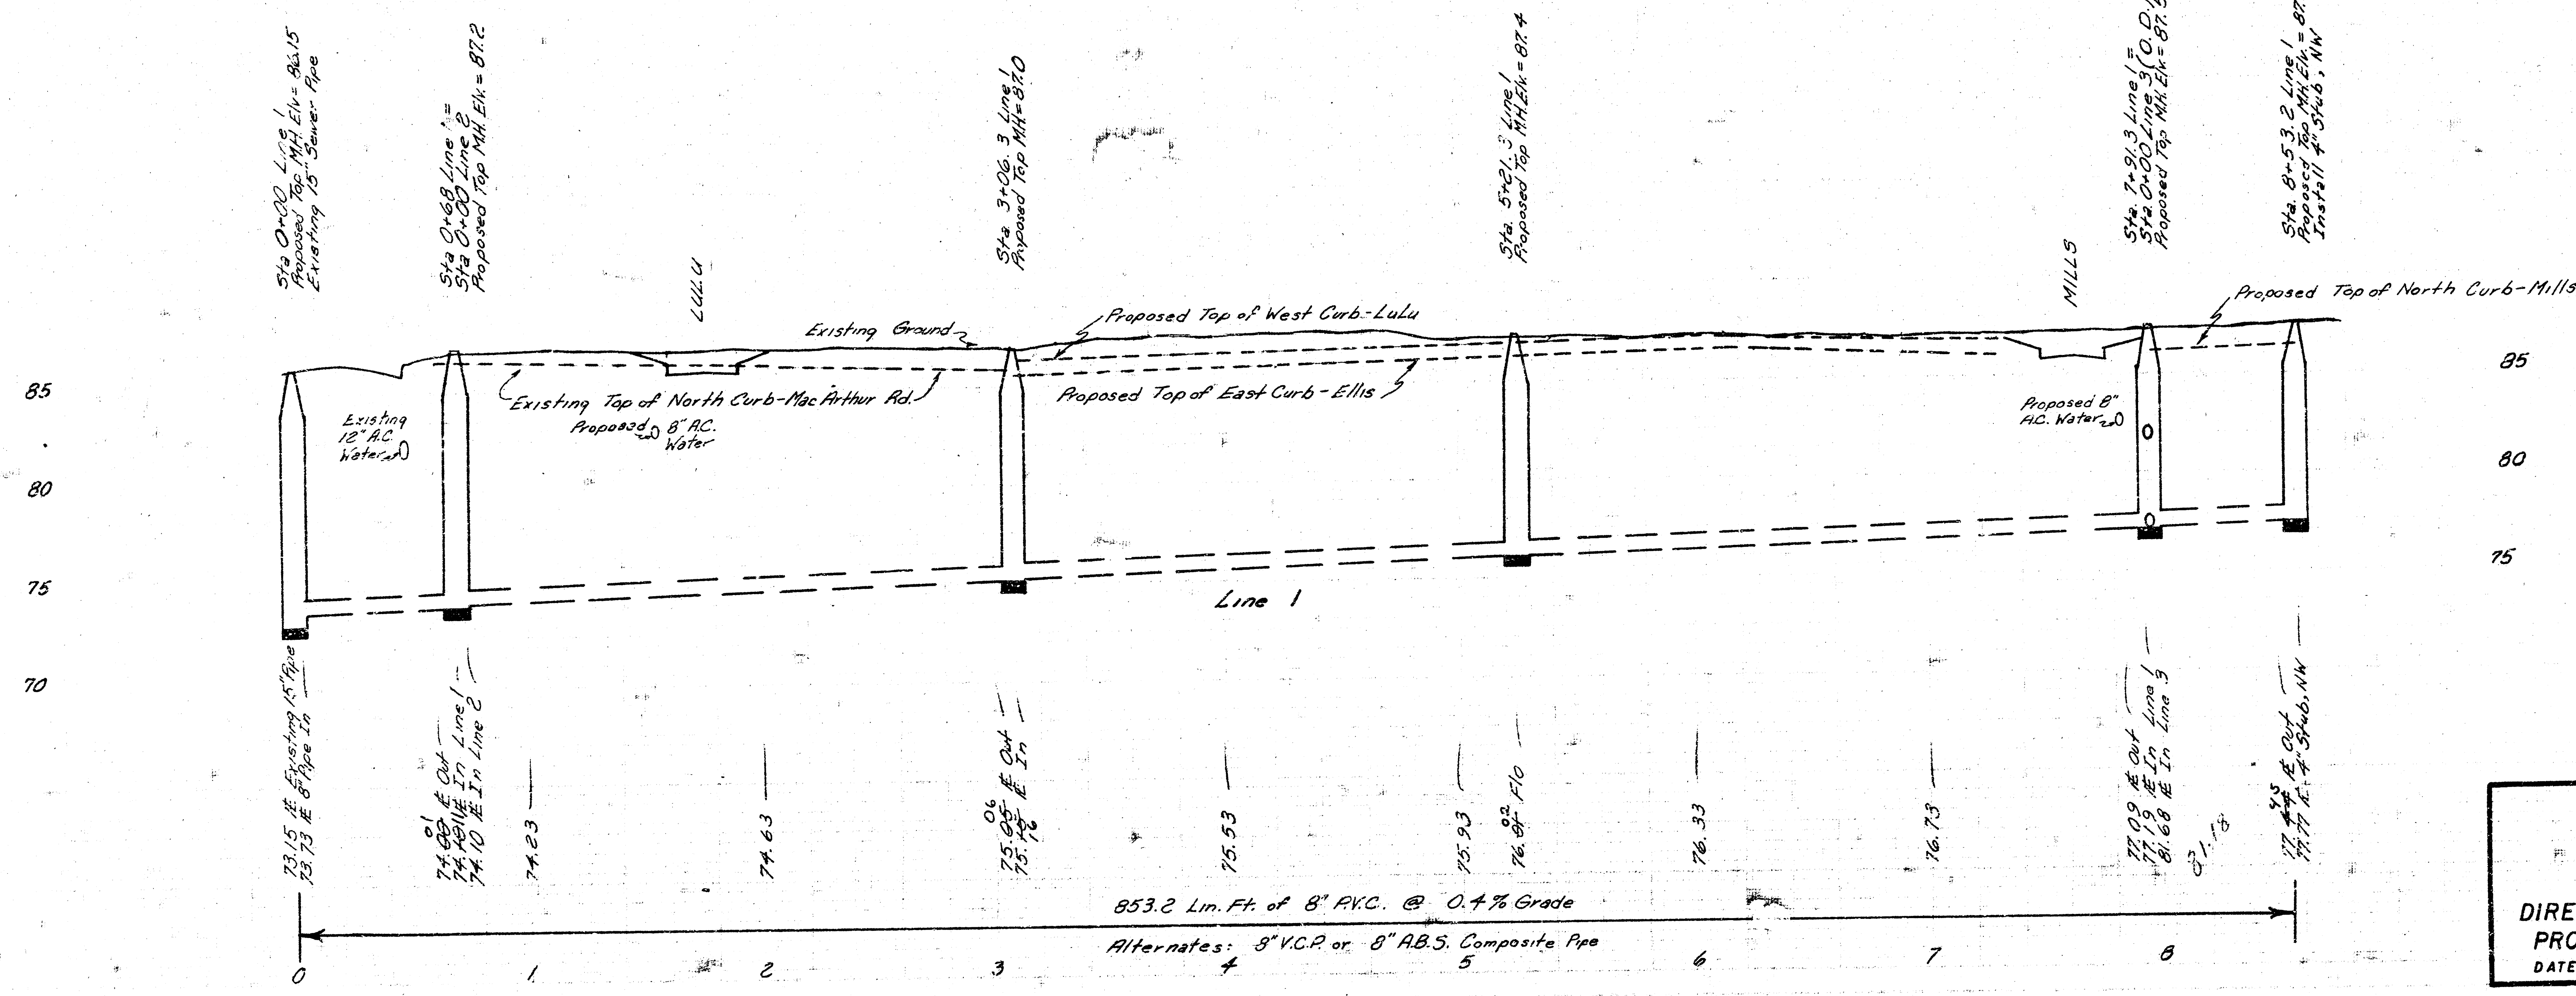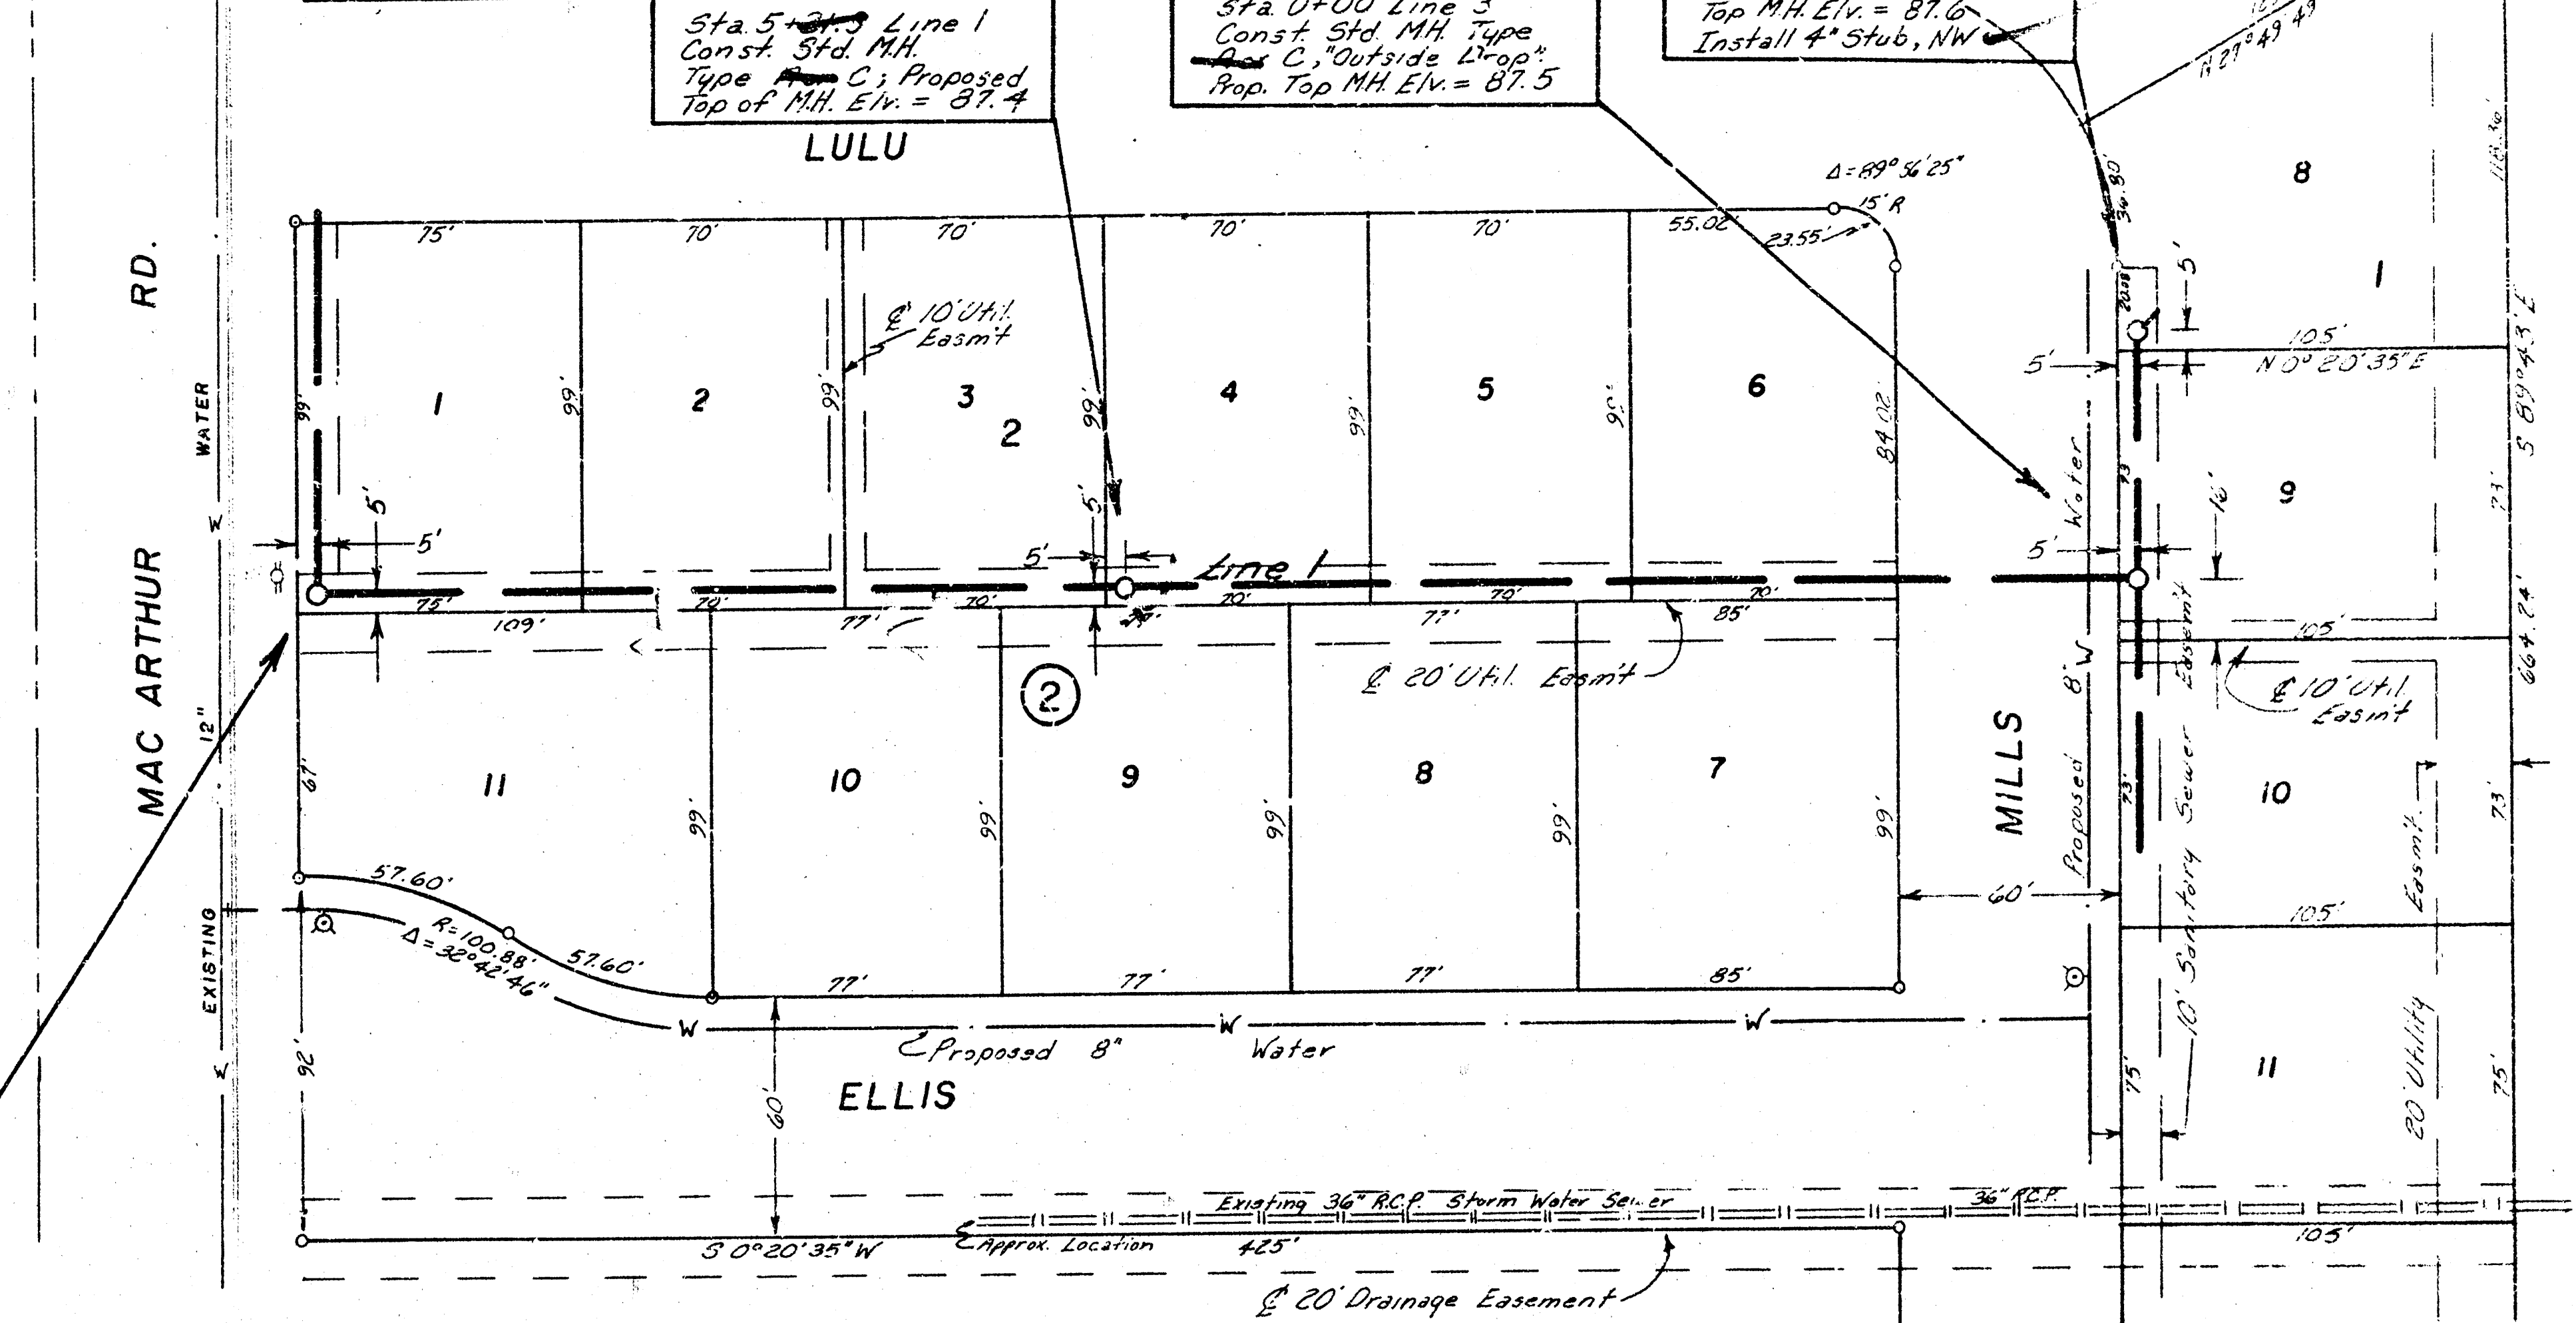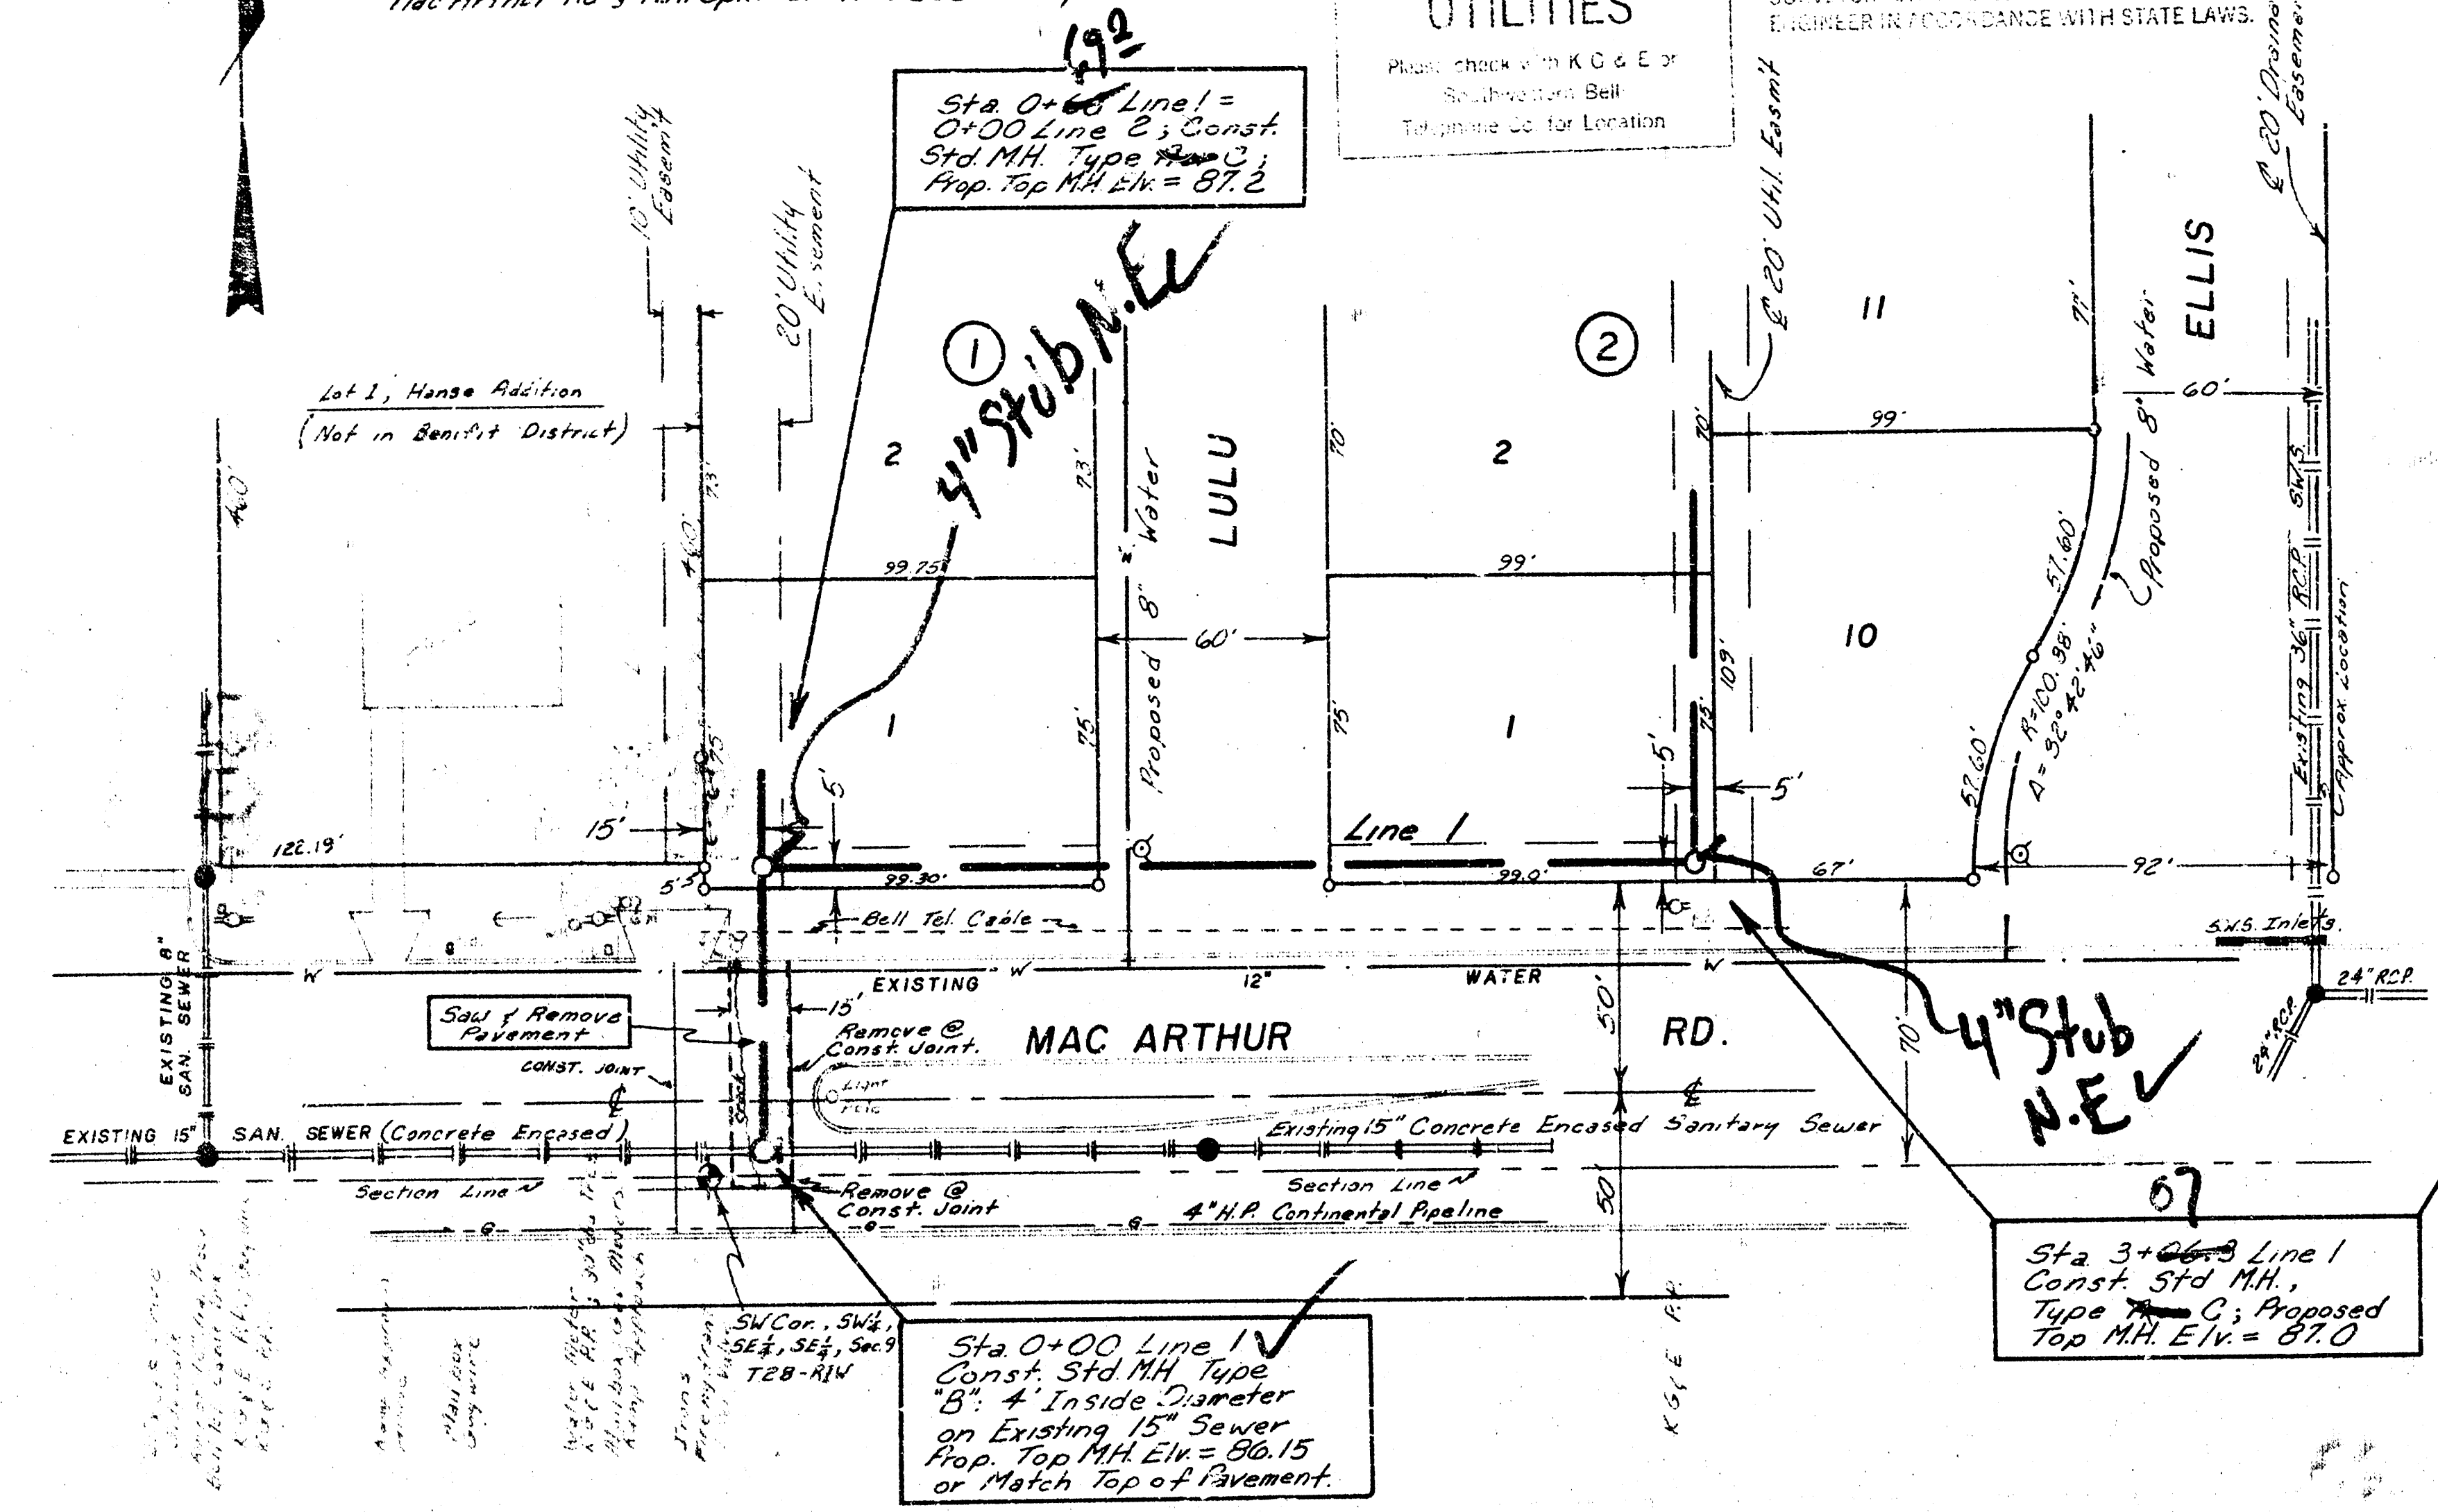



Handwritten signature and date: 12/81

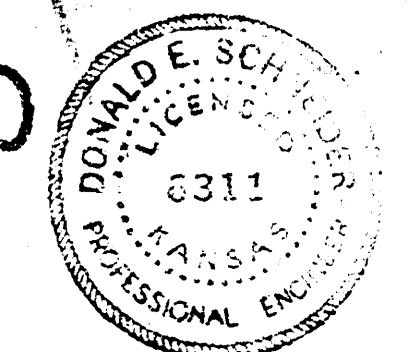

LAT. 62, MAIN 1, S.W.I.
CITY OF WICHITA, KANSAS
R. W. BRUGGEMAN
DIRECTOR OF ENGINEERING / CITY ENGINEER
PROJ. NO. 46876-245-81121-000-000-001
DATE _____ SHEET 1 of 2

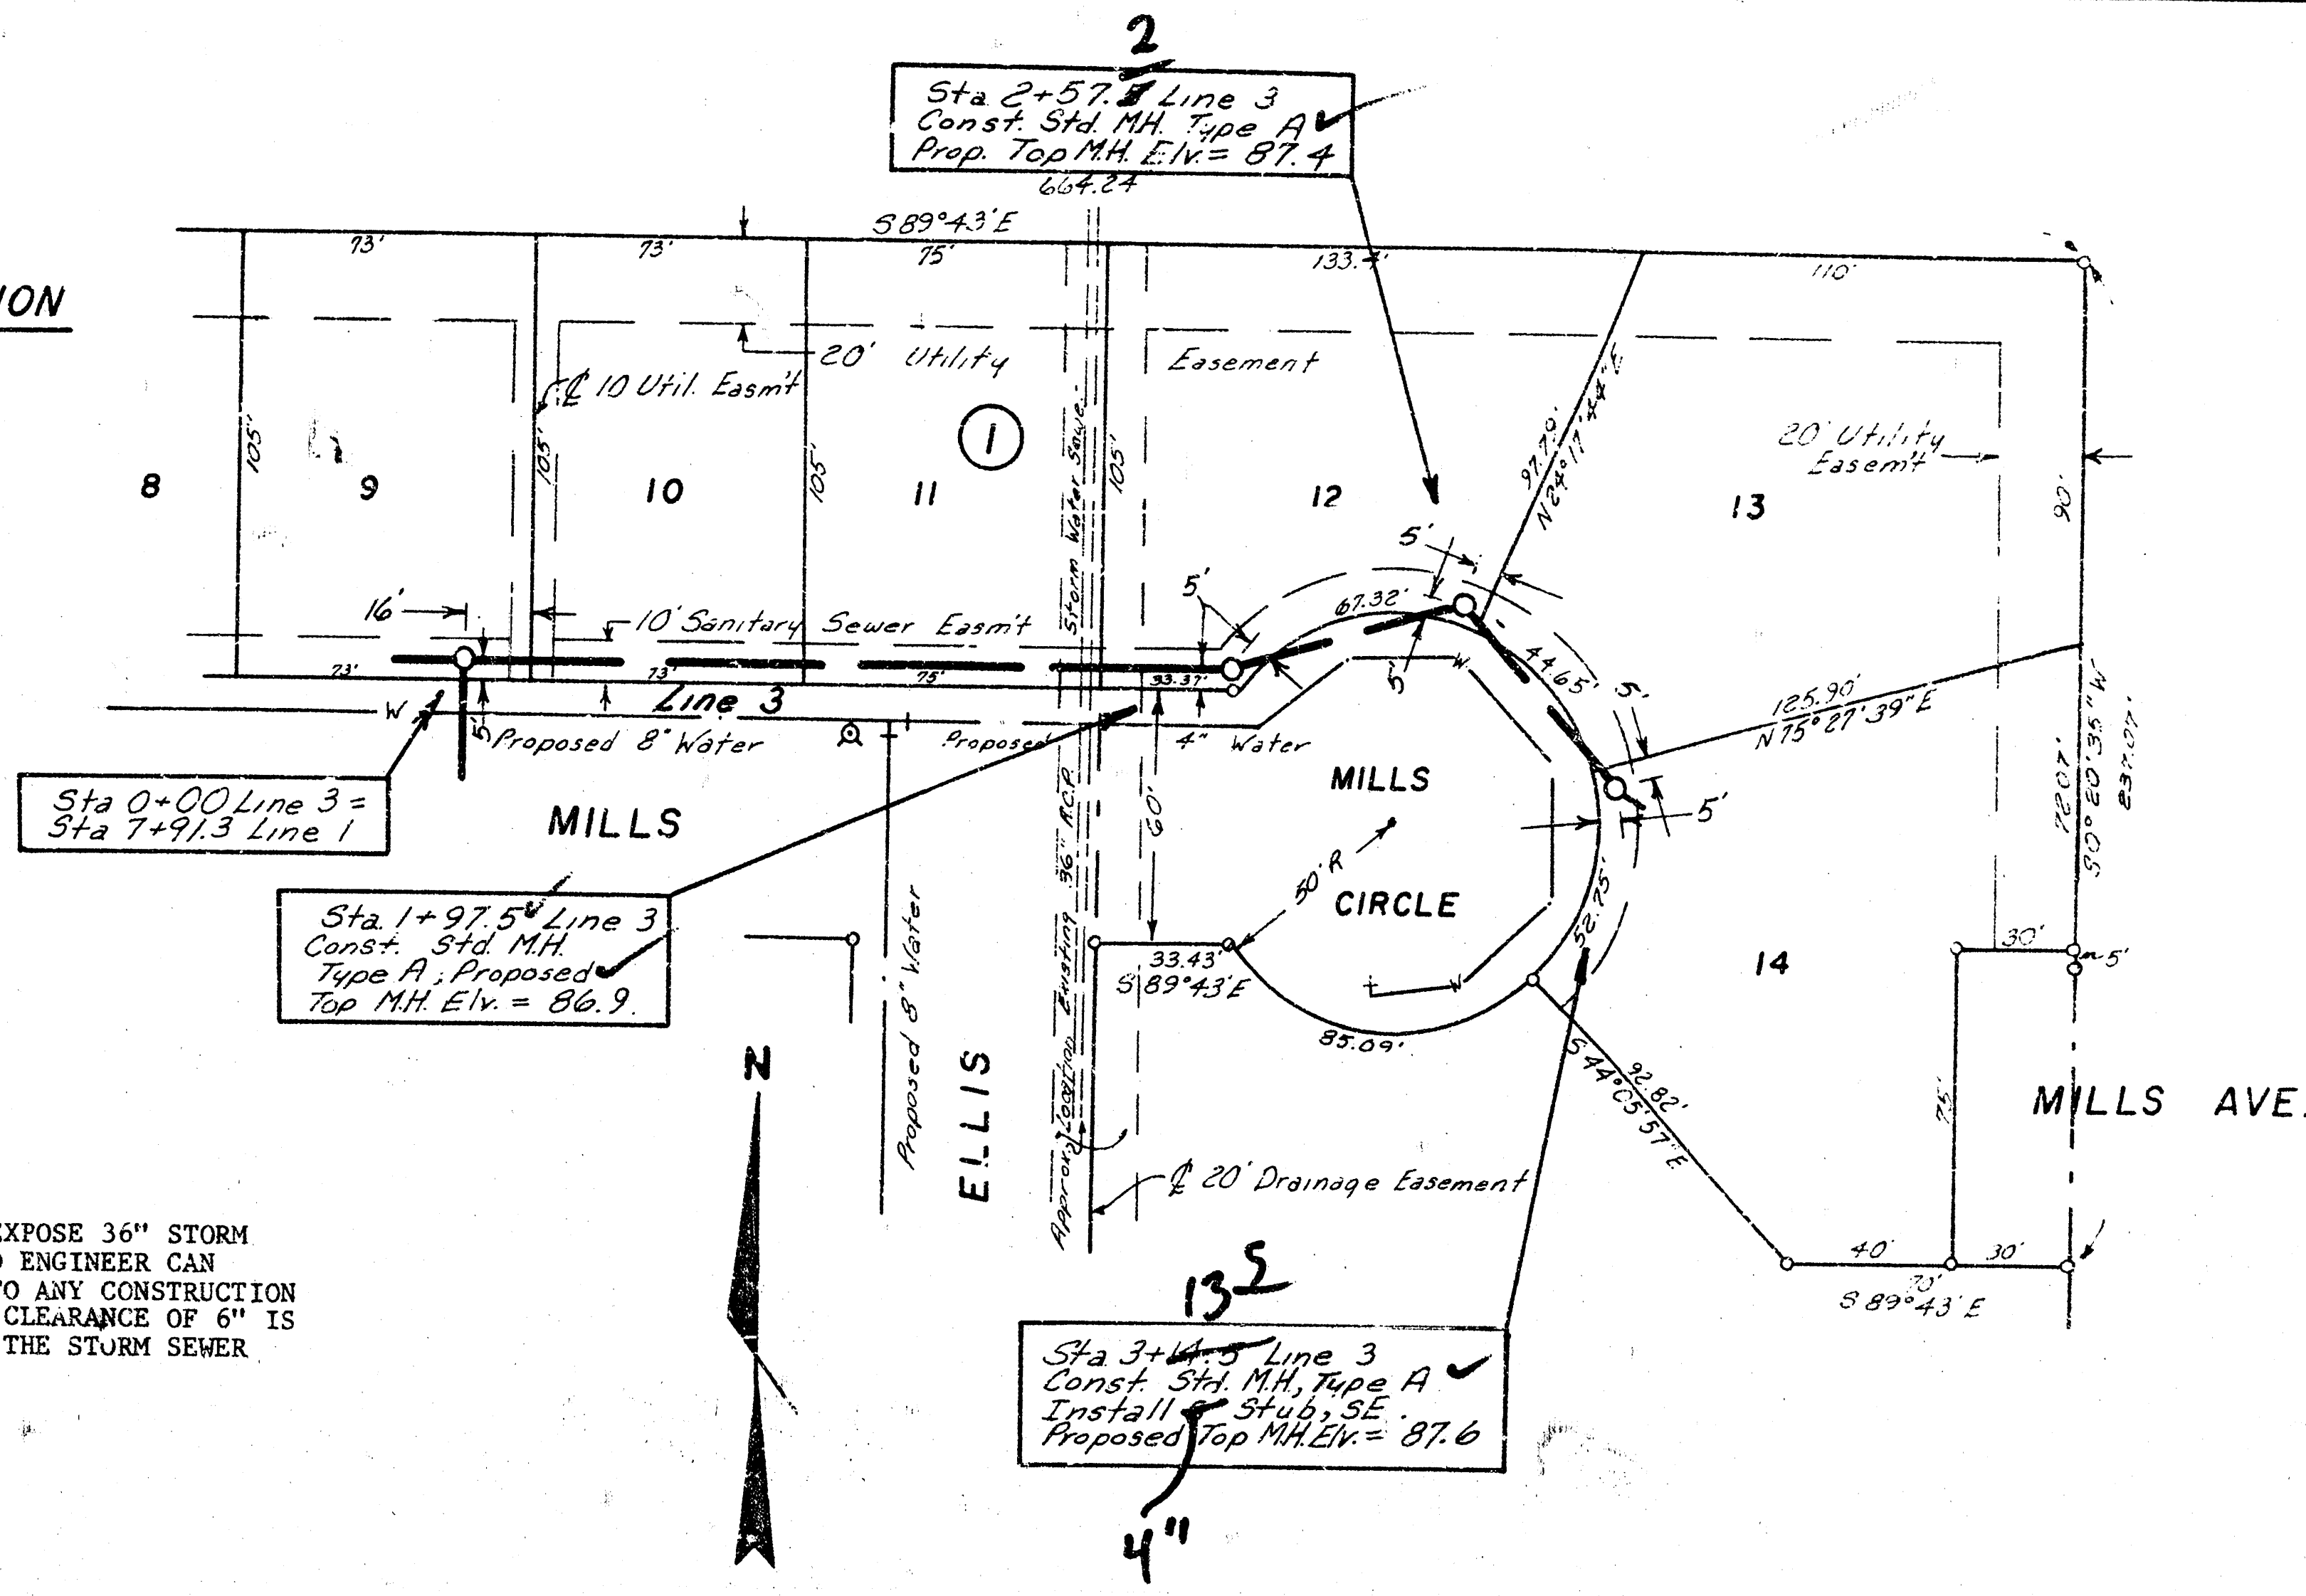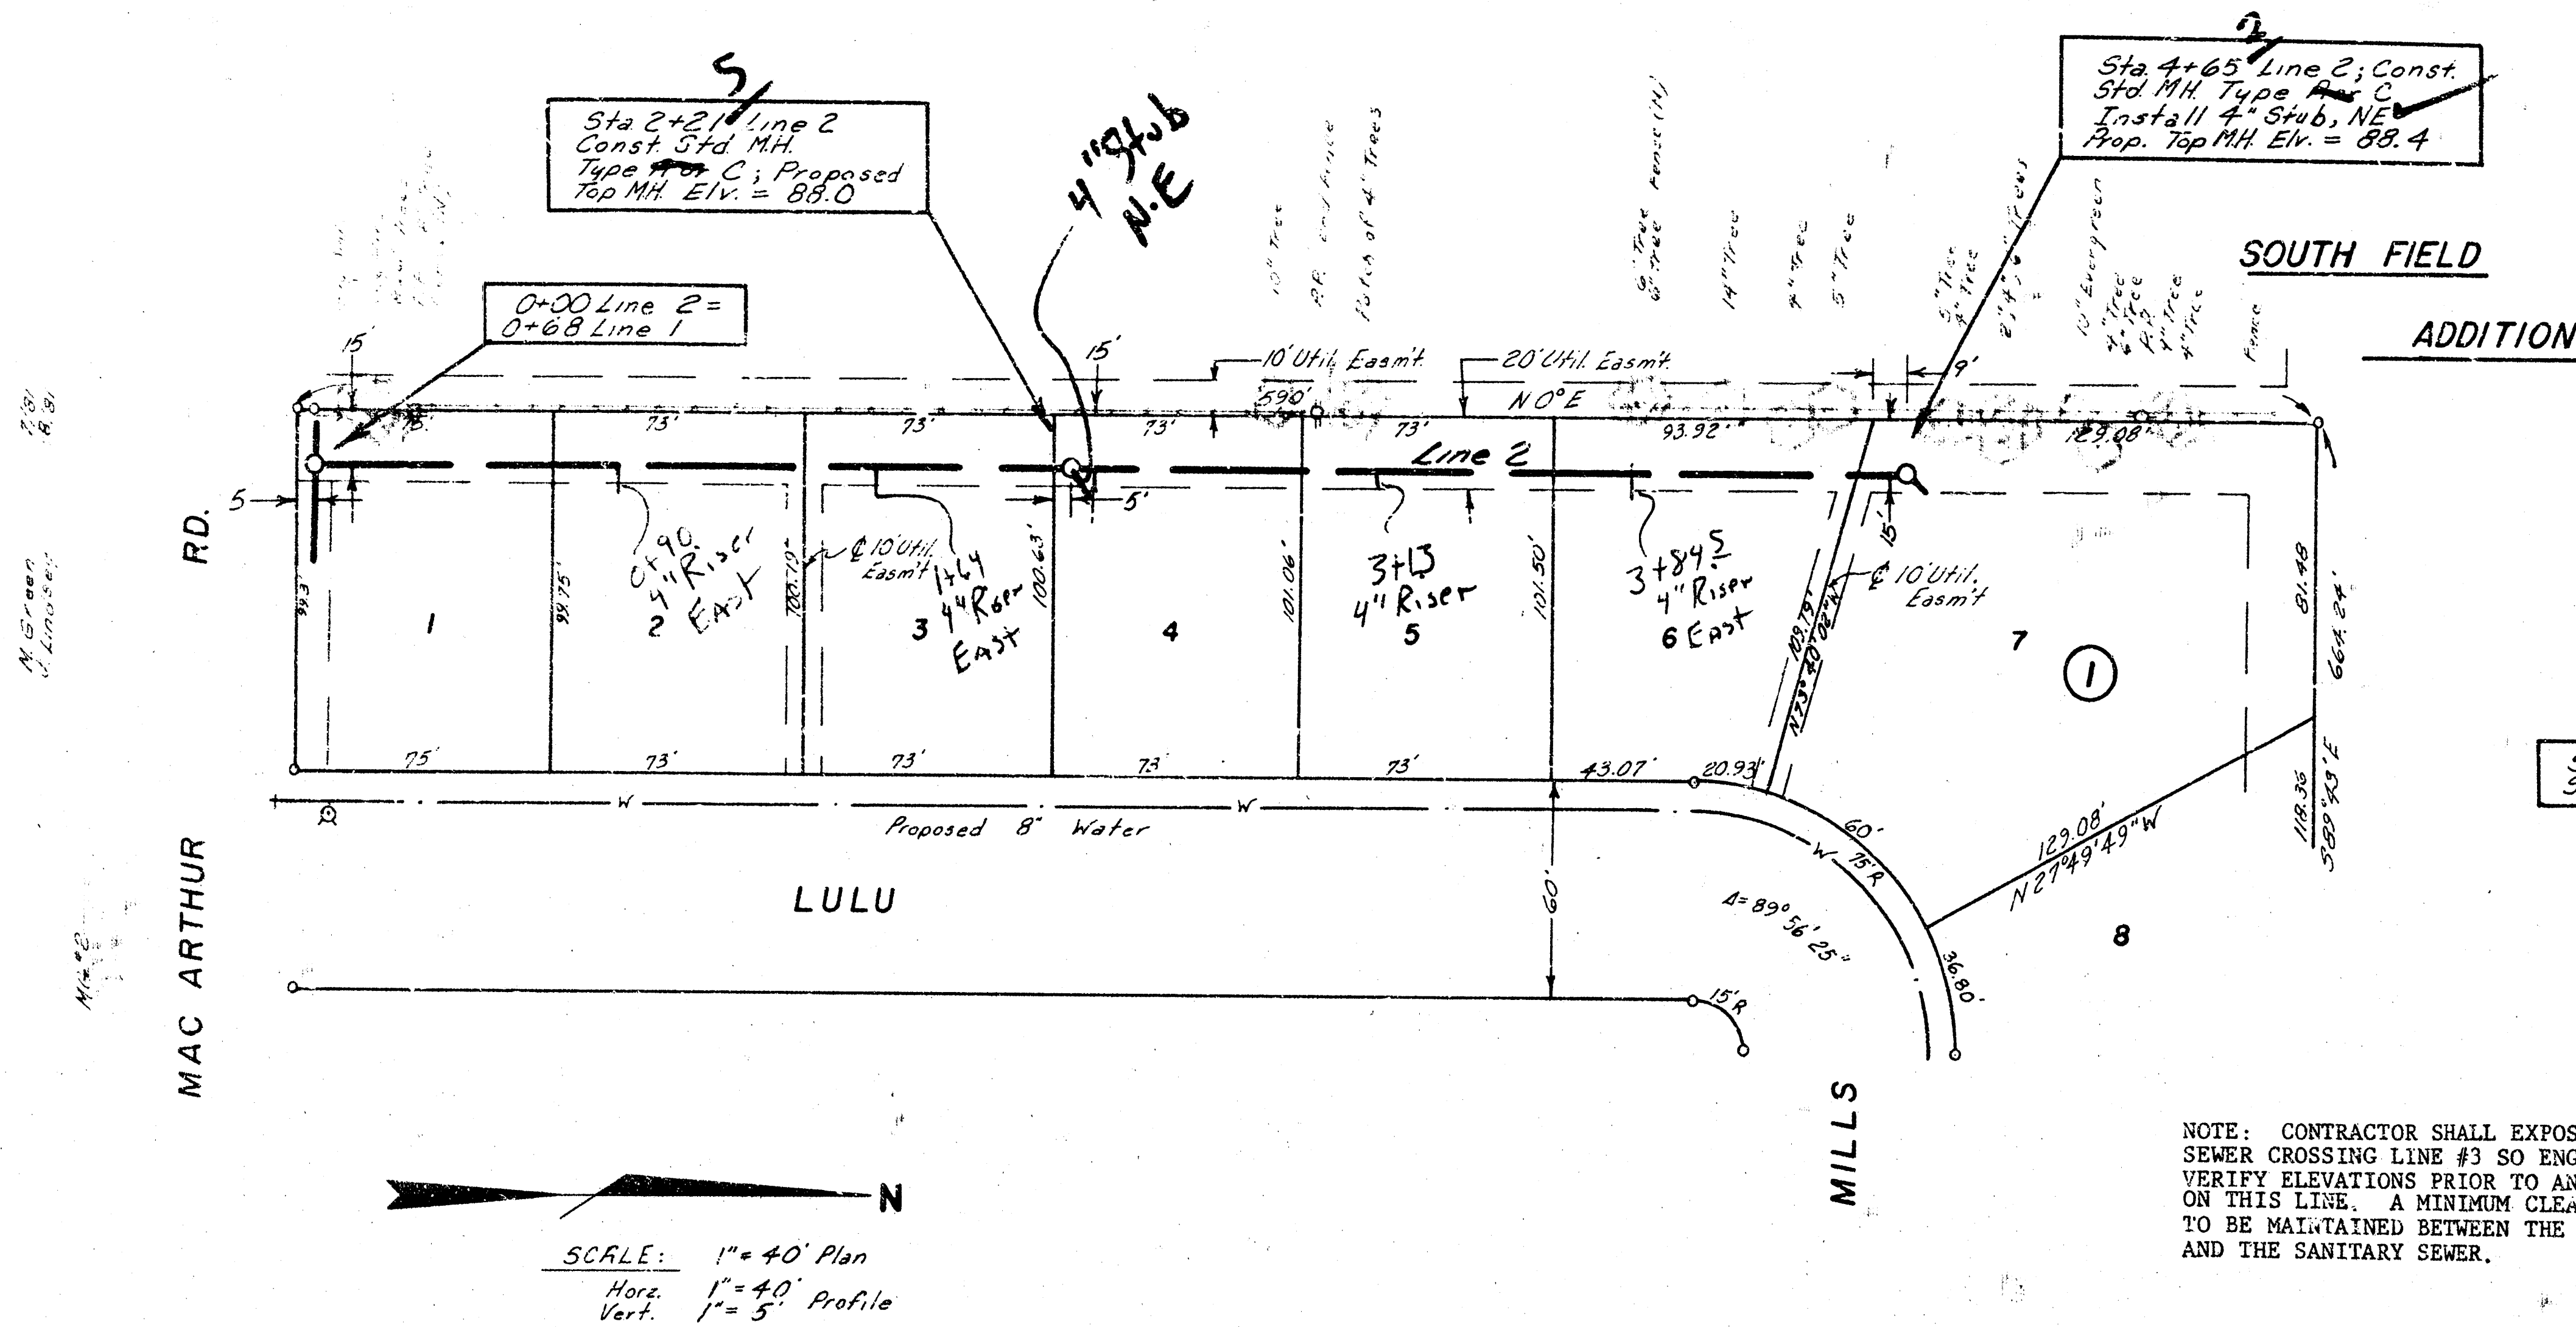

NOTE: CONTRACTOR SHALL EXPOSE 36" STORM SEWER CROSSING LINE #3 SO ENGINEER CAN VERIFY ELEVATIONS PRIOR TO ANY CONSTRUCTION ON THIS LINE. A MINIMUM CLEARANCE OF 6" IS TO BE MAINTAINED BETWEEN THE STORM SEWER AND THE SANITARY SEWER.

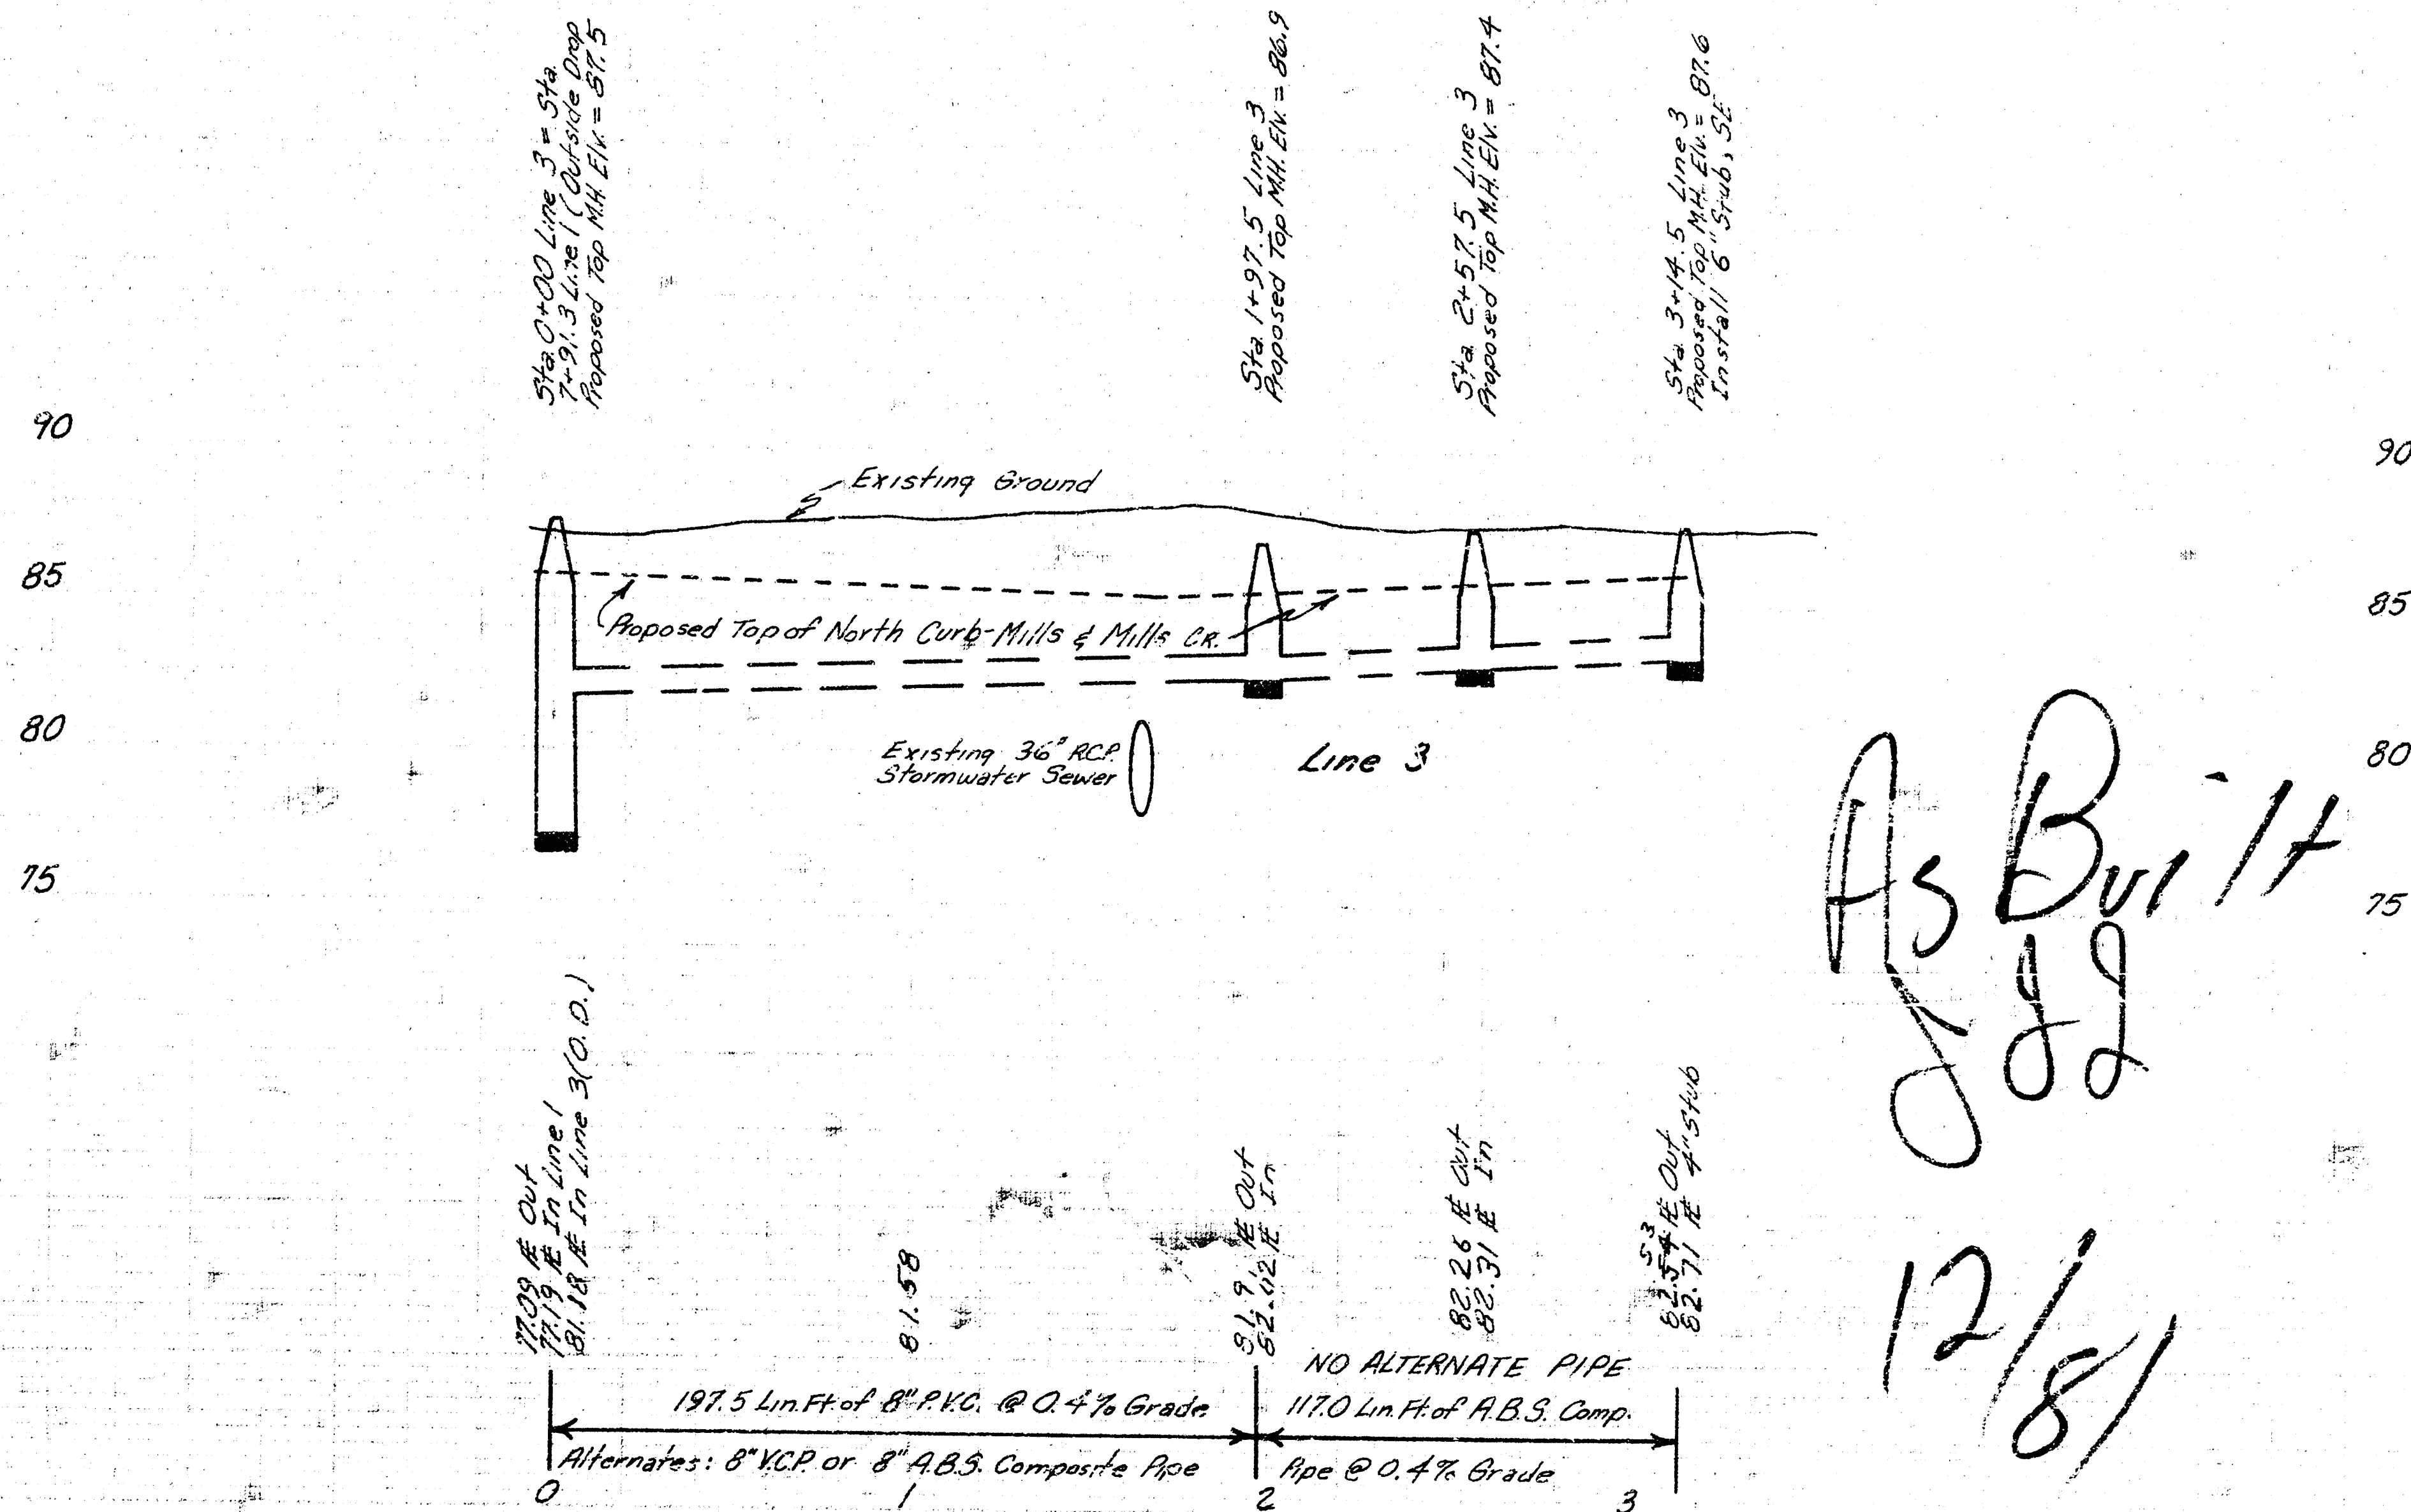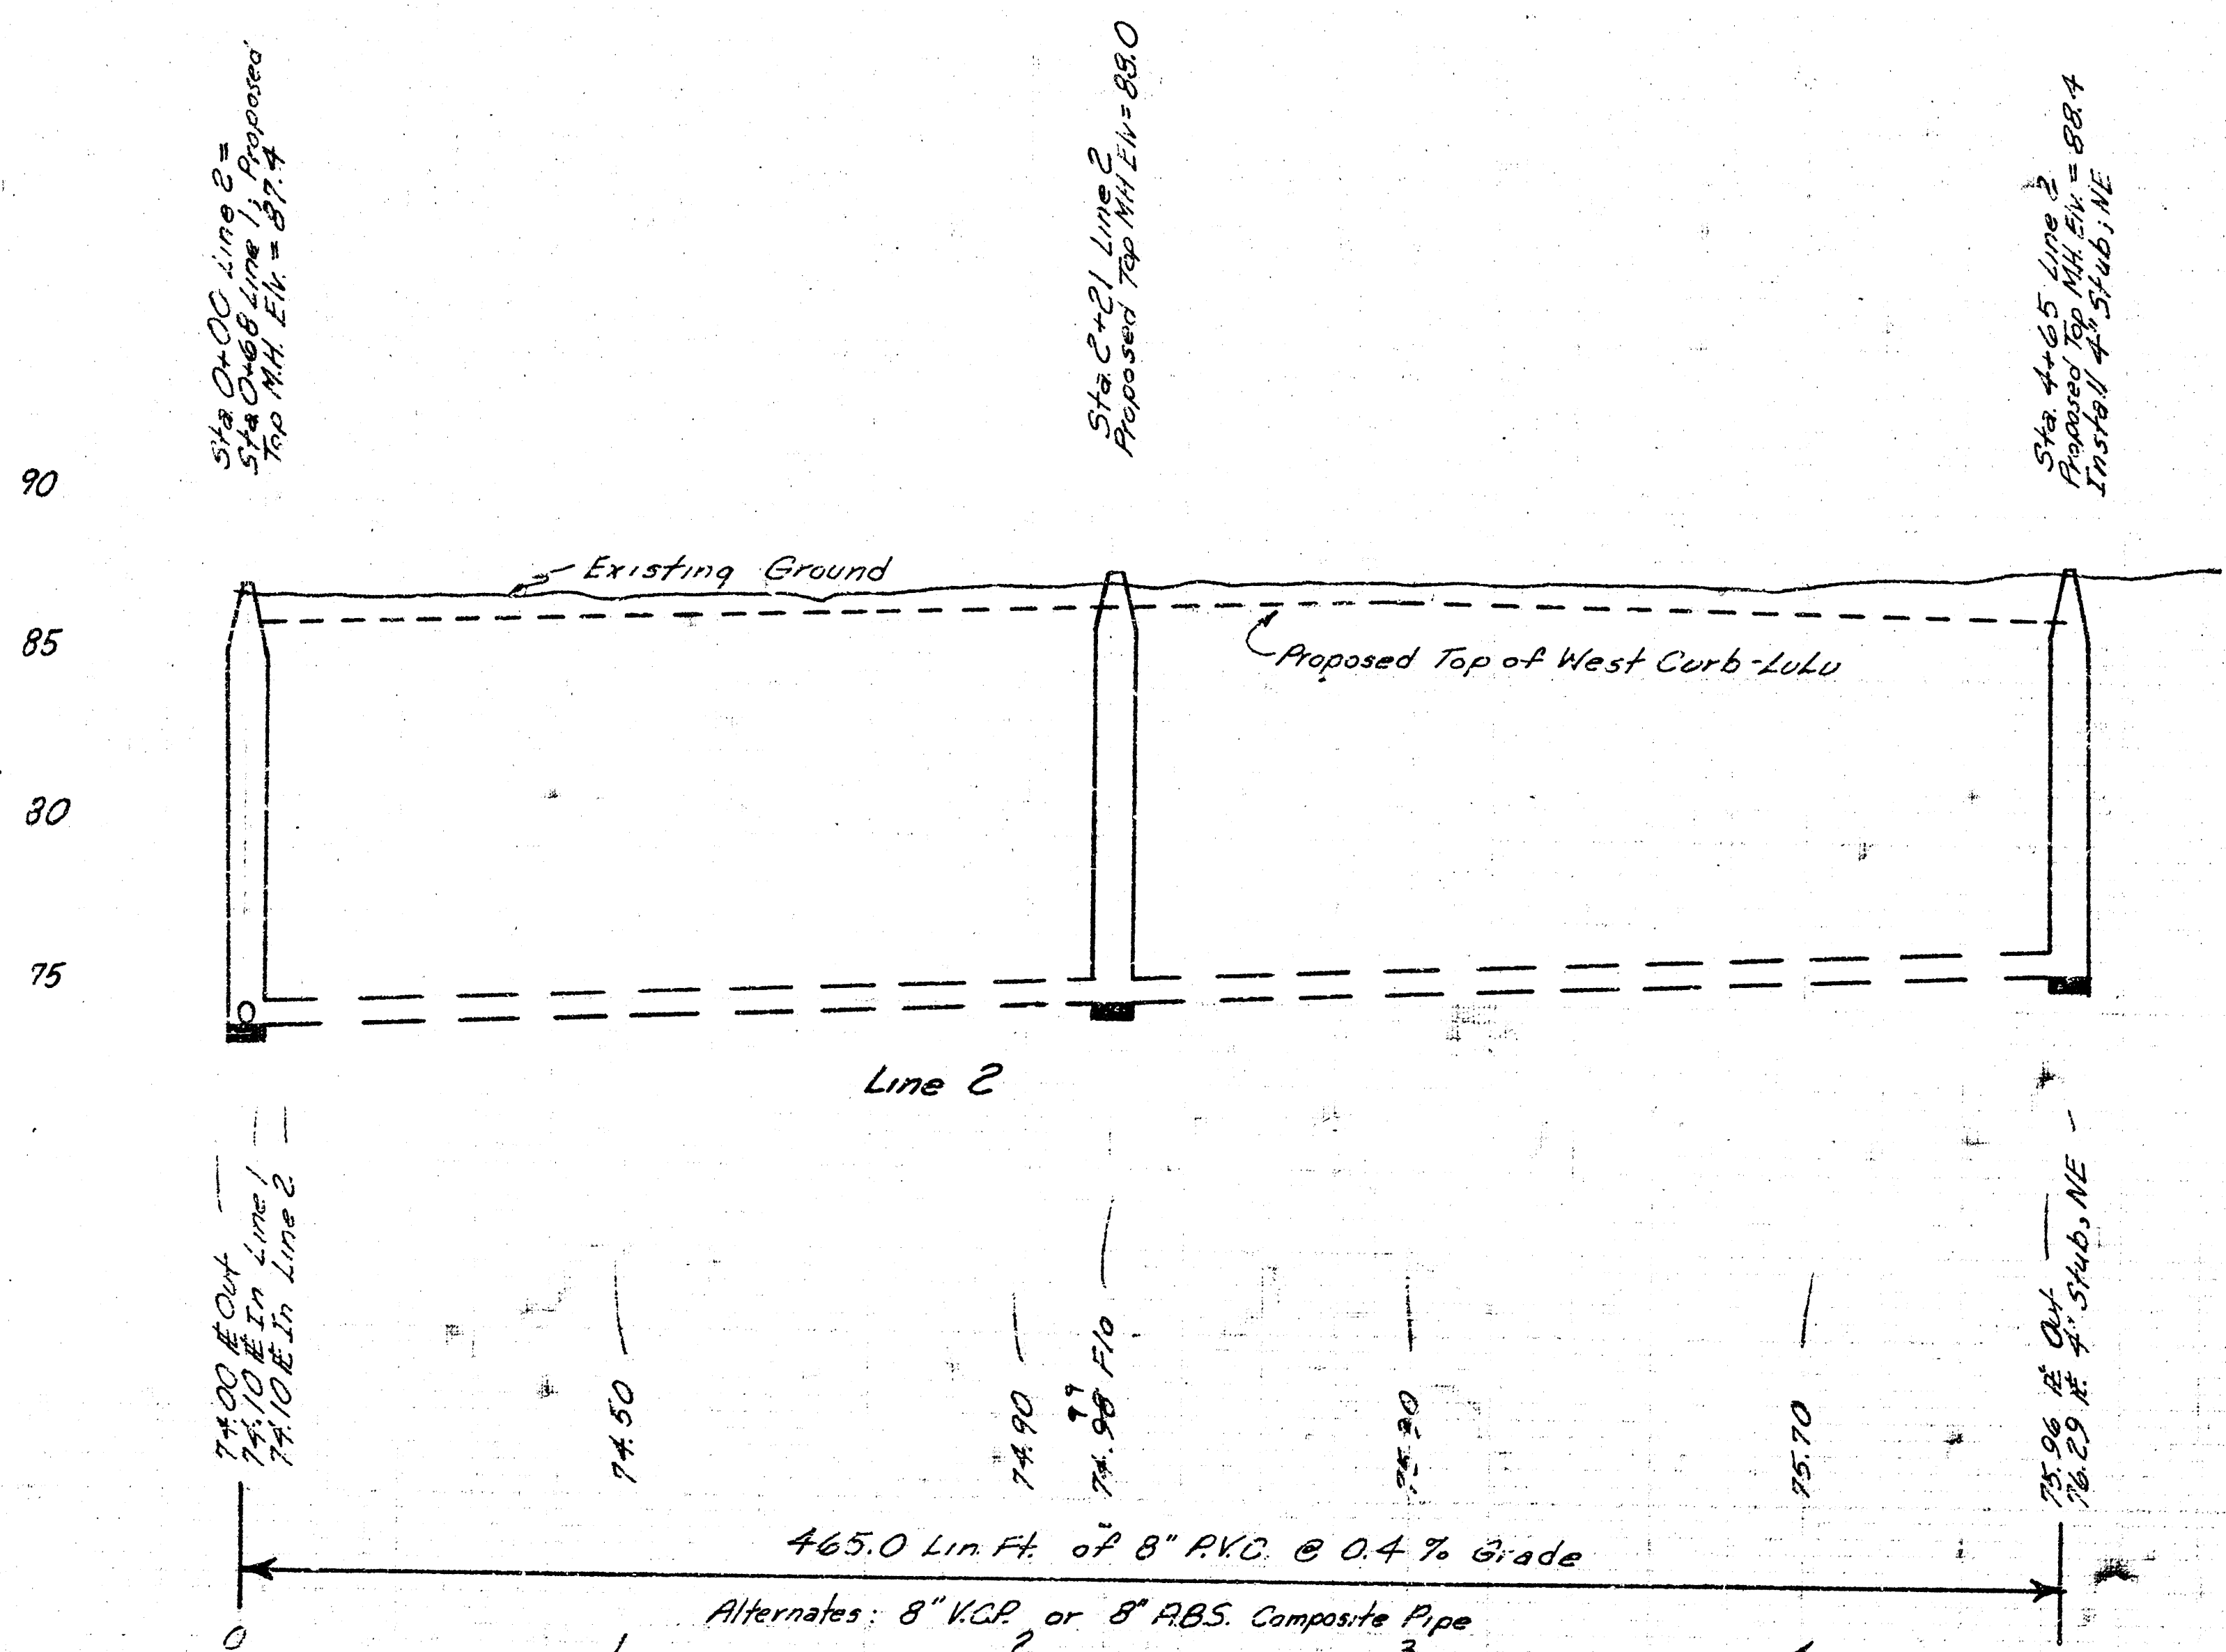

As Built
 12/8/1