


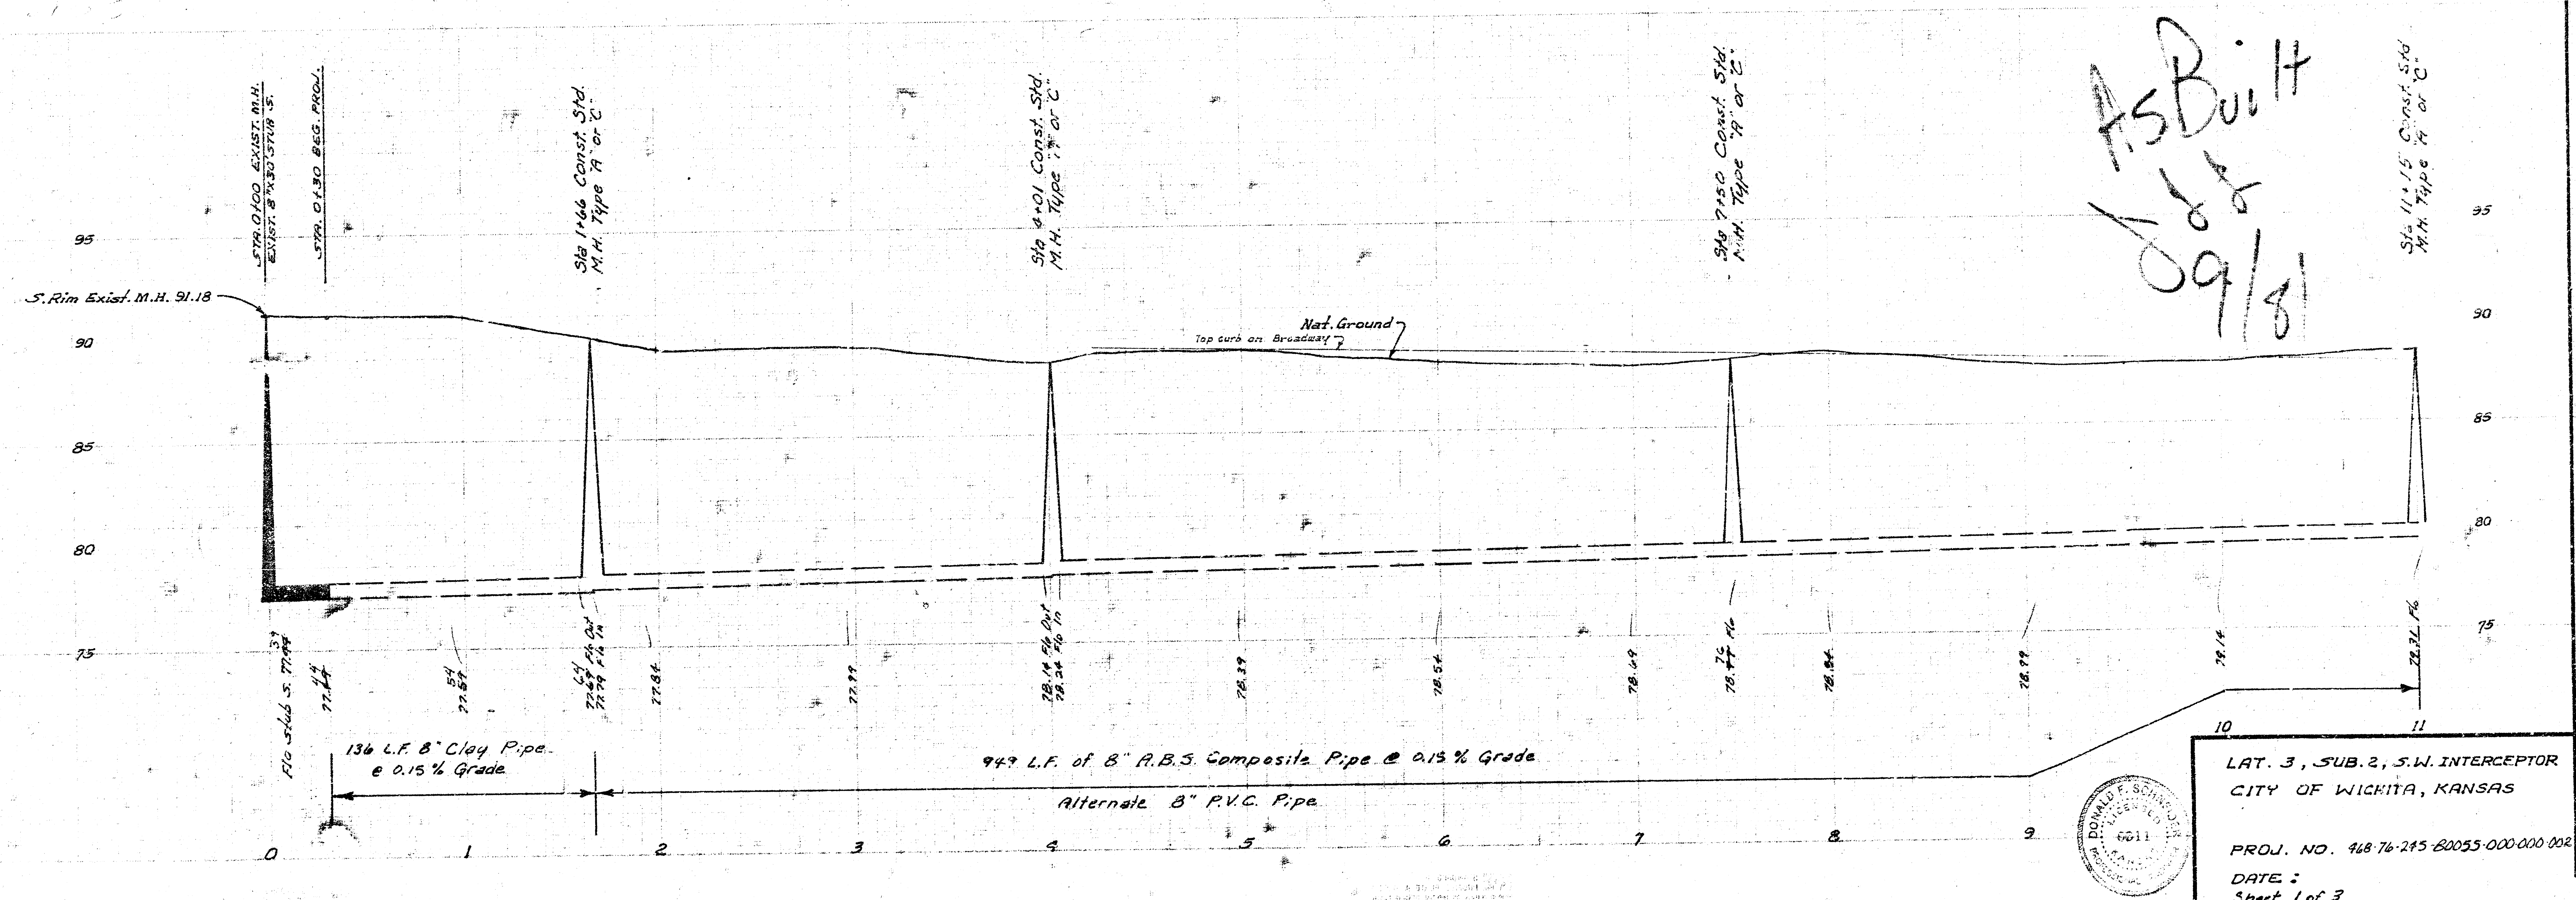
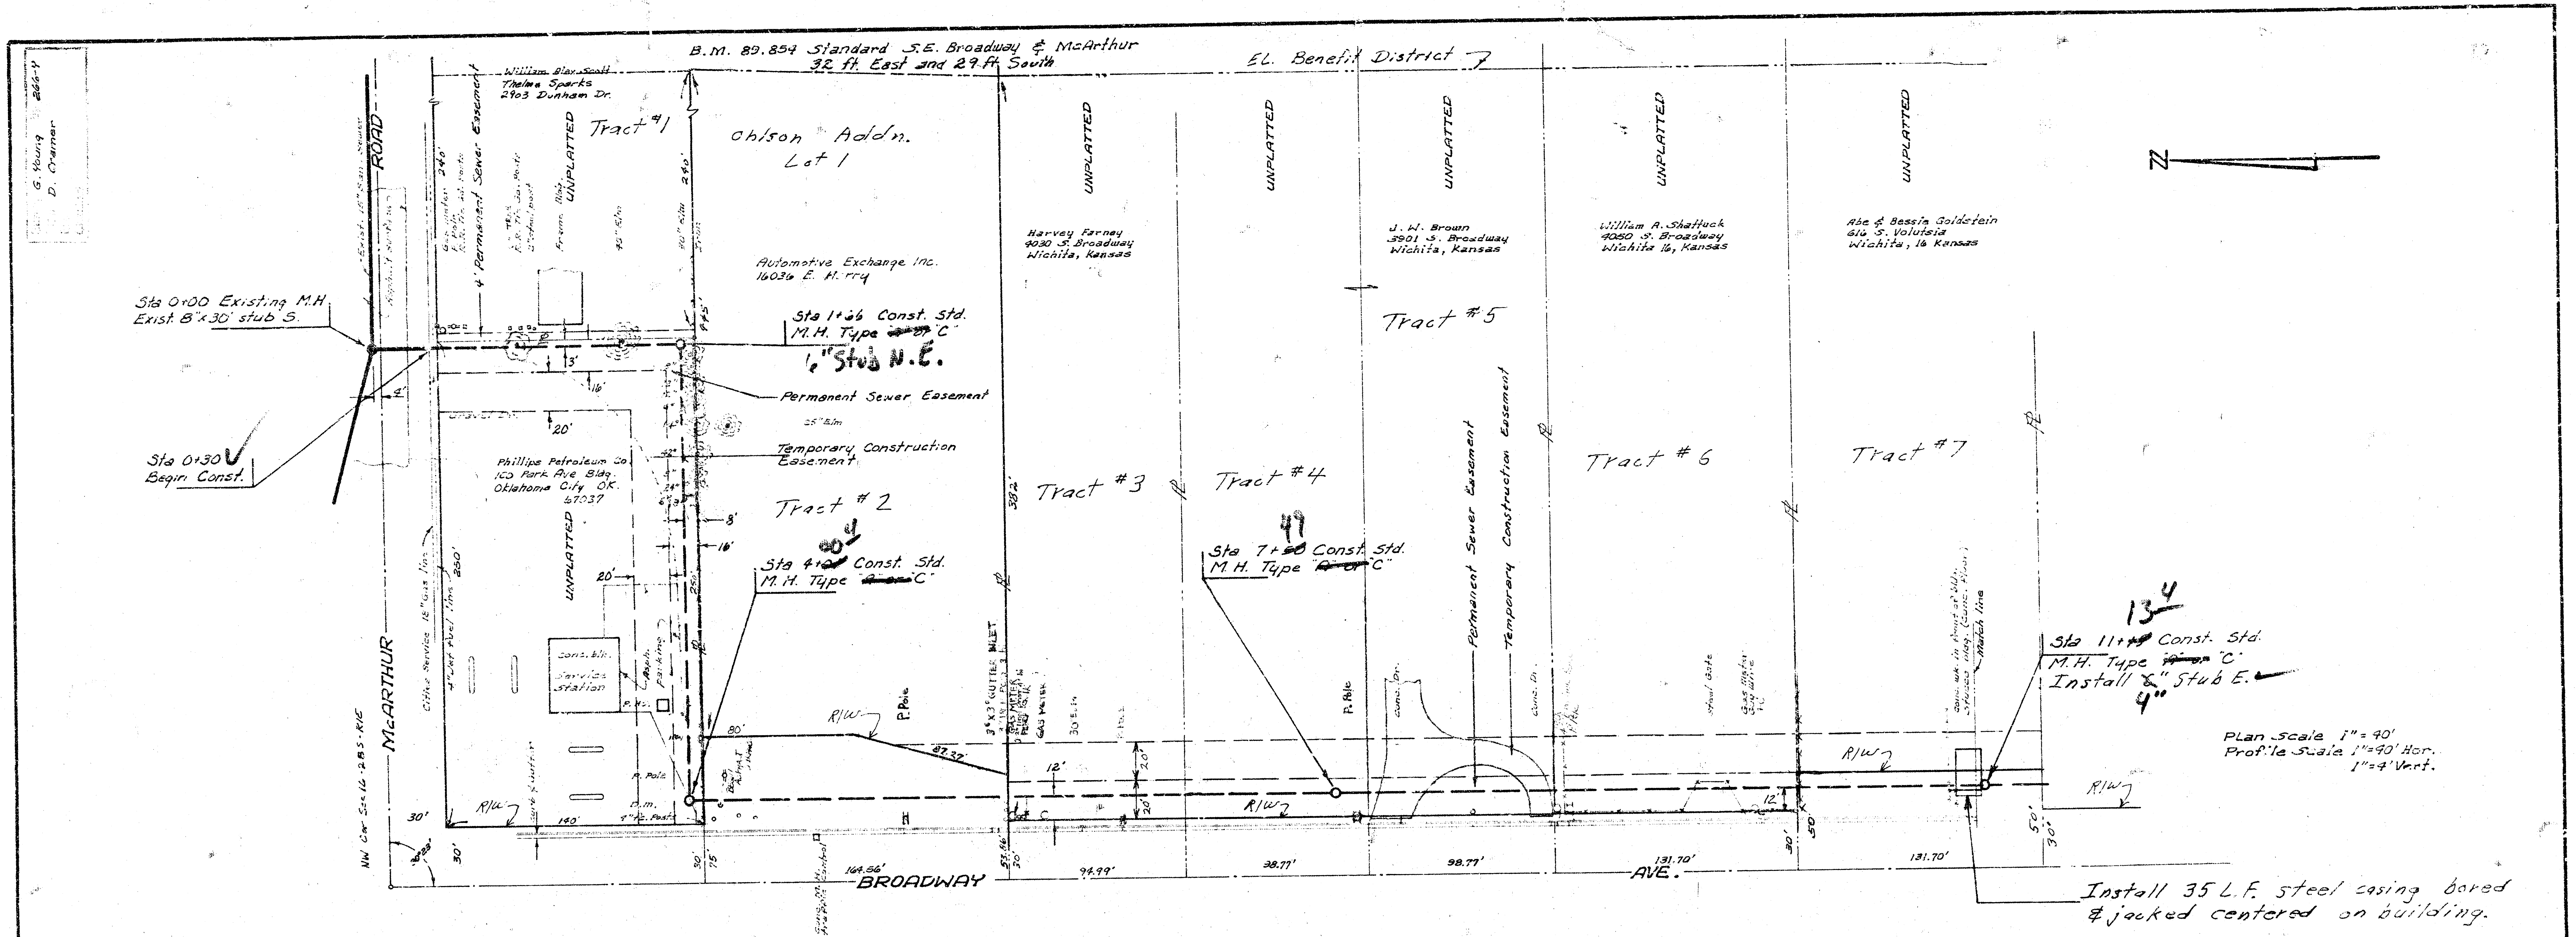


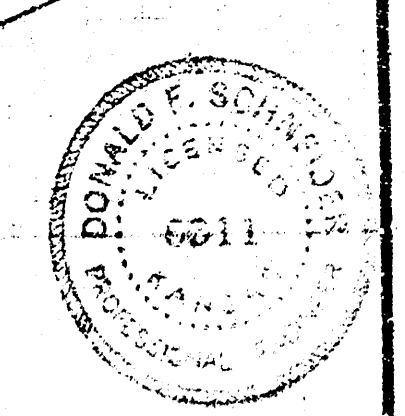

AS BUILT
 8/8
 09/81

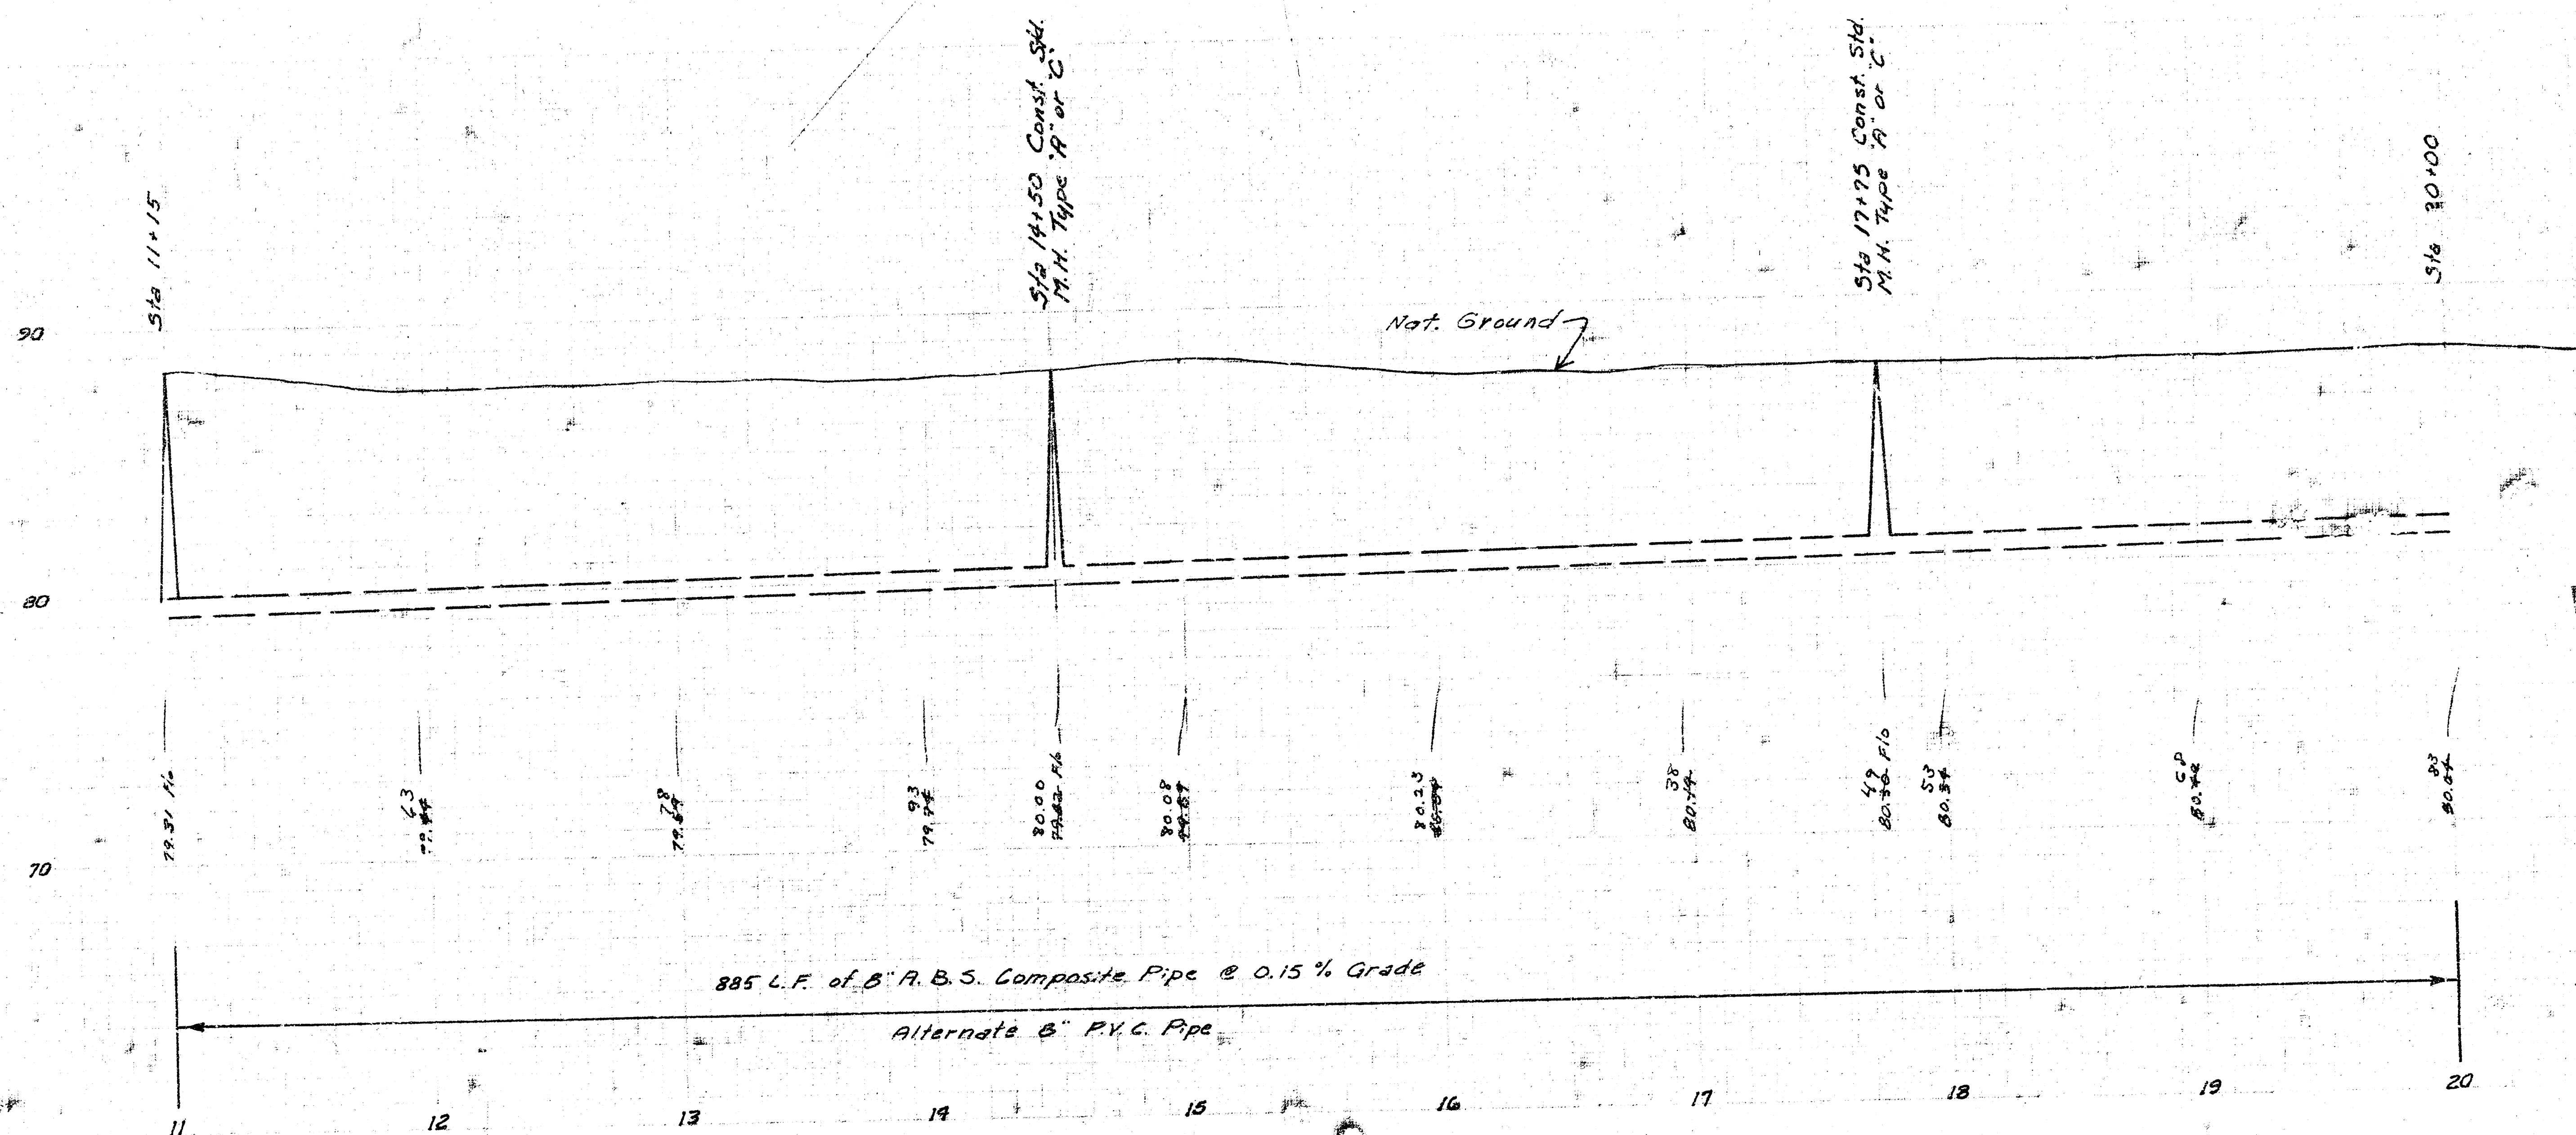


LAT. 3, SUB. 2, S.W. INTERCEPTOR
 CITY OF WICHITA, KANSAS
 PROJ. NO. 418-76-245-62053-000-000-000
 DATE:
 Sheet 1 of 3

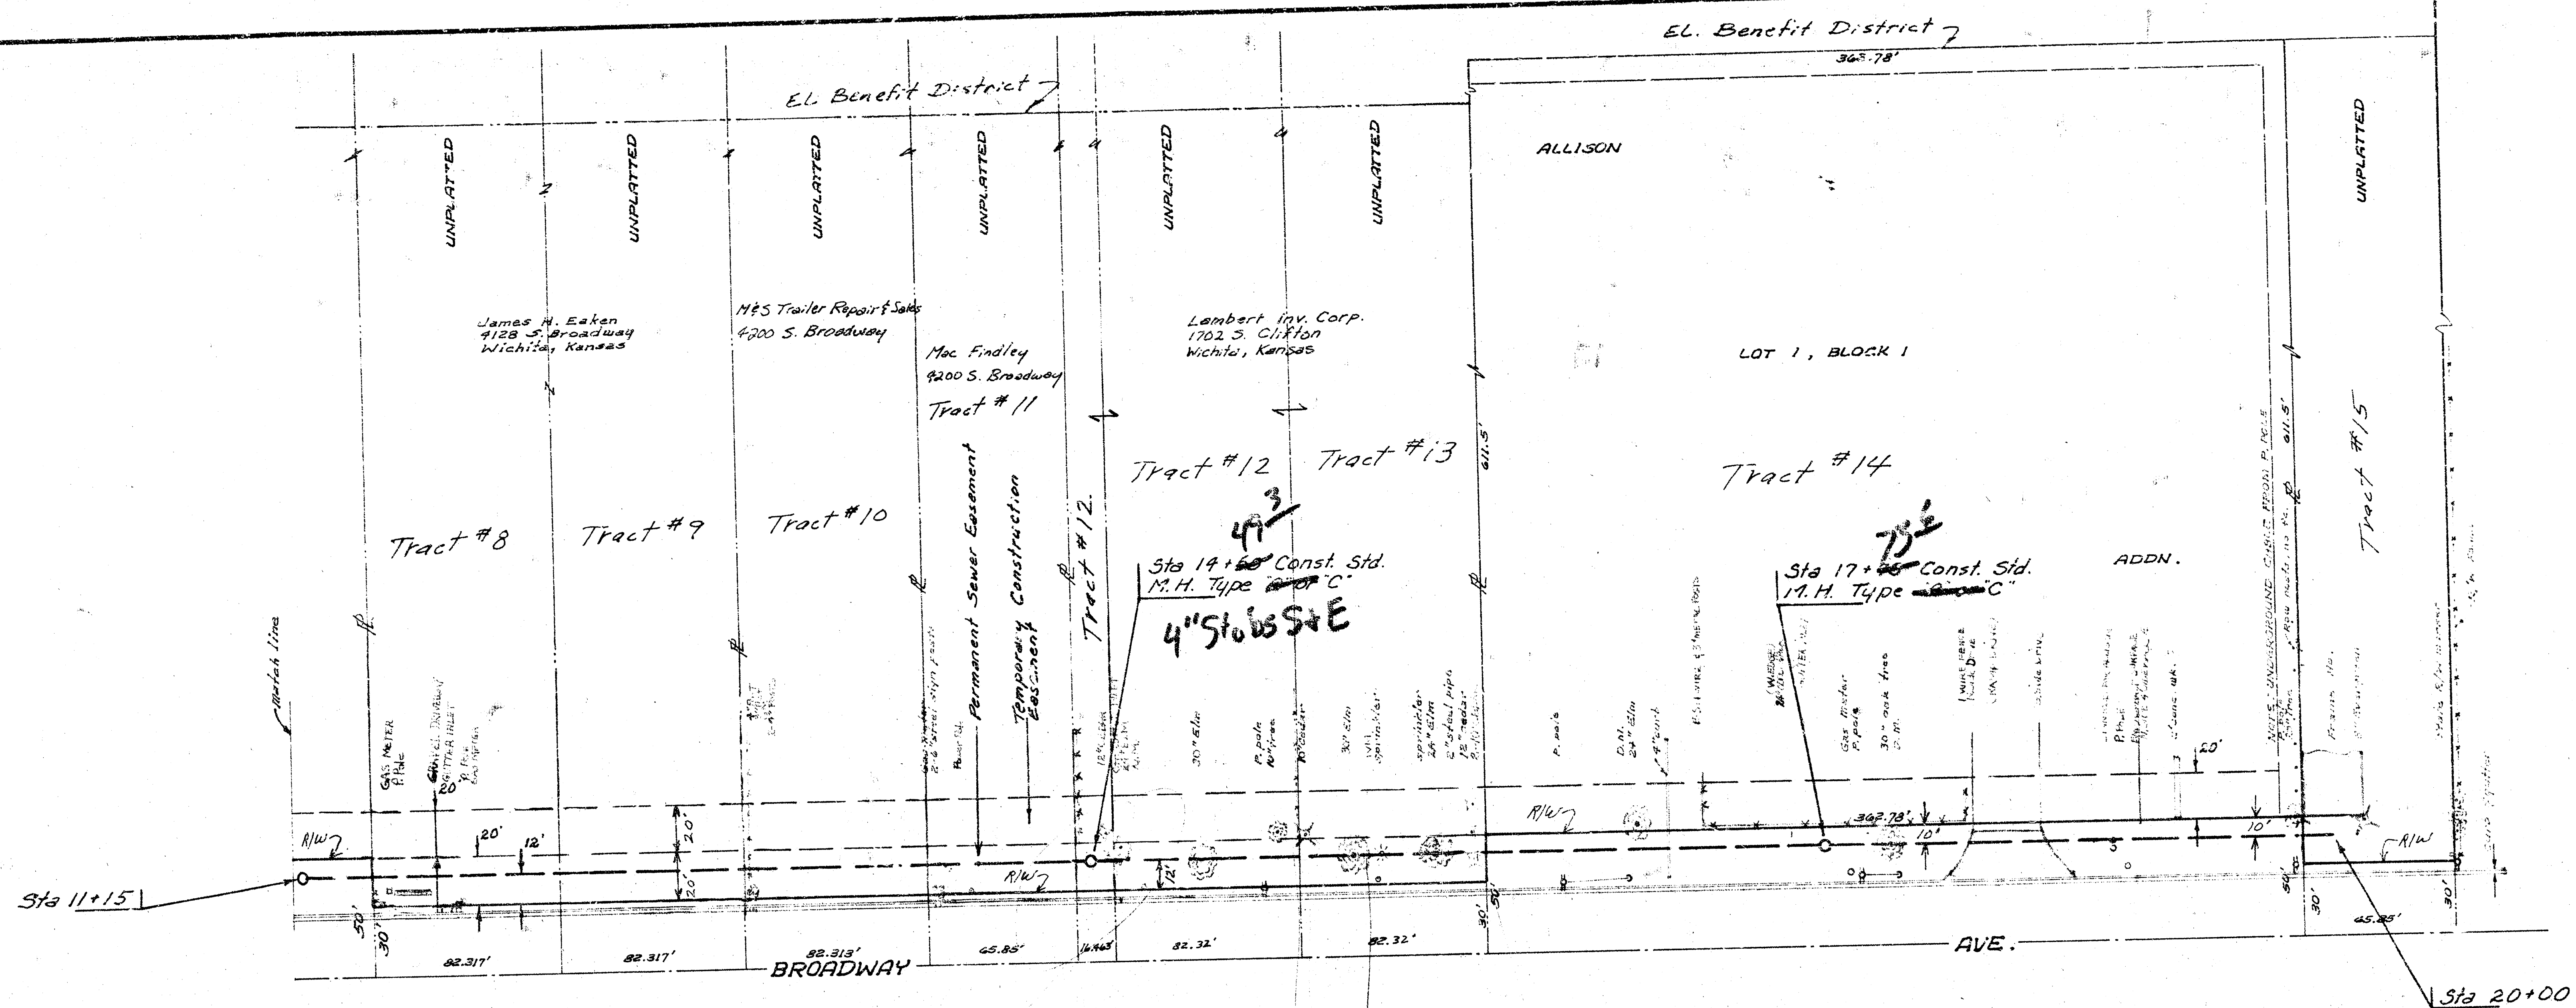


As Built
9/8/81
JSS

9/18
De Ciego
PLAN
TCD 12

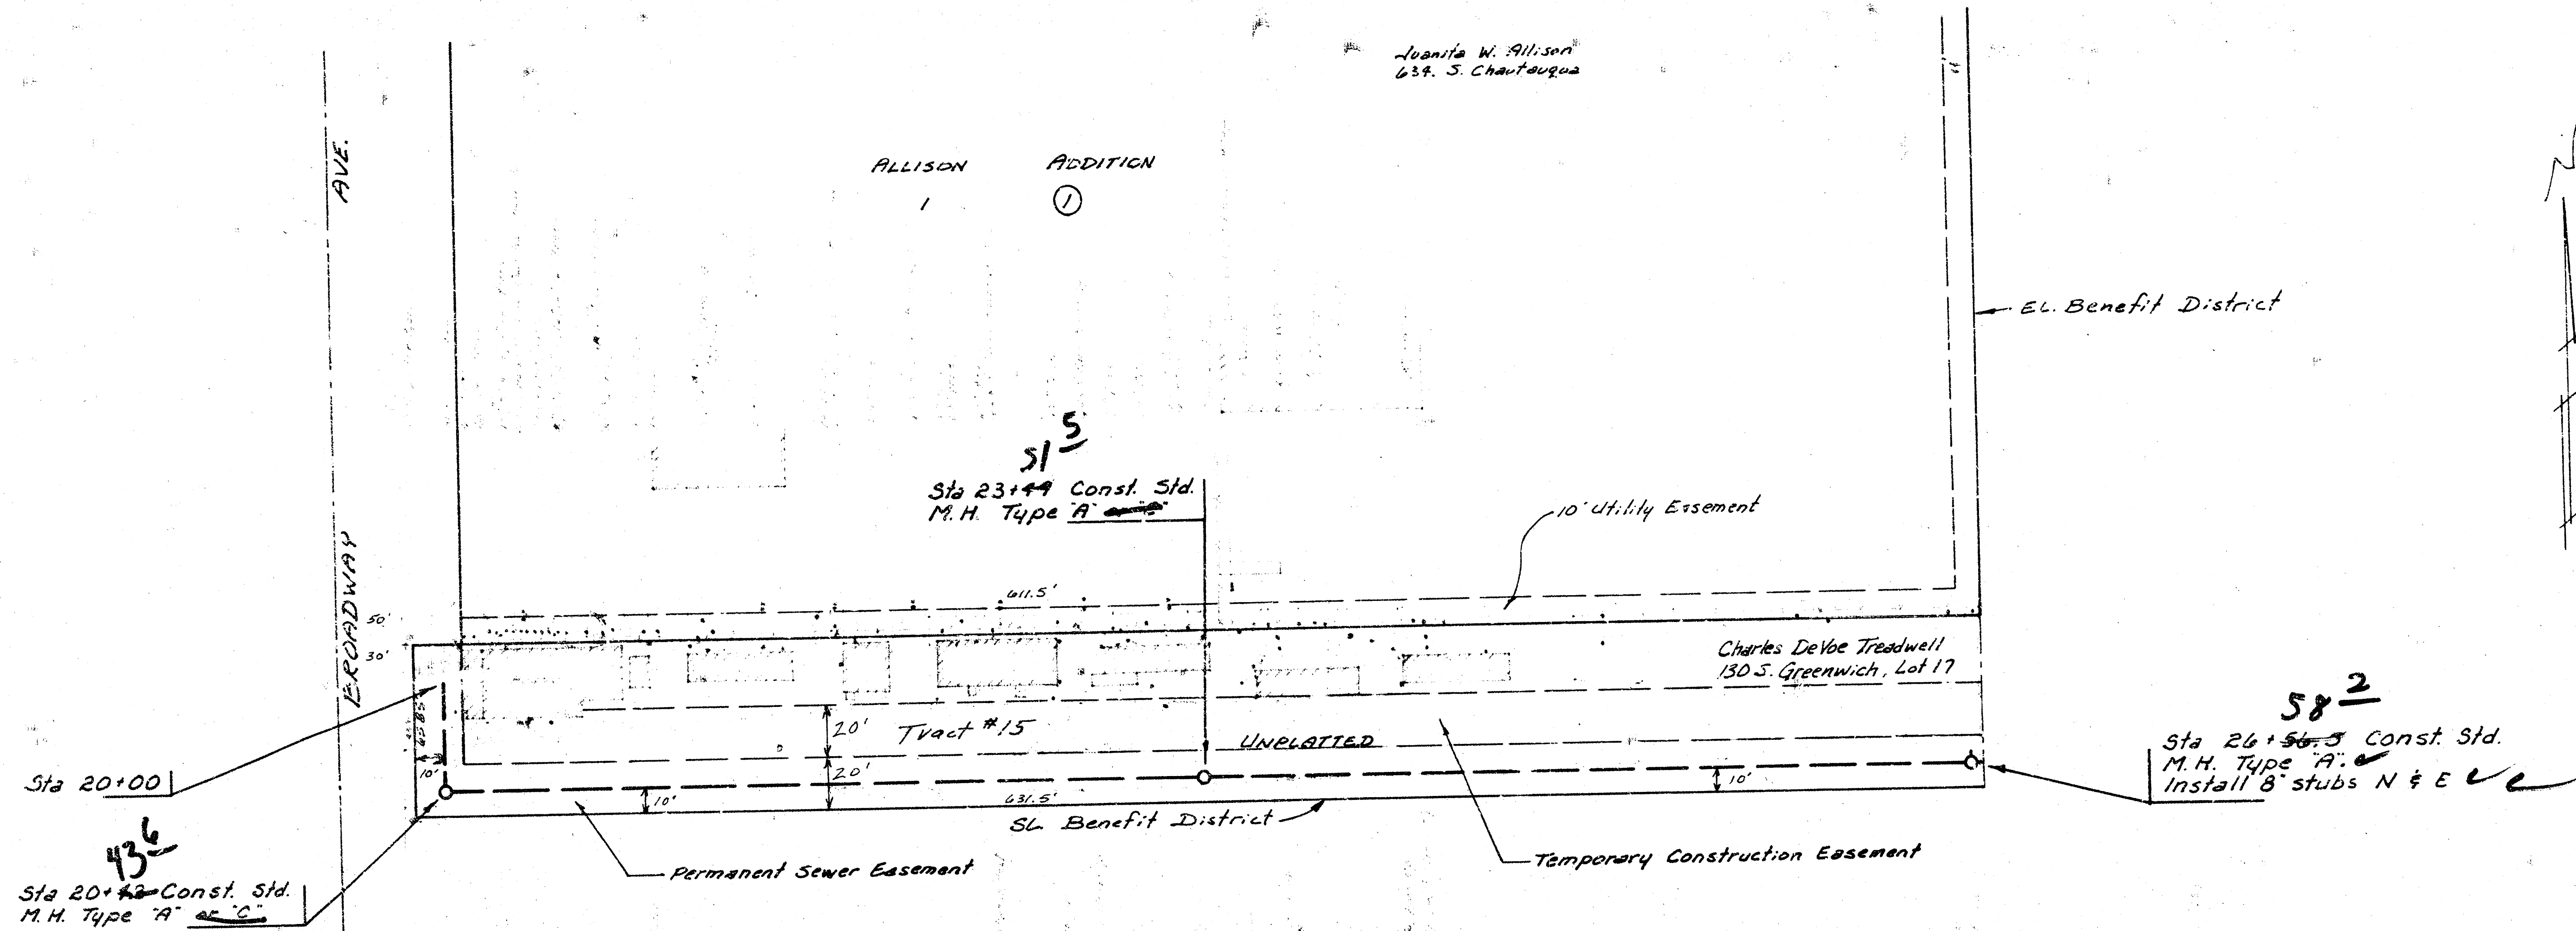

Scale Plan 1" = 40'
Profile 1" = 40' Horiz.
1" = 5' Vert.

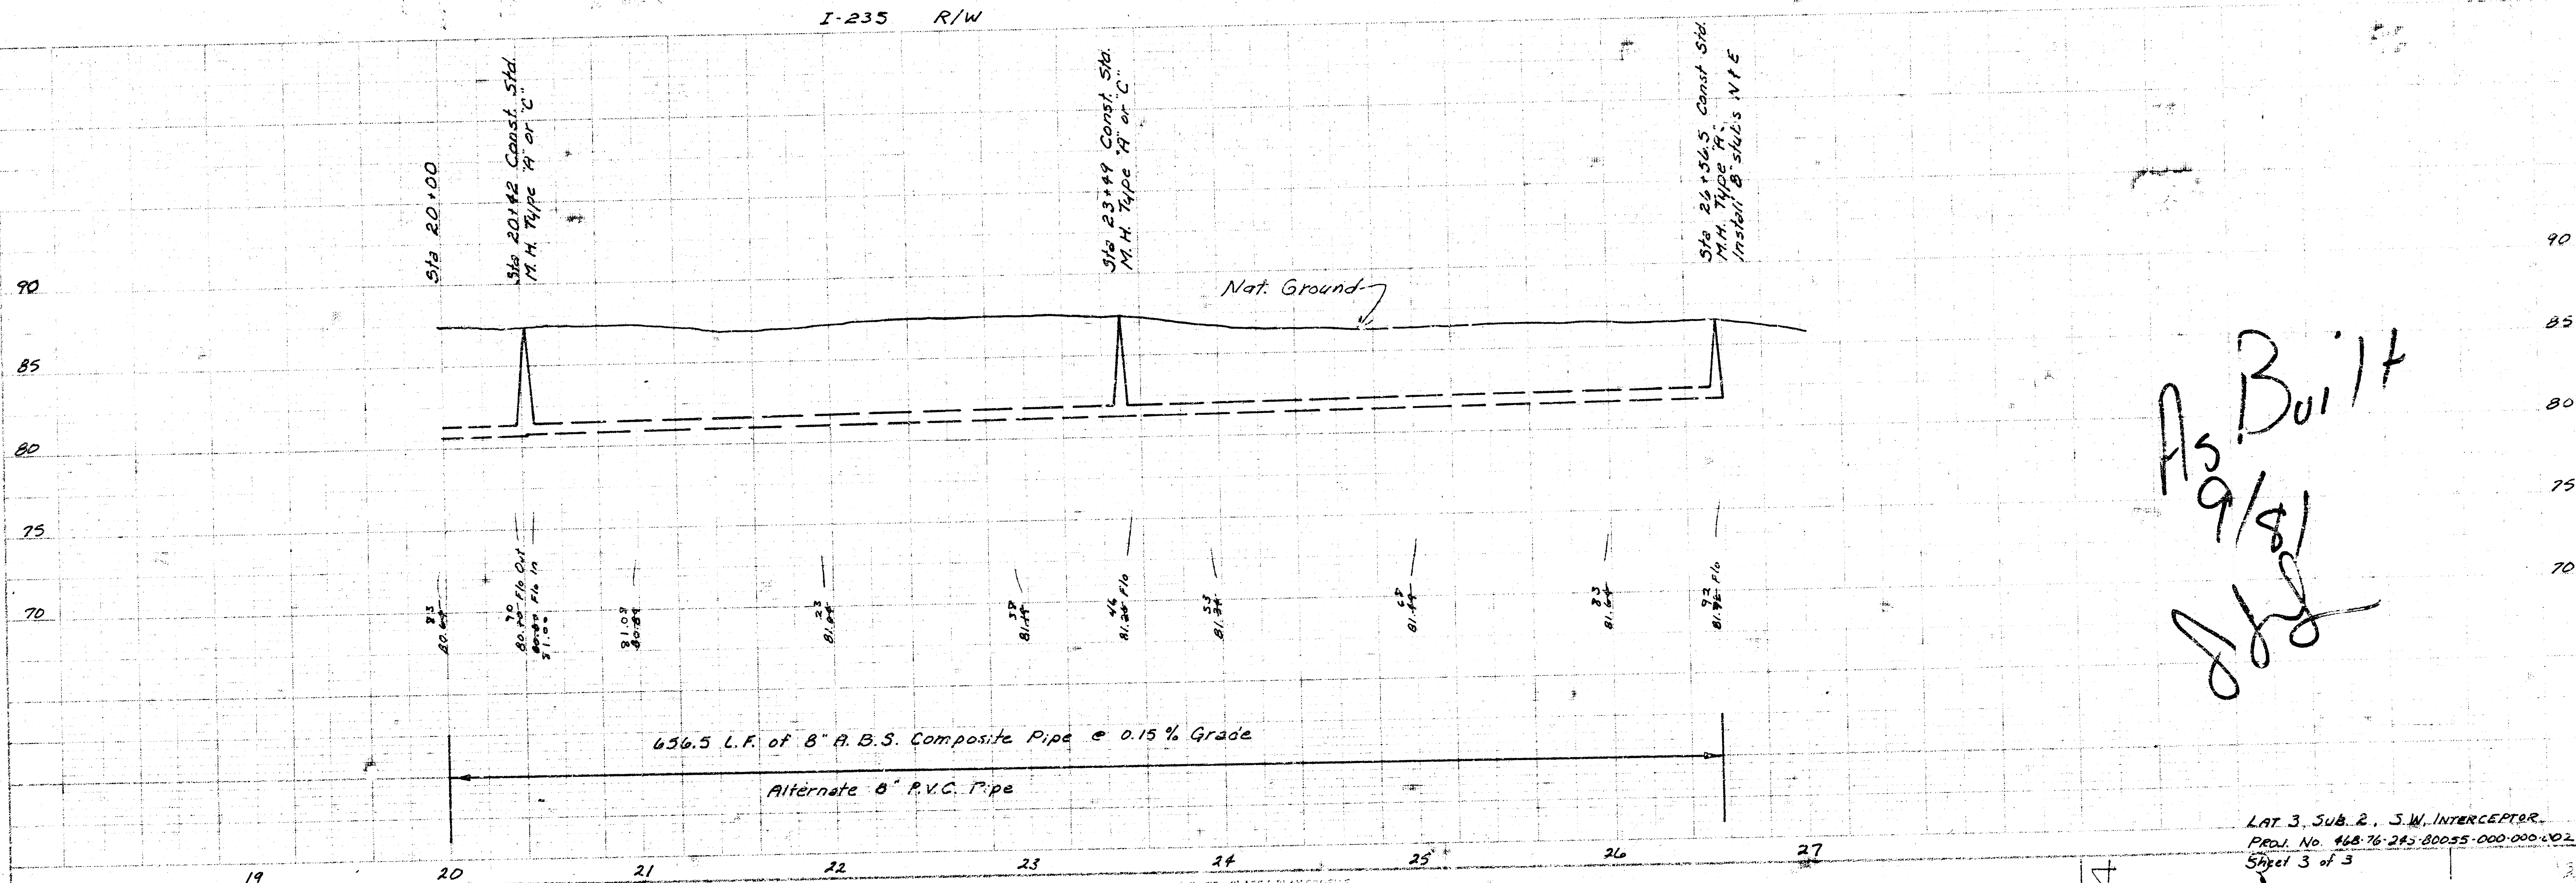

As Built
9/8/01
JH

LAT. 3, SUB. 2, S.W. INTERCEPTOR.
PROJ. No. 468-76-243-80055-000-000-002
Sheet 3 of 3

PRINTED FROM THE BEST