


B. M. 88.30 "d" cut top, S.E. cor.
conc. base for Bidwell Village
Sign on N.W. cor. Broadway &
43rd St. So.

B. M. 87.72 N.E. cor. Conc. Patch
Ho # 4401 So. Market.

Sta. 0100.0 Beg. Siphon
Exist. manhole.
Exist. 8.5"-8" Ductile Iron
pipe (PE-MU) east.

Field Engineer to make 'ties' to all irons.
Irons disturbed or destroyed are to be replaced.

Contractor shall not remove any trees without
prior approval from the Field Engineer.

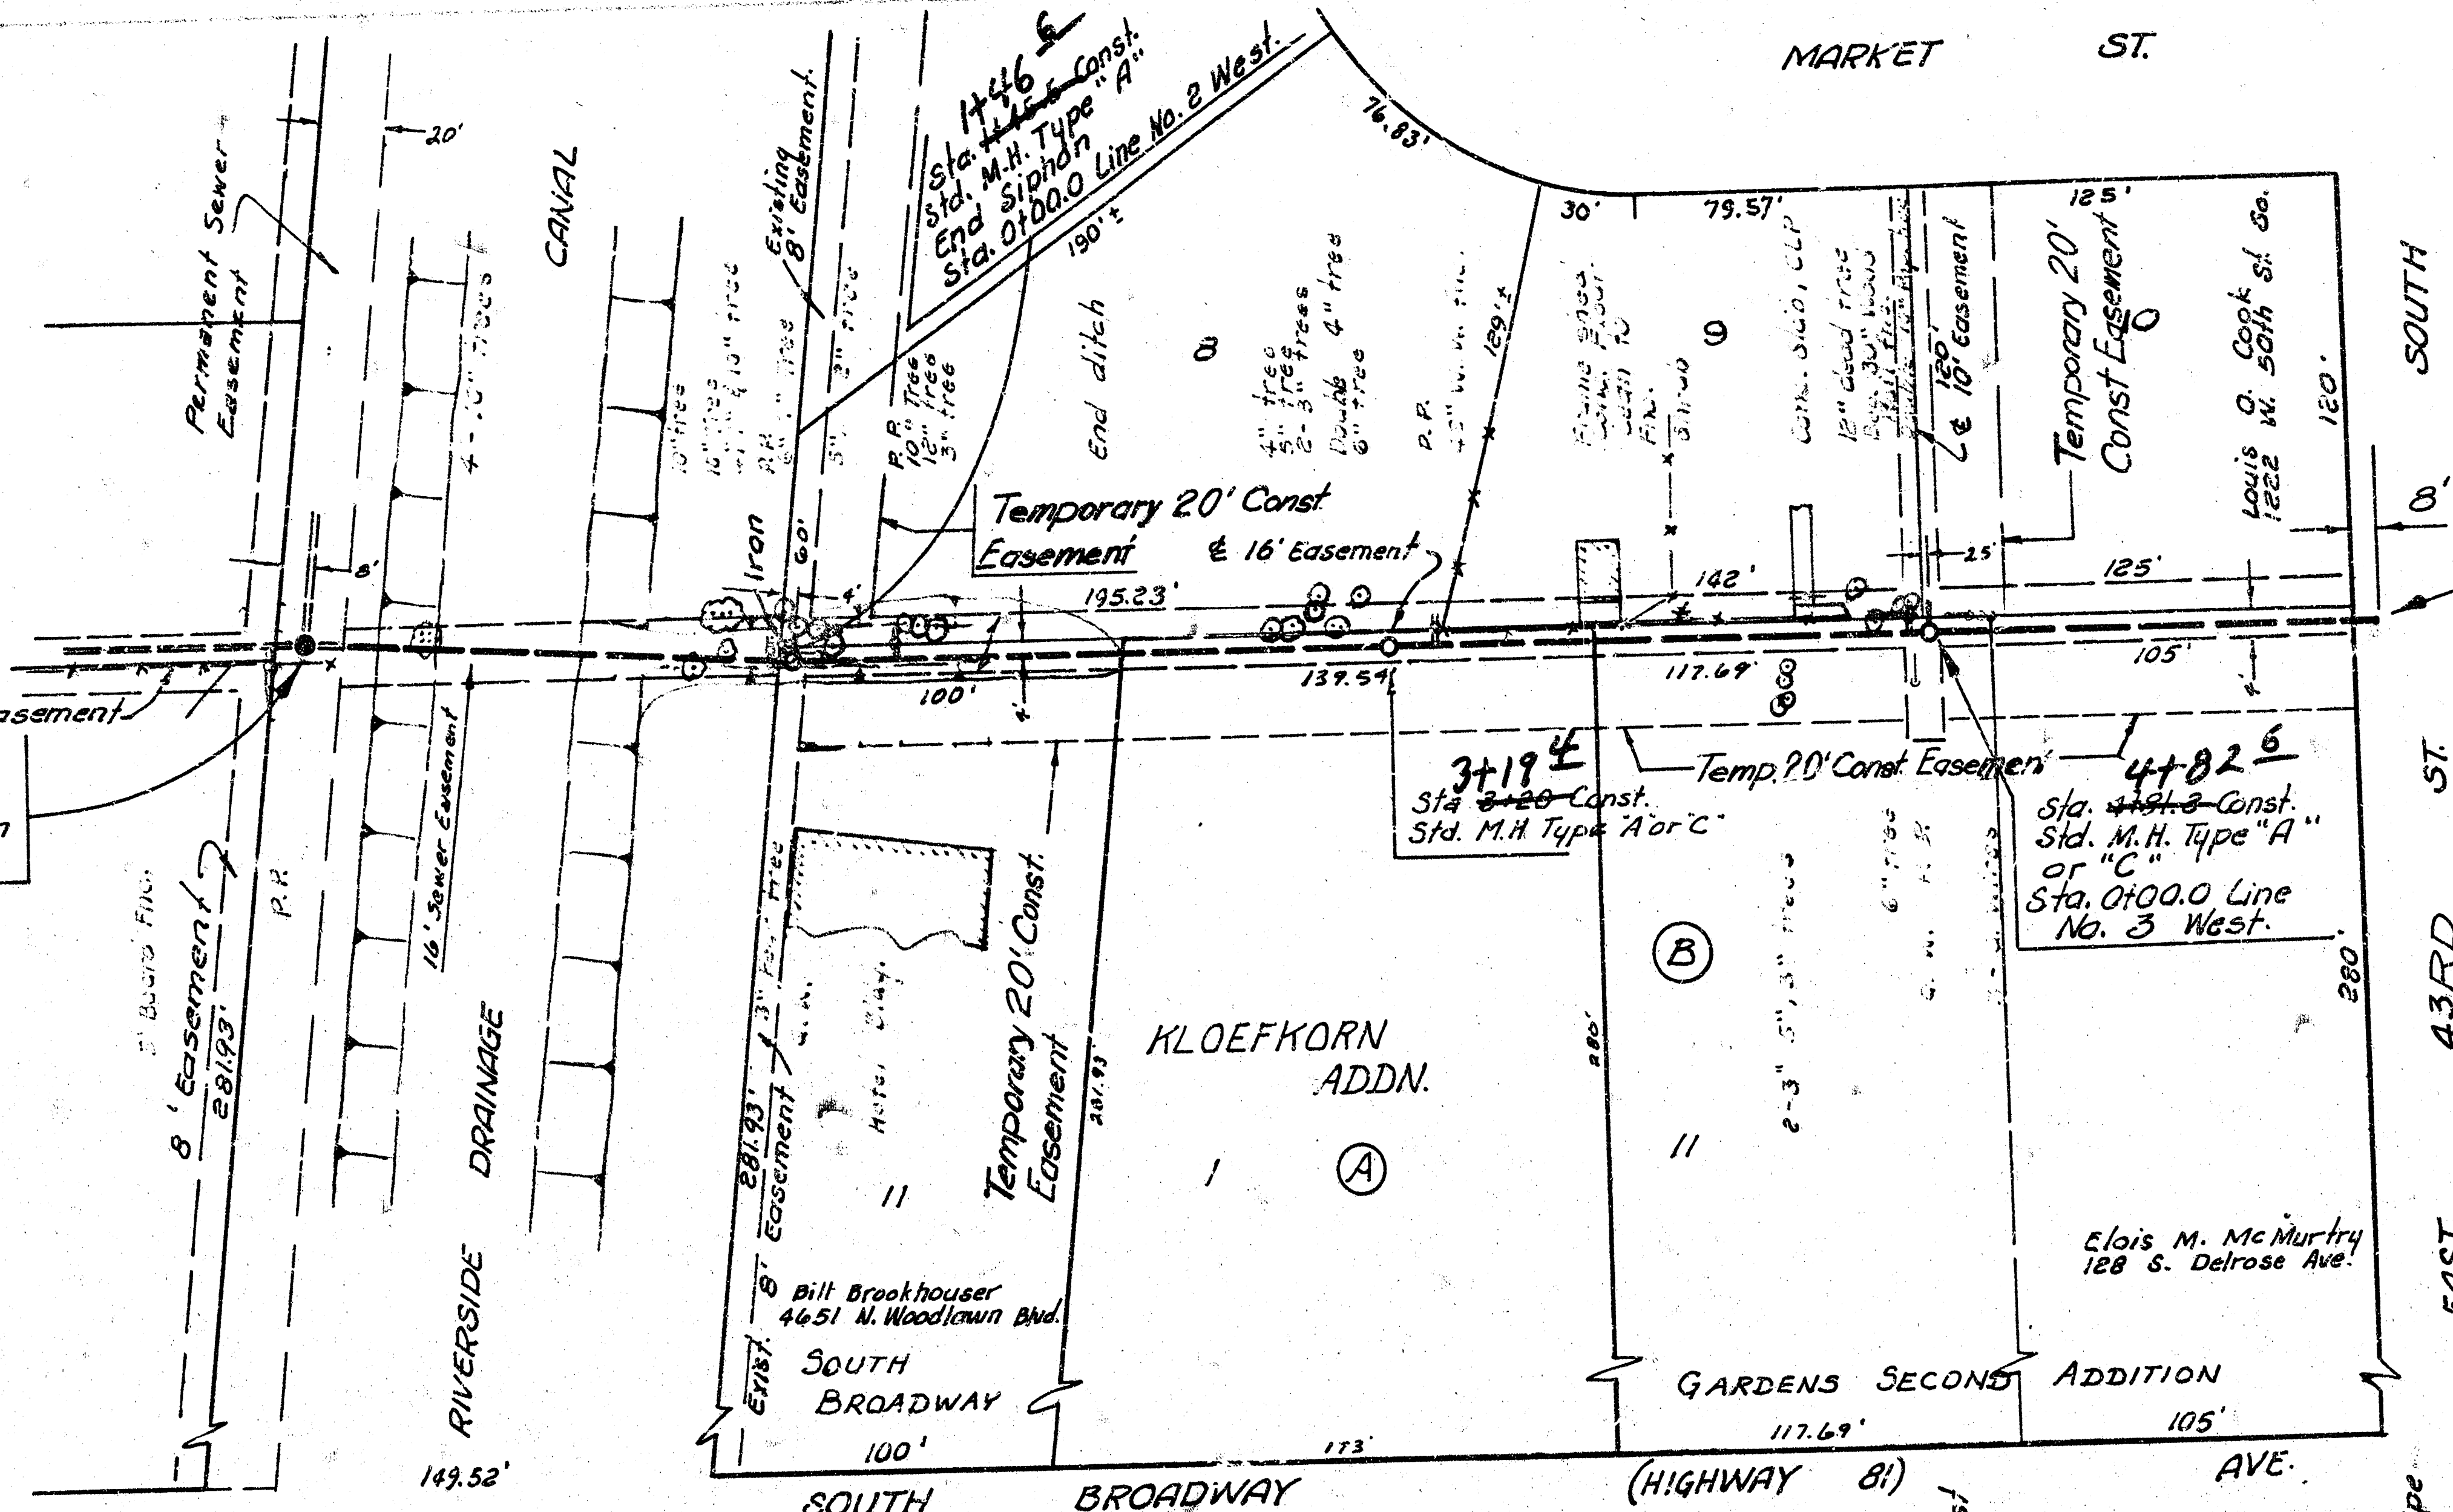


Plan Scale 1" = 40' Horiz.
Profile Scale 1" = 5' Vert.

NOTE:
Owner of lot 8 and the south
100 ft. of lot 11 Block B wants
all trees removed for fire waste
wood.
City lateral across south 100 ft.
of lot 11 Block B will cut Septic
tank main line and lateral field.

GENERAL NOTES


BACKFILL IN CHANNEL RIGHT-OF-WAY SHALL BE EXCAVATED MATERIAL COMPACTED TO A MINIMUM DENSITY
OF 90% OF STANDARD DENSITY. COMPACTION OF EXCAVATED BACKFILL MATERIAL SHALL BE CONSIDERED
AS SUBSIDIARY TO THE OTHER ITEMS OF WORK. EMP SUM BID FOR SIFON DOES NOT INCLUDE MANHOLE.
MANHOLE WILL BE PAID FOR SEPARATELY. CONTRACTOR WILL BE REQUIRED TO NOTIFY PROPERTY OWNERS
ADJACENT TO AND ALONG THE NORTH SIDE OF THE RIVERSIDE DRAINAGE CANAL SUFFICIENTLY IN AD-
VANCE OF CONSTRUCTION OF LINE #2 SUCH THAT THESE PROPERTY OWNERS MAY HAVE THE OPPORTUNITY
TO TRANSPLANT TREES AND TREES OR OTHERWISE SALVAGE IMPROVEMENTS ENDANGERED BY THE SEWER
CONSTRUCTION. CONTRACTOR WILL ALSO BE REQUIRED TO NOTIFY THE OWNER OF LOT 6, BLOCK 8
OF THE NECESSITY OF MOVING THE SHED WITH A CONCRETE FLOOR PRIOR TO CONSTRUCTION OF THE SEWER.
OWNER SHALL BE GIVEN AN OPPORTUNITY TO MOVE THIS SHED WITH A CONCRETE FLOOR AS A PART OF THIS
CONTRACT IF IT IS NOT MOVED BY THE PROPERTY OWNER. THE SHED AND ITS CONCRETE FLOOR IN ITS
NEW LOCATION SHALL BE EQUAL TO OR BETTER THAN ITS CONDITION IN THE ORIGINAL LOCATION. THE
BID PRICE OF SHED MOVED (CONCRETE FLOOR) SHALL INCLUDE ALL COSTS FOR MOVING THIS SHED
INCLUDING REMOVING AND REPLACING THE CONCRETE FLOOR.

NOTE:
Use mechanical
joints in fittings
in siphon.

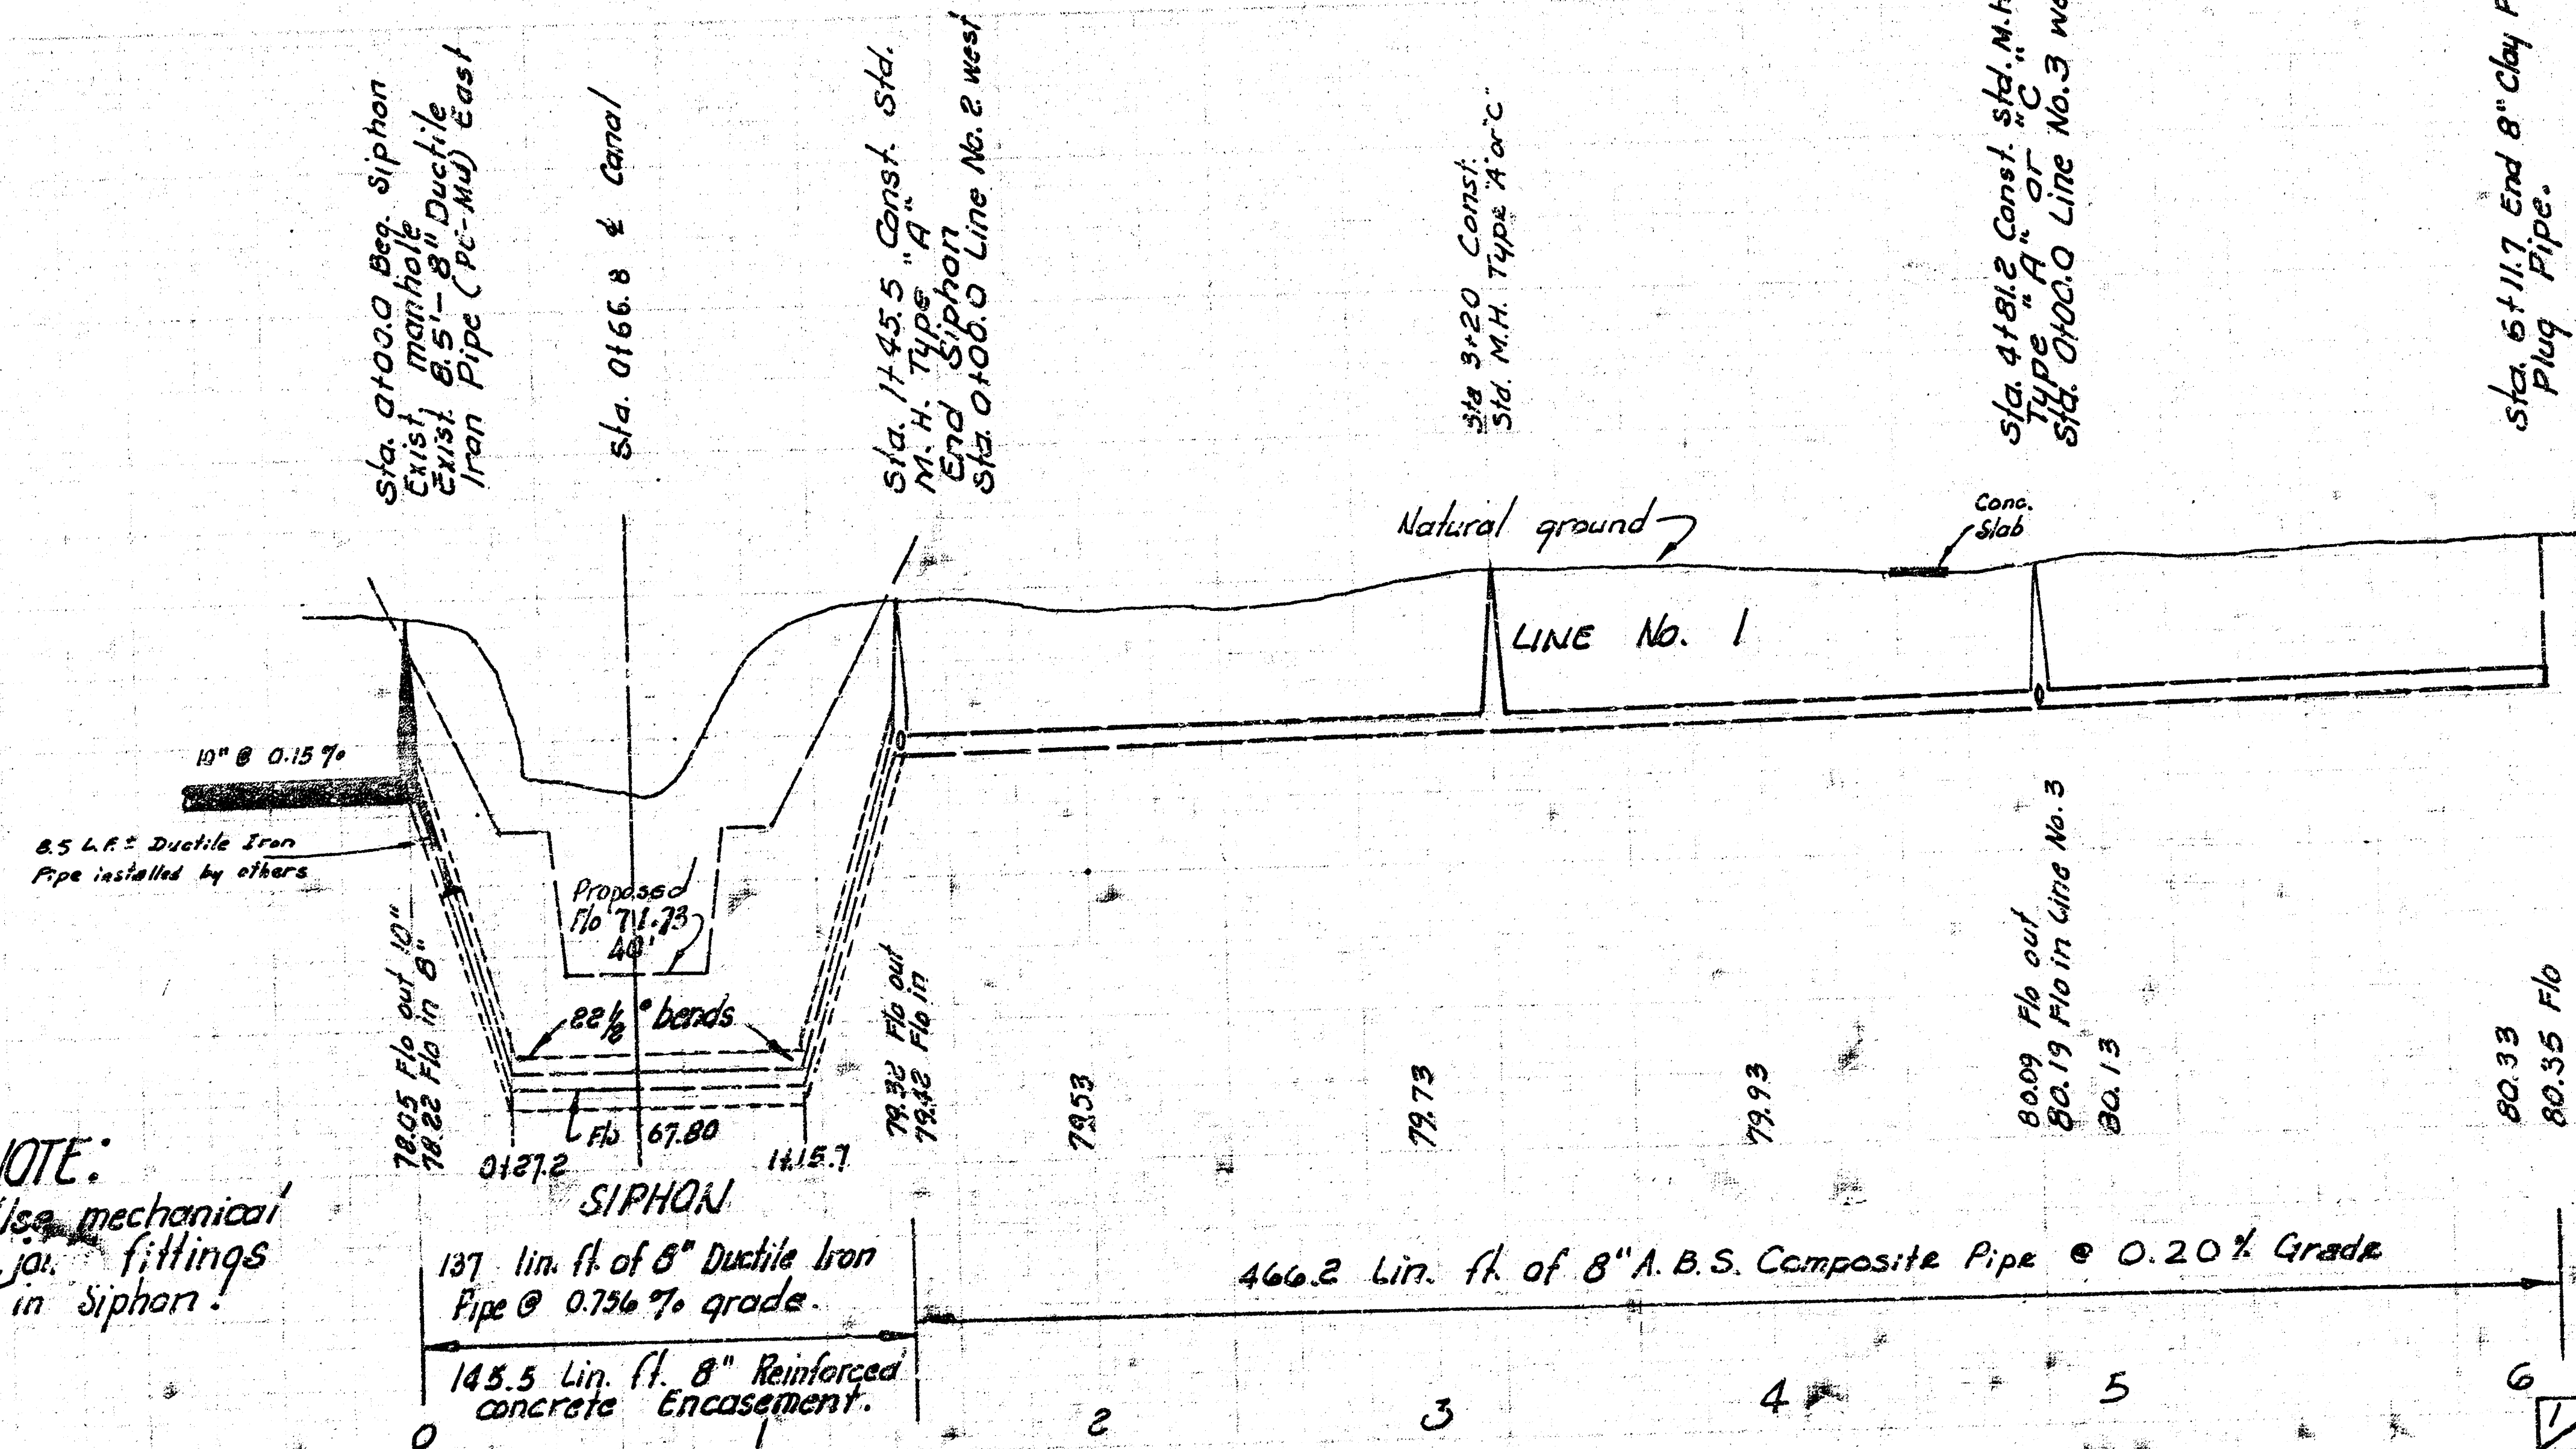



As built 4-27-77

LAT. 6, MAIN 2, S. W. INTERCEPTOR SEWER	
CITY OF WICHITA, KANSAS	
R. W. LINN	CITY ENGINEER
MARCH 1975	PROJECT NO. DBKL 57 20 2

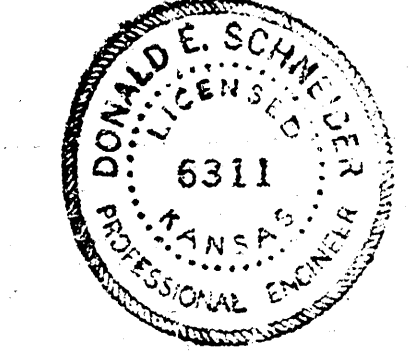

B. M. 85.98 R. R. Spike N. W.
side P. Pole on S. E. cor.
Main & 43rd St. So.

SOUTH BROADWAY GARDENS SECOND ADDITION

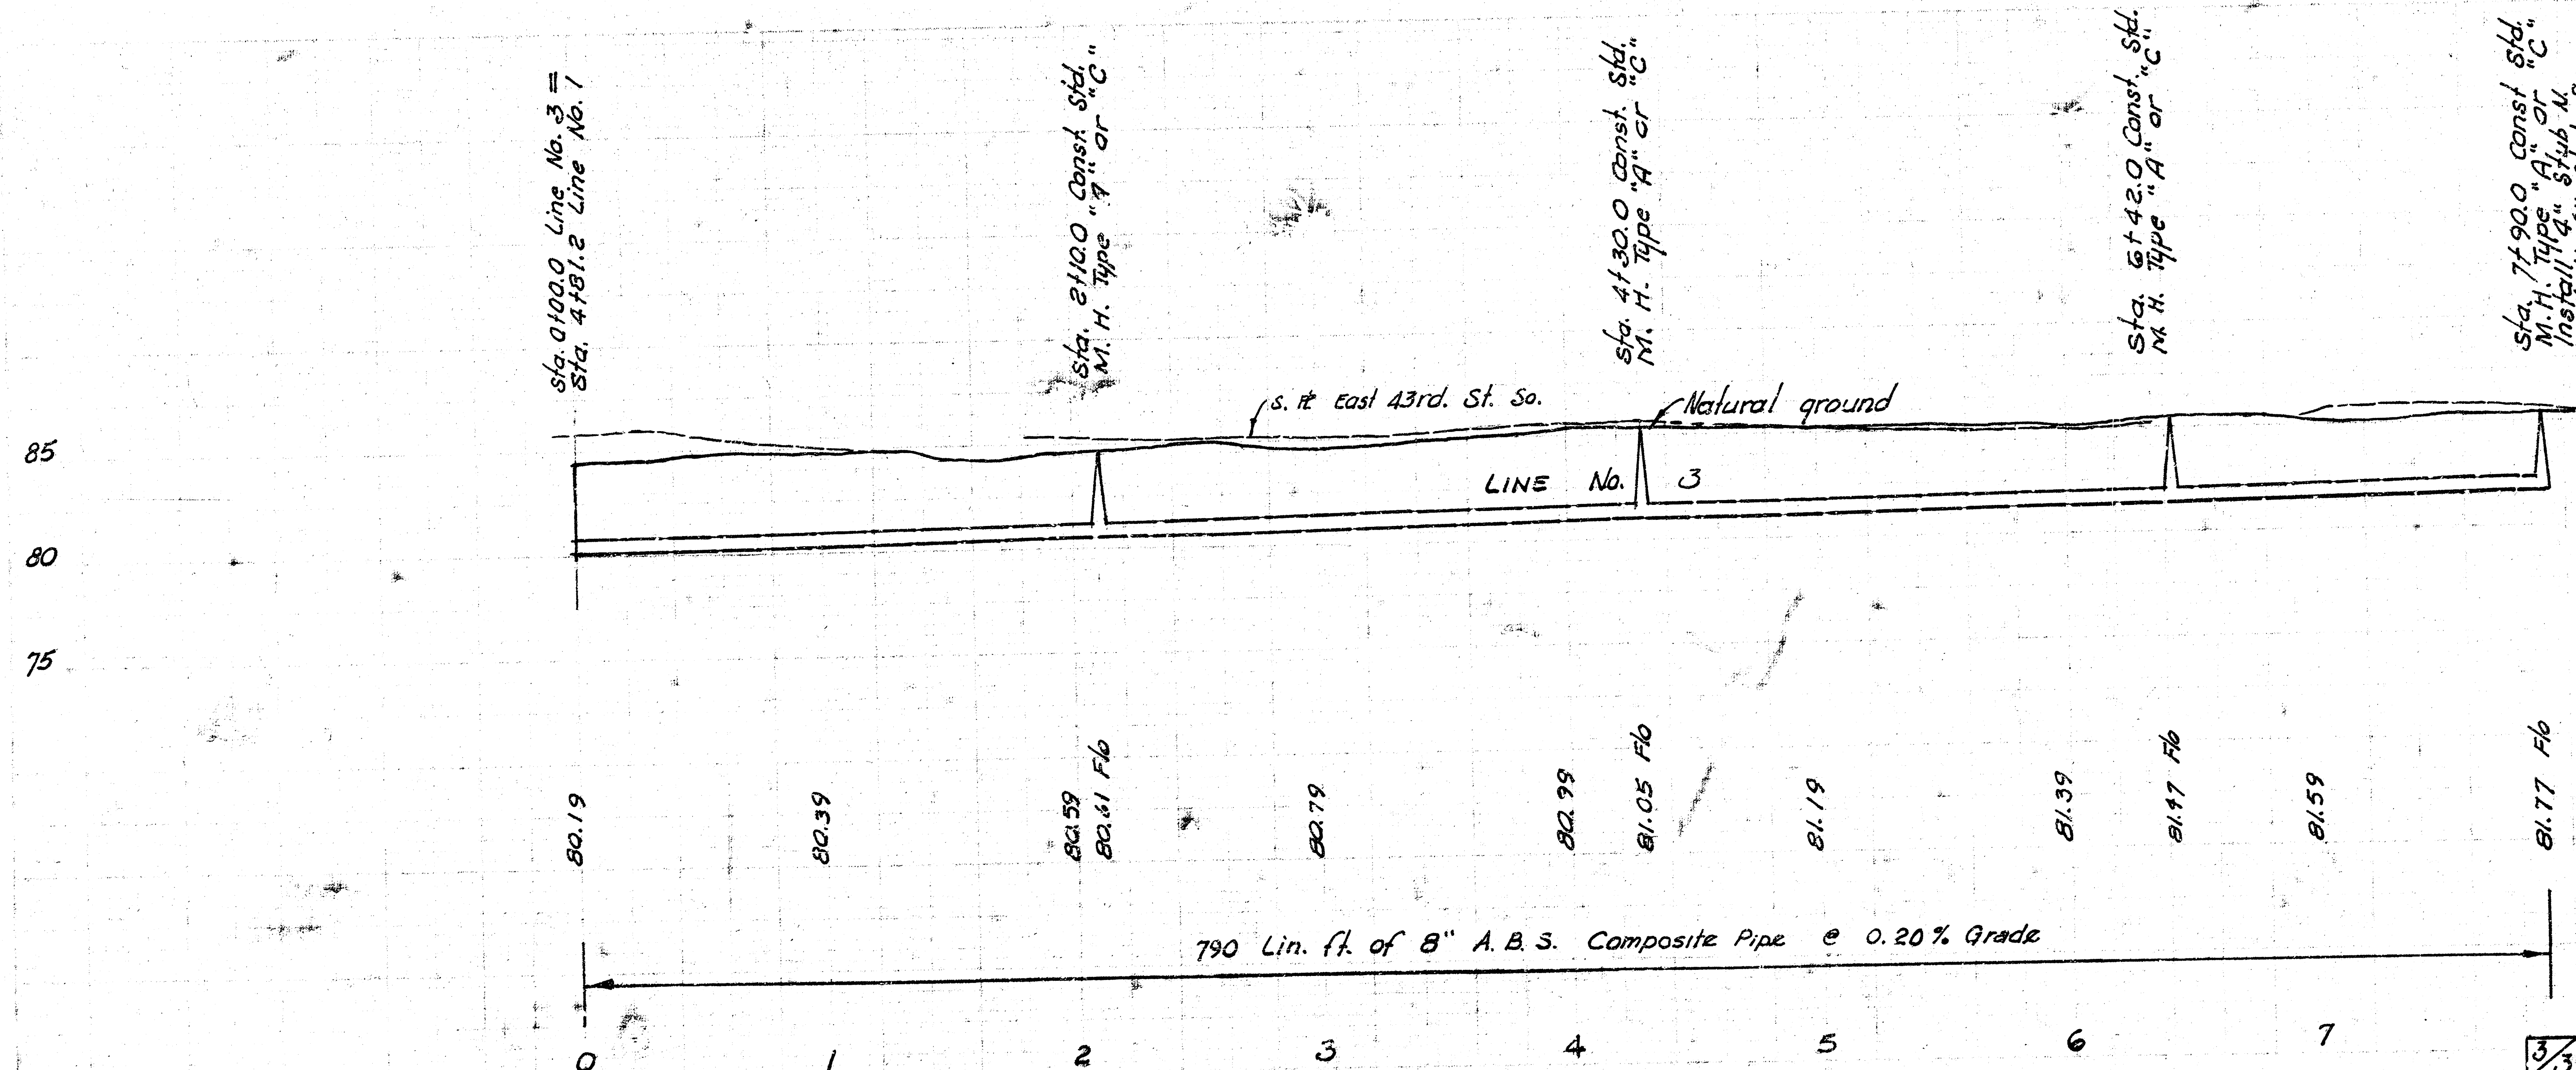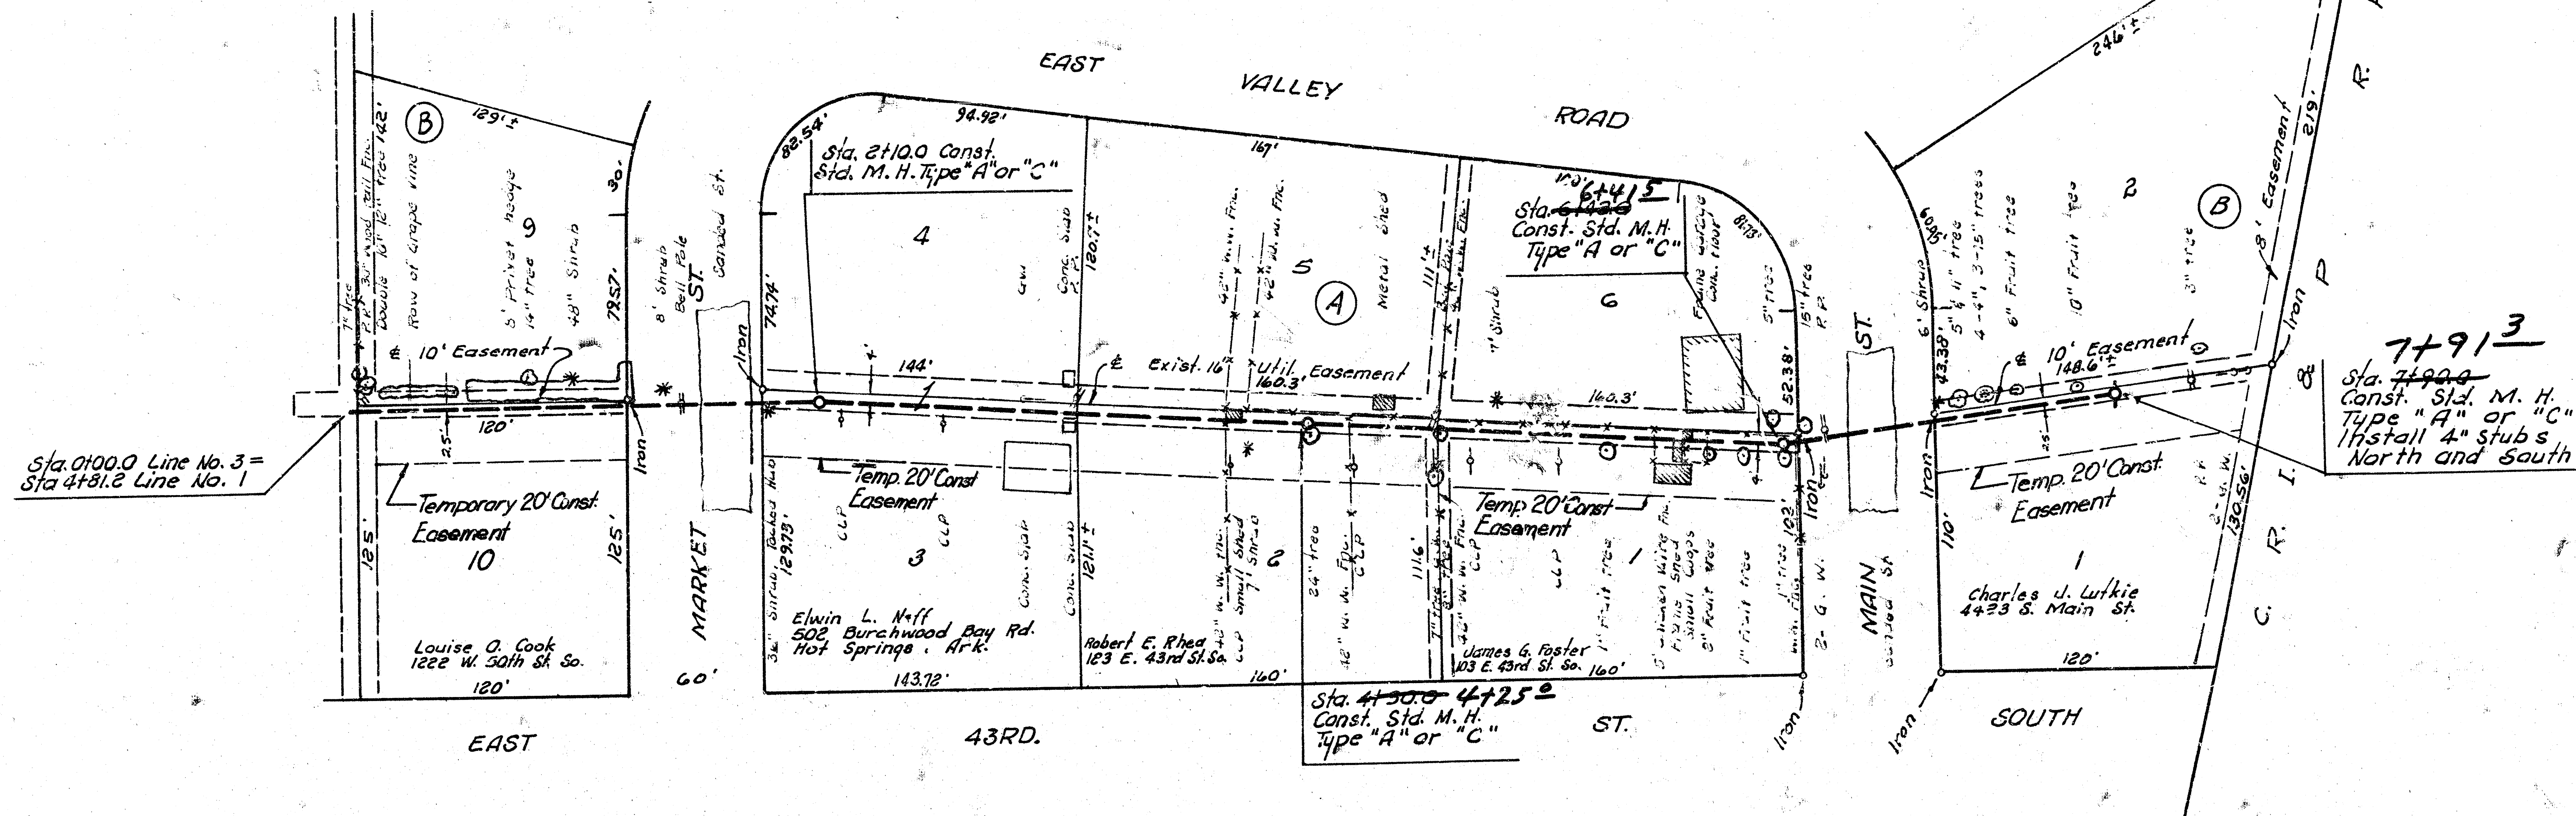

LAT. 6, MAIN 2, S. W. INTERCEPTOR SEWER
PROJECT NO DBKL 572023