



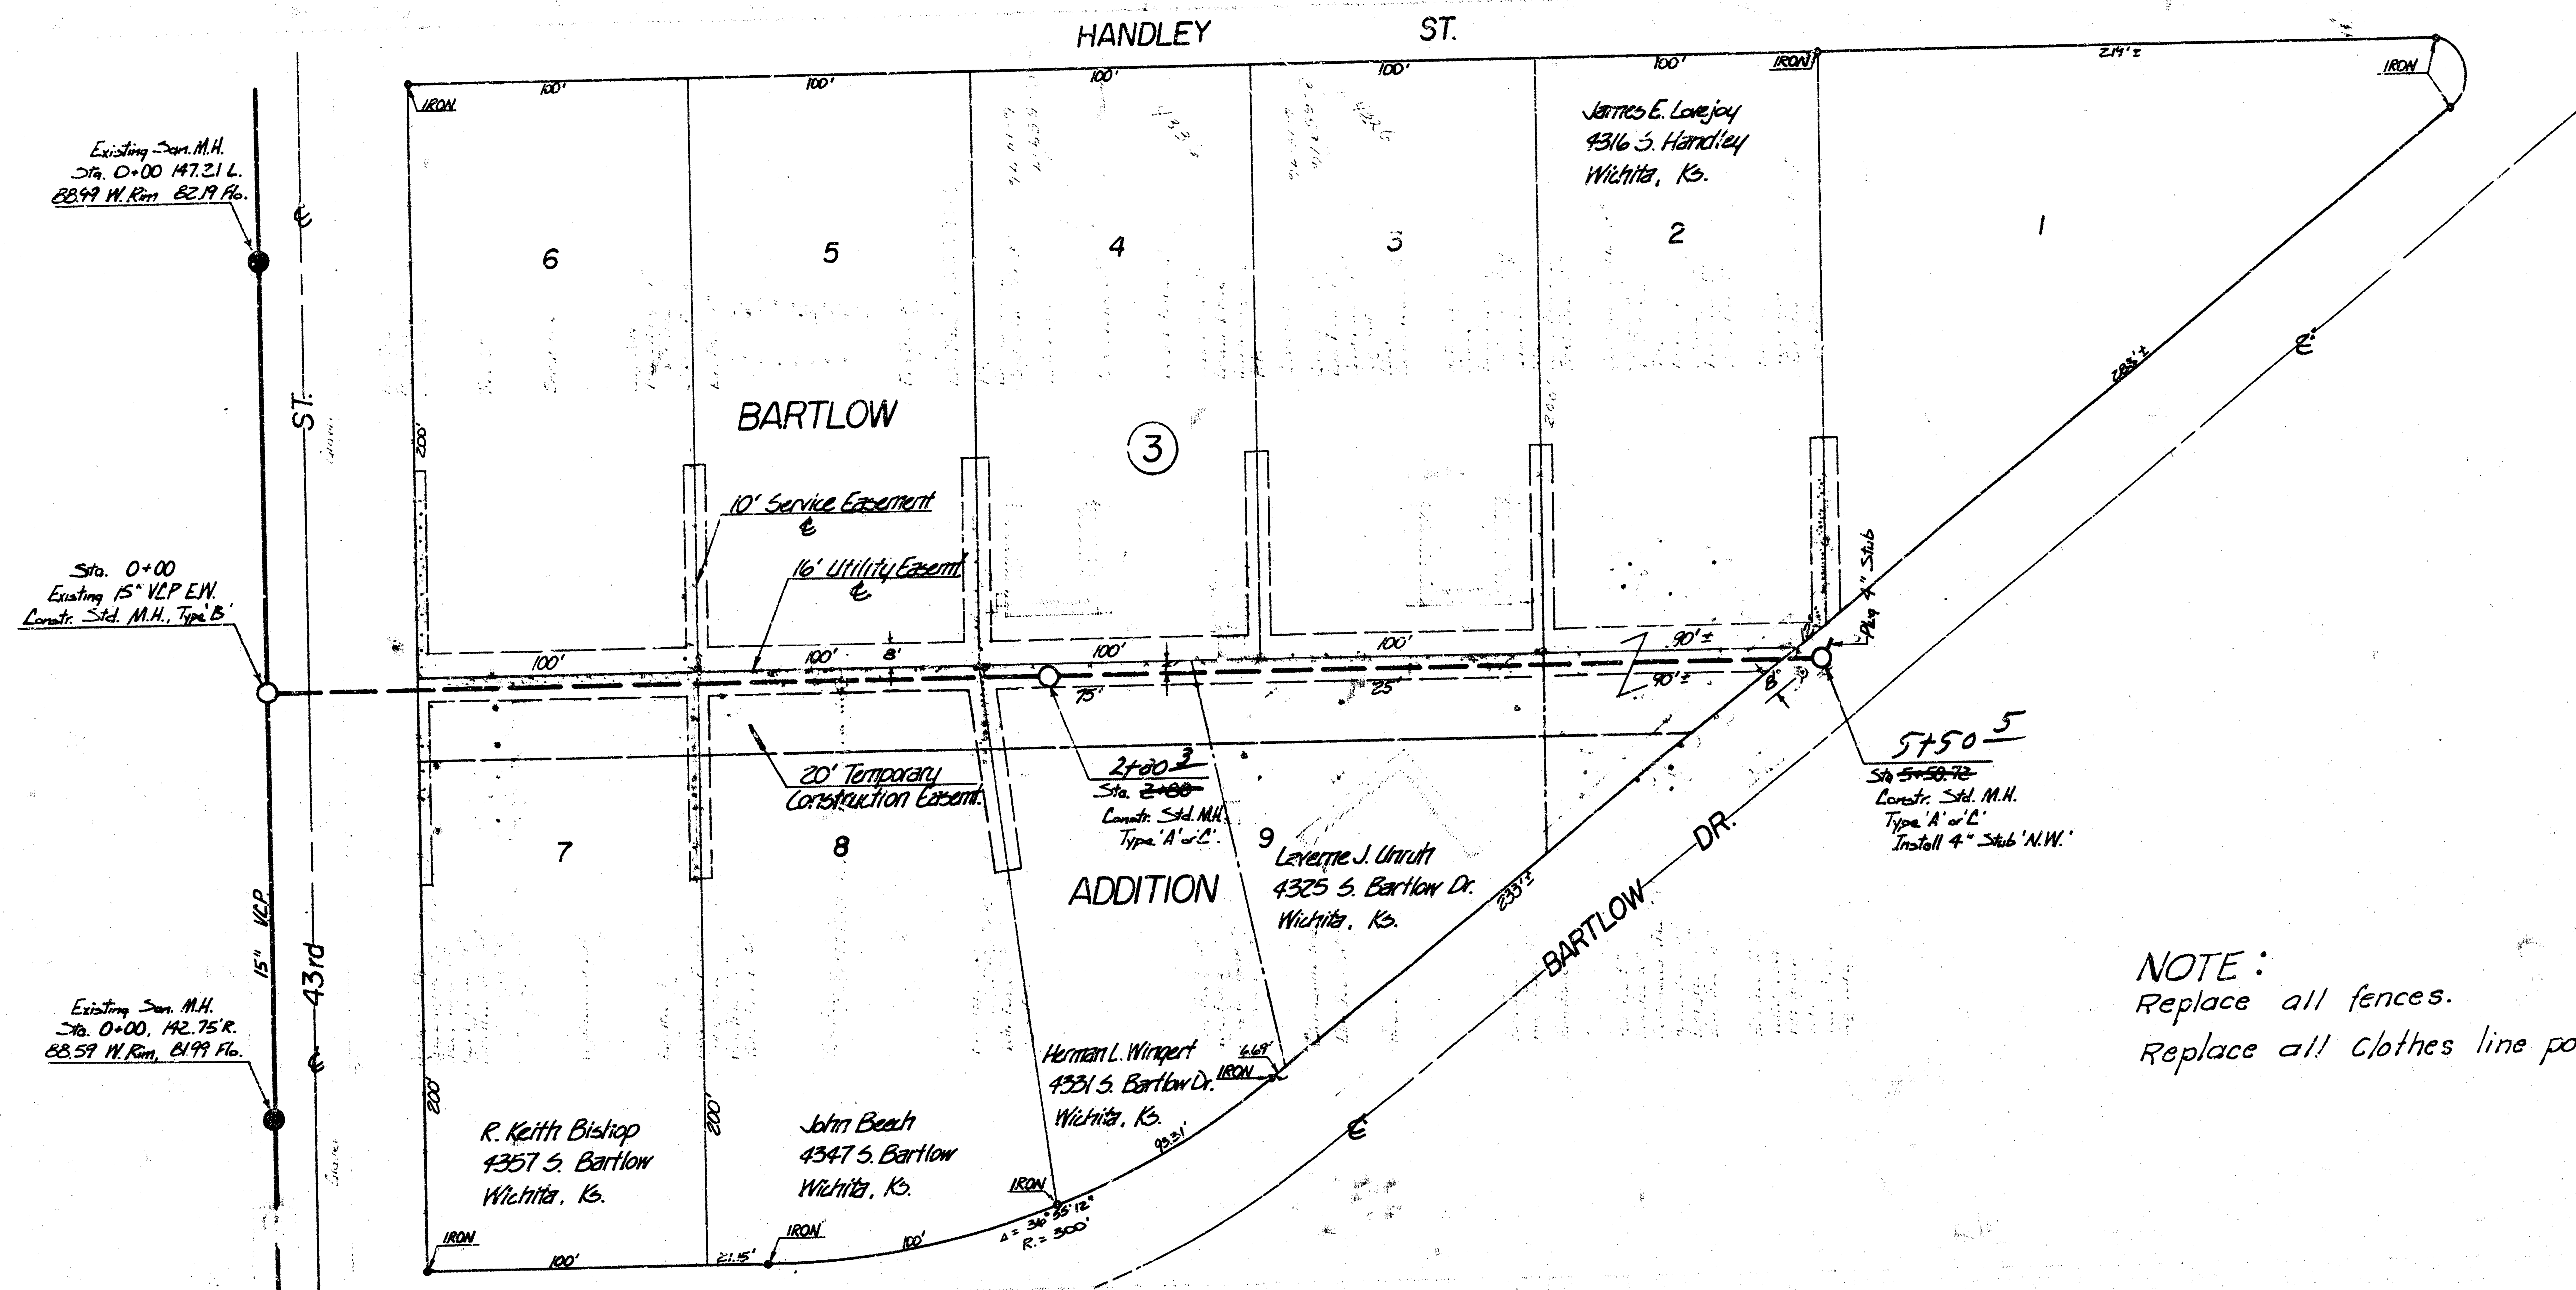

Plan Scale 1" = 40'
Profile Scale 1" = 40' Hor.
1" = 5' Vert.

B.M. 88.01 City Sid. Disc. 42.8' S. & 48' E. of E. 43rd St. & Seneca
B.M. 89.82 R.R. Spk S. Face Street Lite Pole N.E. Cor. Handley-43rd St. So.

NOTE:
Replace all fences.
Replace all clothes line poles.

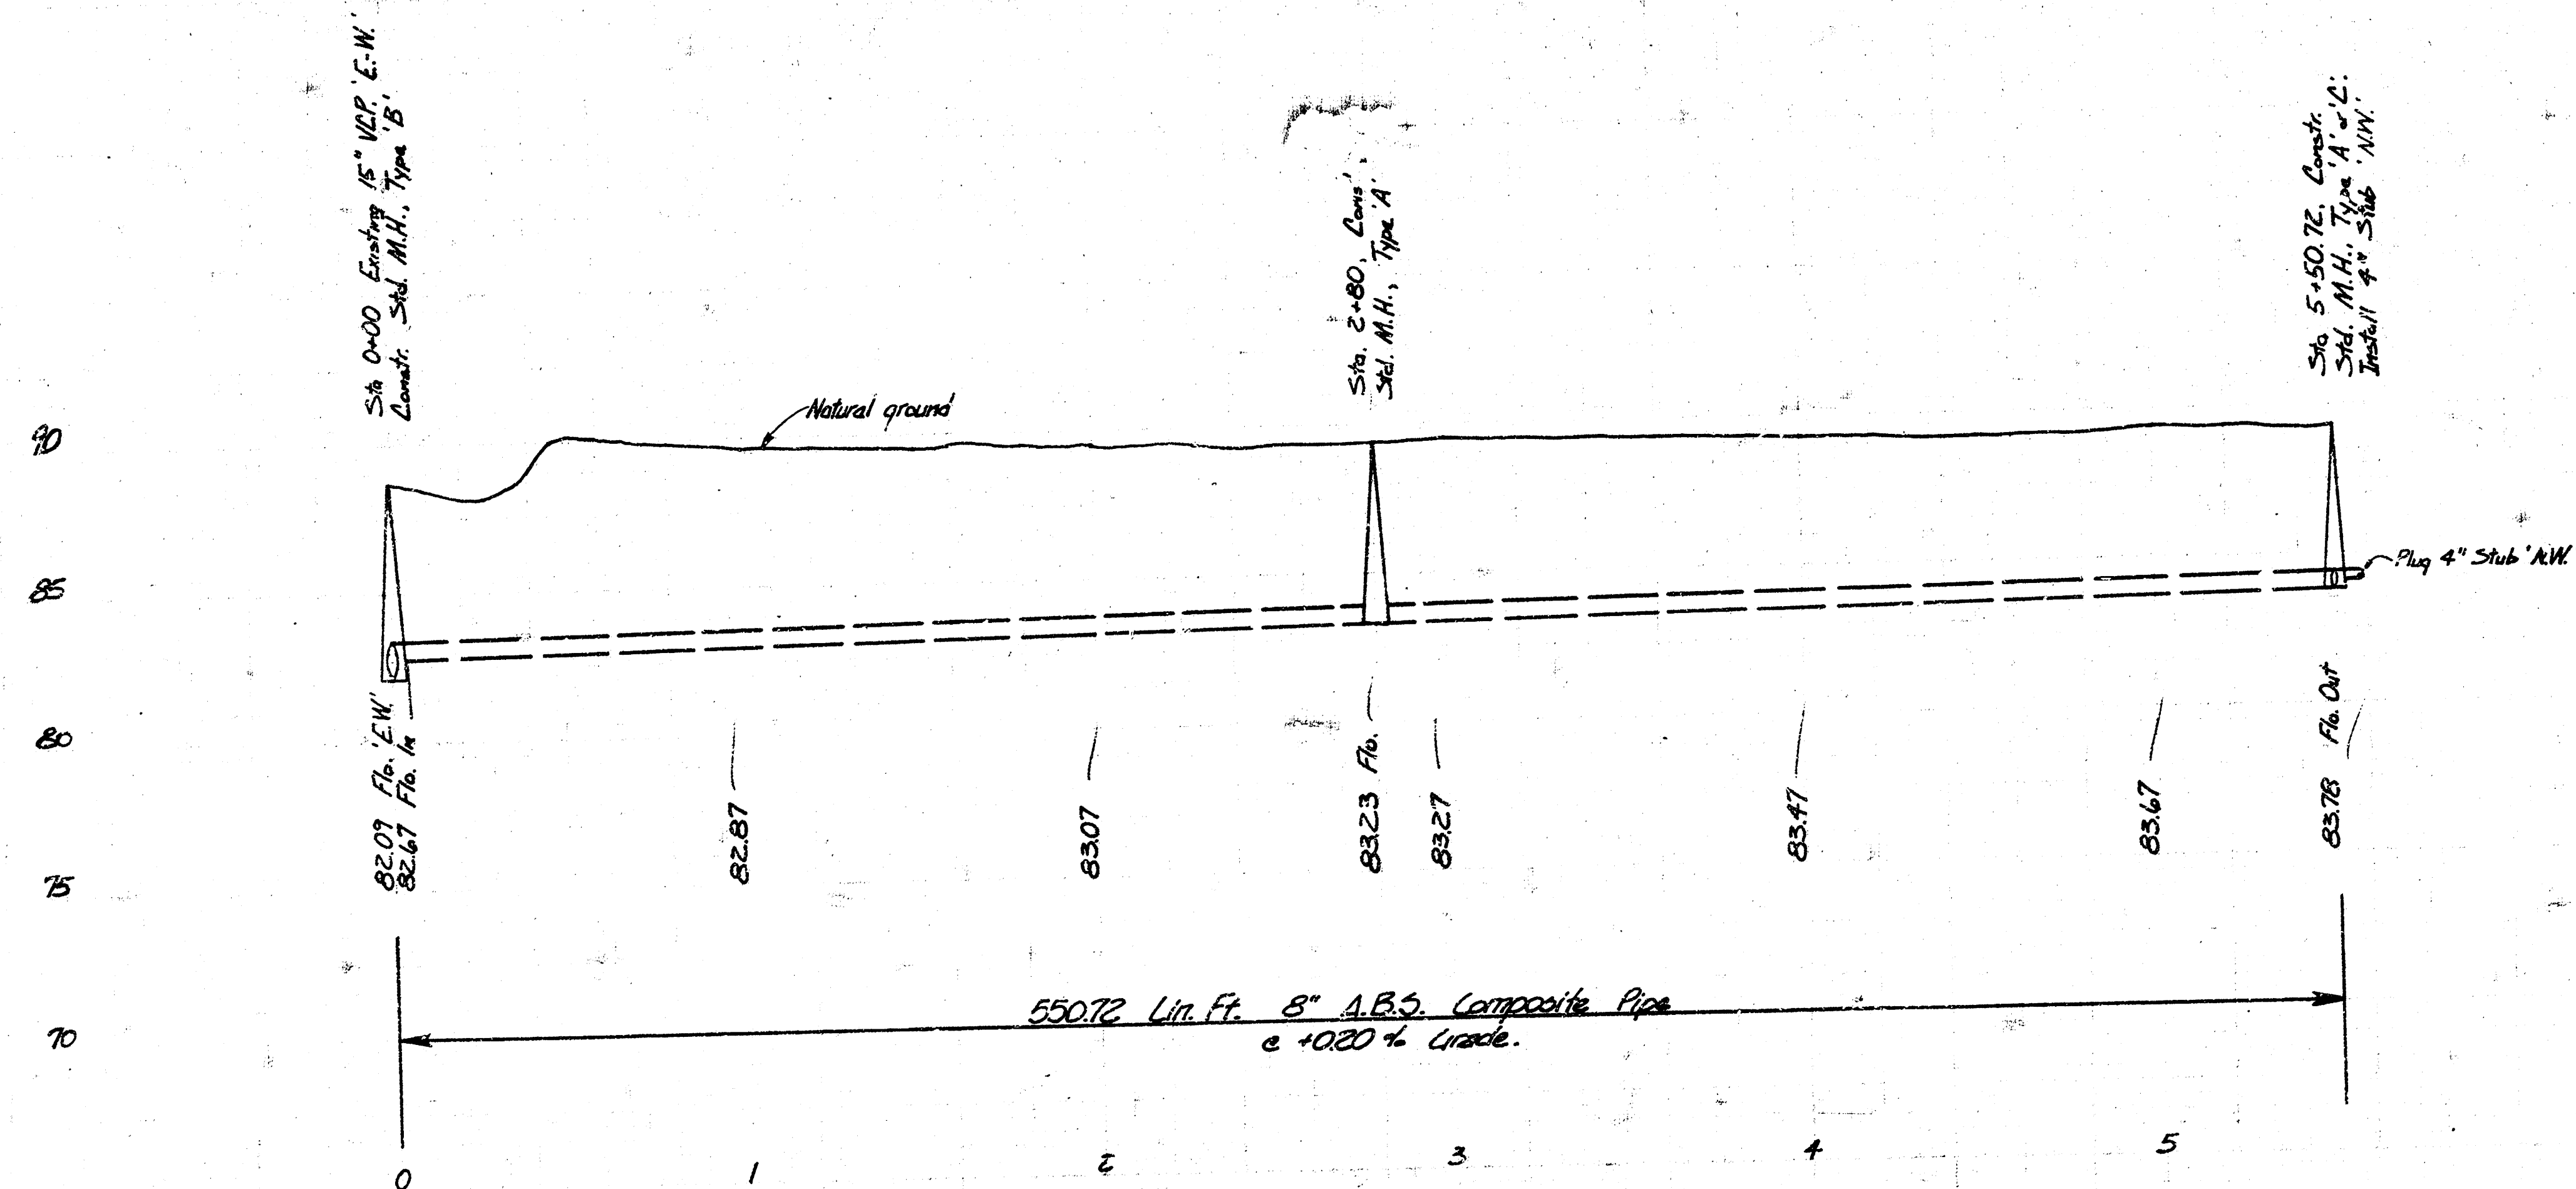

As Built 6-23-76

LAT. 10, MAIN 2, S.W.1.
CITY OF WICHITA, KANSAS
R. W. LINN
PROJECT NO. DBKL 575027
MARCH 1976