


LATERAL 20, MAIN 2, SOUTHWEST INTERCEPTOR SEWER **CITY OF WICHITA, KANSAS**

R. W. BRUGGEMAN: DIRECTOR OF ENGINEERING/CITY ENGINEER
PROJECT NO. 468-76-245-81086-000-000-001

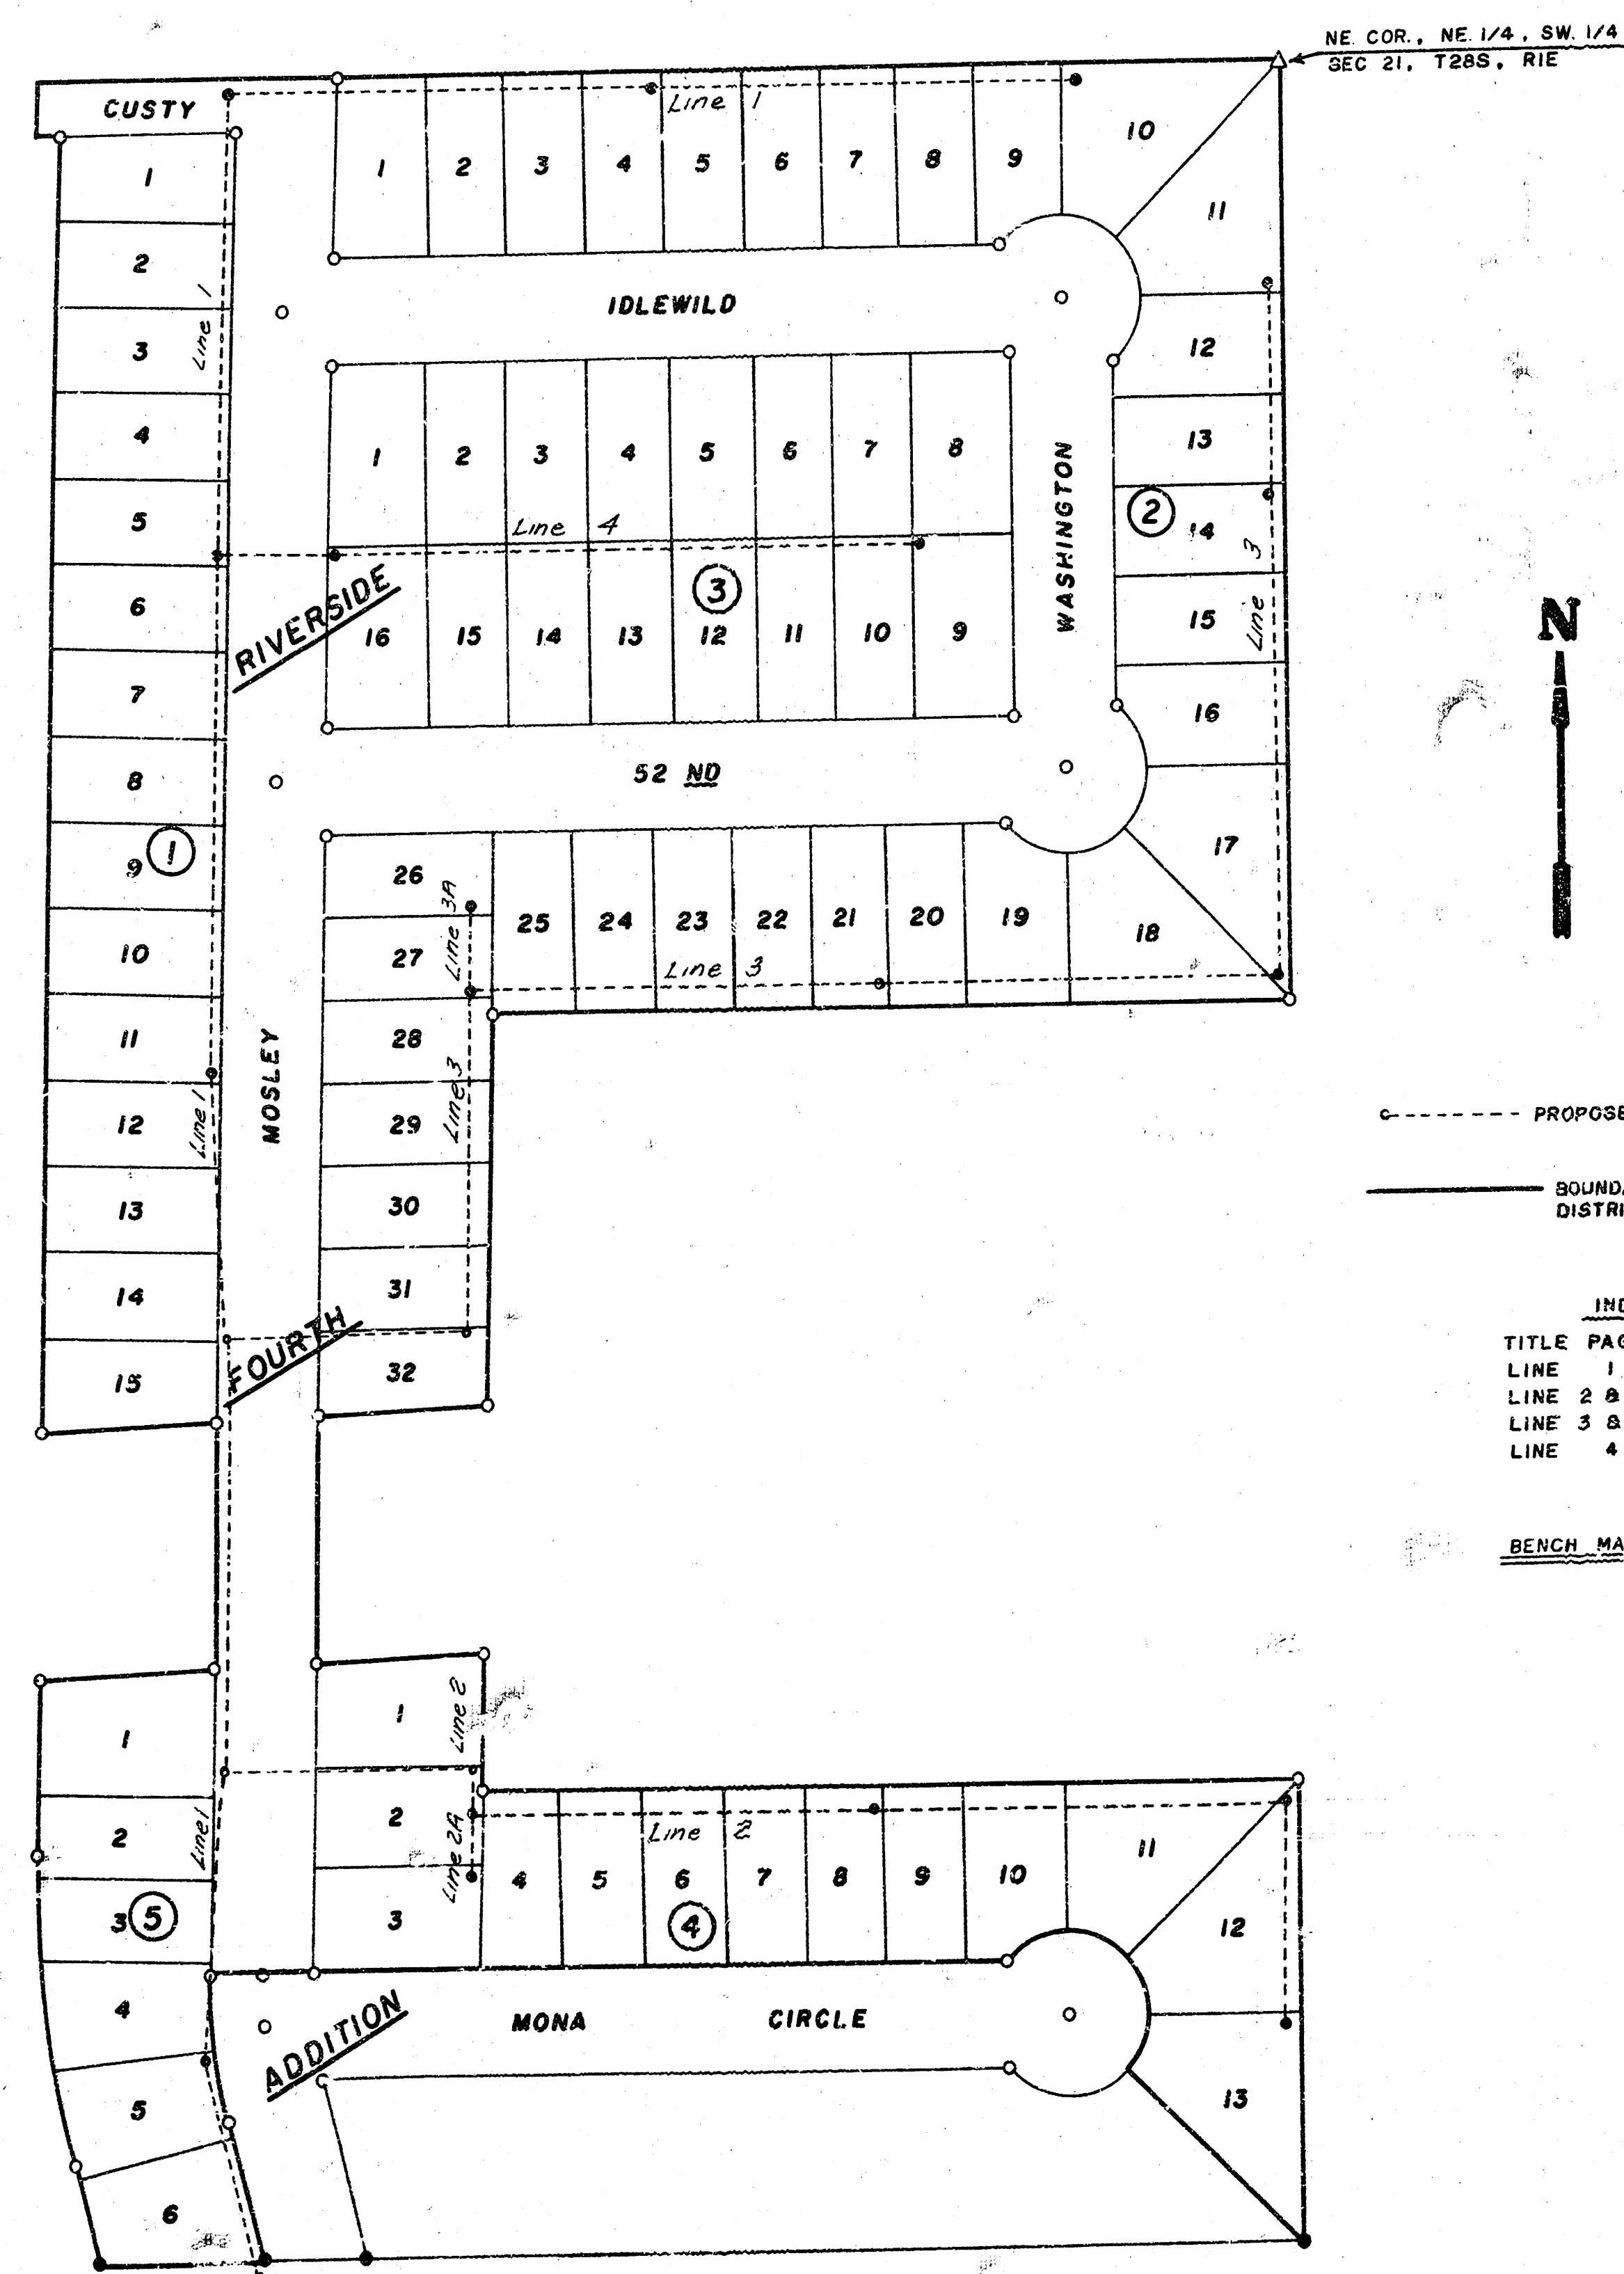

----- PROPOSED SAN SEWER
 _____ BOUNDARY OF IMPROVEMENT DISTRICT


INDEX TO SHEETS		
TITLE PAGE	---	SHEET
LINE 1	---	SHEET 2 & 3
LINE 2 & 2A	---	SHEET 4
LINE 3 & 3A	---	SHEET 5 & 6
LINE 4	---	SHEET 6

BENCH MARKS - 84.56' NW "M" IN MUELLER ON FIRE HYDRANT AT NW COR. OF MEAD & 53RD ST. SO.
 77.54' "D" SO. END OF CONC. HEADWALL, W. END OF KTA DRAINAGE SMT. APPROX. 126' W OF WL MOSLEY.

THE CONTRACTOR SHALL BE RESPONSIBLE FOR PRESERVING PROPERTY IRONS. THE CONTRACTOR SHALL BE REQUIRED TO RE-ESTABLISH ANY PROPERTY IRONS WHICH ARE DAMAGED OR DESTROYED BY HIS CONSTRUCTION OPERATIONS. SUCH IRONS SHALL BE RE-ESTABLISHED BY A LICENSED LAND SURVEYOR OR A LICENSED PROFESSIONAL ENGINEER IN ACCORDANCE WITH STATE LAWS.


NOTE: RISER PIPE SHALL BE INSTALLED TO SERVE INDIVIDUAL LOTS OR TRACTS IN CONJUNCTION WITH NEW SANITARY SEWER CONSTRUCTION, UNLESS OTHERWISE ORDERED BY THE ENGINEER, BECAUSE OF GROUND WATER, UNSTABLE SOIL OR UNUSUALLY DEEP CONSTRUCTION. RISER LOCATIONS SHALL BE AS APPROVED BY THE PROPERTY OWNER WITH THE CONCURRENCE OF THE ENGINEER. INSTALLATION OF RISERS ON SEWERS BECAUSE OF UNUSUAL DEPTH WILL BE REQUIRED WHEN THE SEWER IS DEEPER THAN TWELVE FEET (12'). THE CONTRACTOR WILL BE REQUIRED TO FILE WRITTEN DOCUMENTATION WITH THE ENGINEER IN A FORM APPROVED BY THE ENGINEER INDICATING THE LOCATIONS WHERE RISERS ARE TO BE INSTALLED AS REQUESTED BY THE PROPERTY OWNER OR HIS AUTHORIZED REPRESENTATIVE. RISER PIPE CONSTRUCTION SHALL CONFORM TO THE REQUIREMENTS AS SHOWN ON THE STANDARD RISER DETAIL SHEET.

As Built
 6-82
 J.L.L.

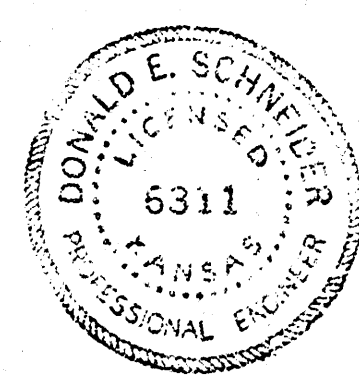




LATERAL 20, MAIN 2, S.W. I.
 PROJECT NO. 468-76-245-81086-000-000-001
 LINE 1 SHEET 3

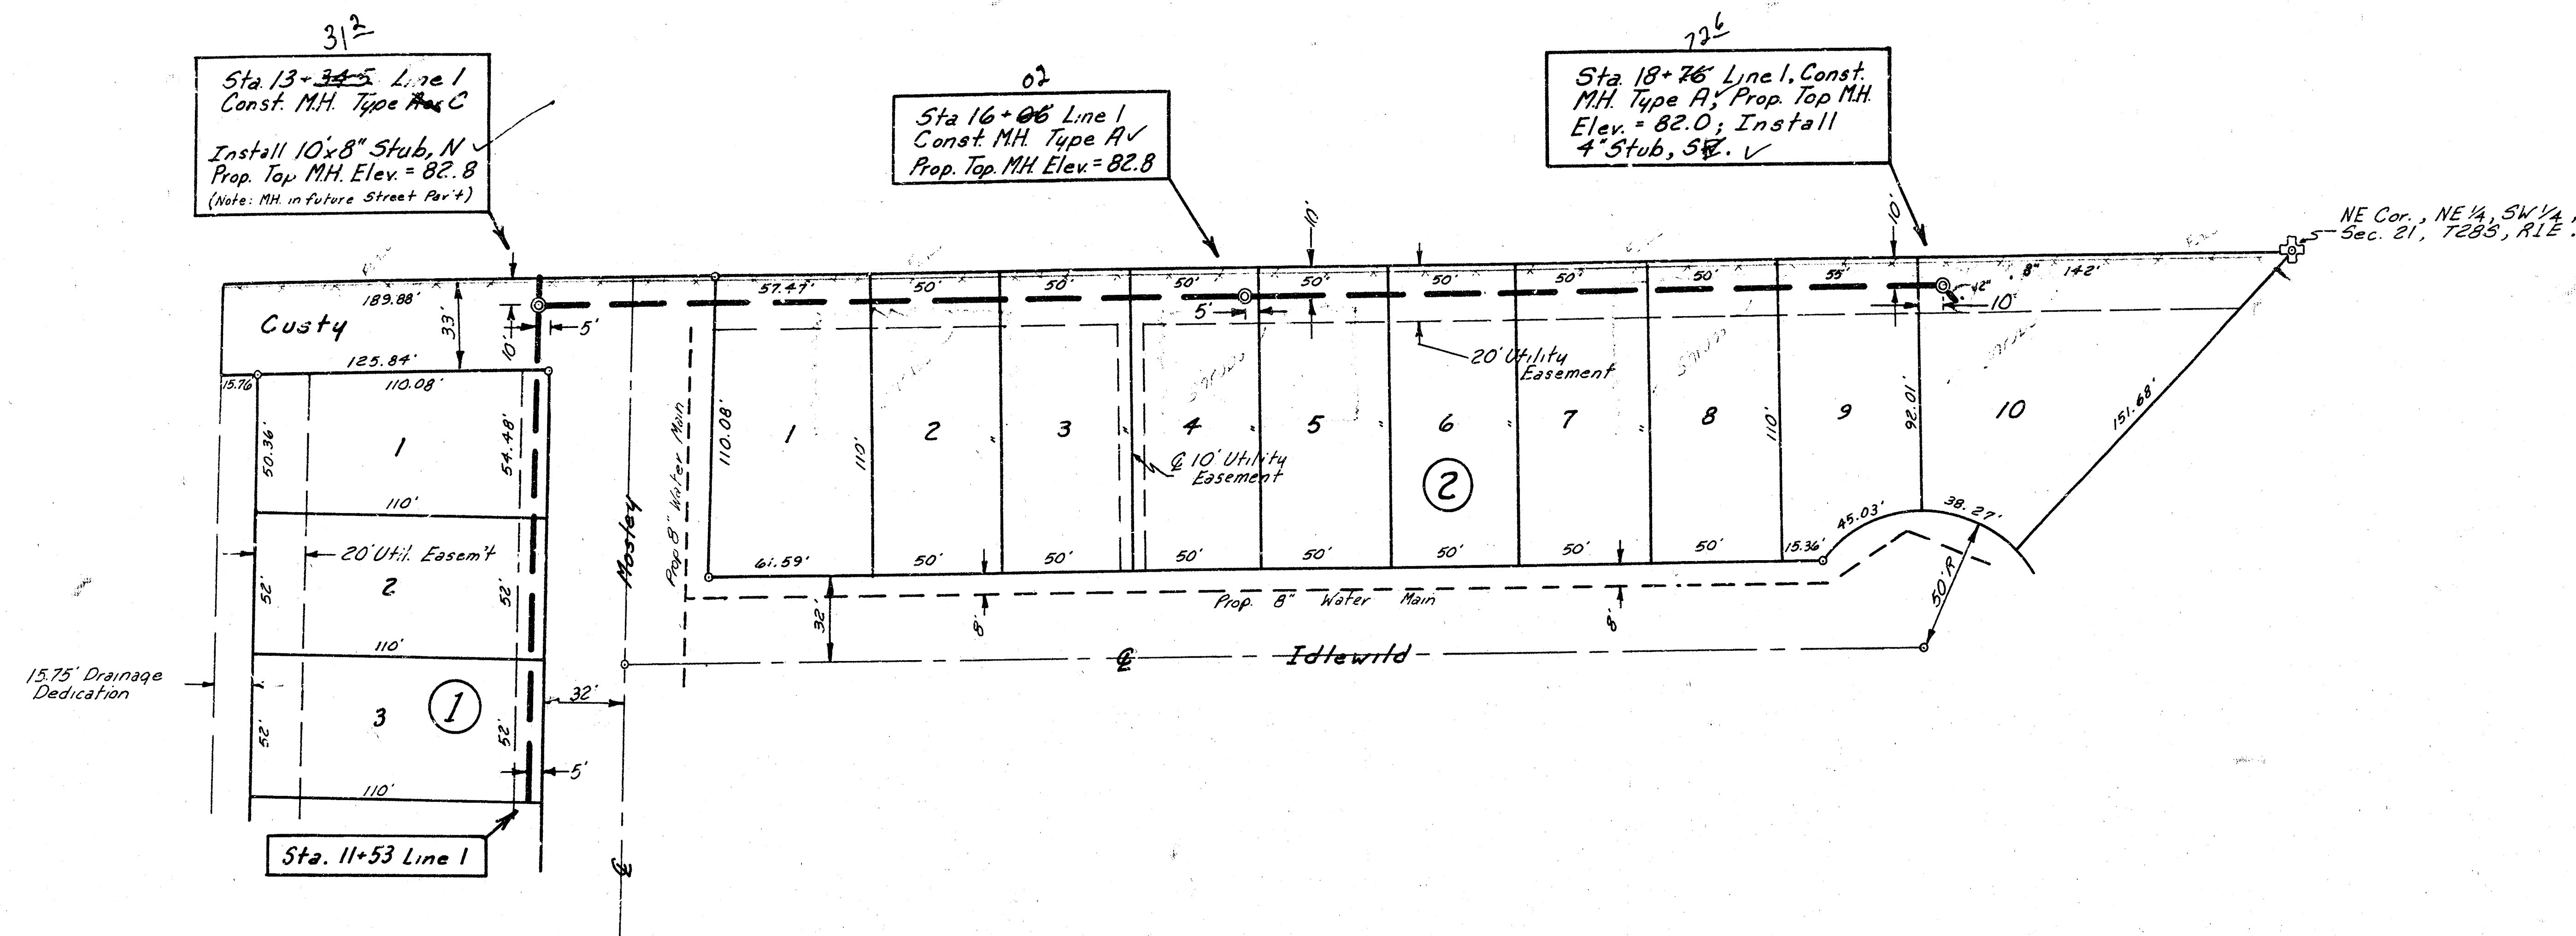




SCALE: 1" = 40' Plan
 1" = 40' Profile
 Vert. 1" = 5'

As Built
 6.82
 J.L.L.

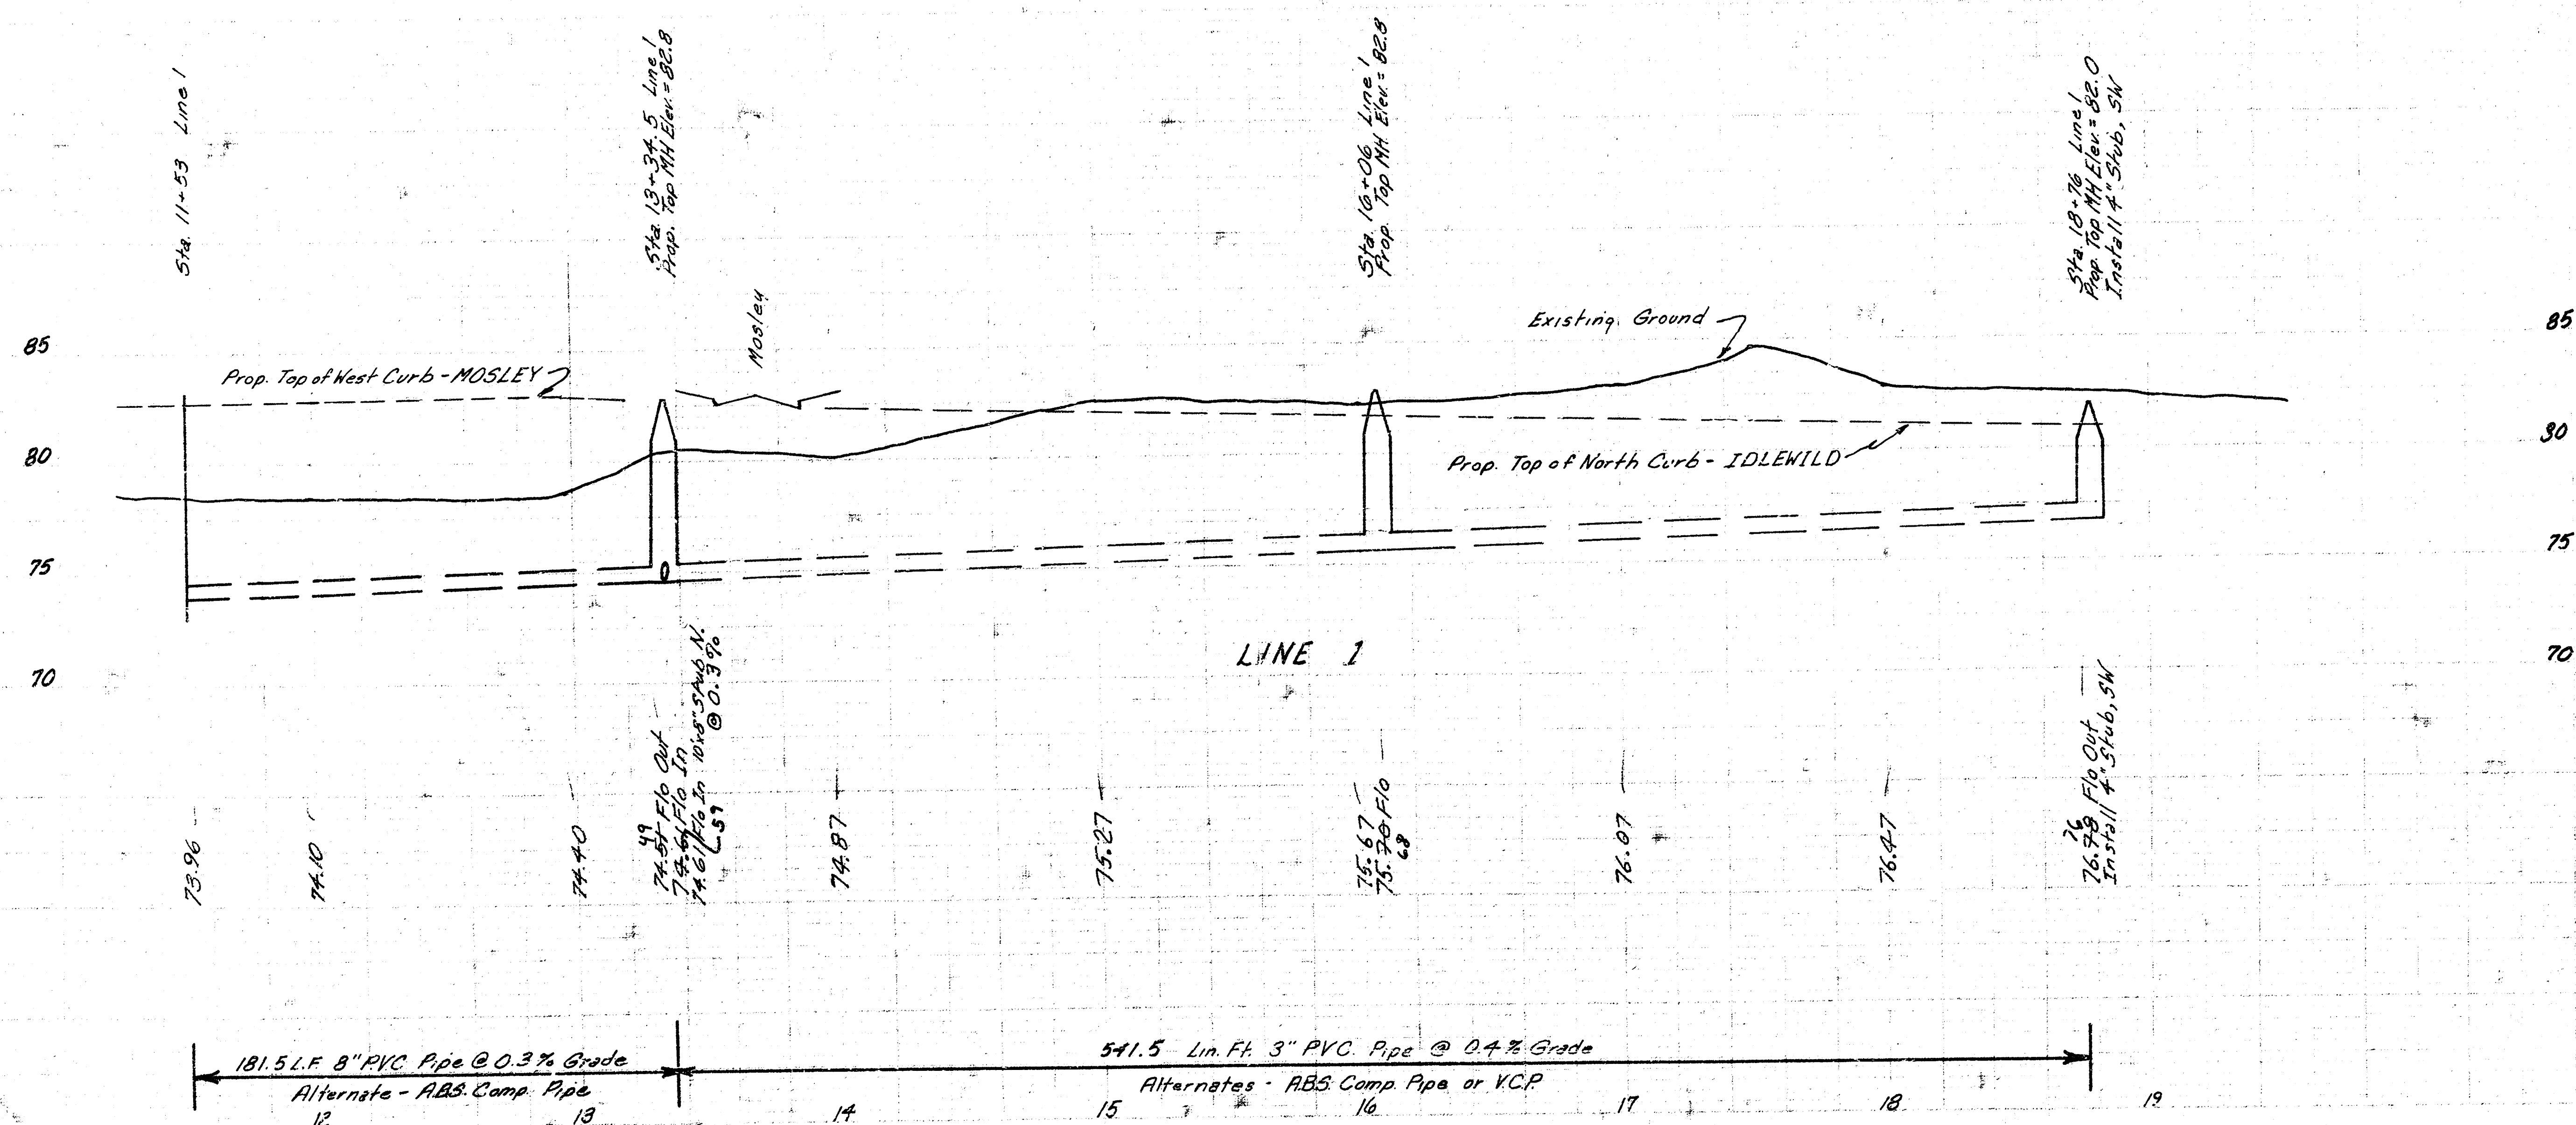

LATERAL 20, MAIN 2, S.W.I.
 PROJECT NO. 468-76-245-81086-000-000 001
 LINE 2 & 2A SHEET 4

SCALE: 1" = 40' Plan
 Horiz. 1" = 40' Profile
 Vert. 1" = 5' Profile

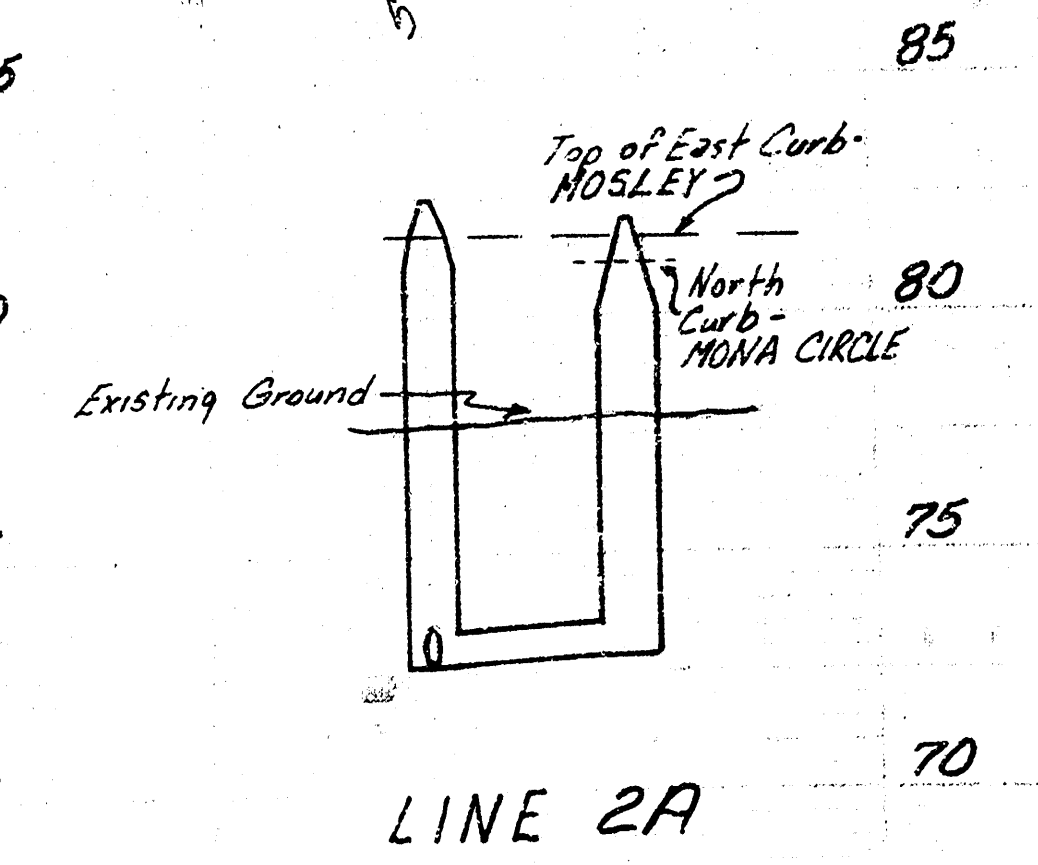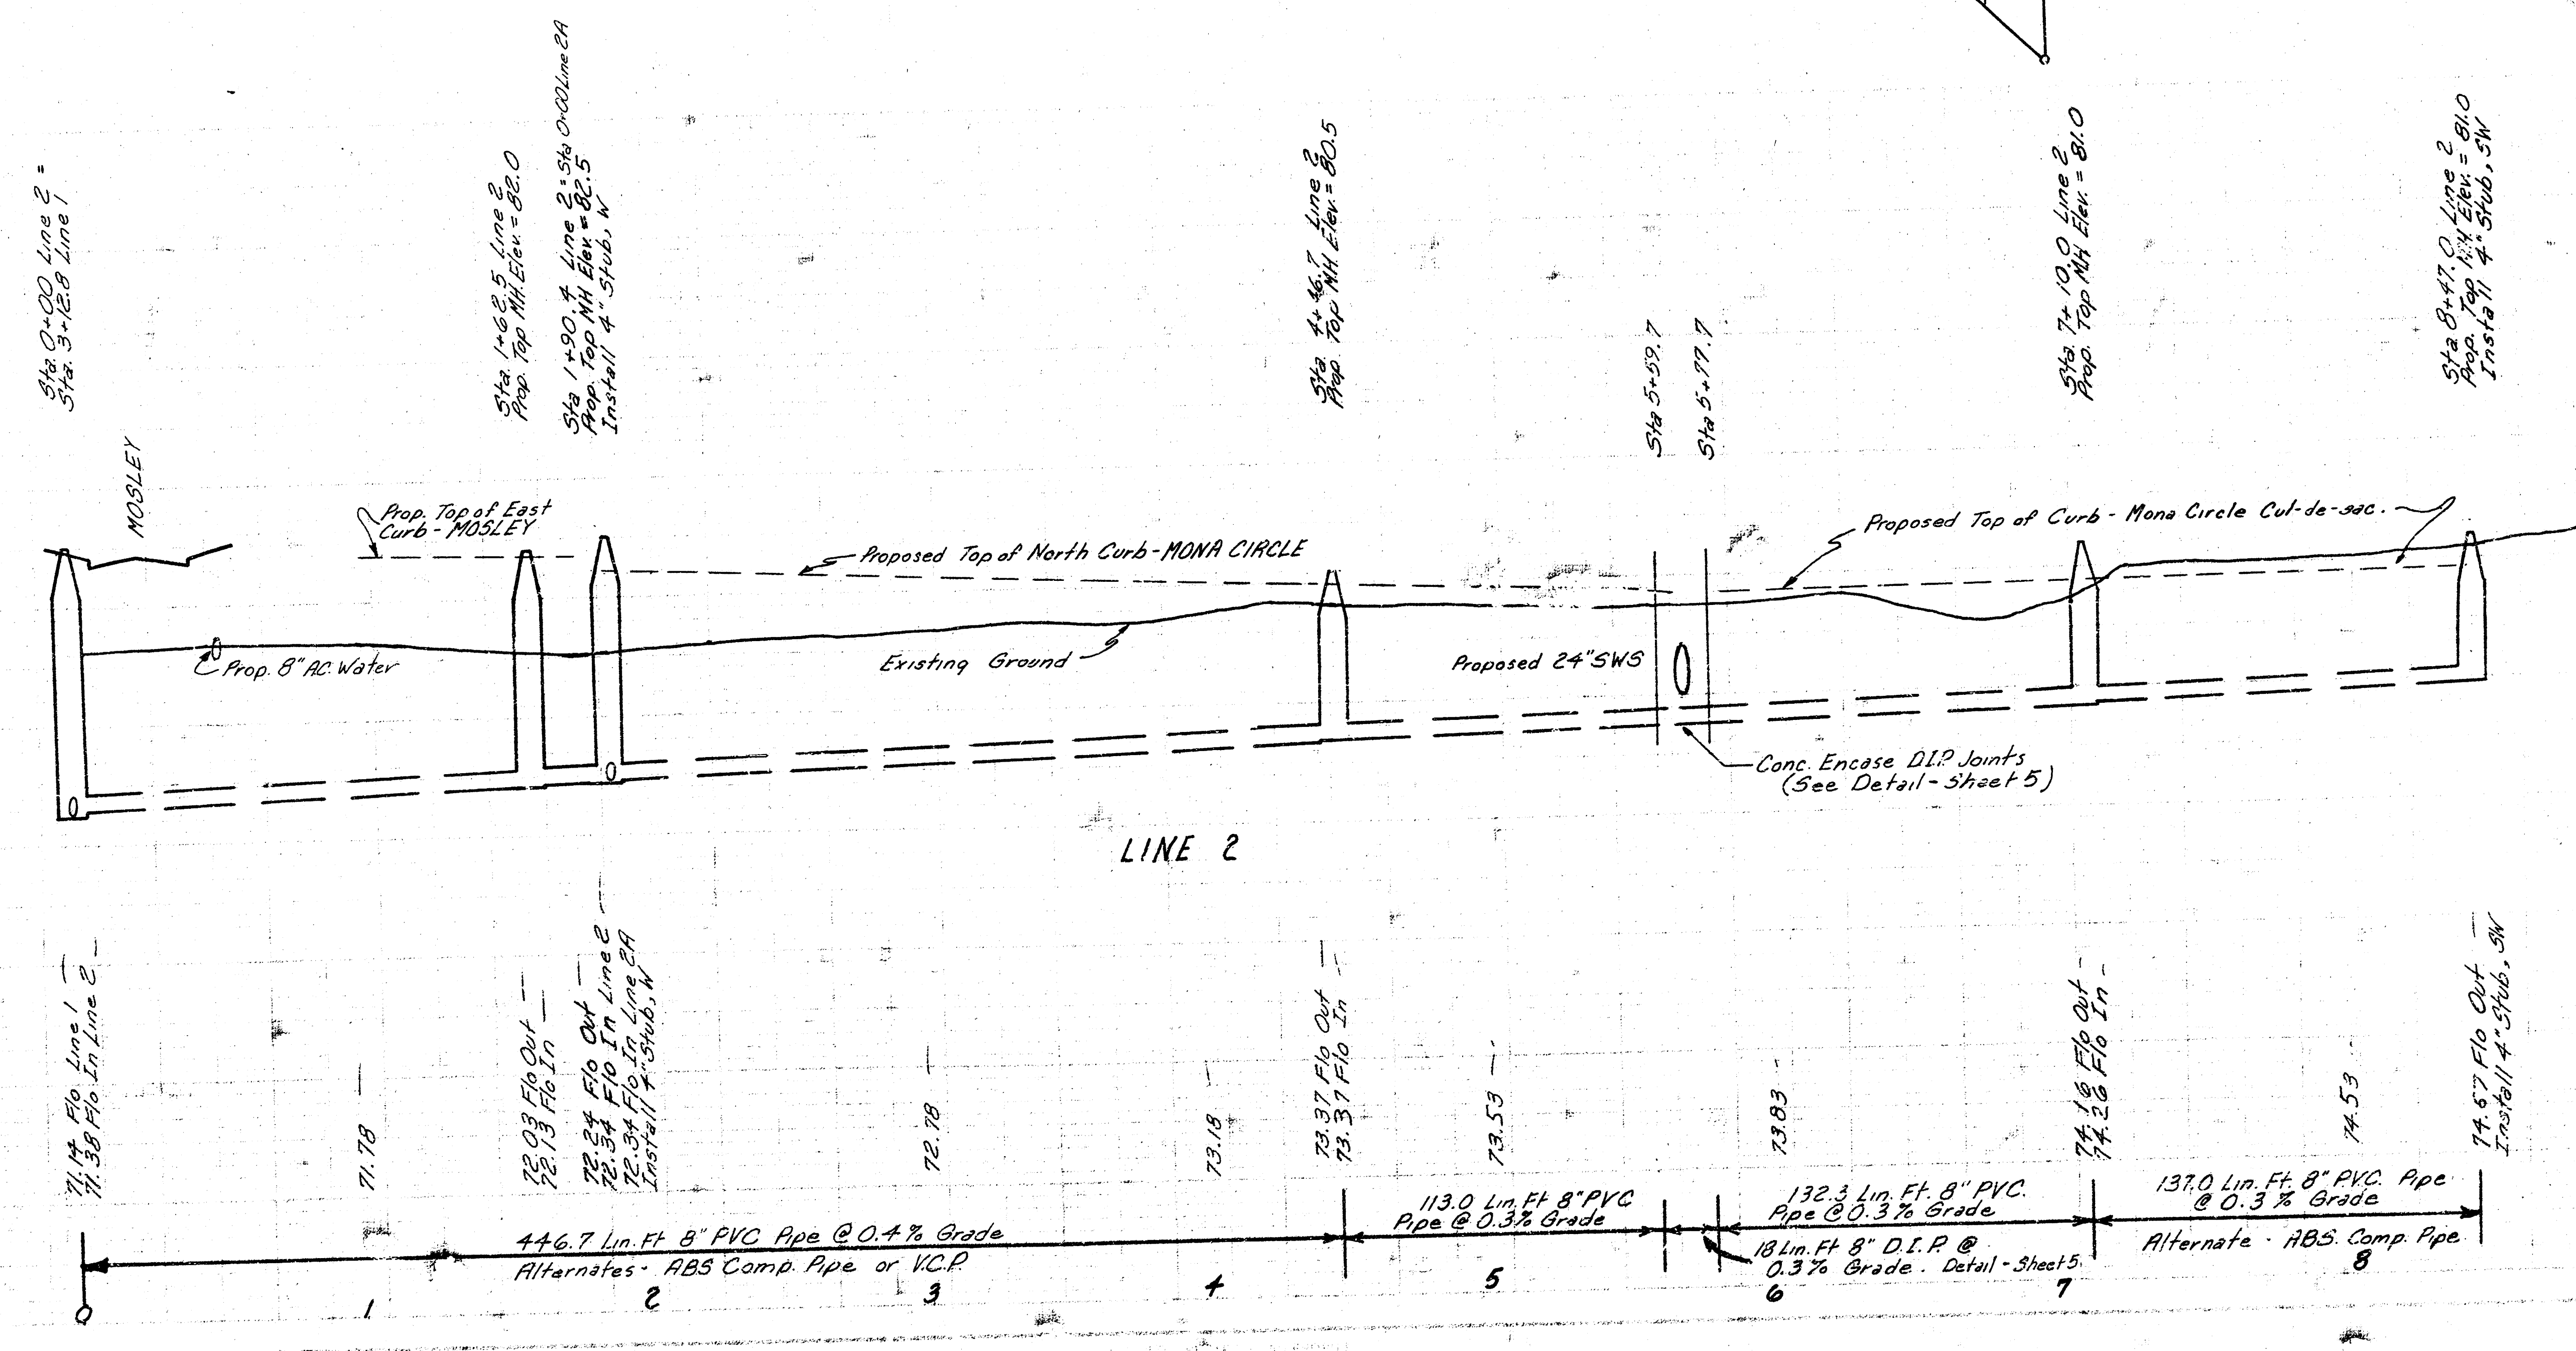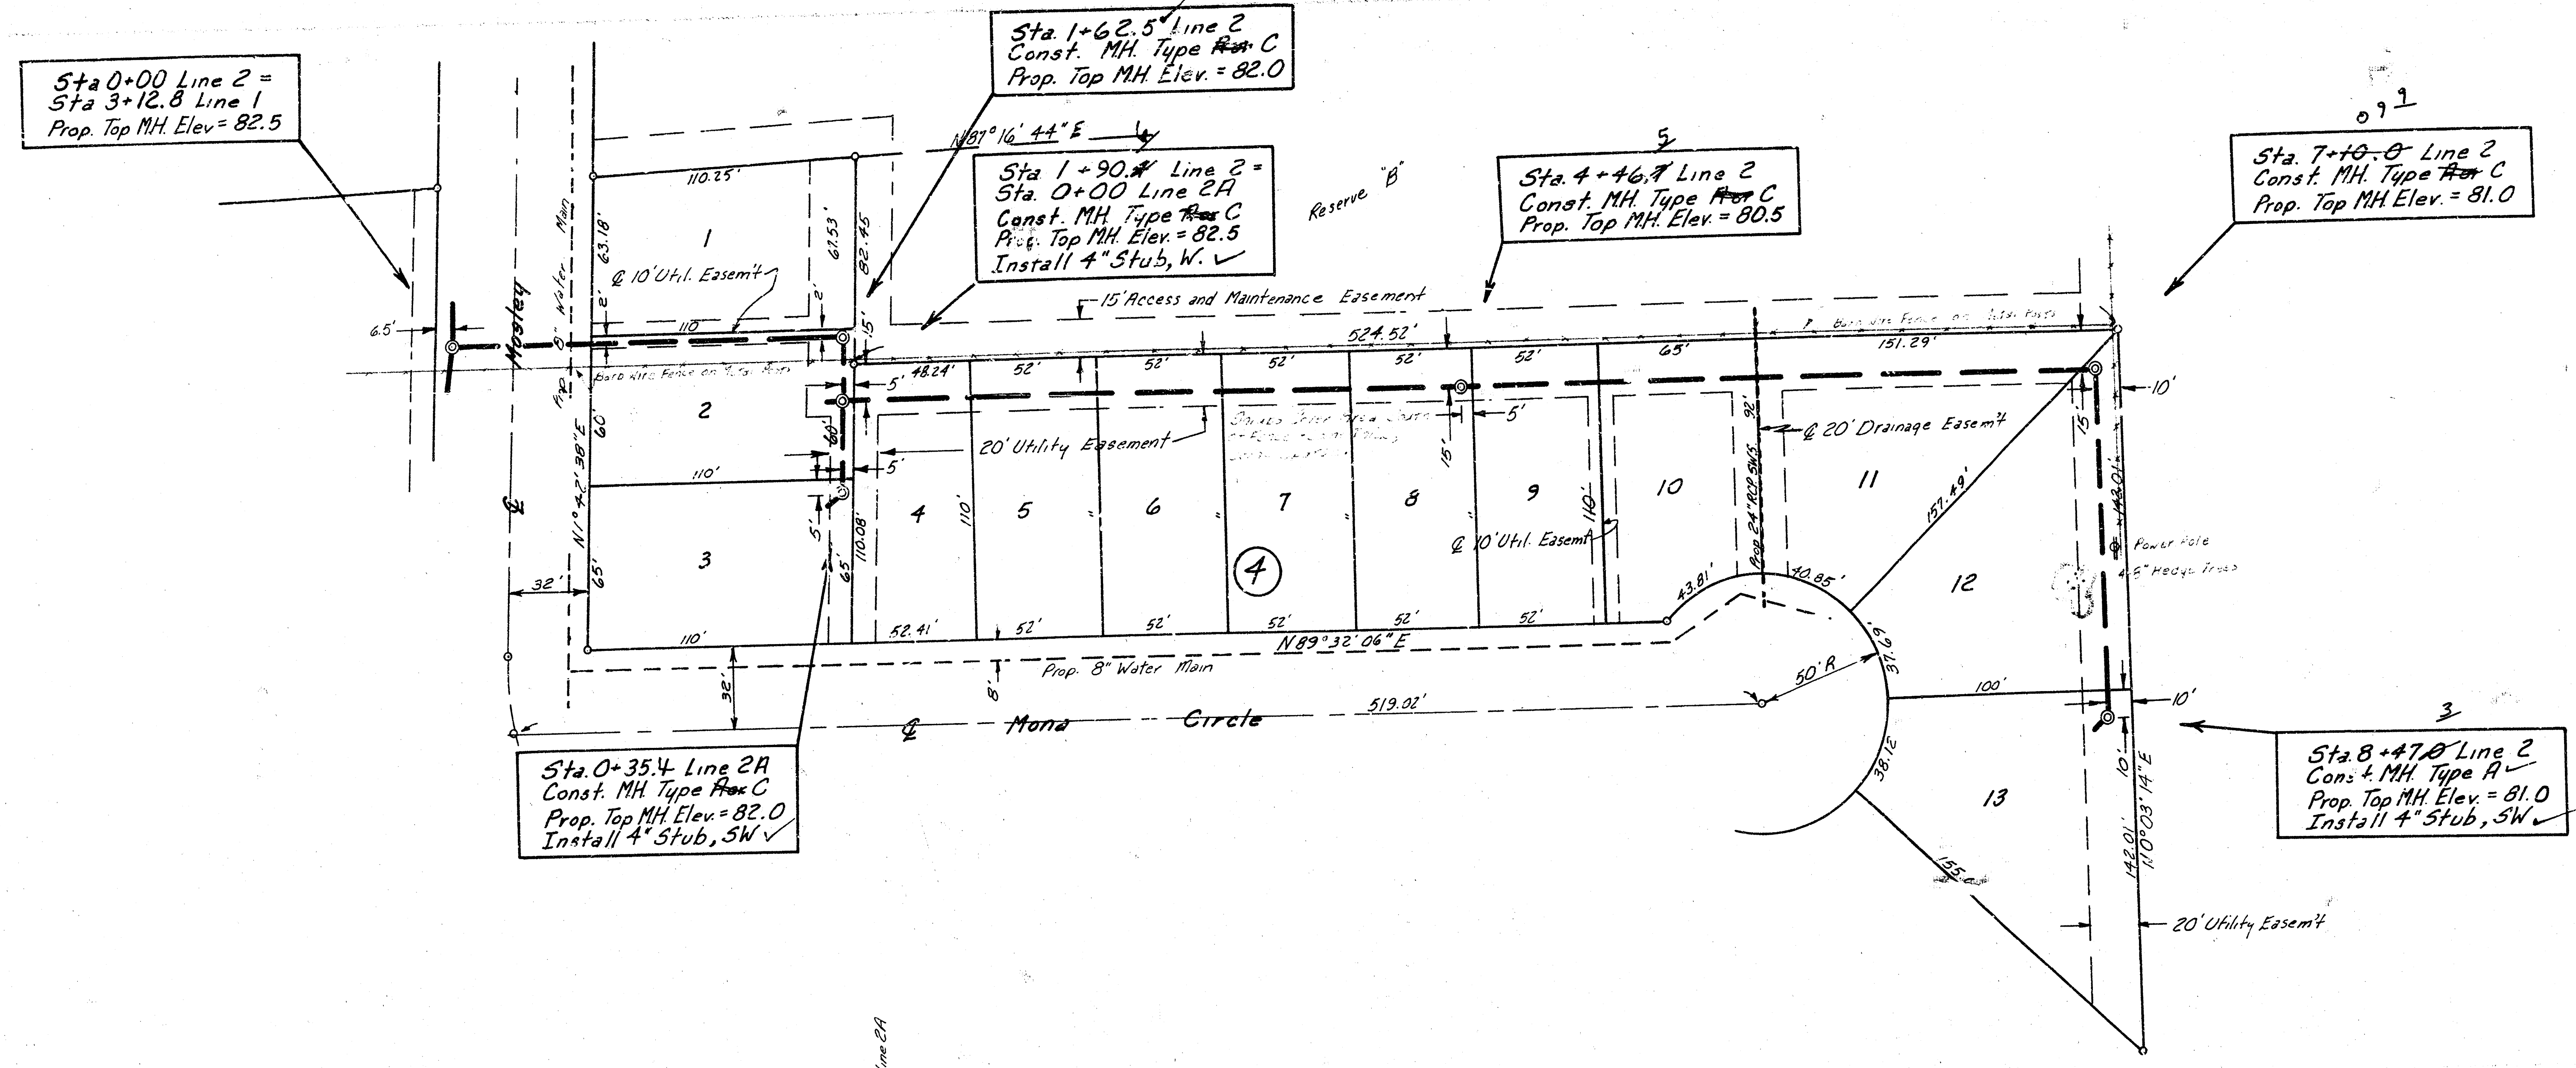


12/81
 J. Lindsey


12/81
 J. Lindsey

12/81
 J. Lindsey


LATERAL 20, MAIN 2, S.W. I.
 PROJECT NO. 468-76245 91086-000-000-001
 LINE 3 & 3A SHEET 5

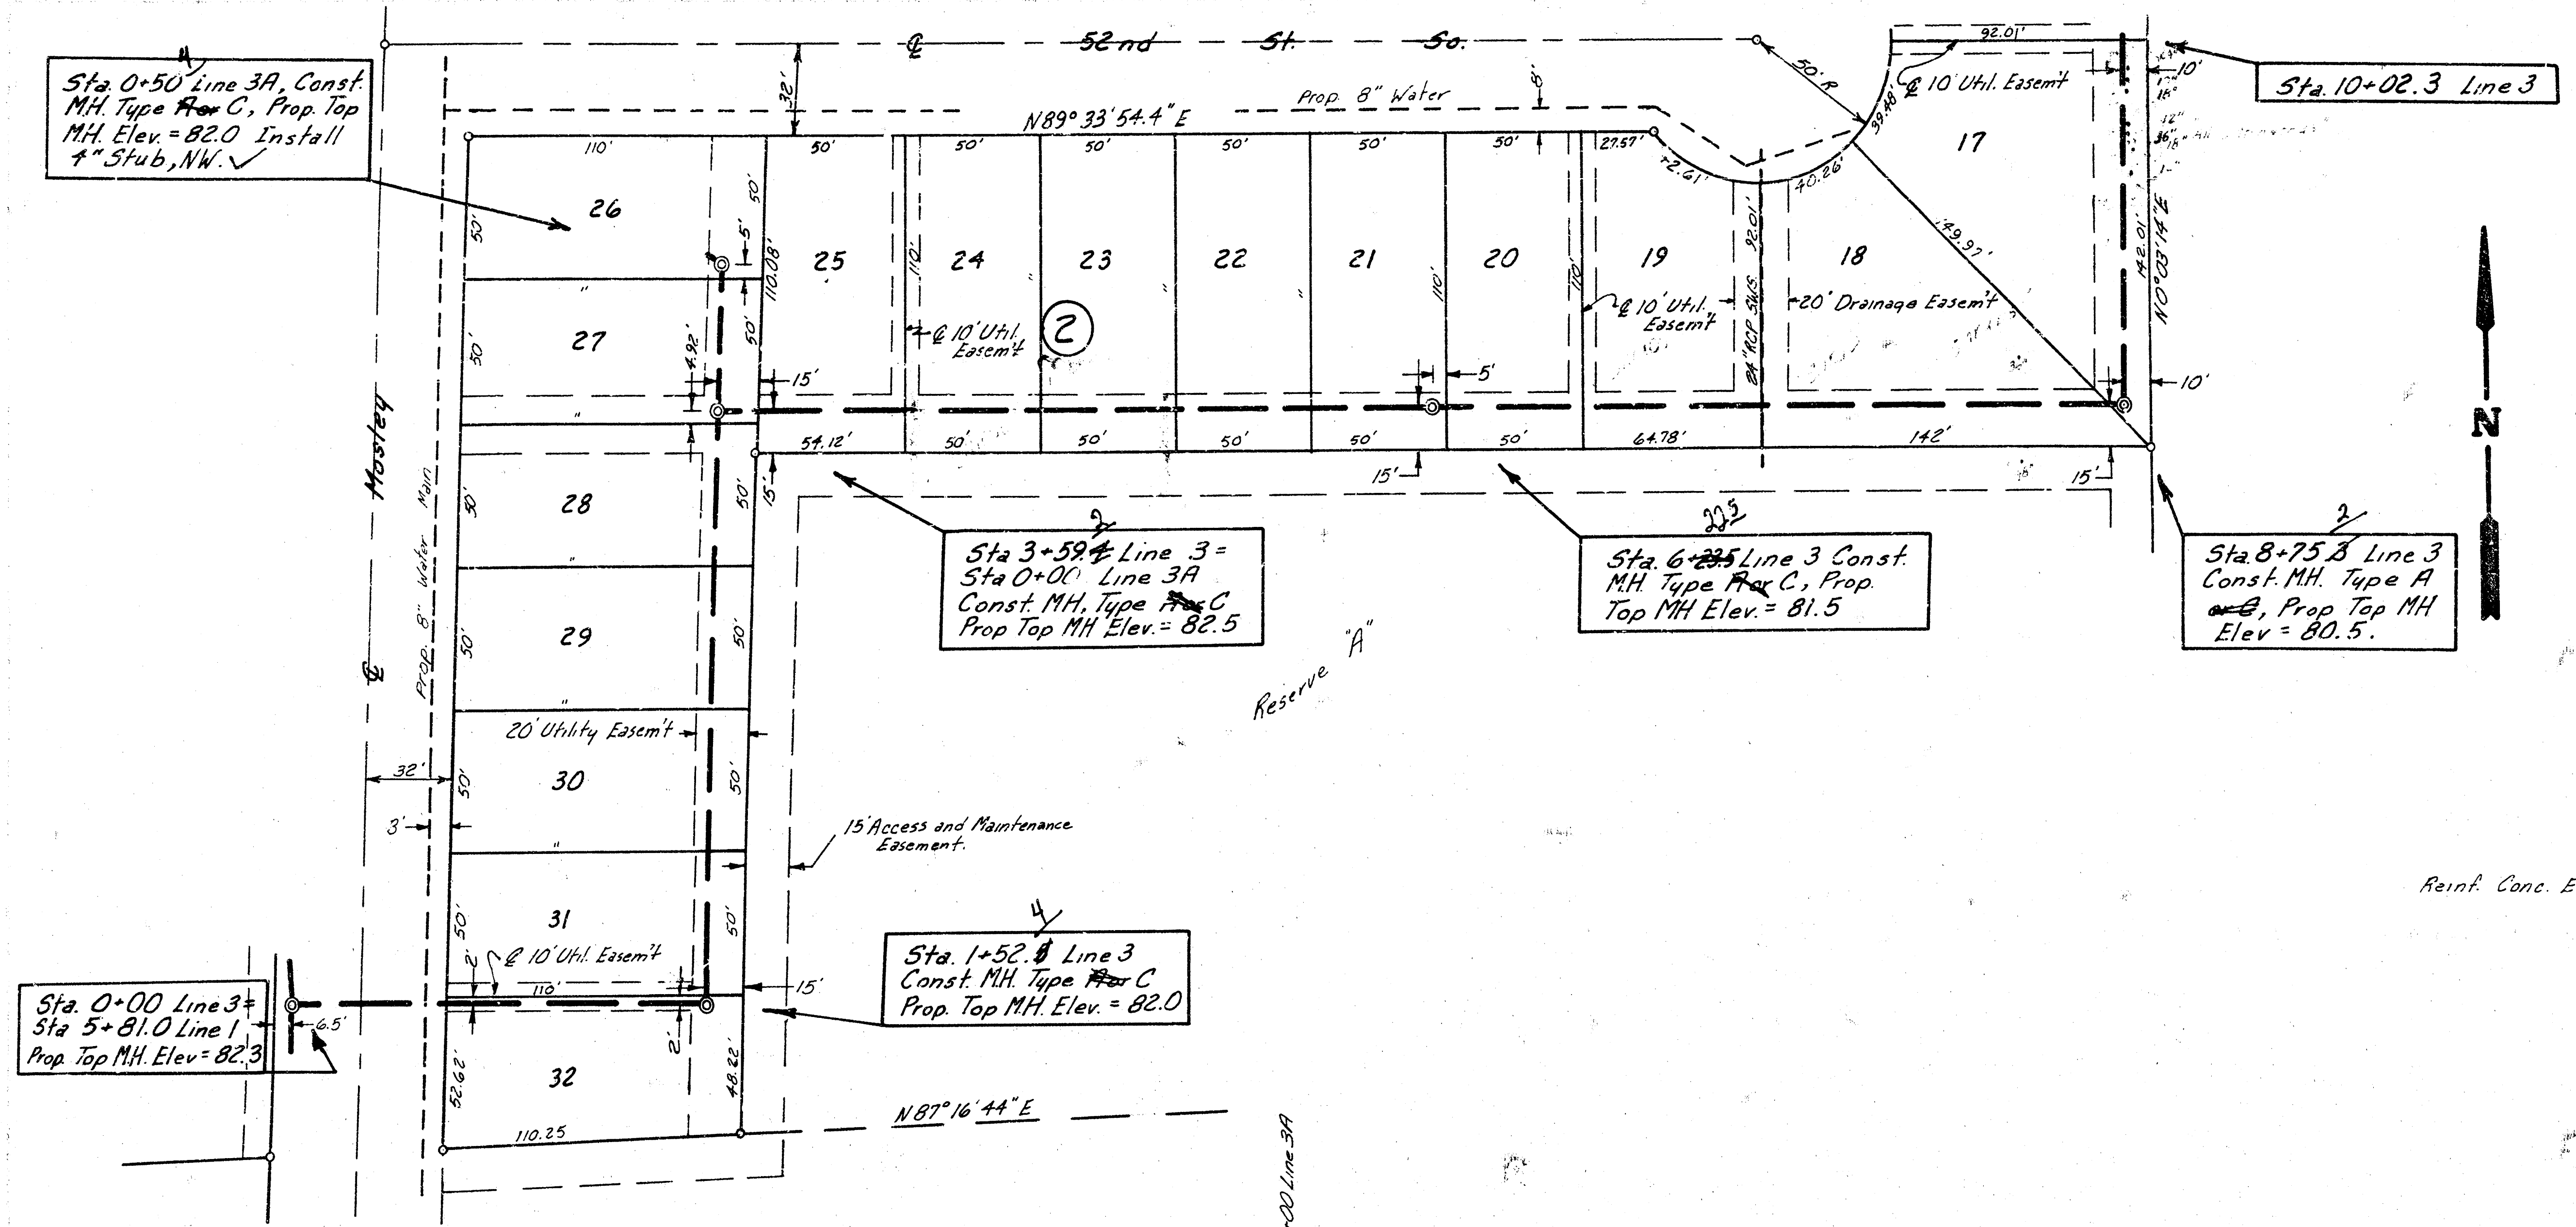

SCALE: 1"=40' Plan
 1"=40' Horiz.
 1"=5' Profile



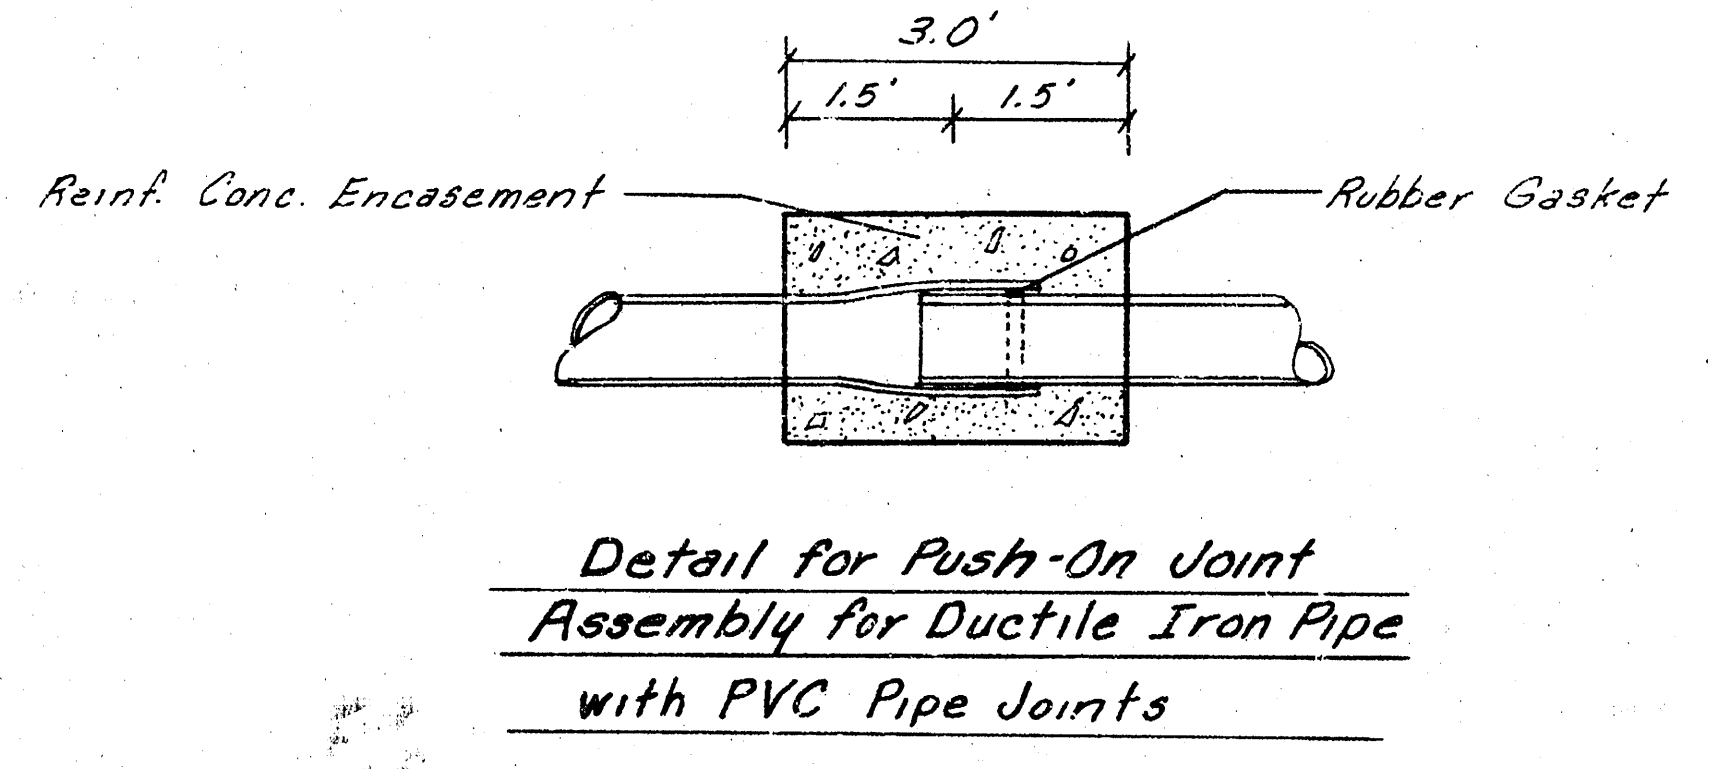


As Built
 JLL
 6-82

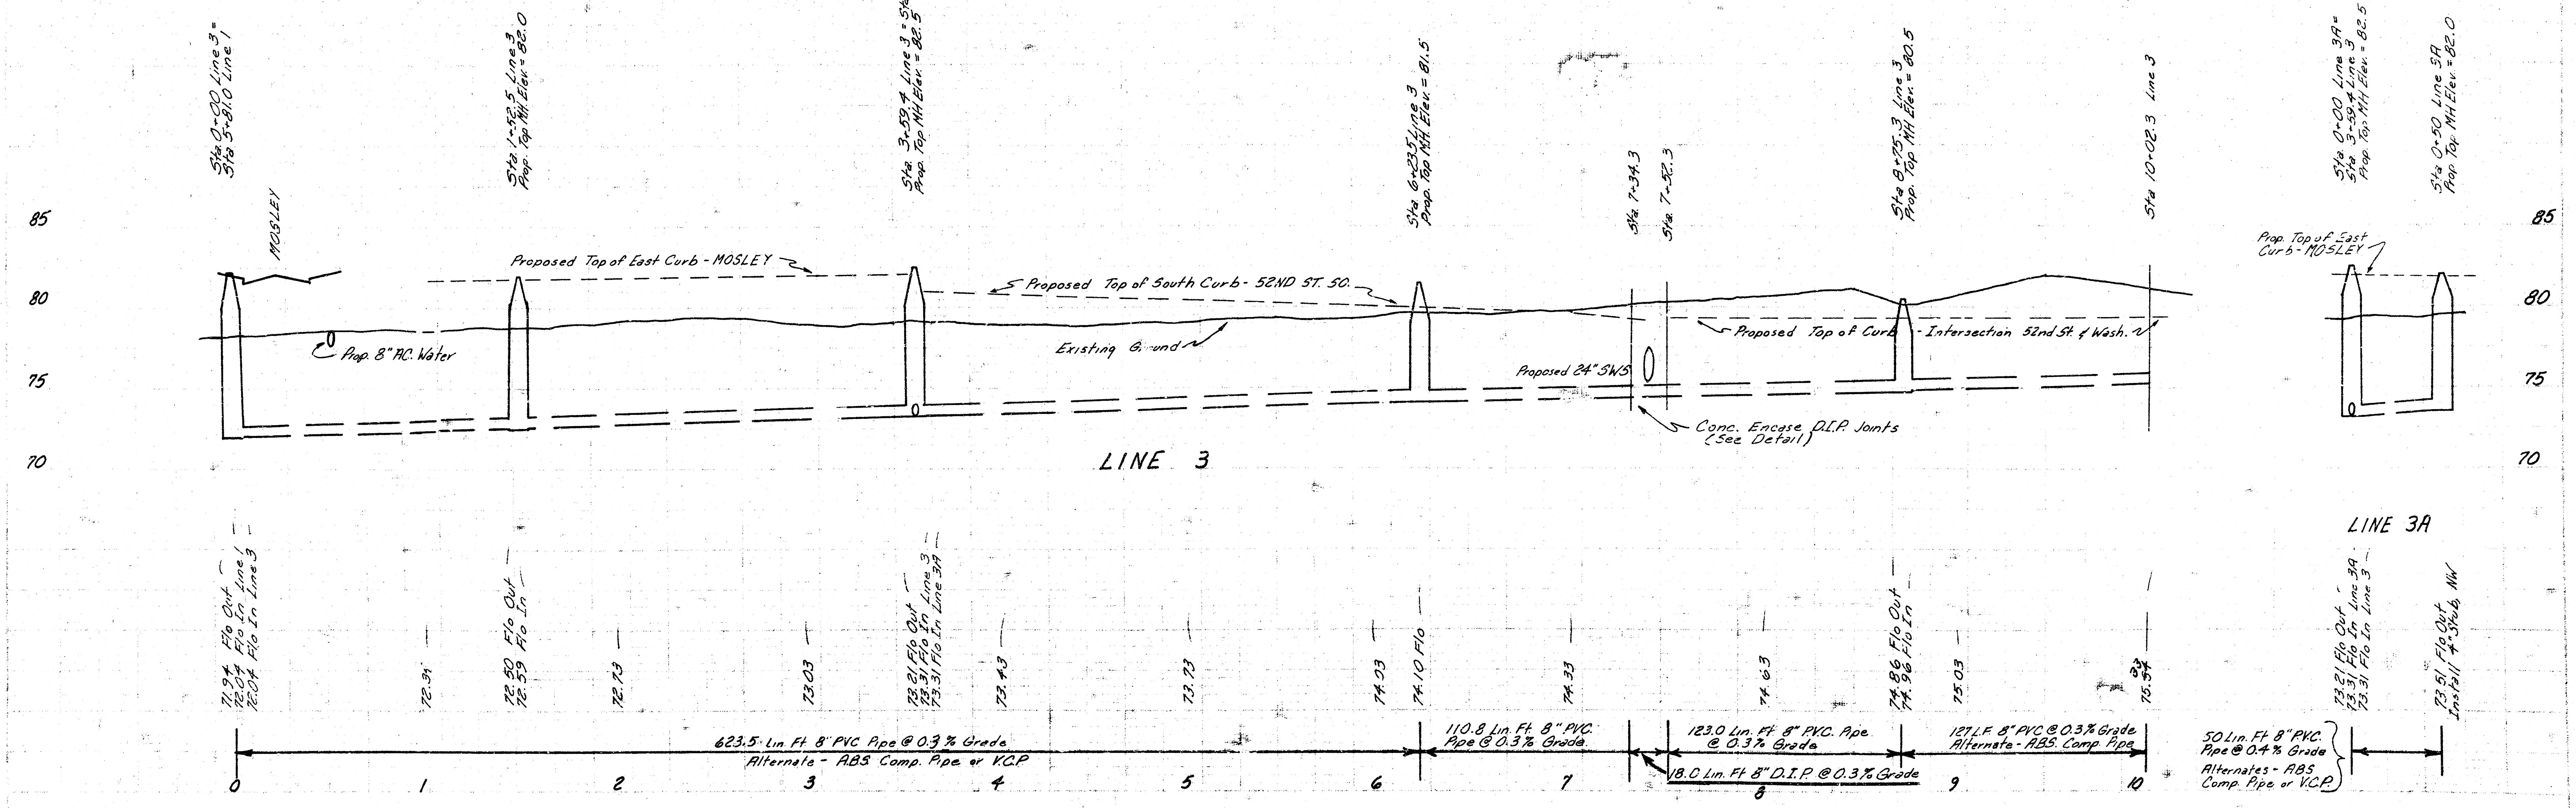

LATERAL 20, MAIN 2, S.W. I.
 PROJECT NO. 468-76-245-81086-000-000-001
 LINE 3 & 4 SHEET 6

SCALE: 1"=40' Plan
 Horiz. 1"=40' Profile
 Vert. 1"=5'

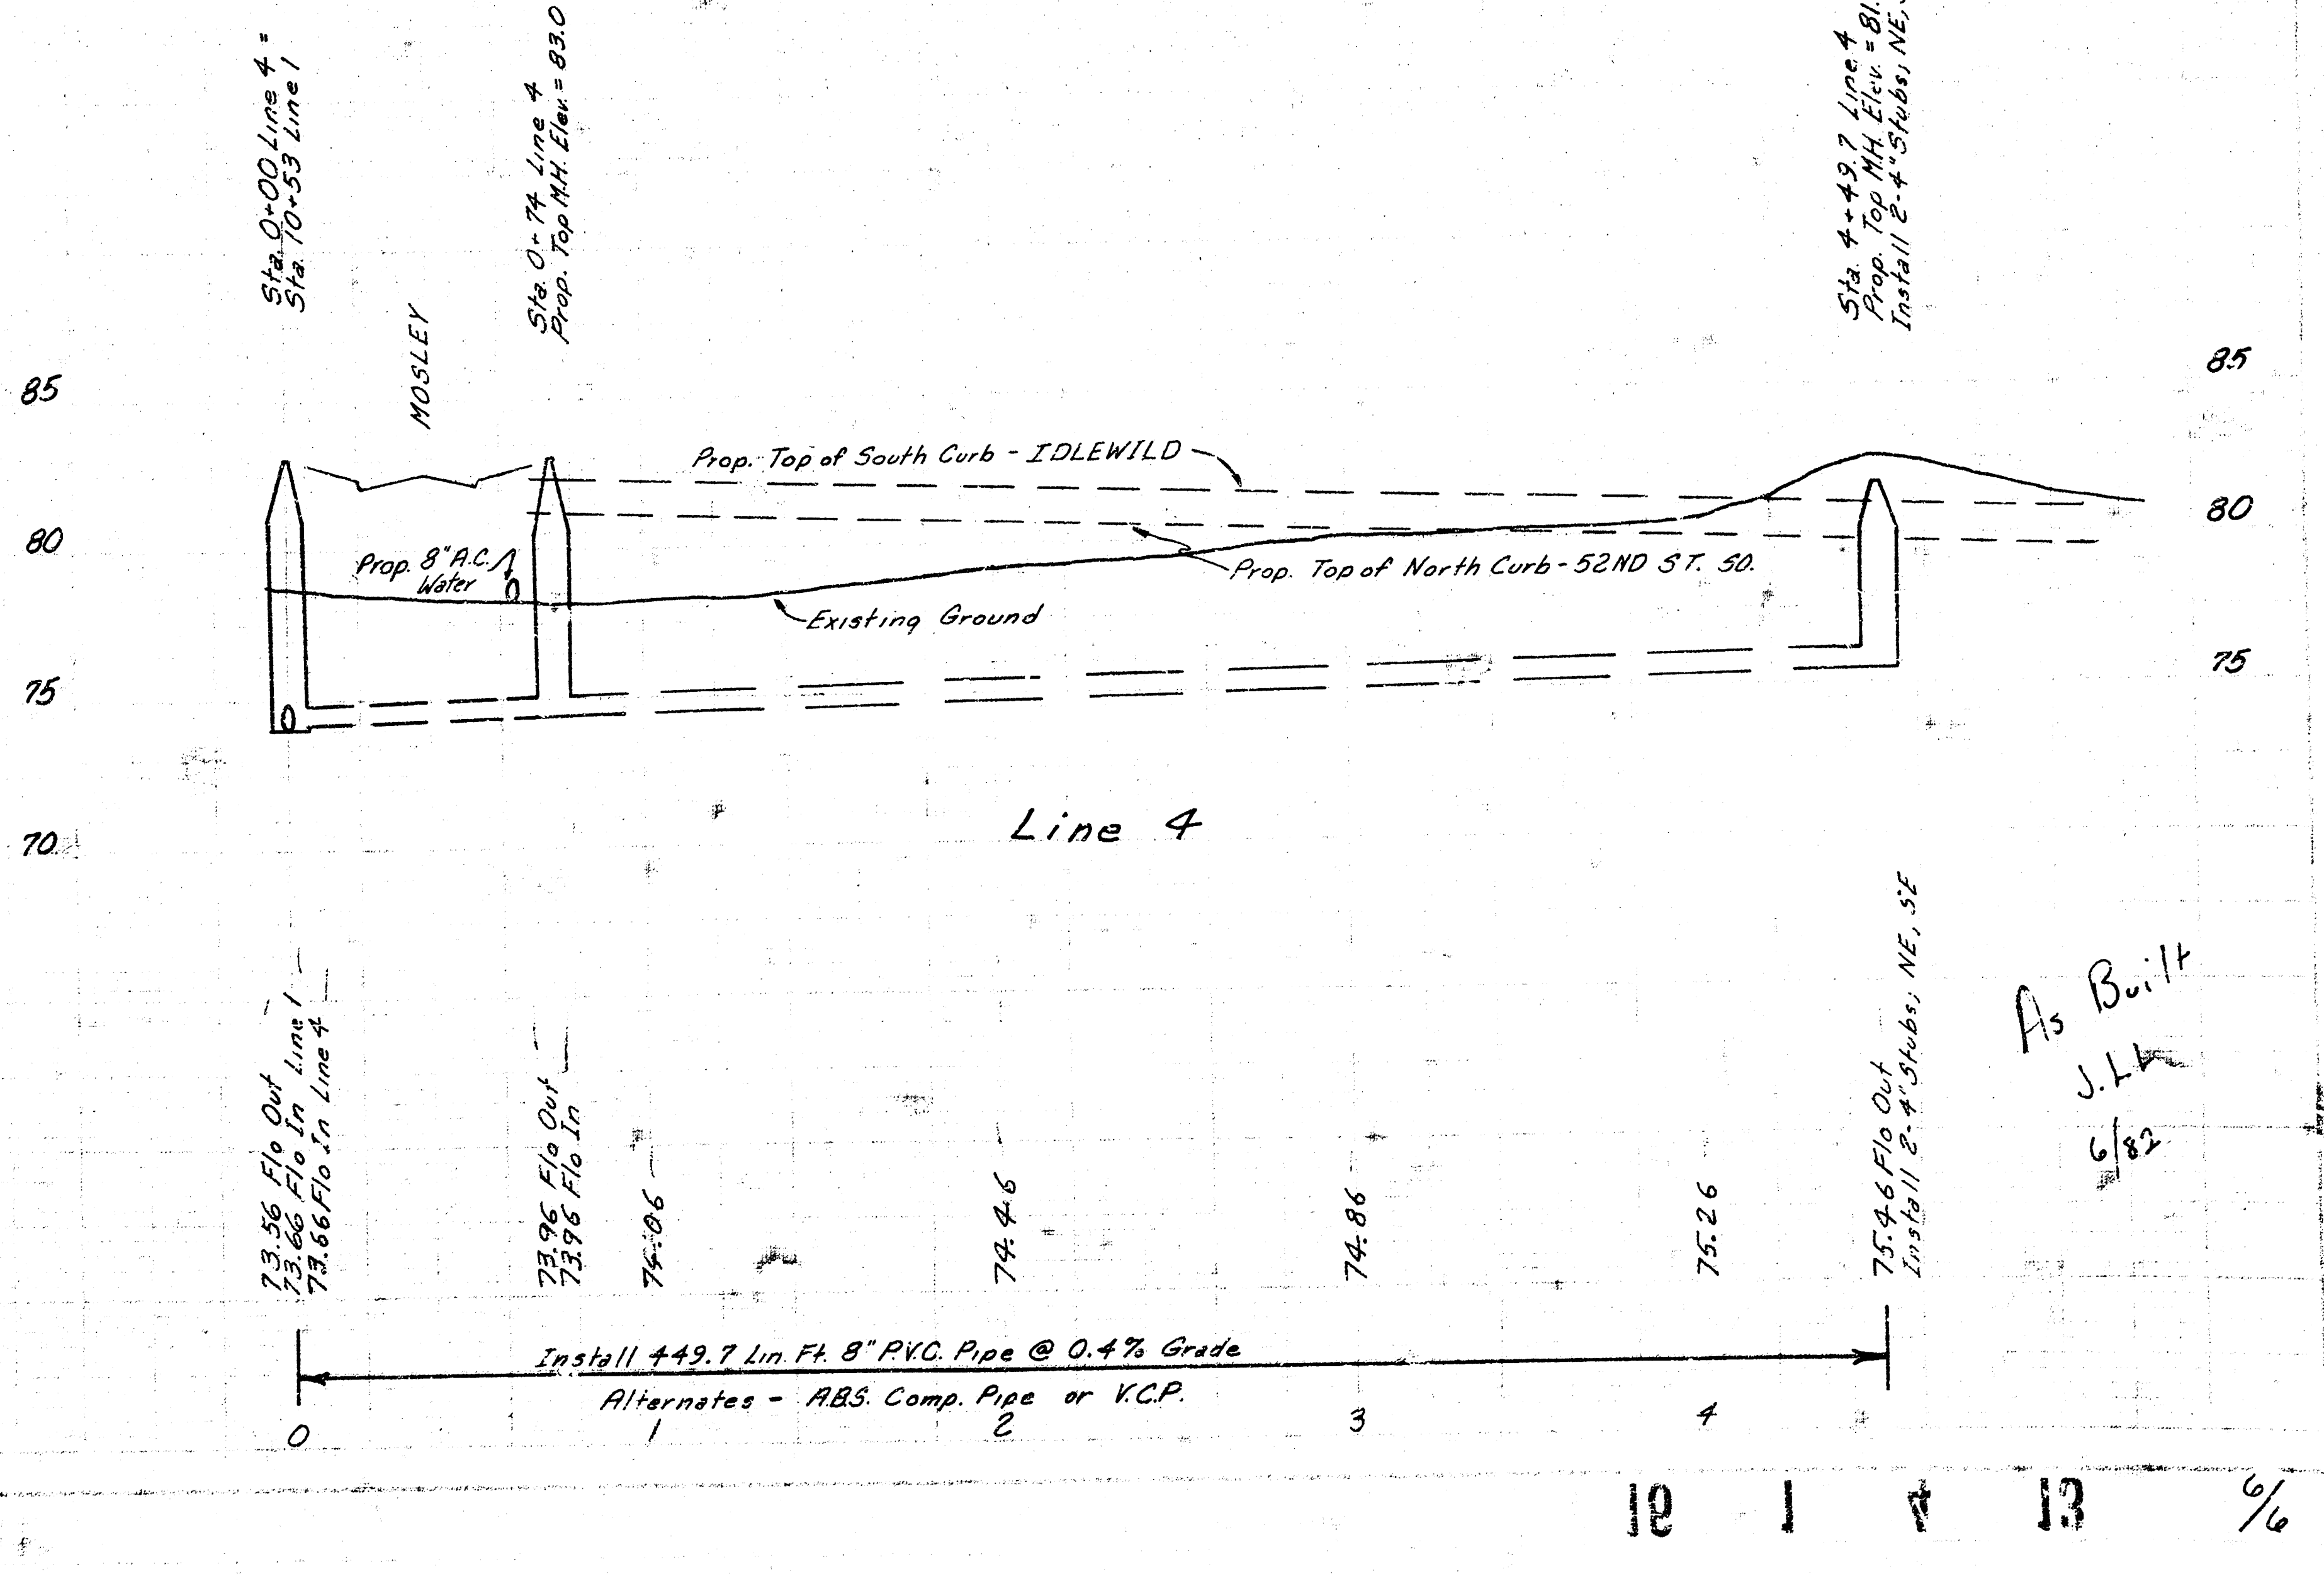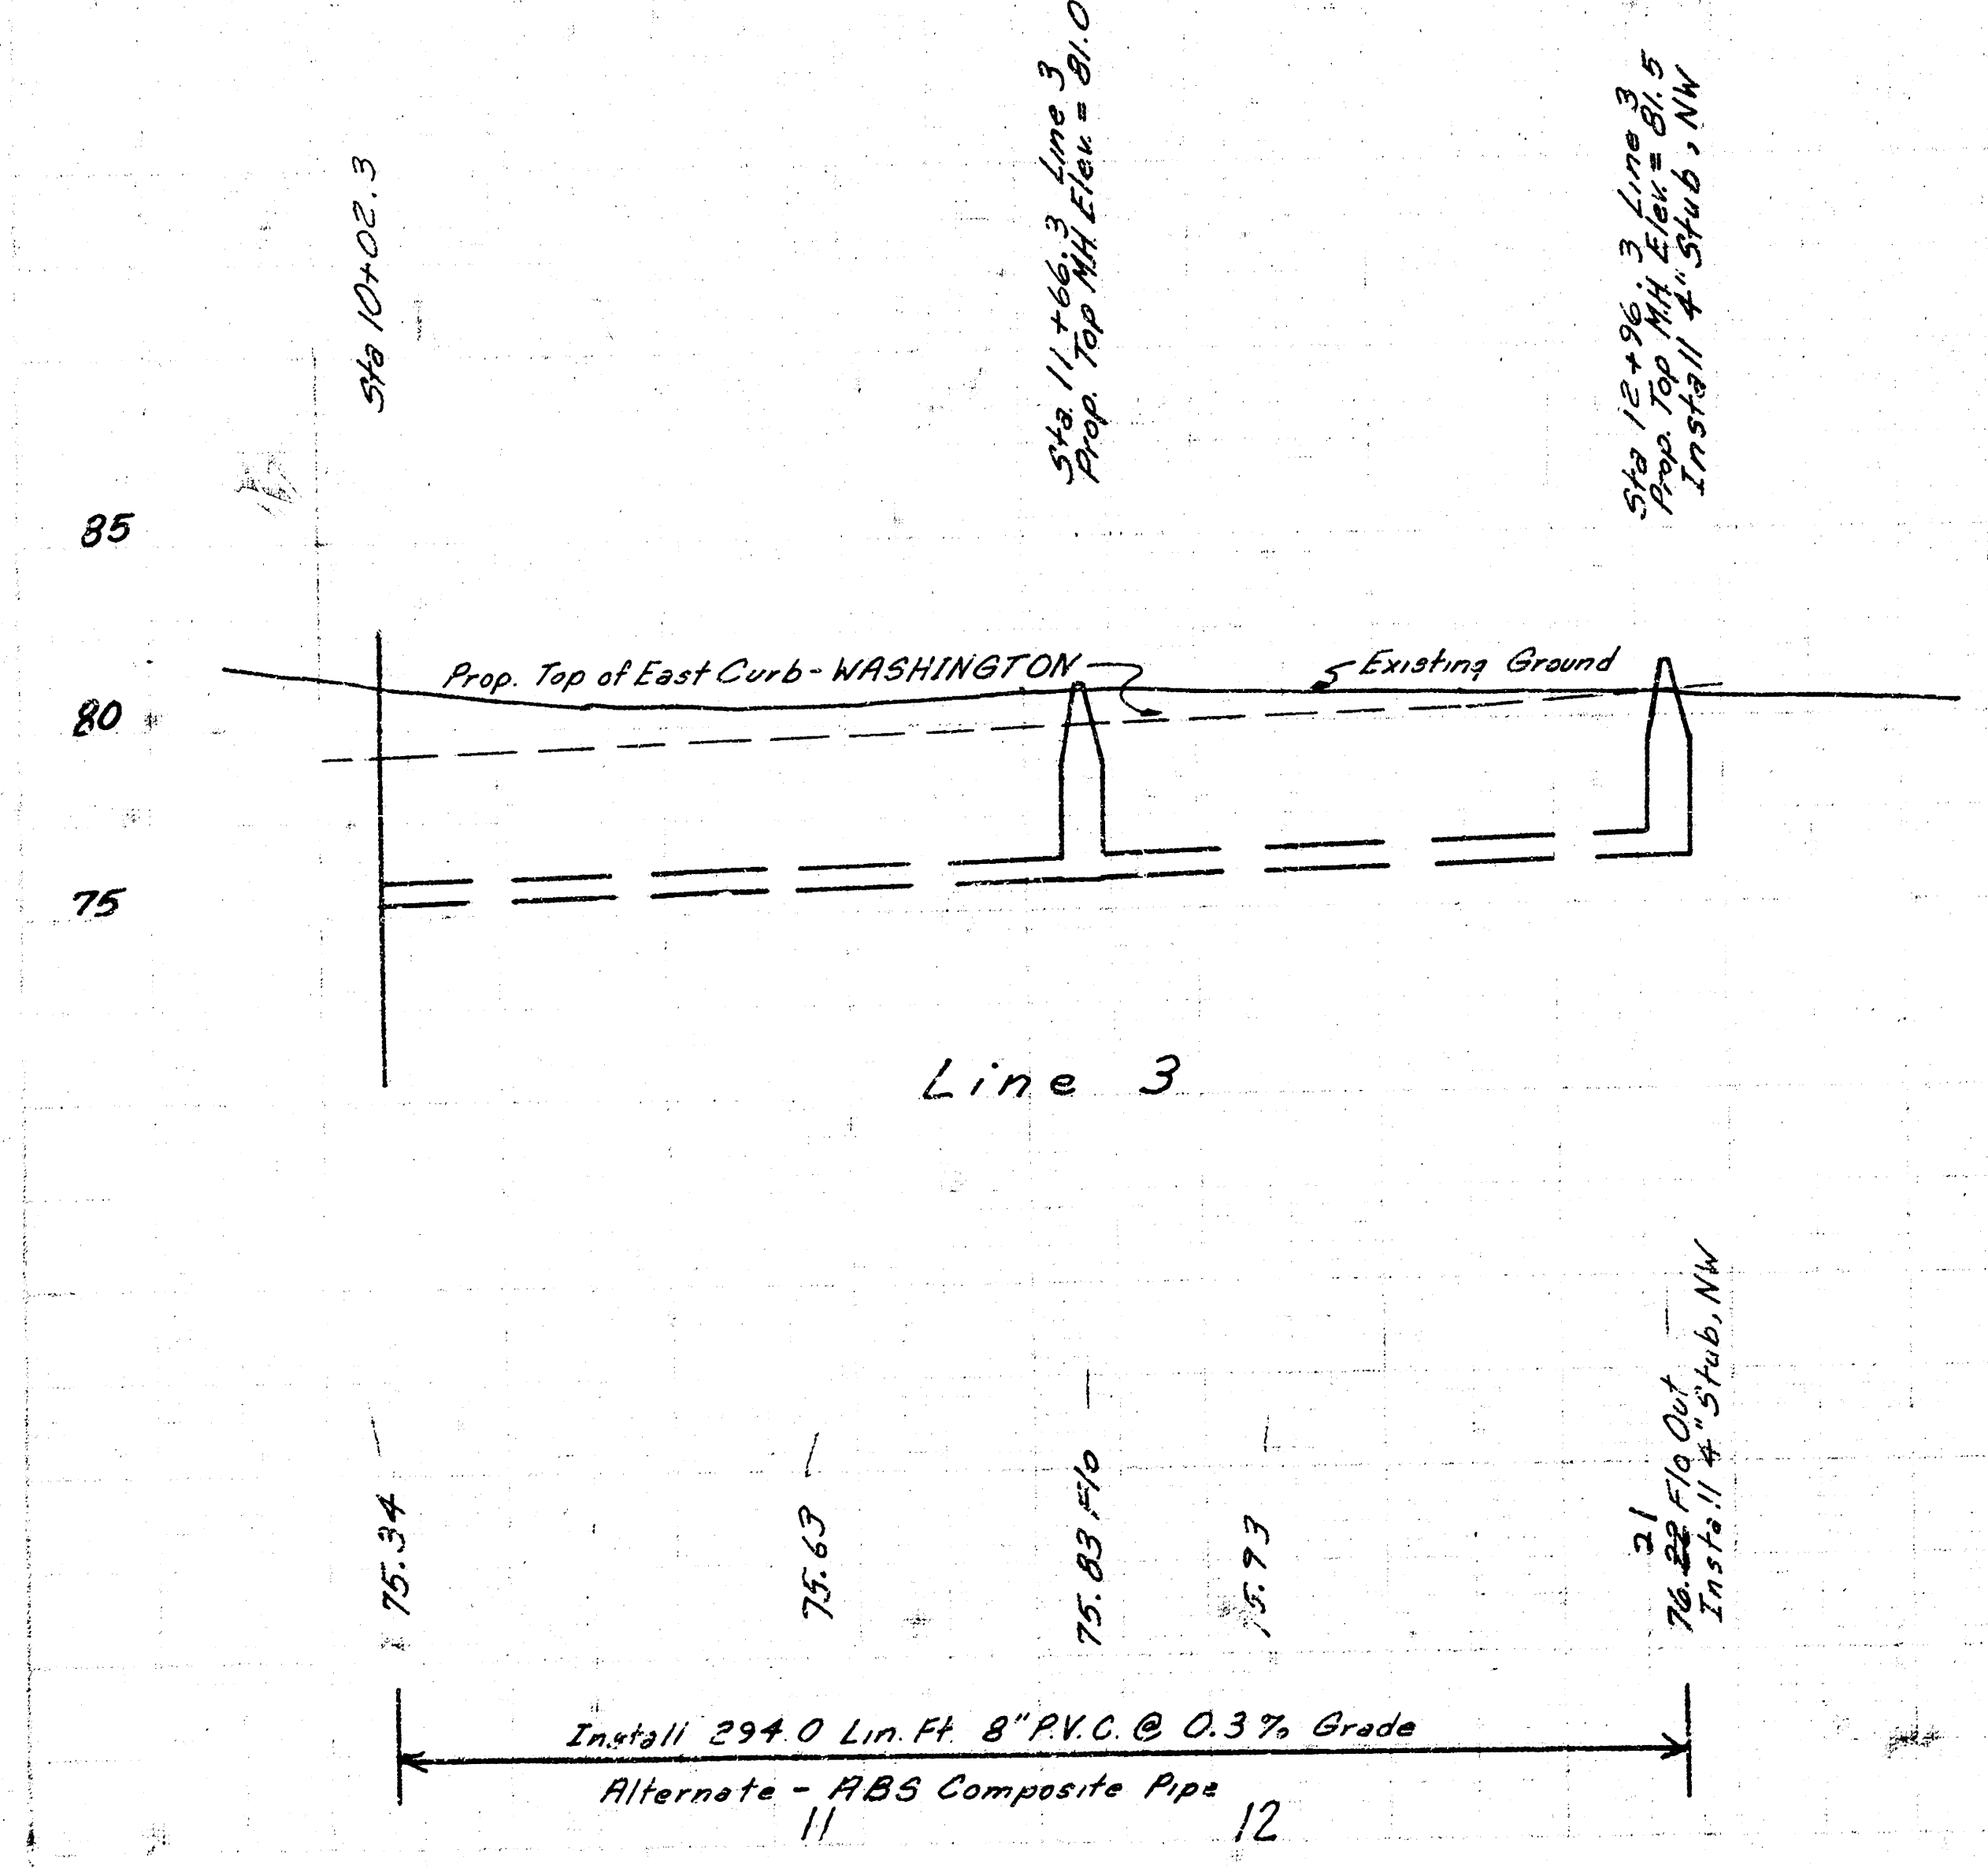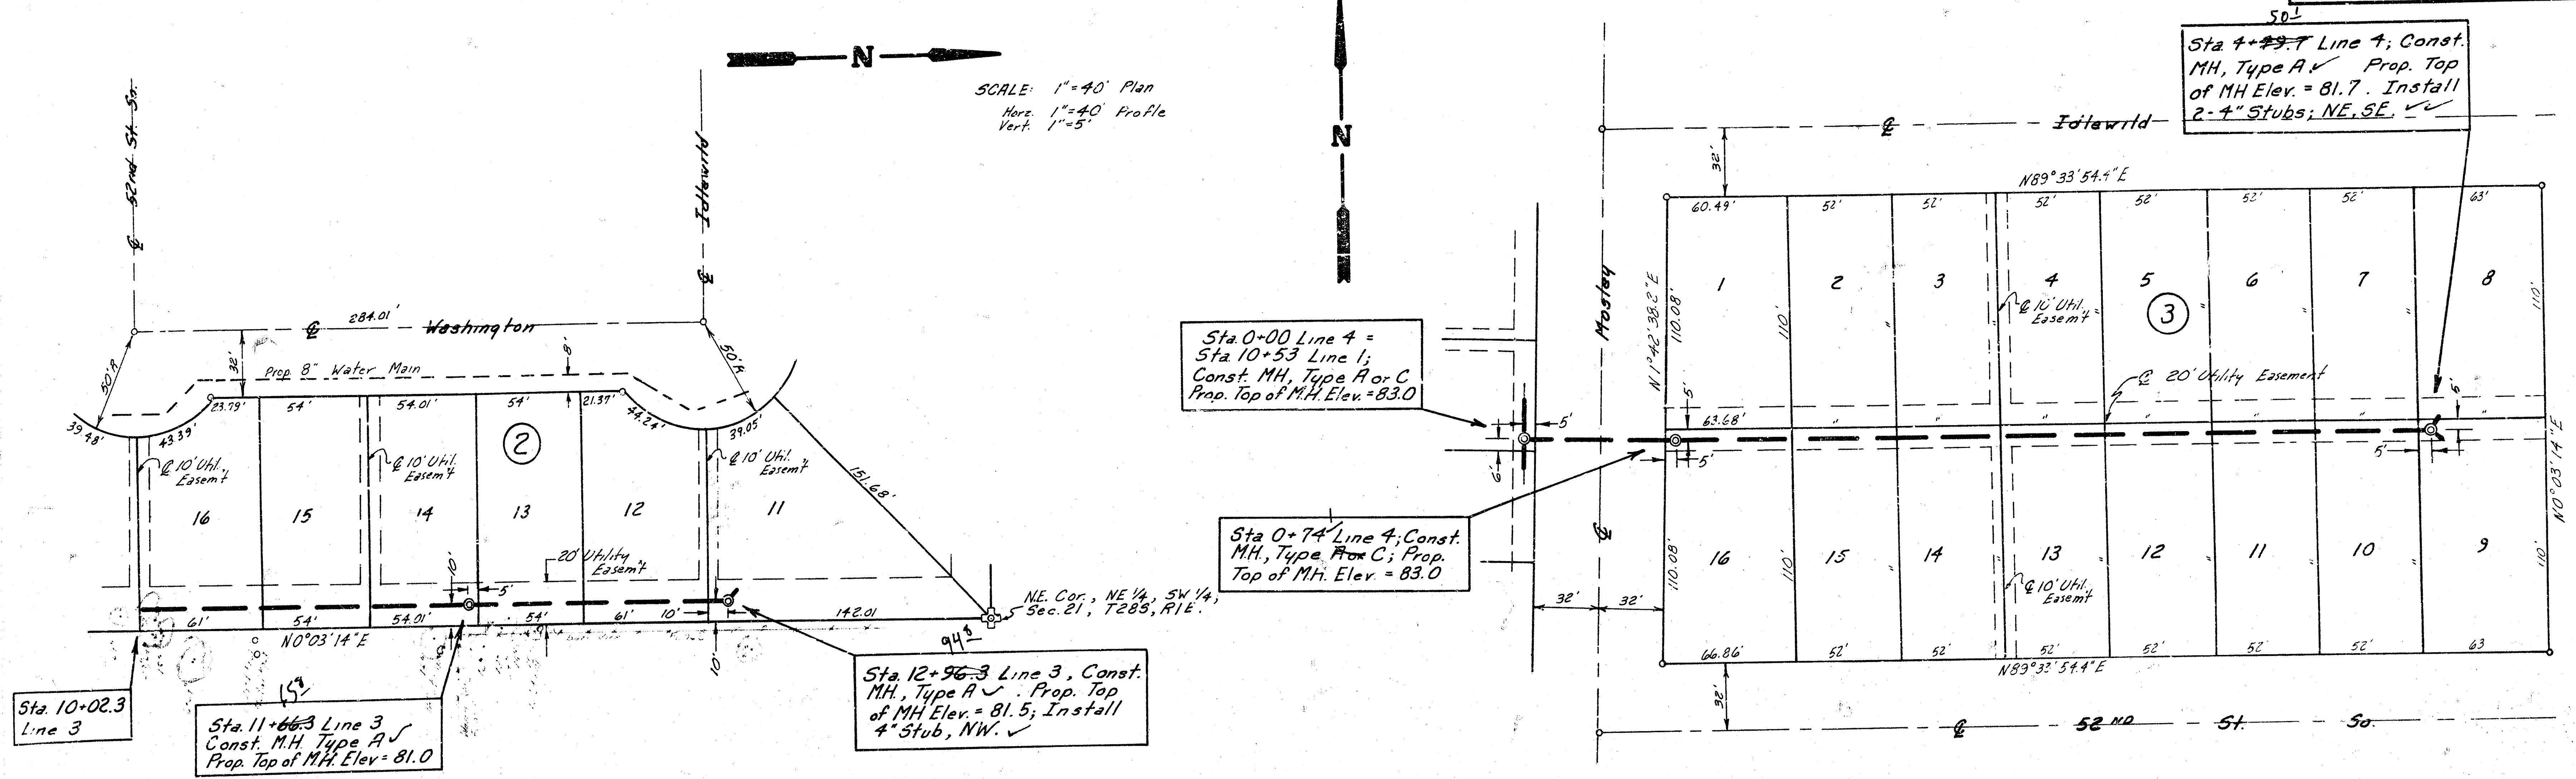

As Built
 J.L.H.
 6/82