


Riverside 4TH Addition

SCALE: 1"=40' Plan
 Horiz. 1"=40' Profile
 Vert. 1"=5'



Bench Mark: 81.23 - City Std. Disc. South Side of
 Conc. Wk. North Side of Bridge on
 55th St. South, approx. 550' West
 of Washington.

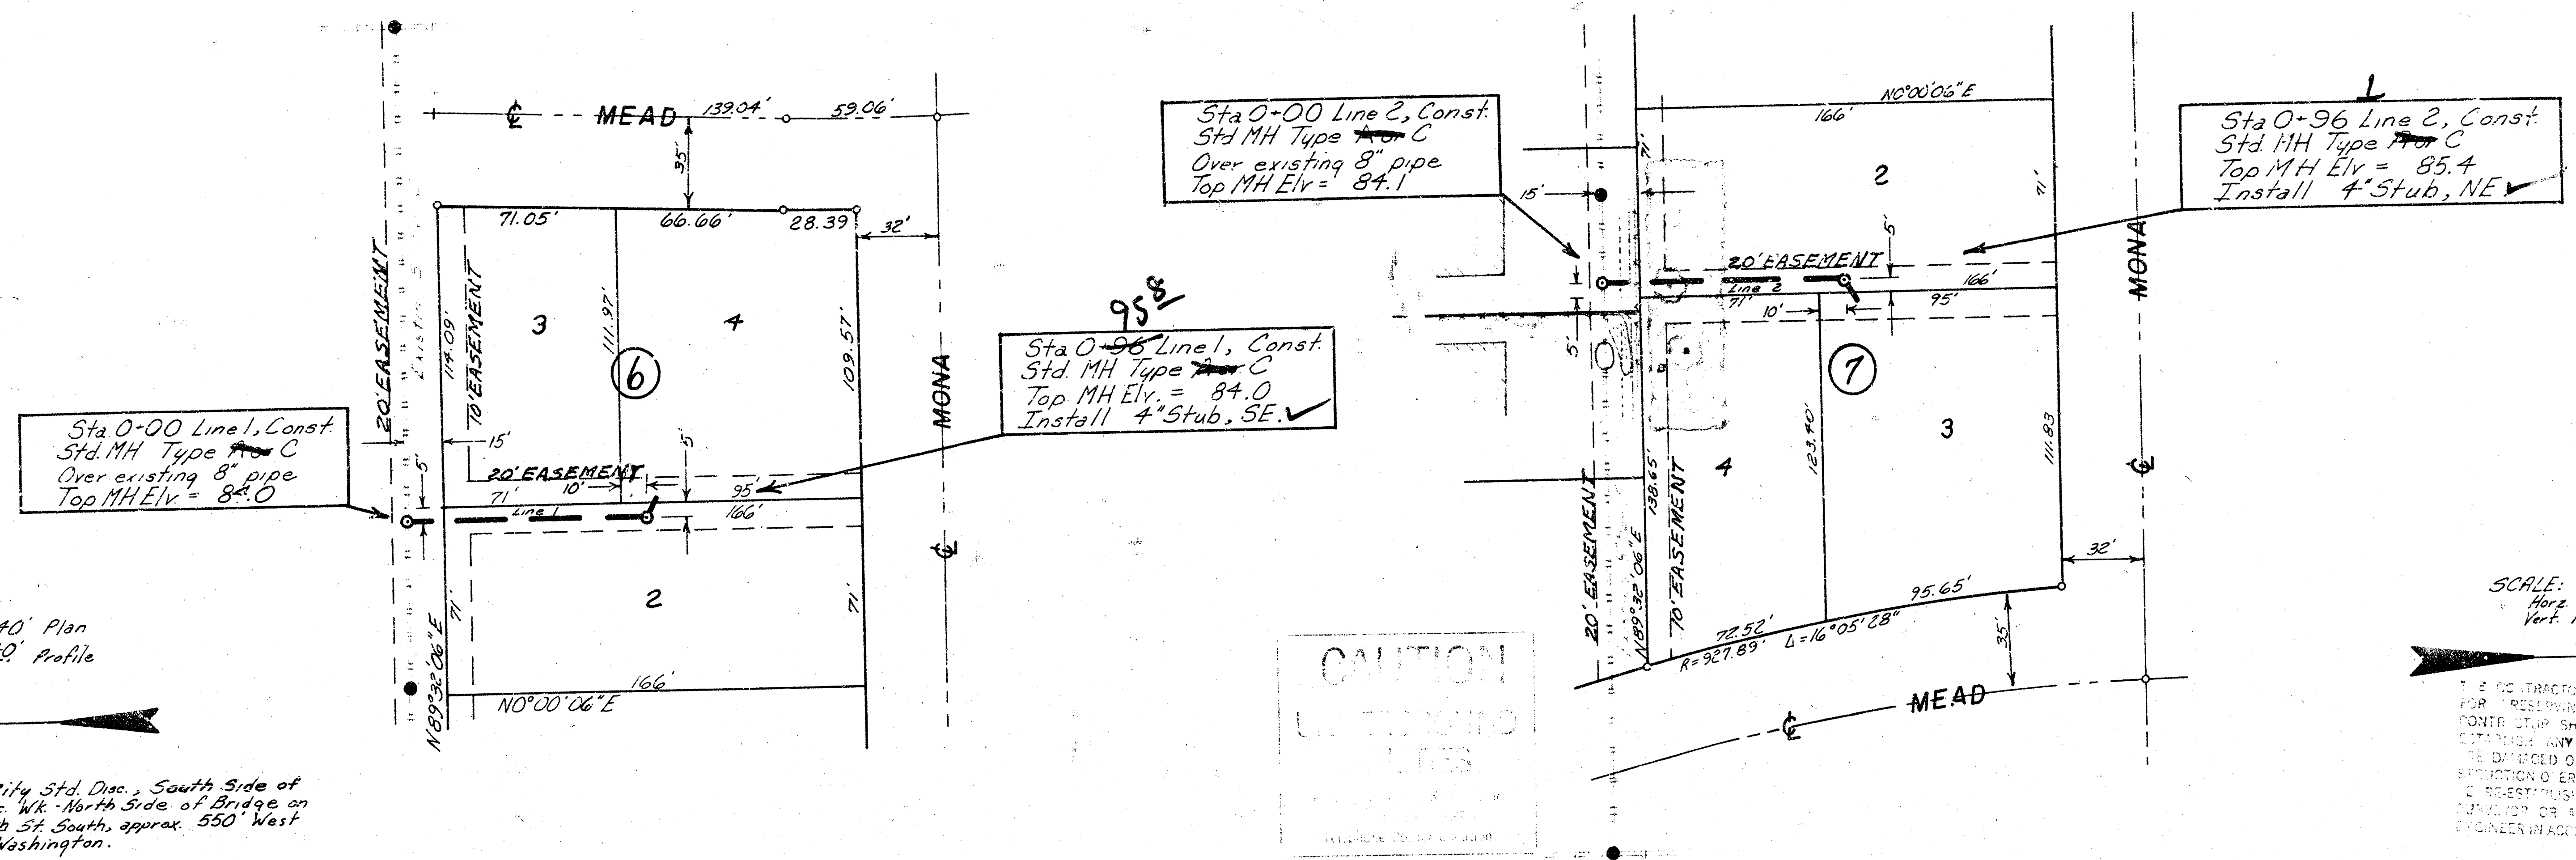

CAUTION
 LIES
 BELOW


SCALE: 1"=40' Plan
 Horiz. 1"=40' Profile
 Vert. 1"=5'

CONTRACTOR SHALL BE RESPONSIBLE
 FOR REMAINING AND CITY IRONS. THE
 CONTRACTOR SHALL BE REQUIRED TO
 EXTERIOR ANY EXISTING IRONS WHICH
 ARE DAMAGED OR DESTROYED BY HIS
 CONSTRUCTION OPERATIONS. SUCH IRONS
 MUST BE REPLACED BY A LICENSED
 PLUMBER OR A LICENSED PROFESSIONAL
 ENGINEER IN ACCORDANCE WITH STATE LAWS.

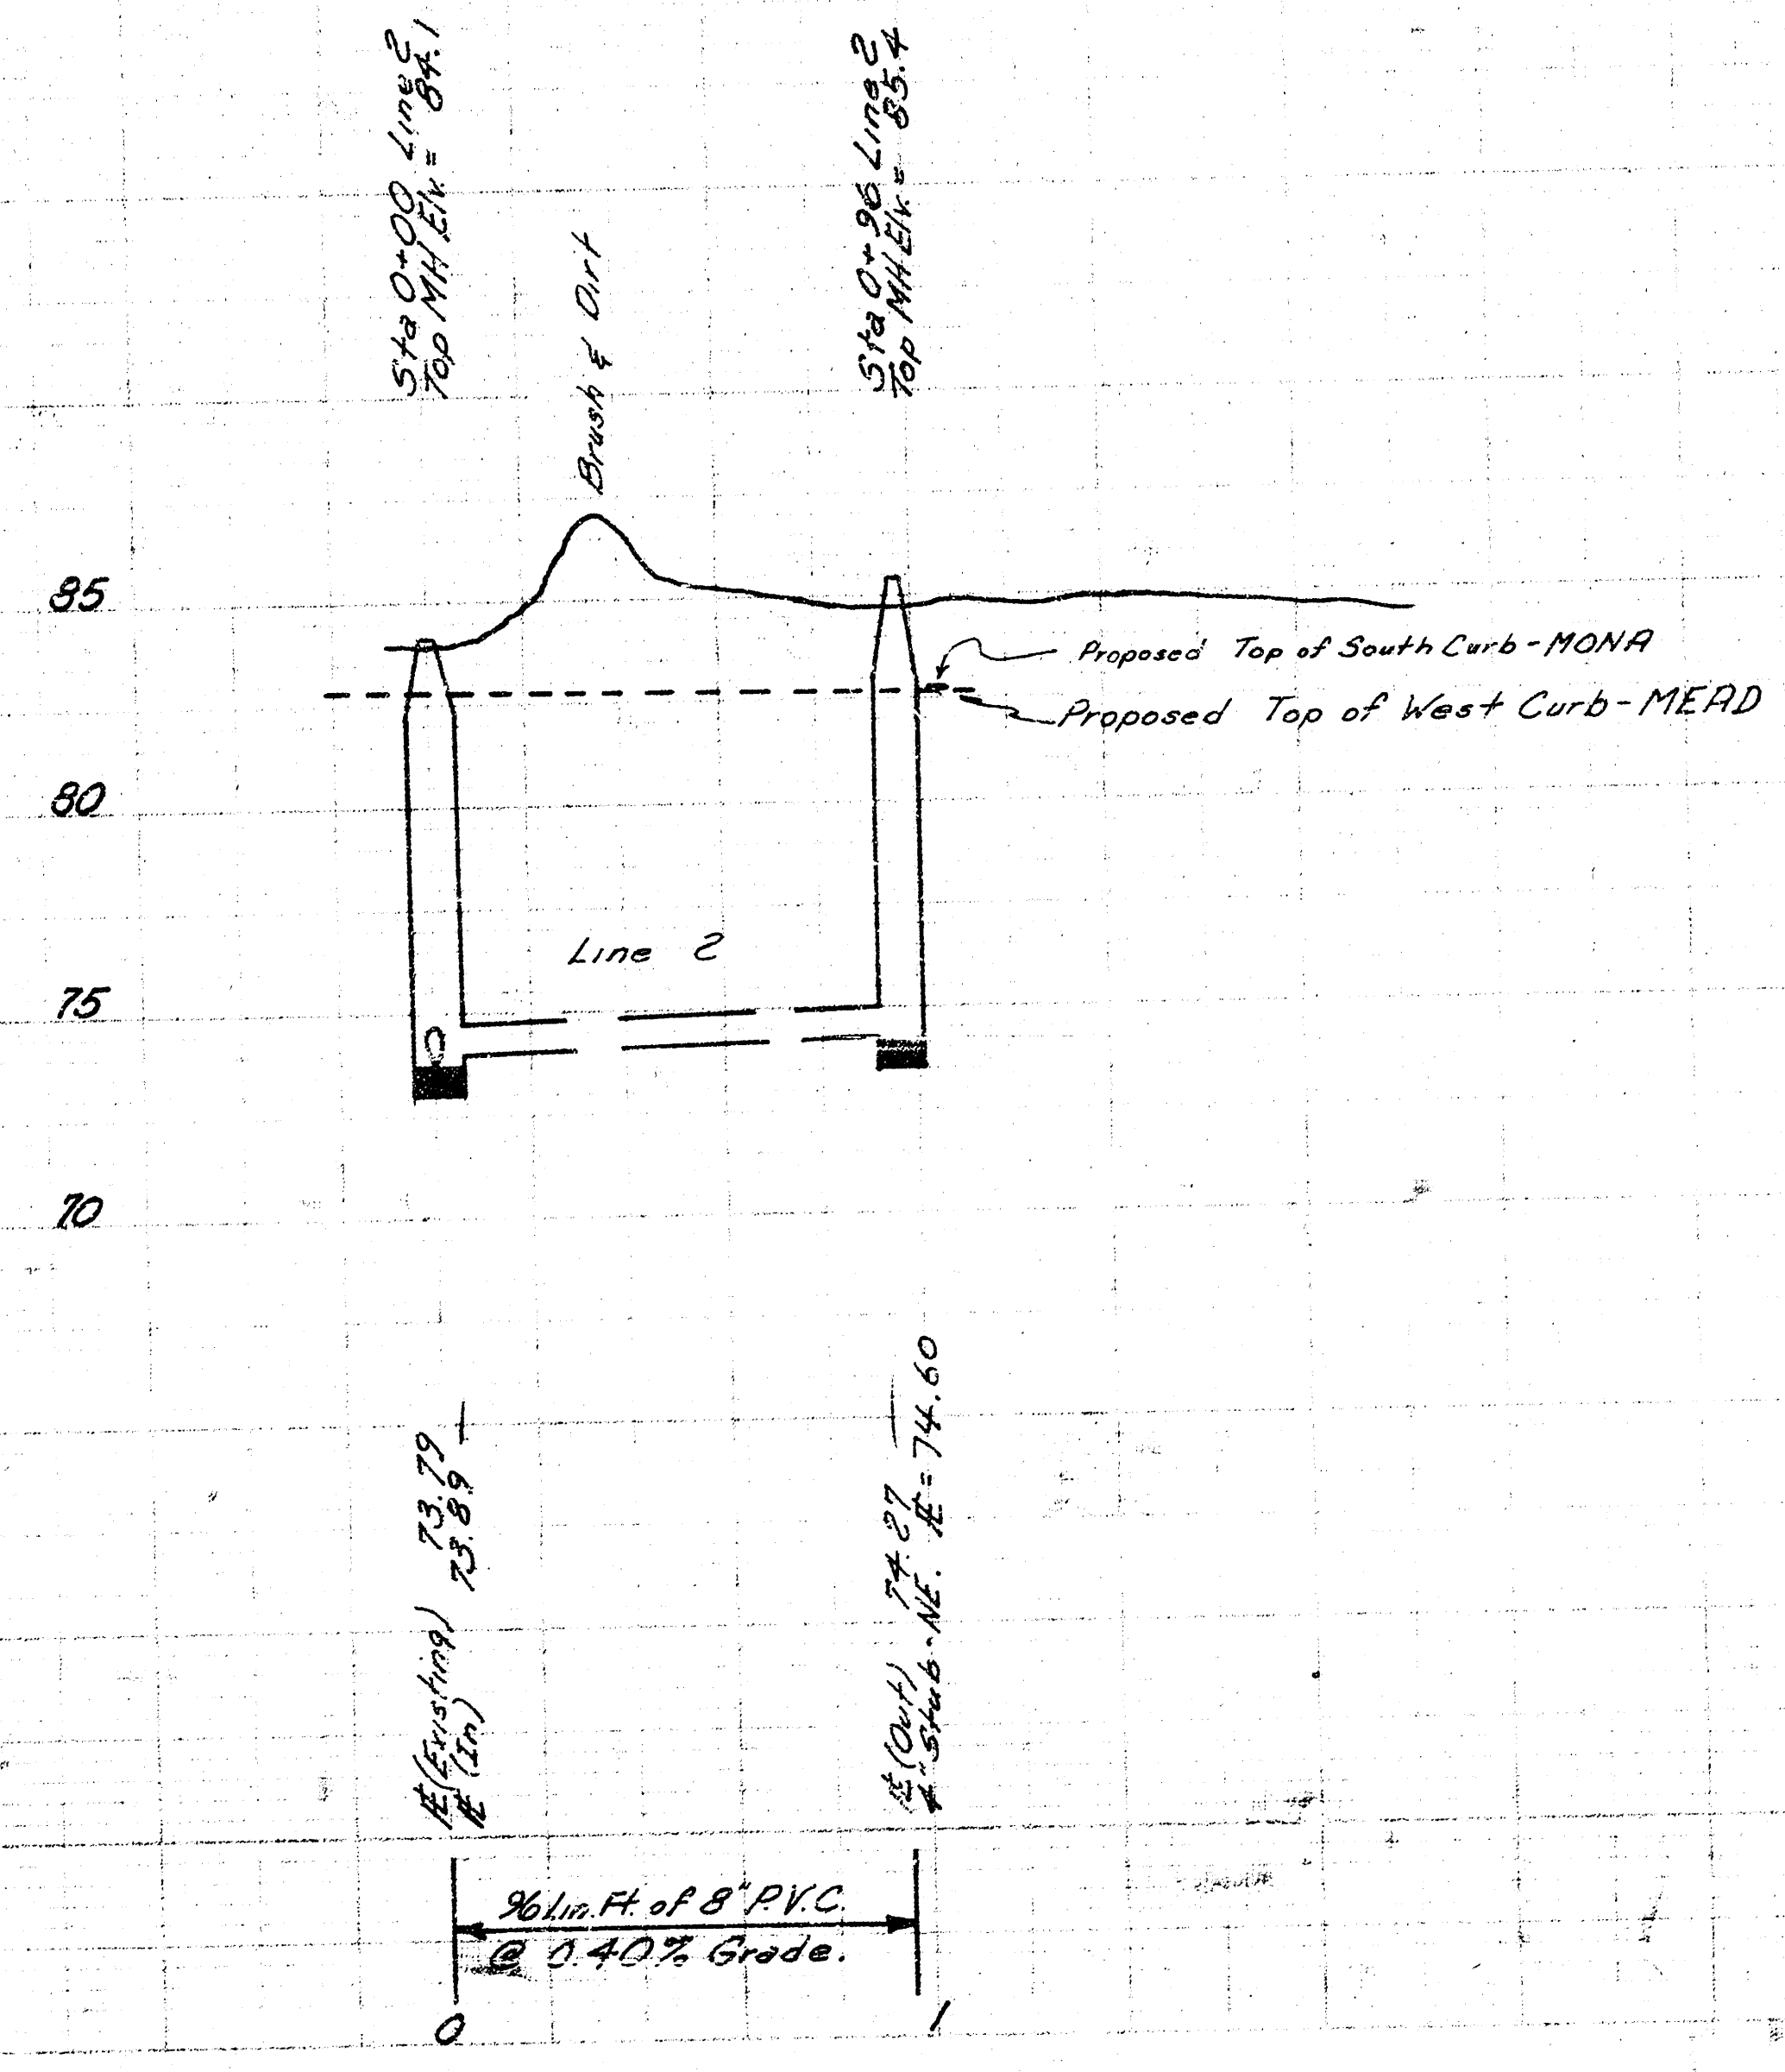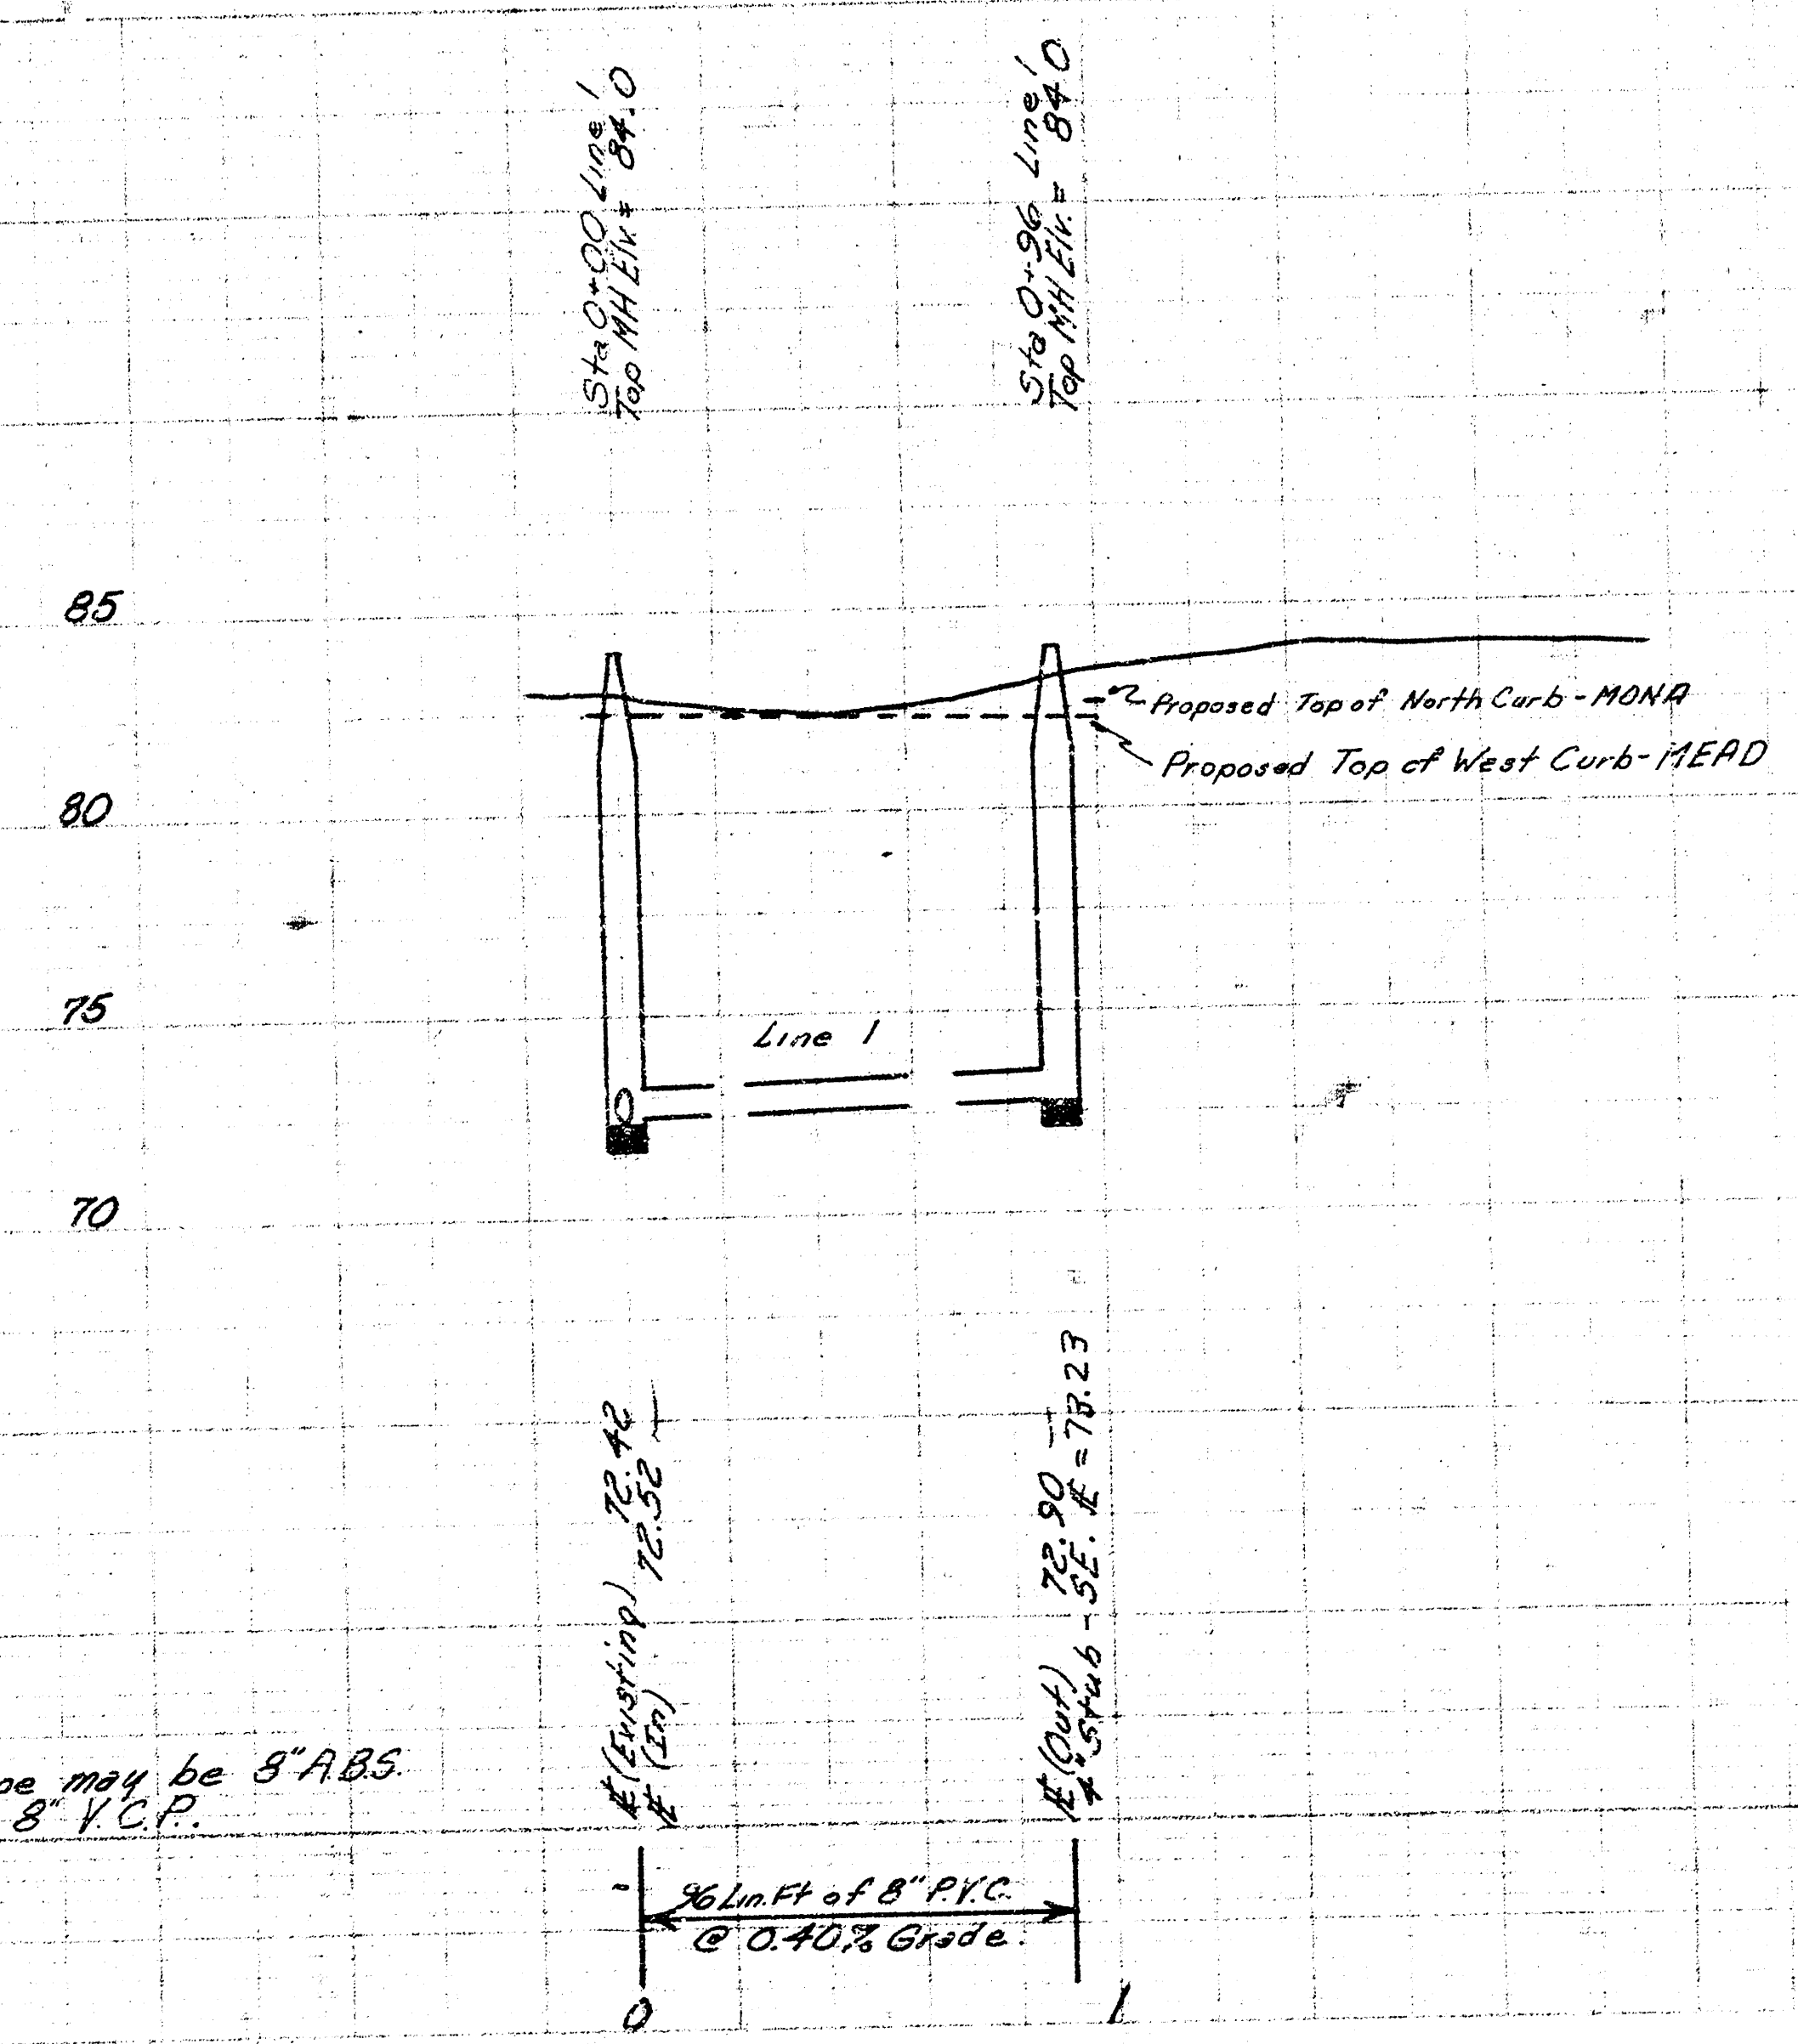

Note: Alternate pipe may be 8" ABS
 Comp. Pipe or 8" V.C.P.

As Built
 11/81

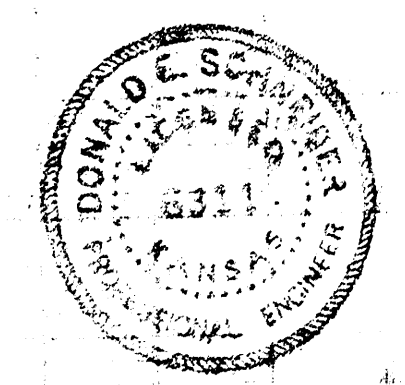

SHEET 1 of 1
 LAT. 21, MAIN 2, S.W.
 CITY OF WICHITA, KANSAS
 R.W. BRUGGEMAN
 DIRECTOR OF ENGINEERING/CITY ENGINEER
 PROJ. NO. 468-76-245-81087-000-000-001