



DATE: Aug 20, 1976
BY: L. J. Lacey

B.M. 82.97 R.R. spike East side of power pole on NW corner of Seneca and 51st St. South.
B.M. 83.525 A.R. spike East side of power pole, East of Seneca, 135' N. of 51st St. South.
B.M. 84.17 R.R. spike North face of power pole, East side of Osage, 135' N. of 51st St. South.

NOTE: ALL FENCES REMOVED TO FACILITATE CONSTRUCTION OF THIS PROJECT SHALL BE REPLACED IN A CONDITION AT LEAST EQUAL TO THE ORIGINAL.



Scale 1"=40'

Scale: Hor. 1"=40'
Ver. 1"=5'

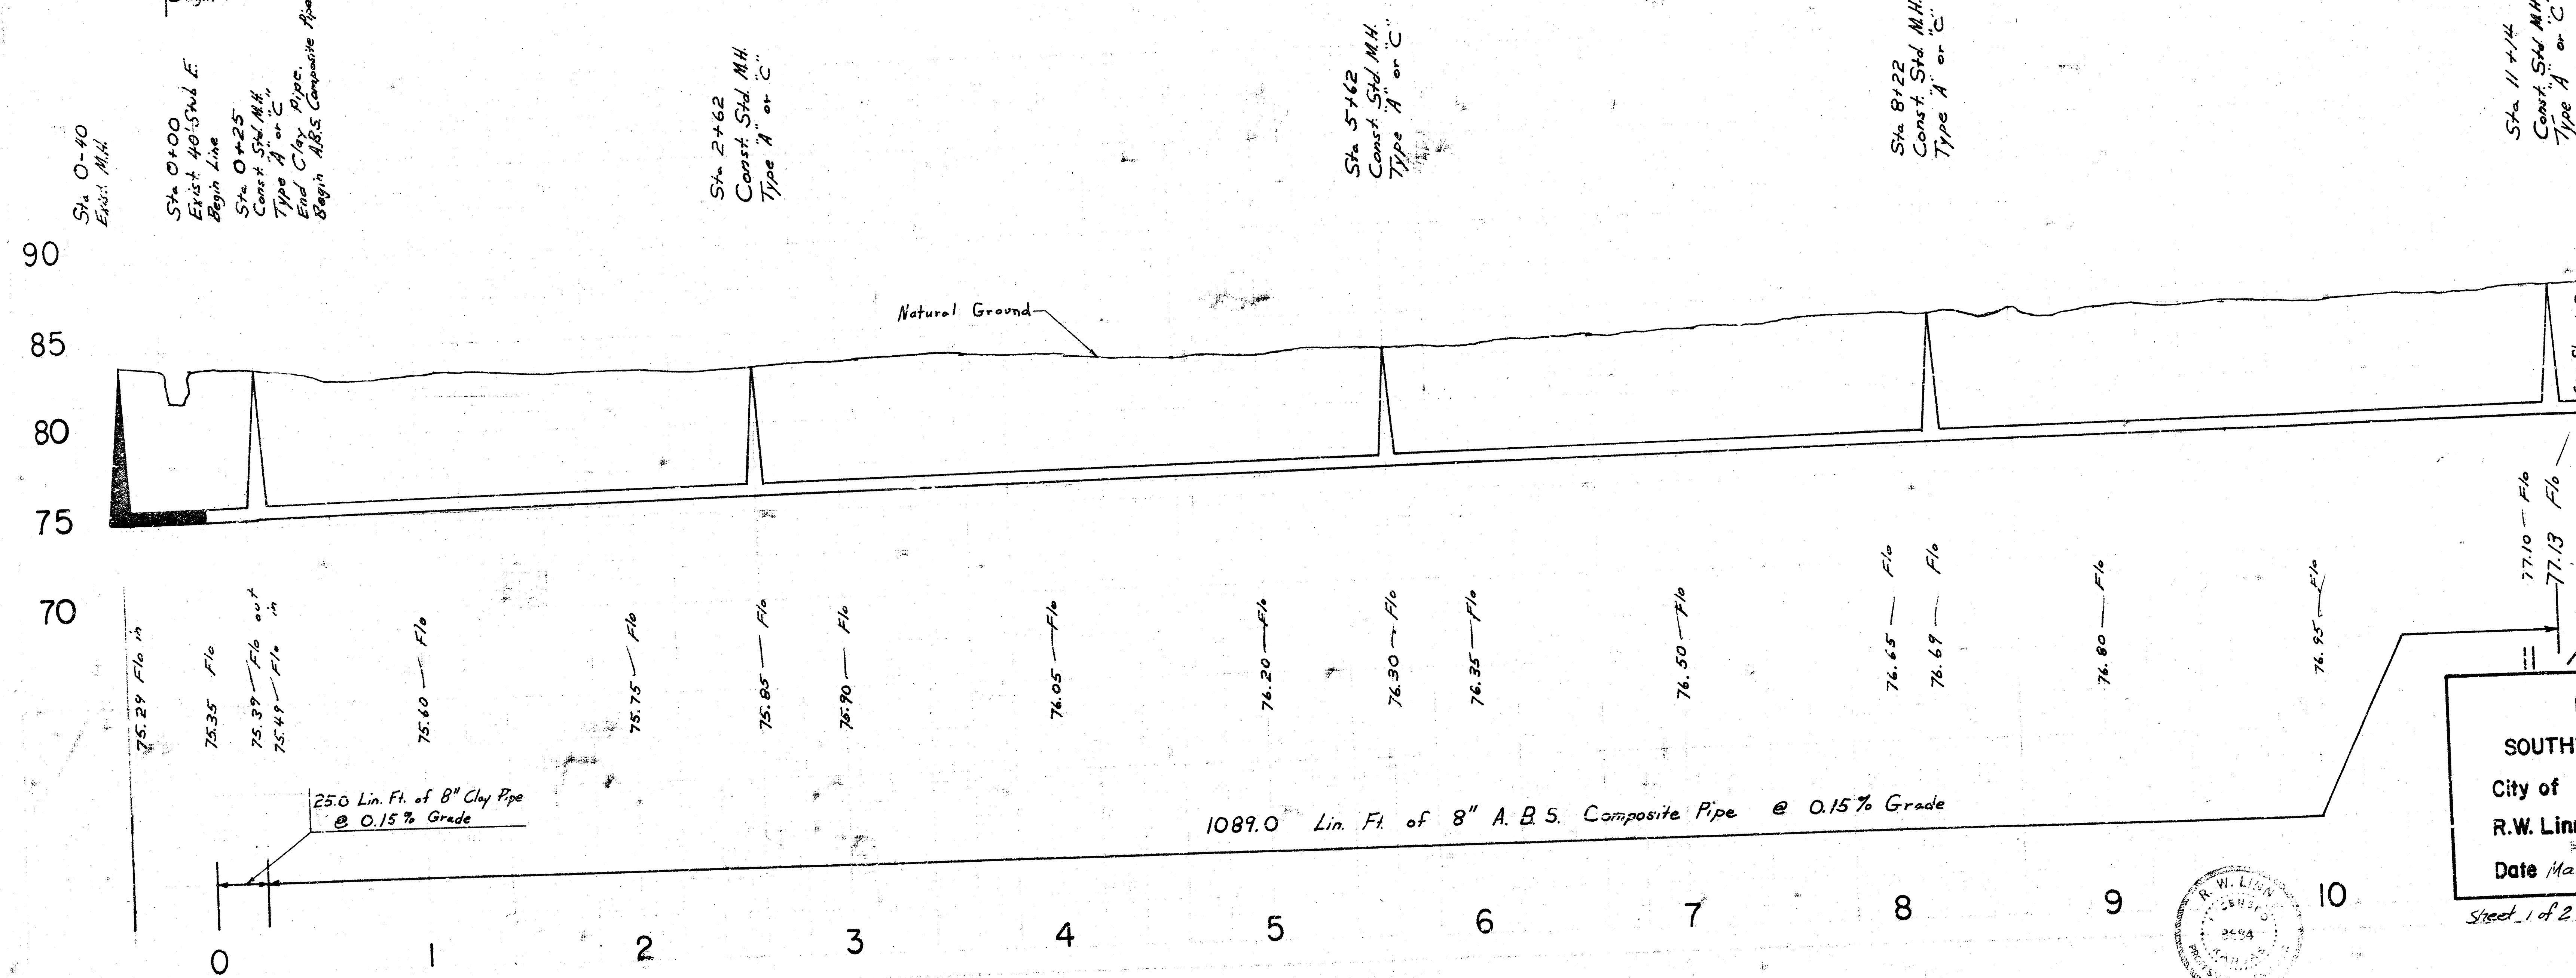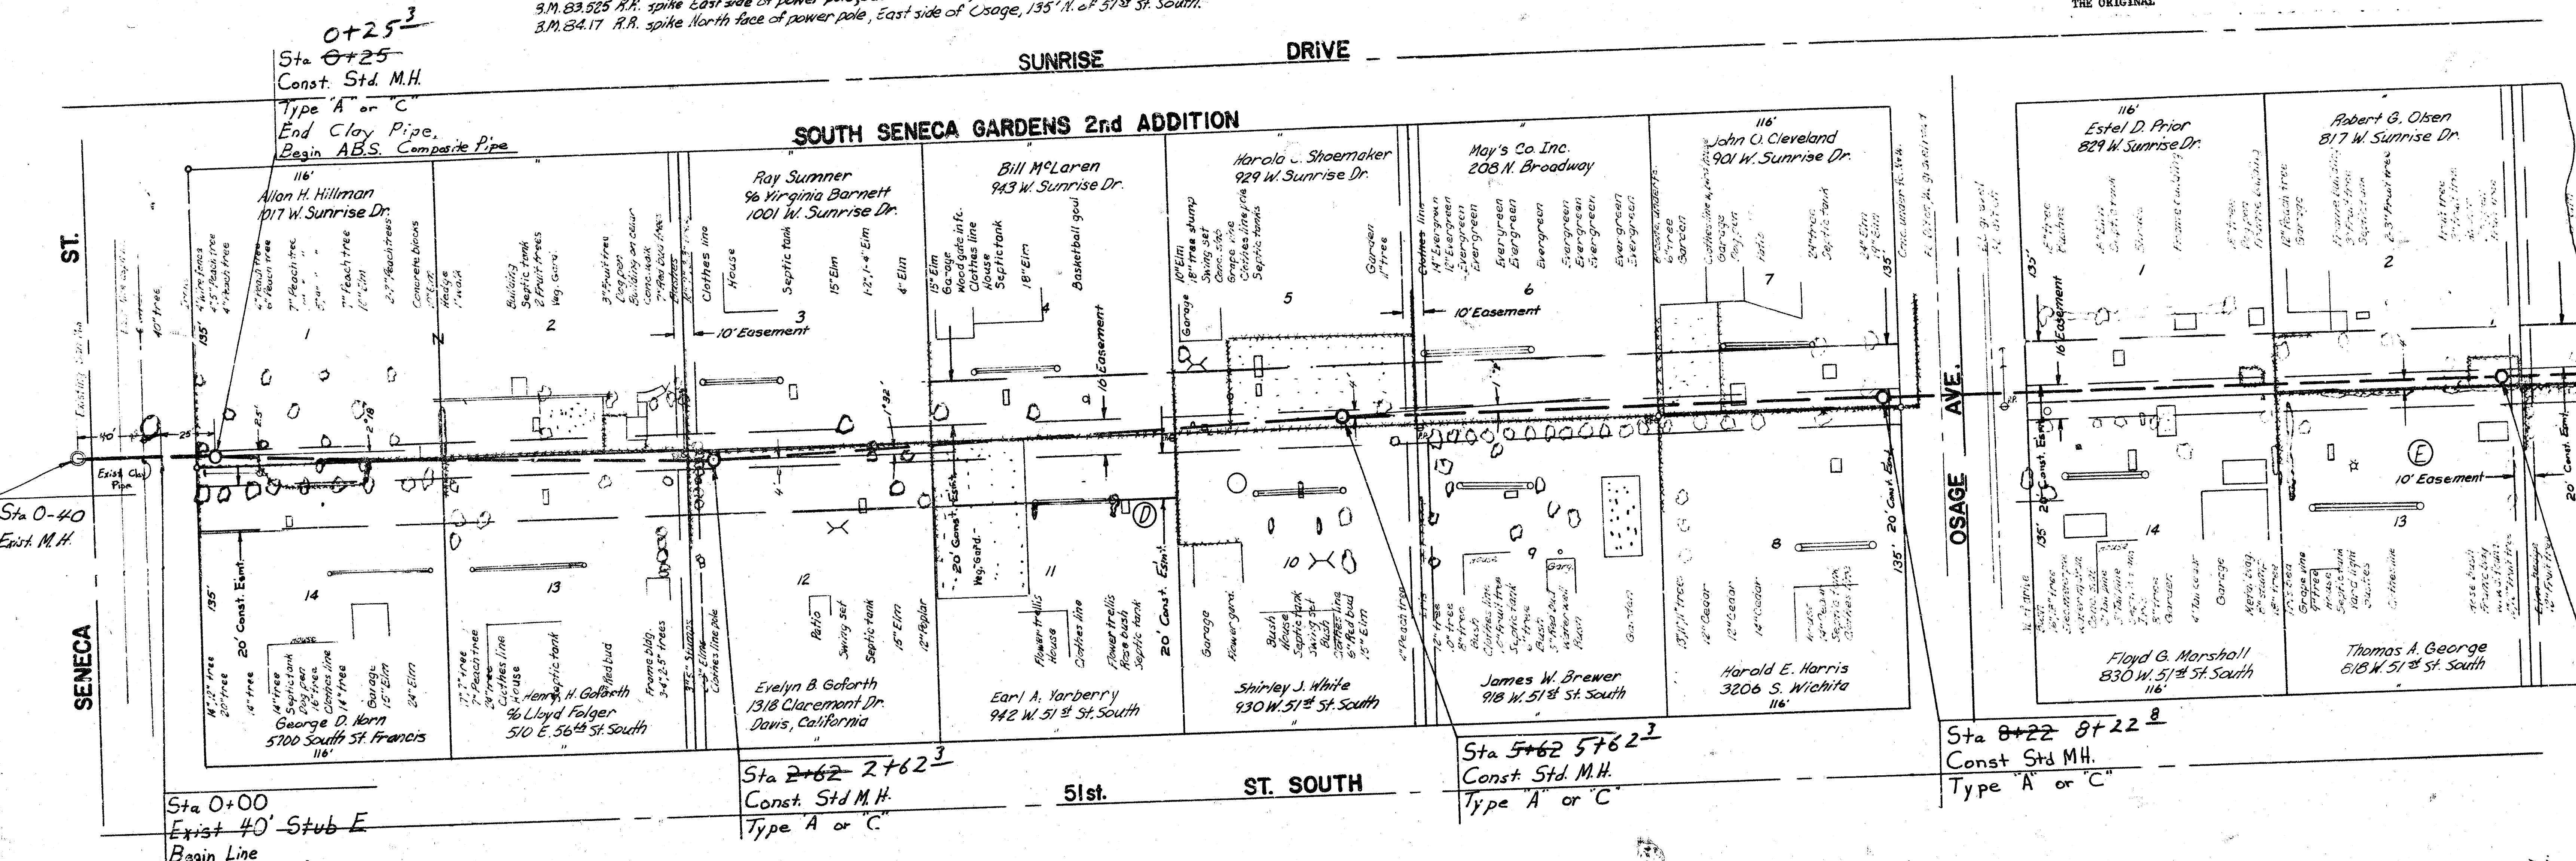

As Built 7-12-76
LAT. II, MAIN 3
SOUTHWEST INTERCEPTOR
City of Wichita, Kans.
R.W. Linn City Engineer
Date March 1976 Proj. no. DBKL572008
Sheet 1 of 2

601174109
601174109

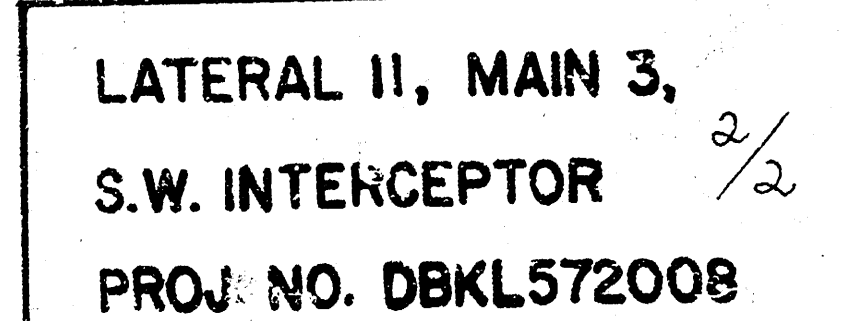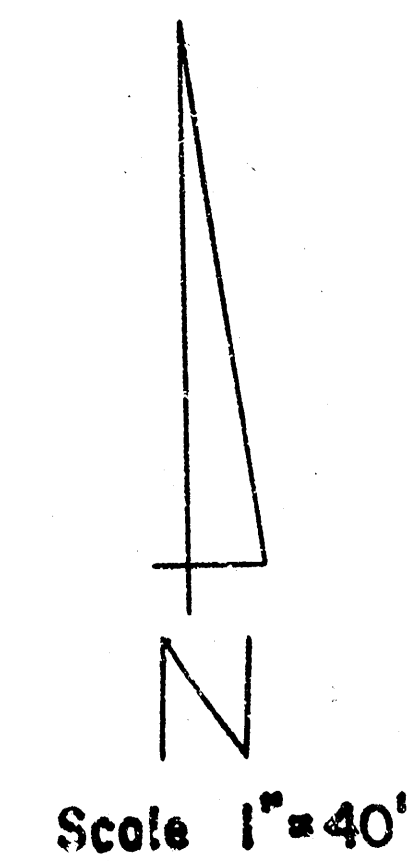

Sheet 2 of 2