



B.M. 92.23 "X" in conc. on S-end of wing wall
 @ N. end of bridge span on W-side of
 Seneca & Carey Lane.

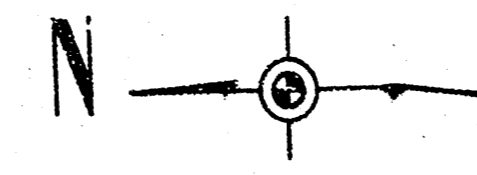




Plan Scale 1" = 40'
 Profile Scale 1" = 5' Vert.

123
 Checked by [Signature]
 D. R. W.

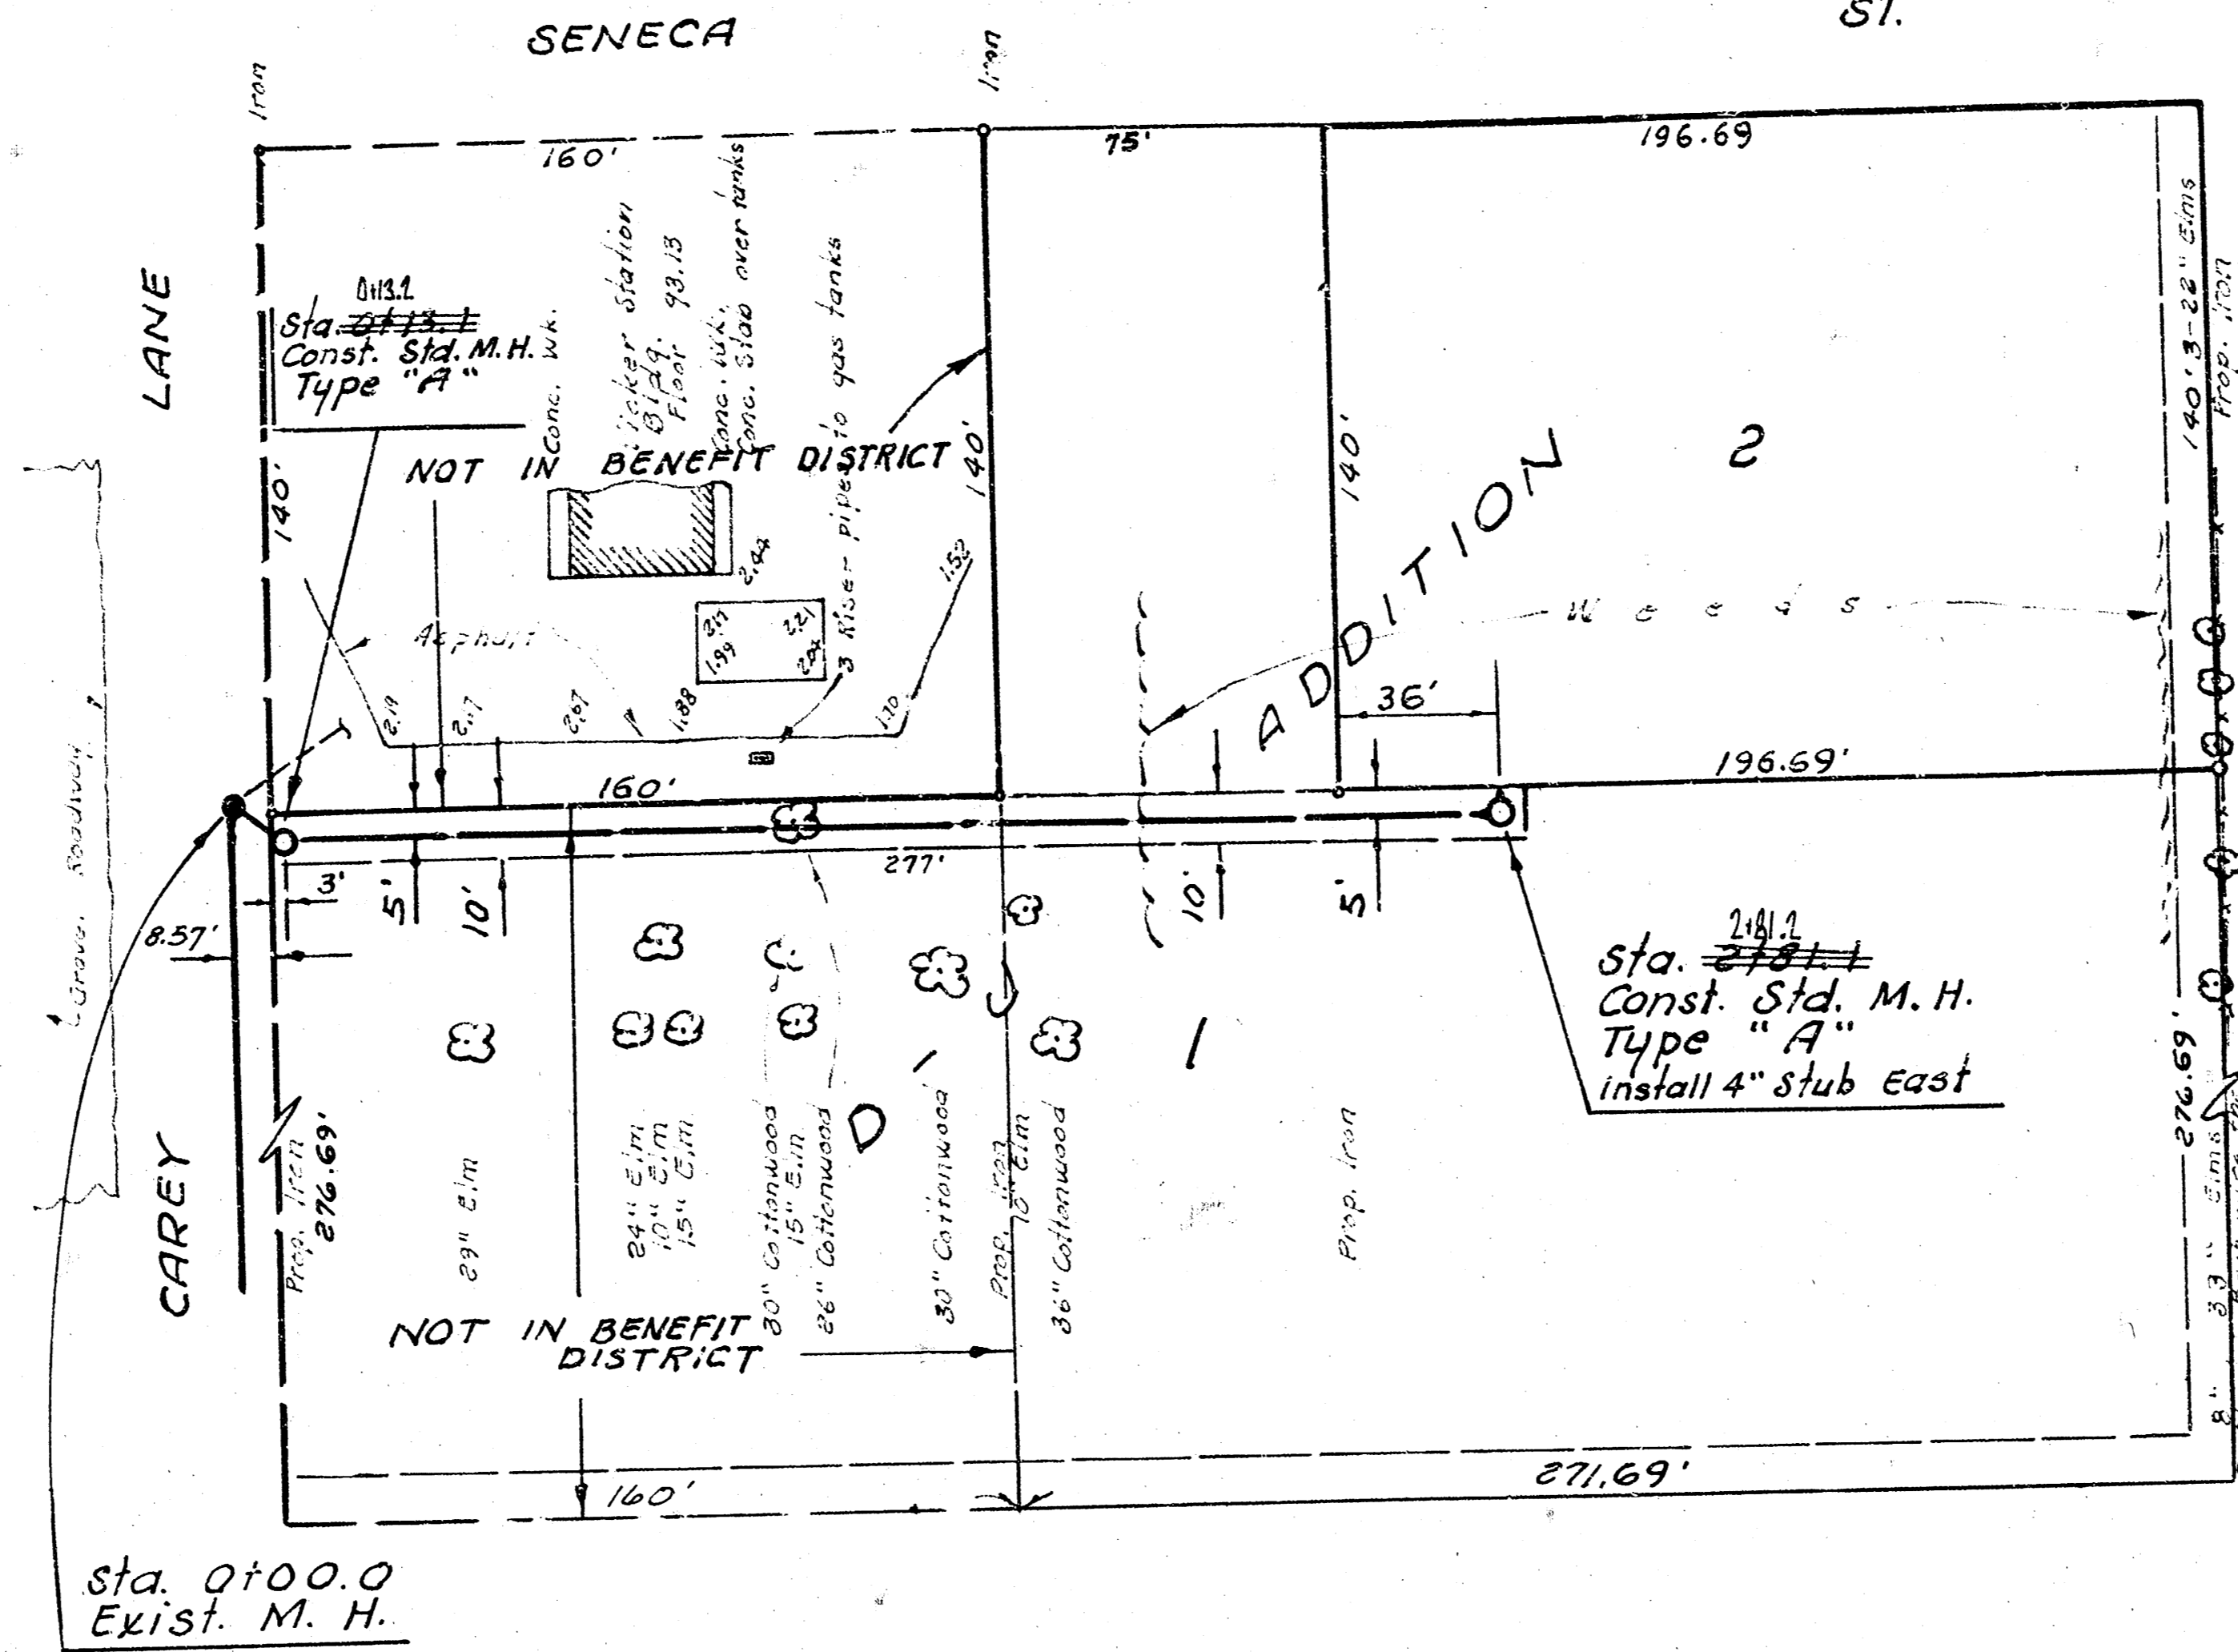

NOTE:
 Sewer pipe must
 have 30" cover.

1/2" H₂O
 No Gas
 Surface
 Reference
 18.5

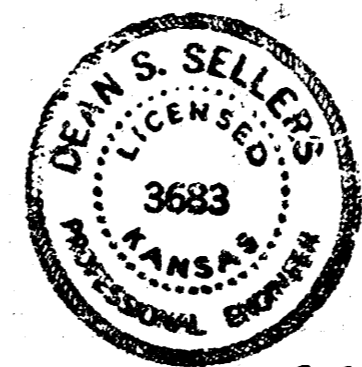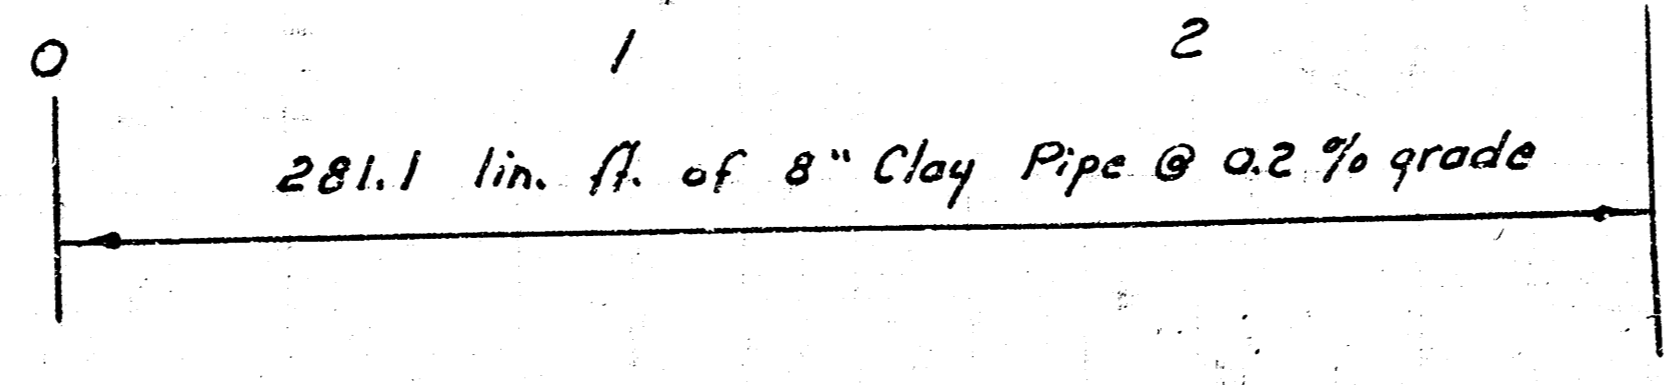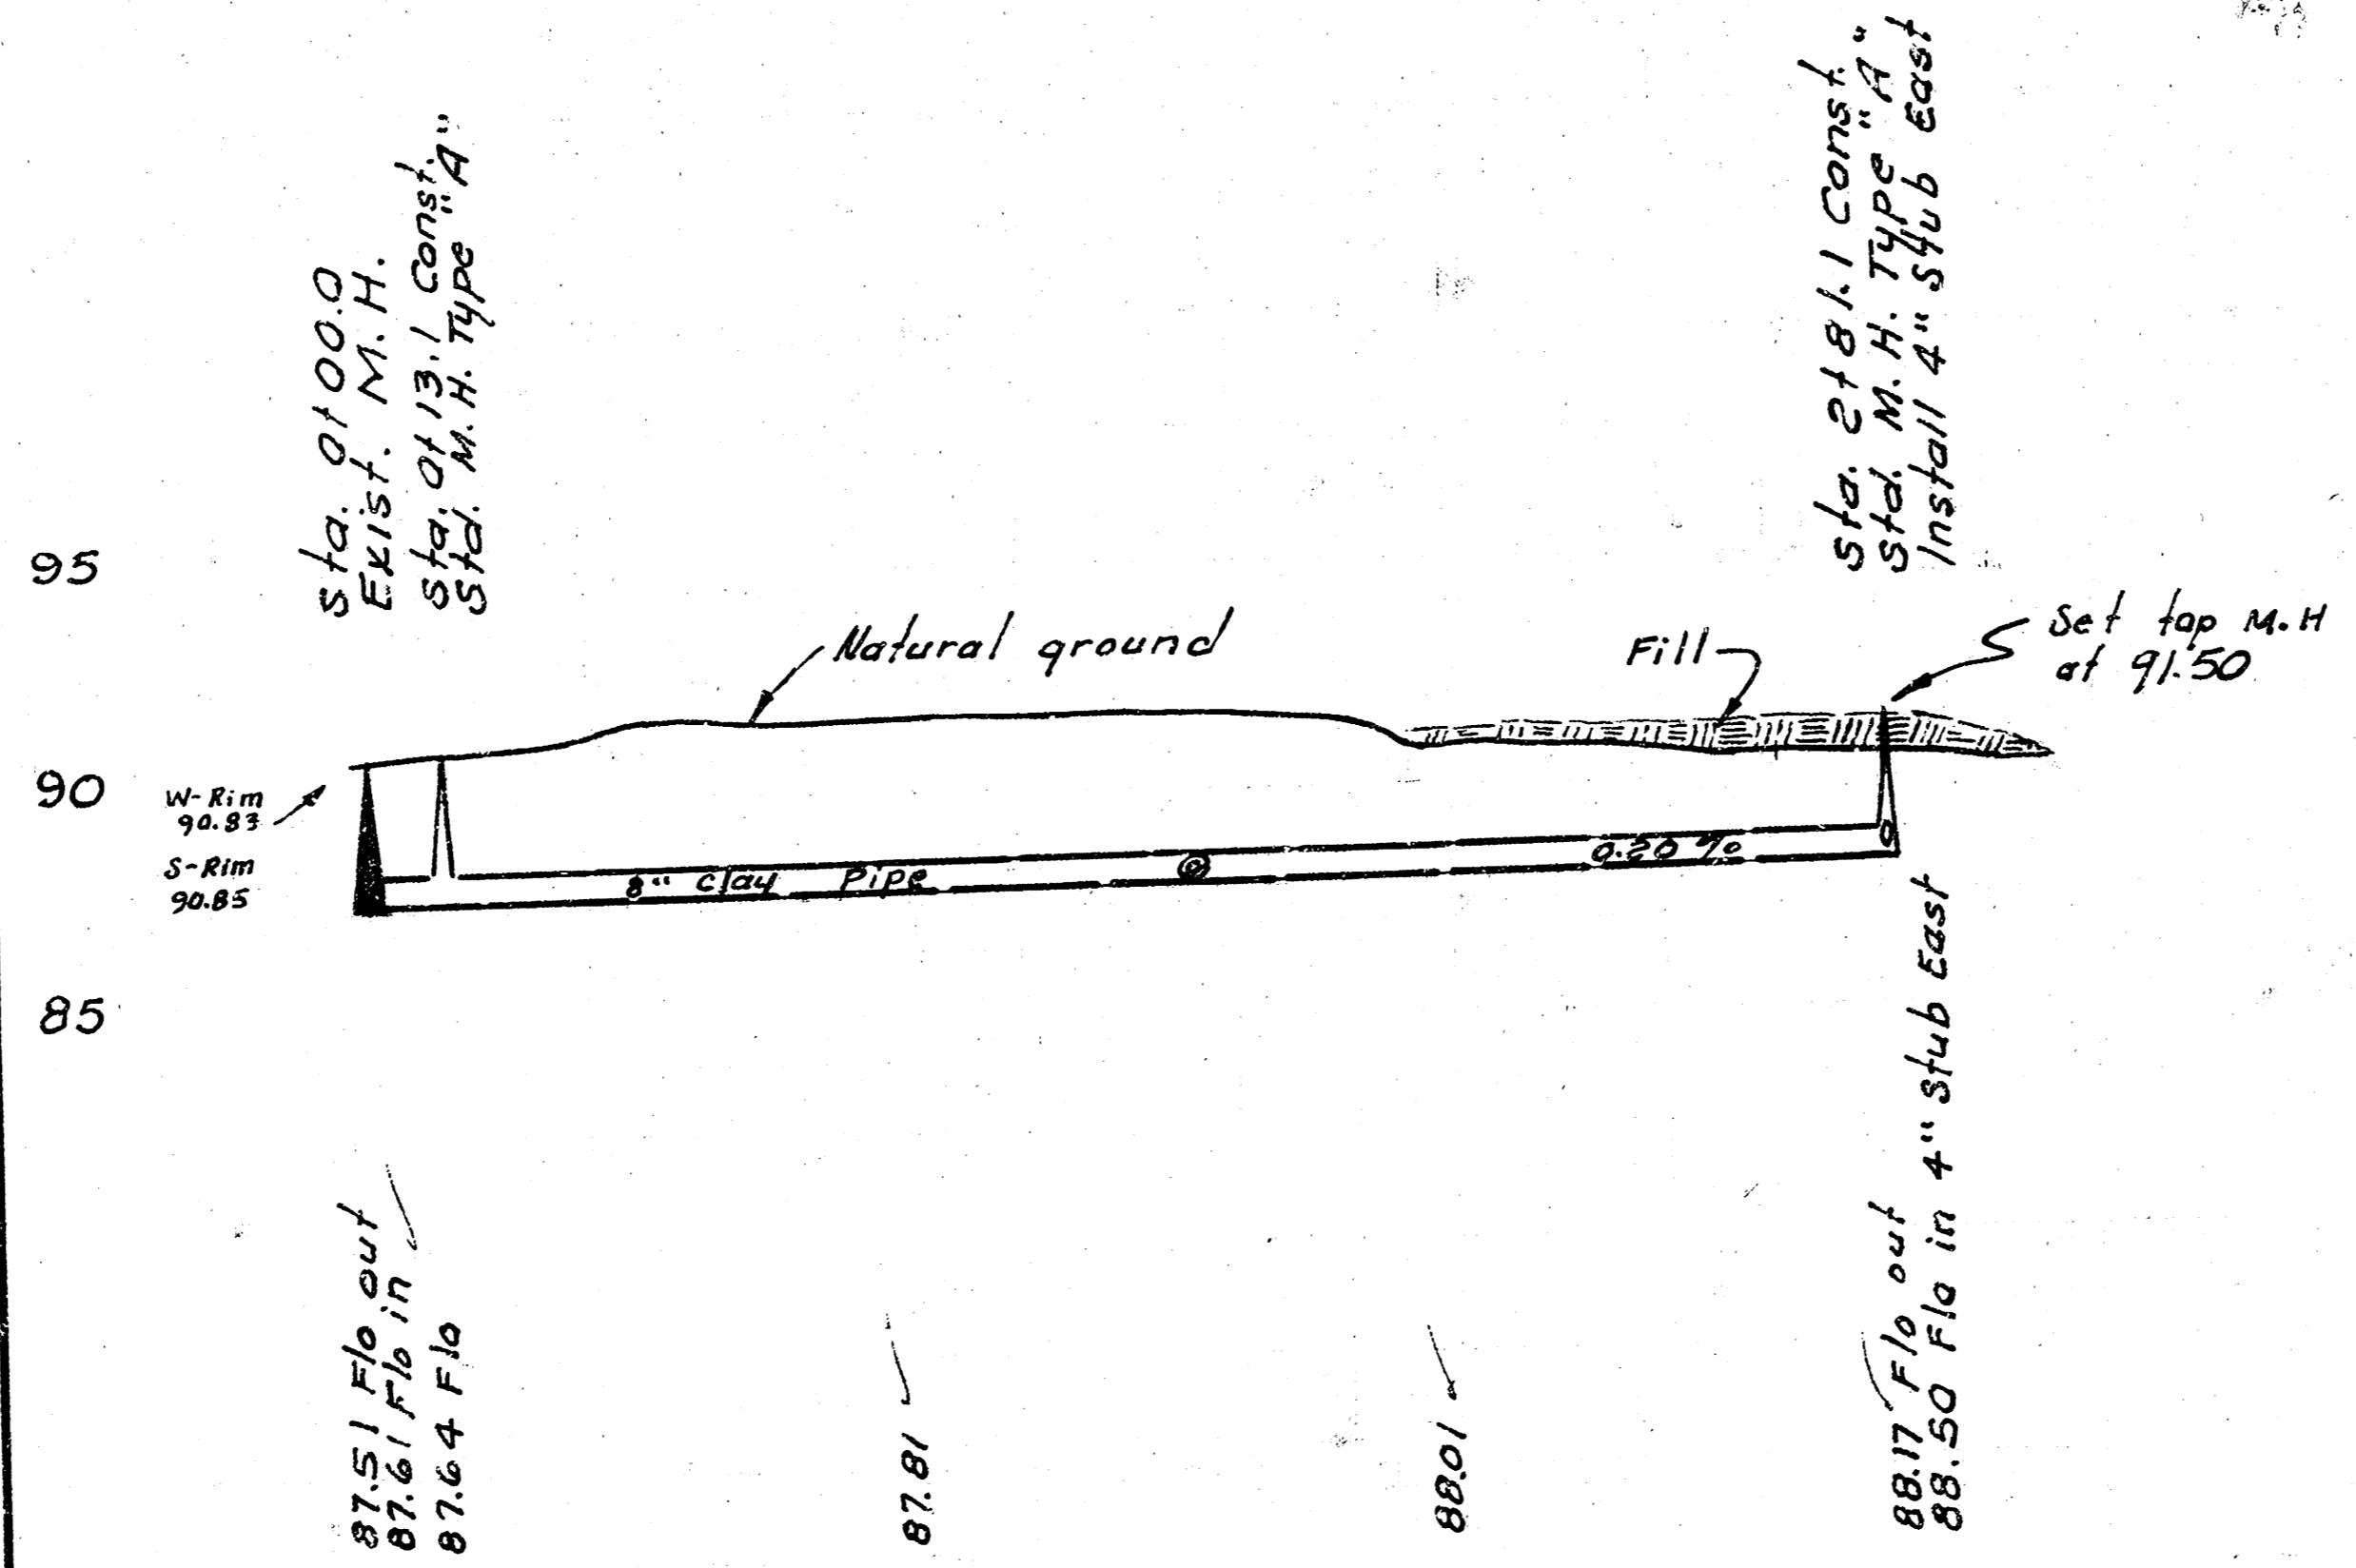

"AS BUILT" FINAL MEASUREMENTS IN S.S.#11 JK
LAT. 12, MAIN 3, S. W. INTERCEPTOR SEWER
 CITY OF WICHITA, KANSAS
 R. W. LINN — CITY ENGINEER
 Sept. 1972 PROJECT NO. DBKLS72039