

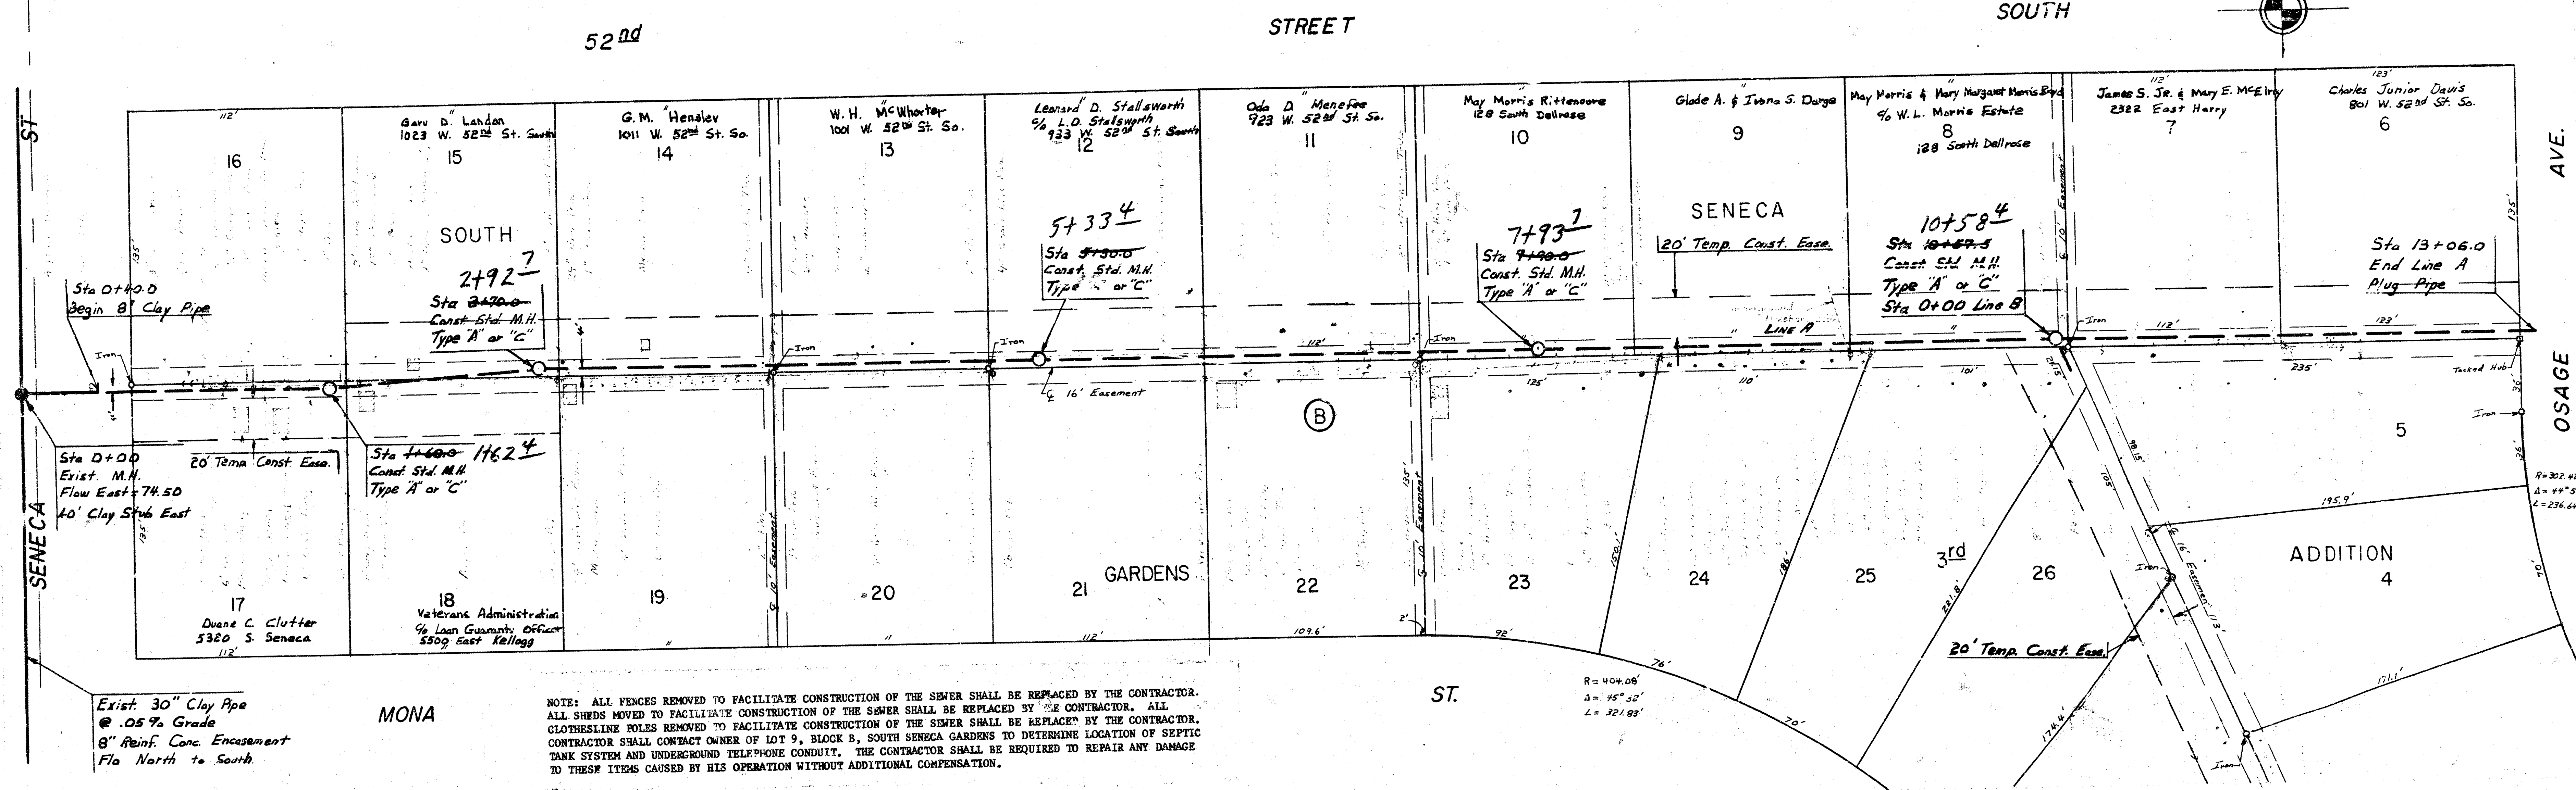


BM = 83.05 - R.R. Sph. East Side P.R. of NW. Cor. Seneca & 52nd St.
 BM = 80.72 - City Std. Disc 30' South & 45' East of E of 55th St. S. & Seneca.

Plan Scale 1" = 40'
 Profile Scale 1" = 40' Horiz.
 1" = 5' Vert.

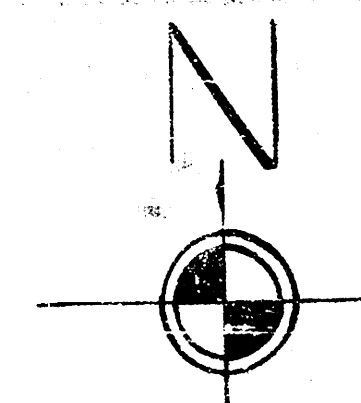


NOTE: ALL FENCES REMOVED TO FACILITATE CONSTRUCTION OF THE SEWER SHALL BE REPLACED BY THE CONTRACTOR. ALL SHEDS MOVED TO FACILITATE CONSTRUCTION OF THE SEWER SHALL BE REPLACED BY THE CONTRACTOR. ALL CLOTHESLINE POLES REMOVED TO FACILITATE CONSTRUCTION OF THE SEWER SHALL BE REPLACED BY THE CONTRACTOR. CONTRACTOR SHALL CONTACT OWNER OF LOT 9, BLOCK B, SOUTH SENECA GARDENS TO DETERMINE LOCATION OF SEPTIC TANK SYSTEM AND UNDERGROUND TELEPHONE CONDUIT. THE CONTRACTOR SHALL BE REQUIRED TO REPAIR ANY DAMAGE TO THESE ITEMS CAUSED BY HIS OPERATION WITHOUT ADDITIONAL COMPENSATION.

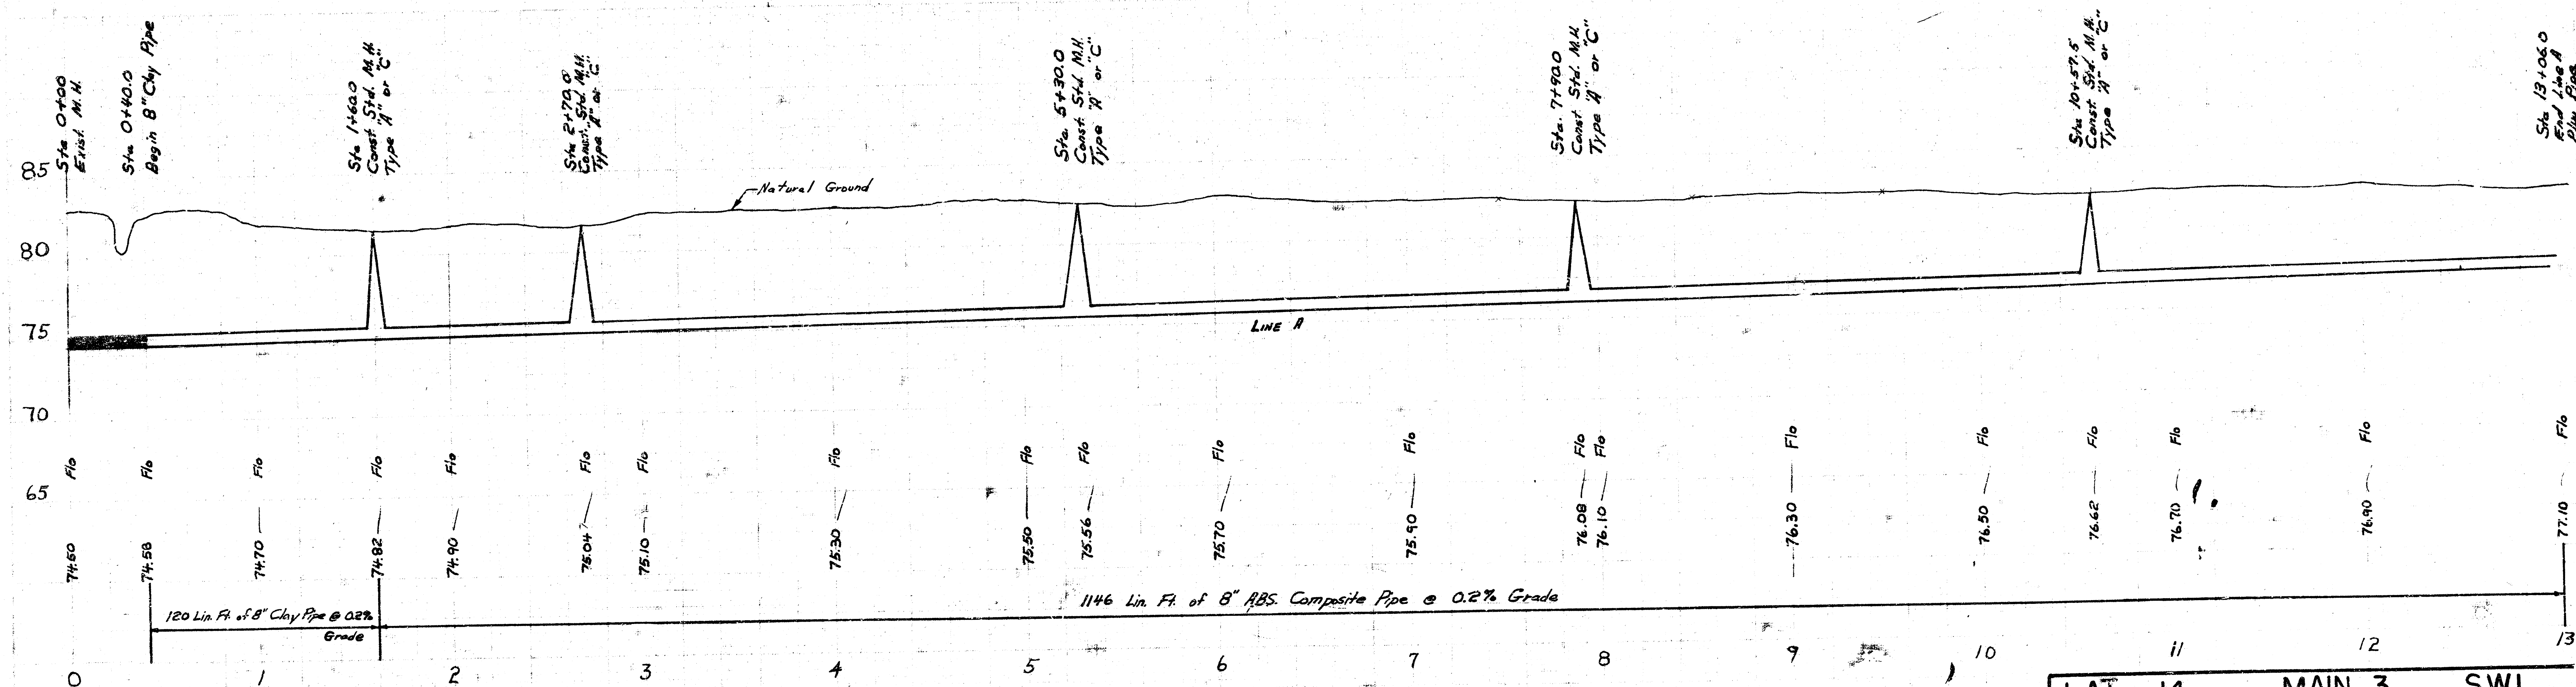

LAT. 14 MAIN 3 SWI
 CITY OF WICHITA, KANSAS
 R. W. LINN - CITY ENGINEER
 PROJECT NO. DBKL 575018

As built 6-8-77

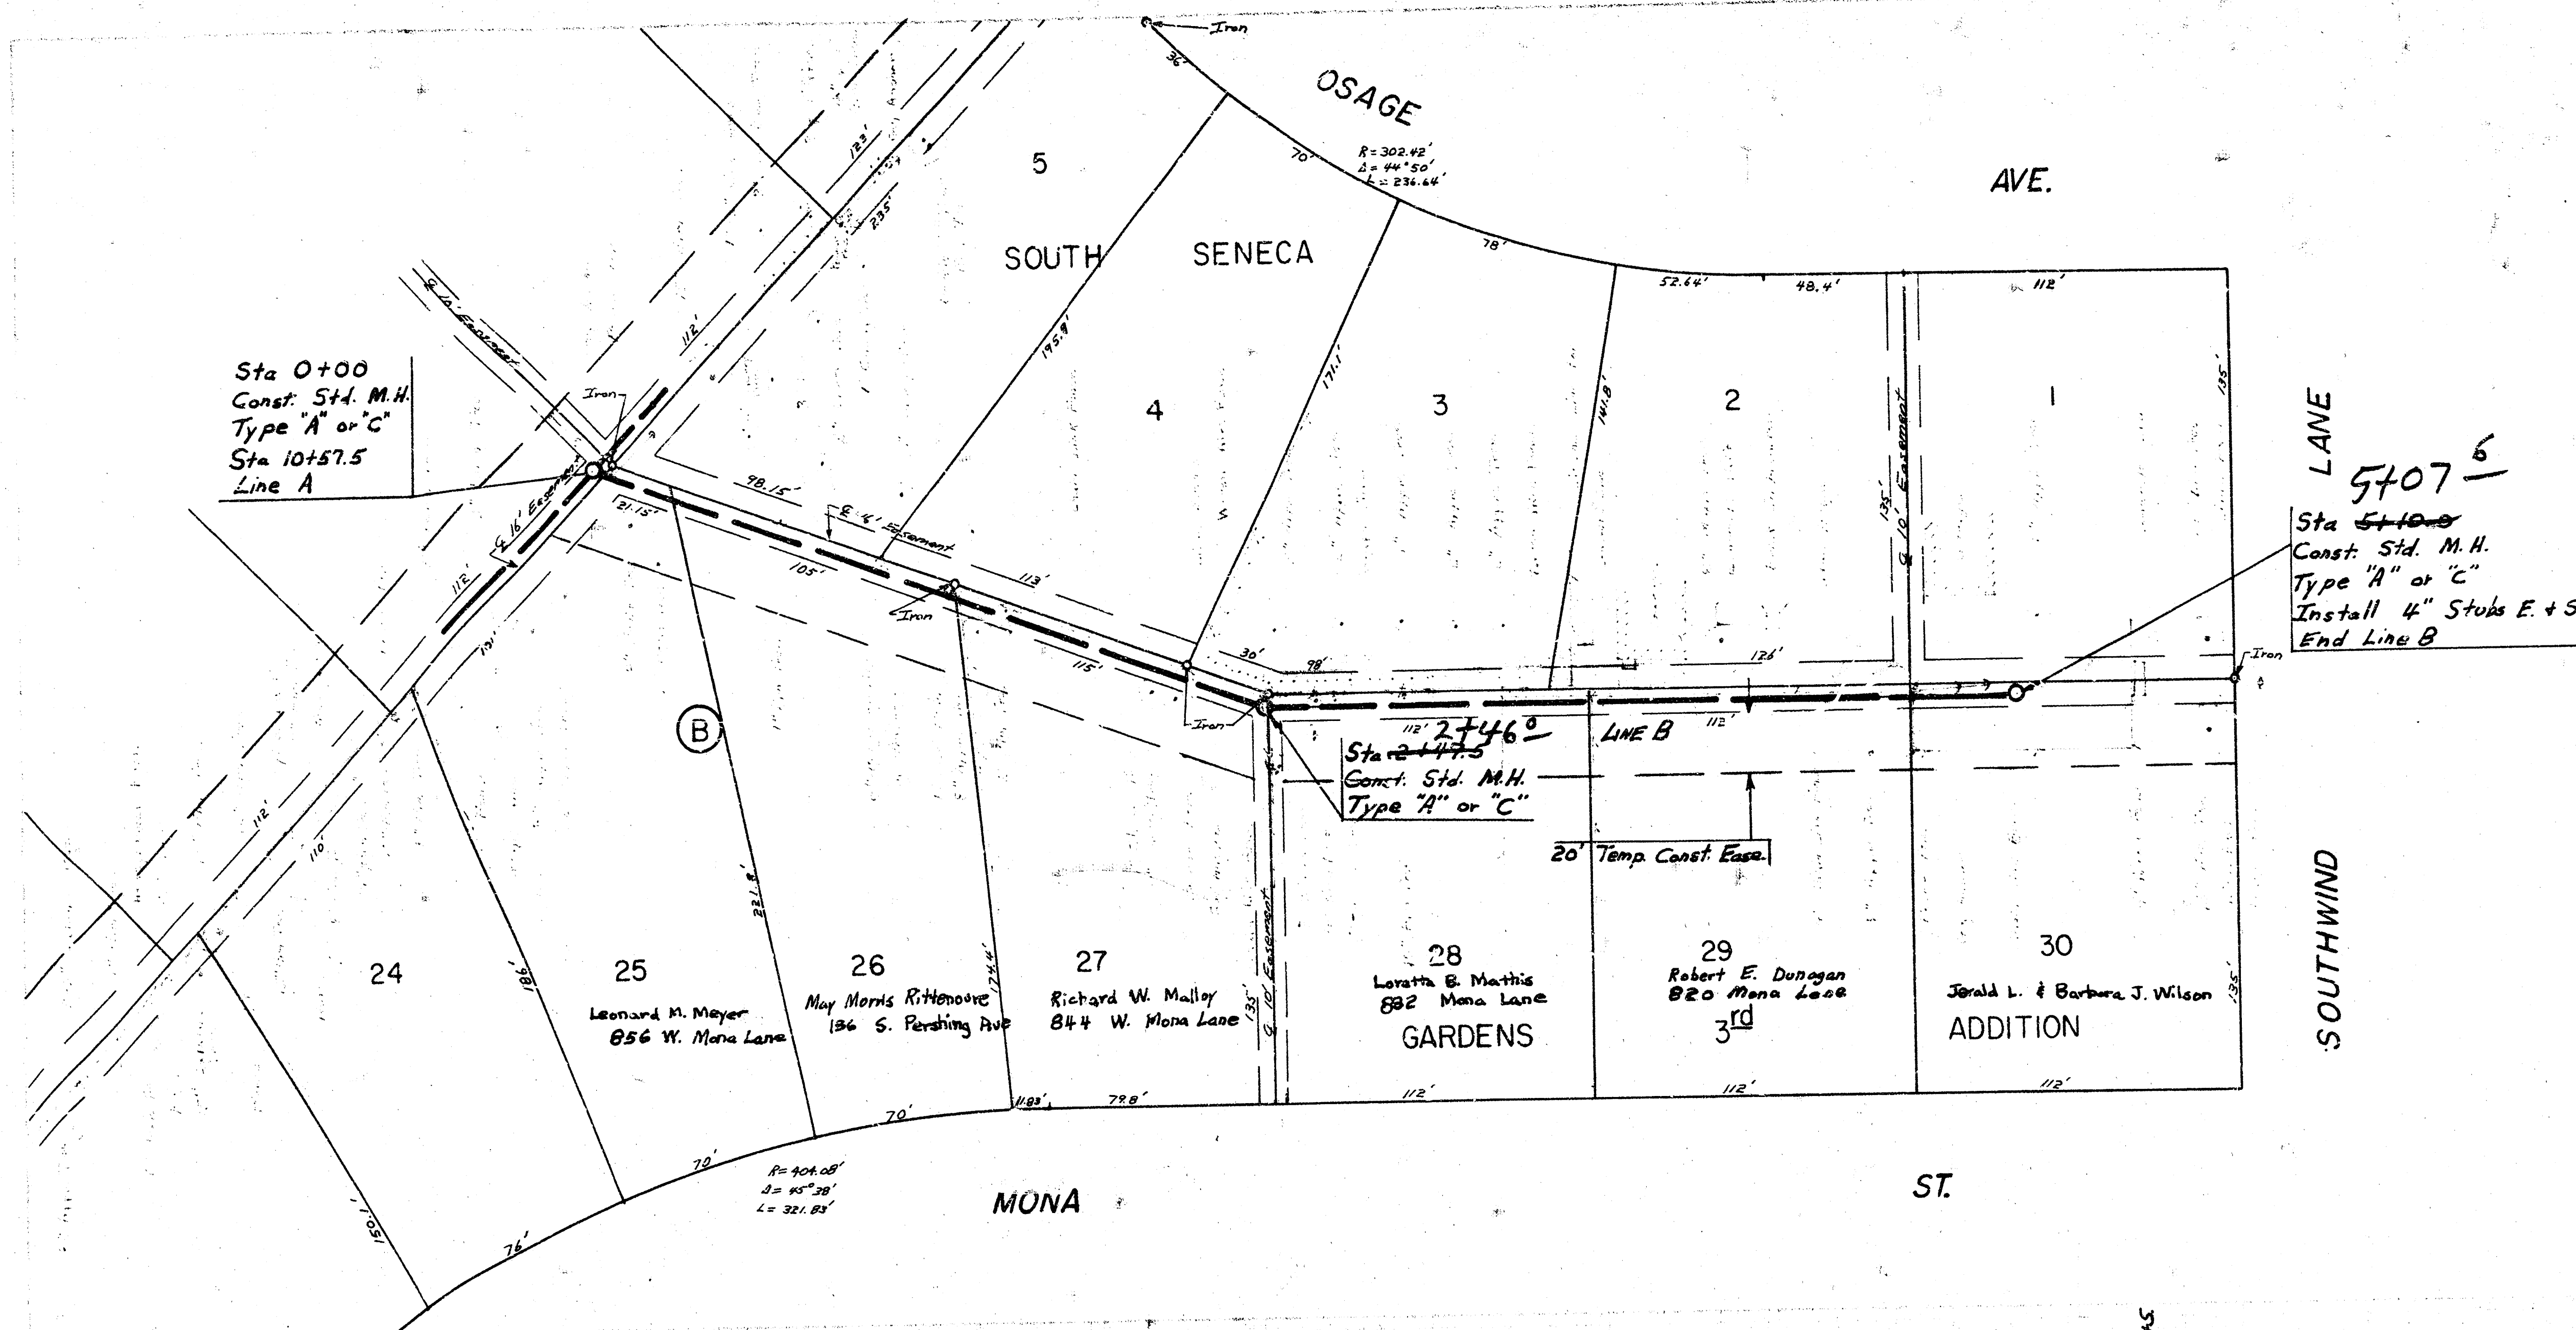

Plan Scale 1" = 40'
 Profile Scale 1" = 40' Horiz.
 1" = 5' Vert.

