



B.M. 85.30 NE Corner of Concrete Porch to House @ 5319 S. Osage Ave.
Bgt. 83.98 NE Corner of Concrete Porch to House @ 801 W. 52nd St. So.
B.M. 80.72 City Sid. Disc. 30' S + 45' E of E. Seneca + 55' S. So.

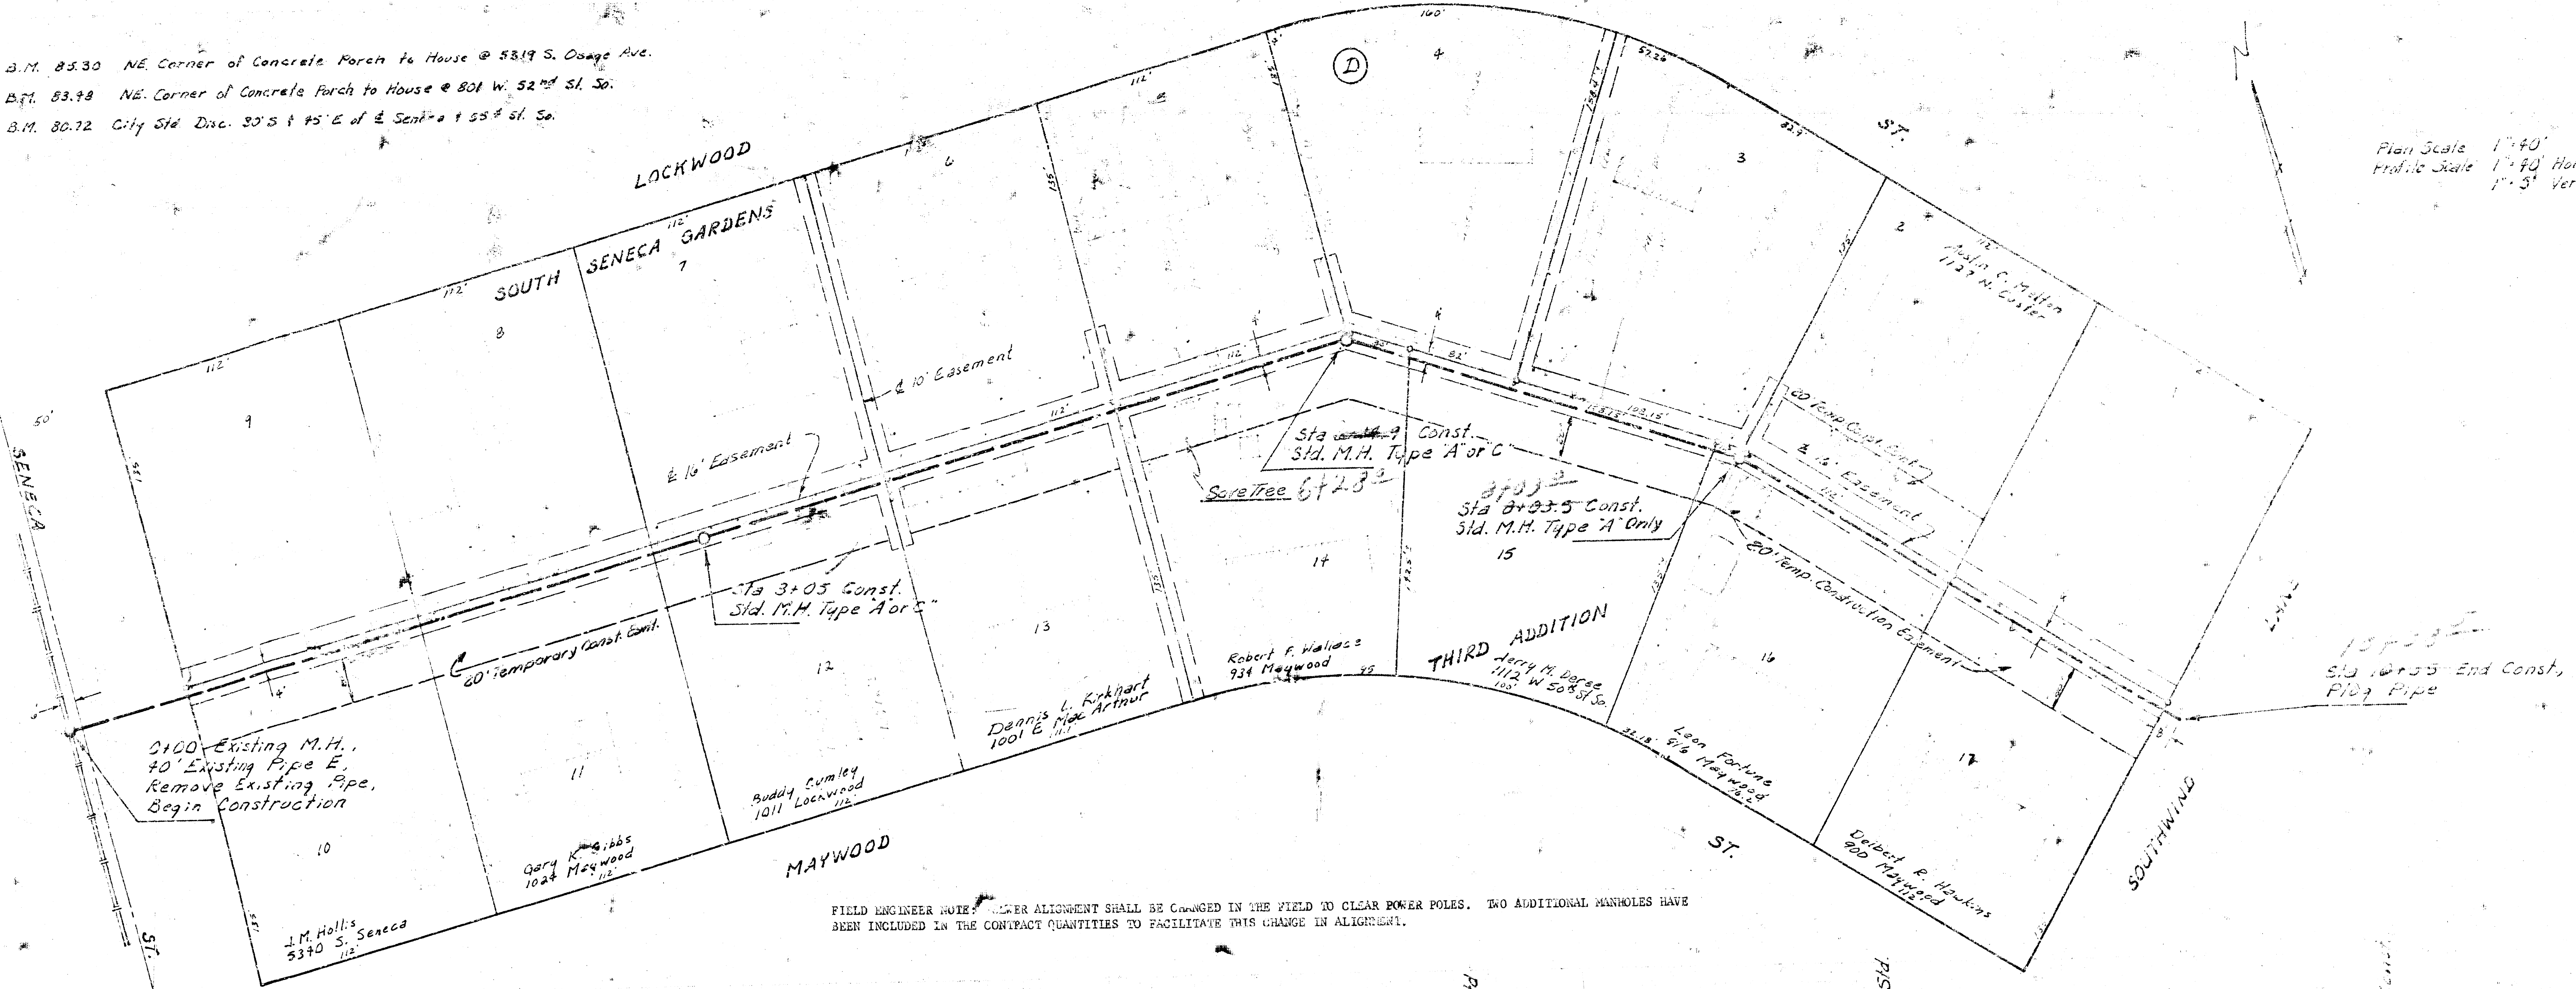

FIELD ENGINEER NOTE: SEWER ALIGNMENT SHALL BE CHANGED IN THE FIELD TO CLEAR POWER POLES. TWO ADDITIONAL MANHOLES HAVE BEEN INCLUDED IN THE CONTRACT QUANTITIES TO FACILITATE THIS CHANGE IN ALIGNMENT.

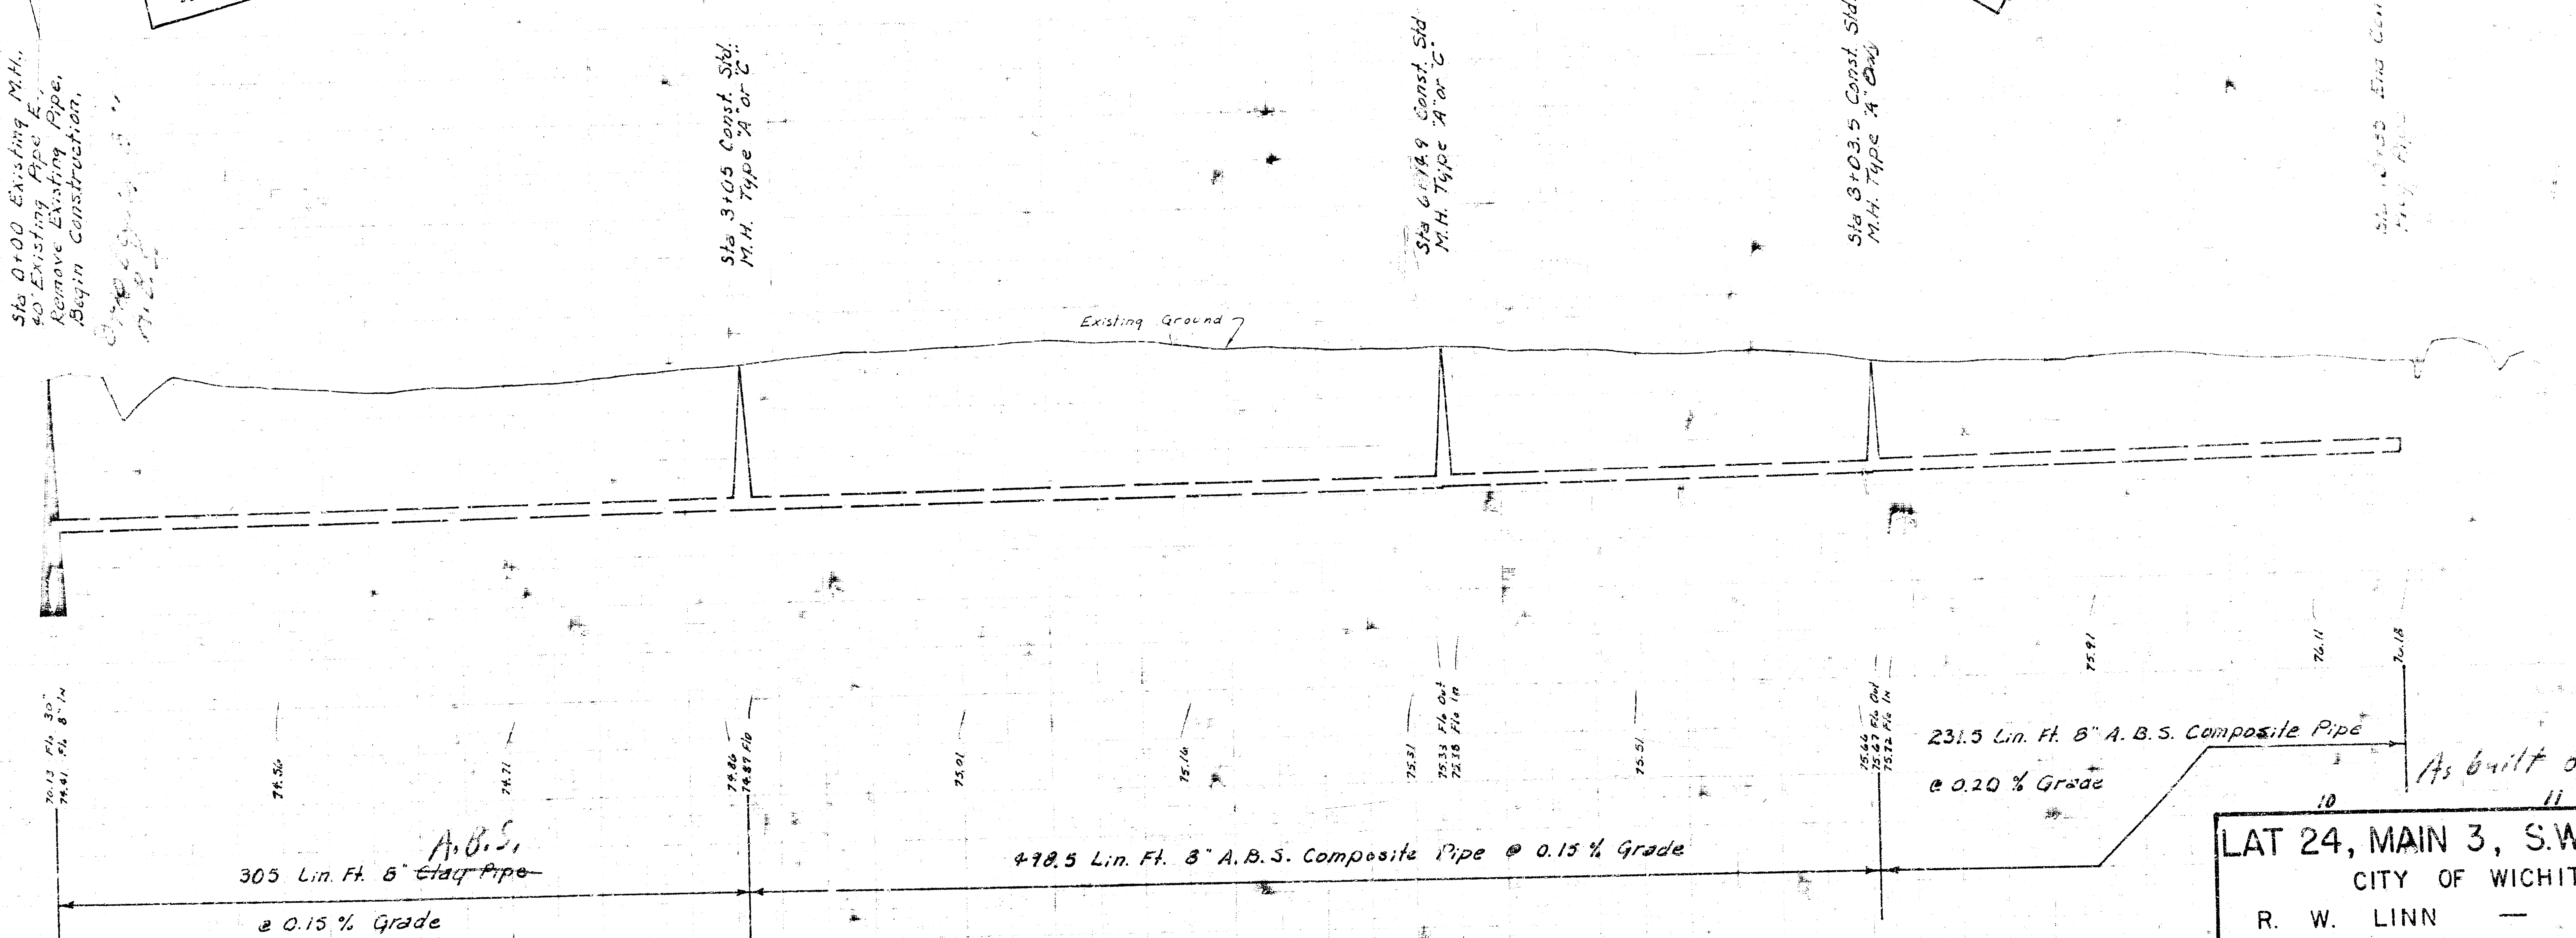

LAT 24, MAIN 3, S.W. INTERCEPTOR
CITY OF WICHITA, KANSAS
R. W. LINN — CITY ENGINEER
March, 1973 PROJECT NO. DBKL577049

NOTE: CONTRACTOR WILL BE REQUIRED TO OBTAIN NECESSARY PERMITS FROM THE CITY OF WICHITA, KANSAS, FOR THE CONSTRUCTION OF THIS SEWER A BRANCH OF THE CITY SEWER SYSTEM. THE CONTRACTOR SHALL BE RESPONSIBLE FOR OBTAINING ALL NECESSARY PERMITS AND FOR THE COST OF THE SAME. THE CONTRACTOR SHALL BE RESPONSIBLE FOR THE PROTECTION OF ALL UTILITIES AND FOR THE REPAIR OF ANY DAMAGE TO THE SAME. THE CONTRACTOR SHALL BE RESPONSIBLE FOR THE PROTECTION OF ALL ADJACENT PROPERTIES AND FOR THE REPAIR OF ANY DAMAGE TO THE SAME. THE CONTRACTOR SHALL BE RESPONSIBLE FOR THE PROTECTION OF ALL ADJACENT PROPERTIES AND FOR THE REPAIR OF ANY DAMAGE TO THE SAME.