




NOTE: TRAPS SHALL BE INSTALLED ON LINES FLOWING INTO MANHOLE AT STATION 2+56.5 IF INDIVIDUAL MOBILE HOME SERVICE LINES SERVED BY THESE LINES ARE NOT TRAPPED. TRAPS SHALL BE PAID FOR AT UNIT PRICE BID FOR THE VARIOUS PIPE SIZES INDICATED.

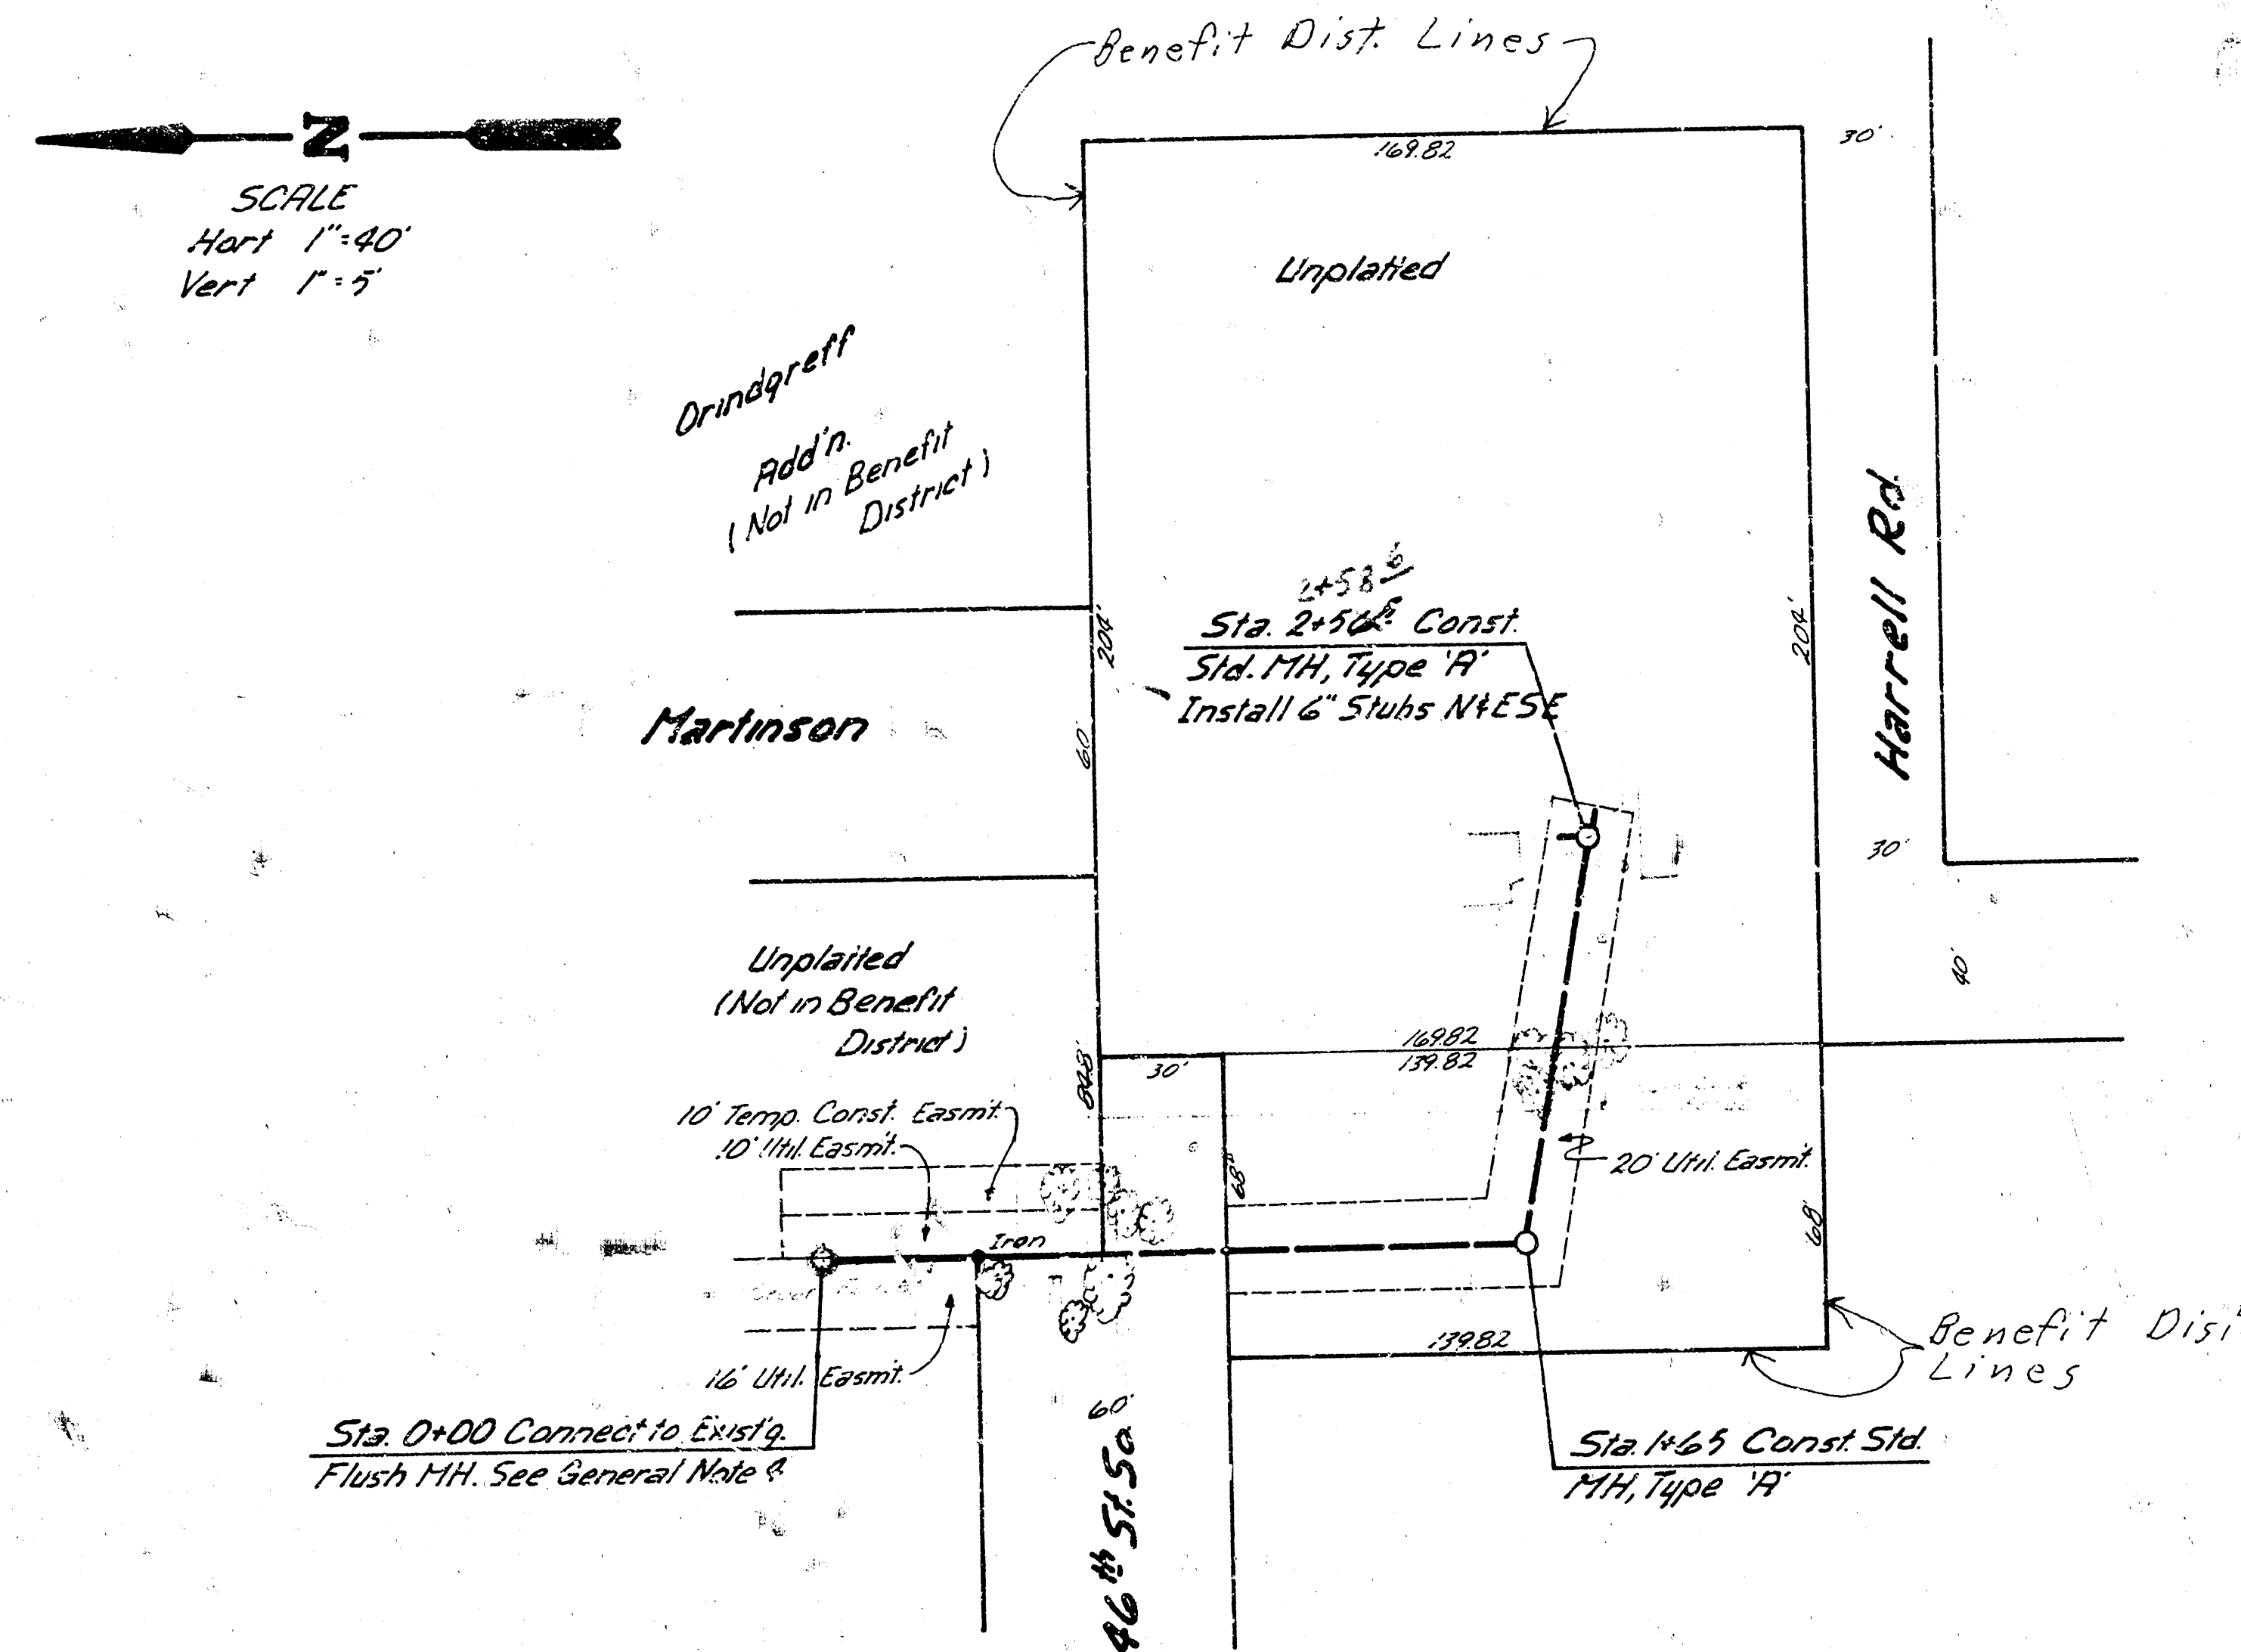

#### General Notes

1. Field Engineer to Take Ties to any Irons which May be Disturbed and Replace any that are Destroyed.
2. Contractor to Coordinate Construction of Manhole Sta 2+56.5 with Wayne Smith, 110 Heitler, Wichita, 522-5862.
3. Contractor to Uncover Service Lines Before Beginning Construction to Verify Flow Elevations.
4. Bid Price of Connection to MH to Include Rem. Flagpole & Chain, Steps & Rework Invert.
5. Contractor to Contact Owner of House West of Sta 0+00 before Removing Fence.

B.M. 87.34 City Std. 74' N & 44' E. of E's Seneca & 47th St. 50

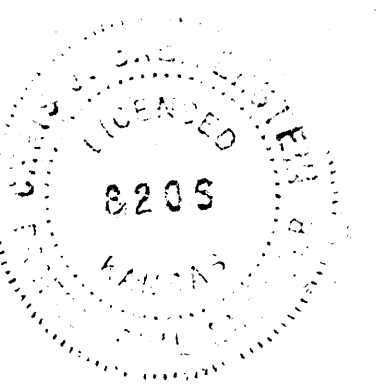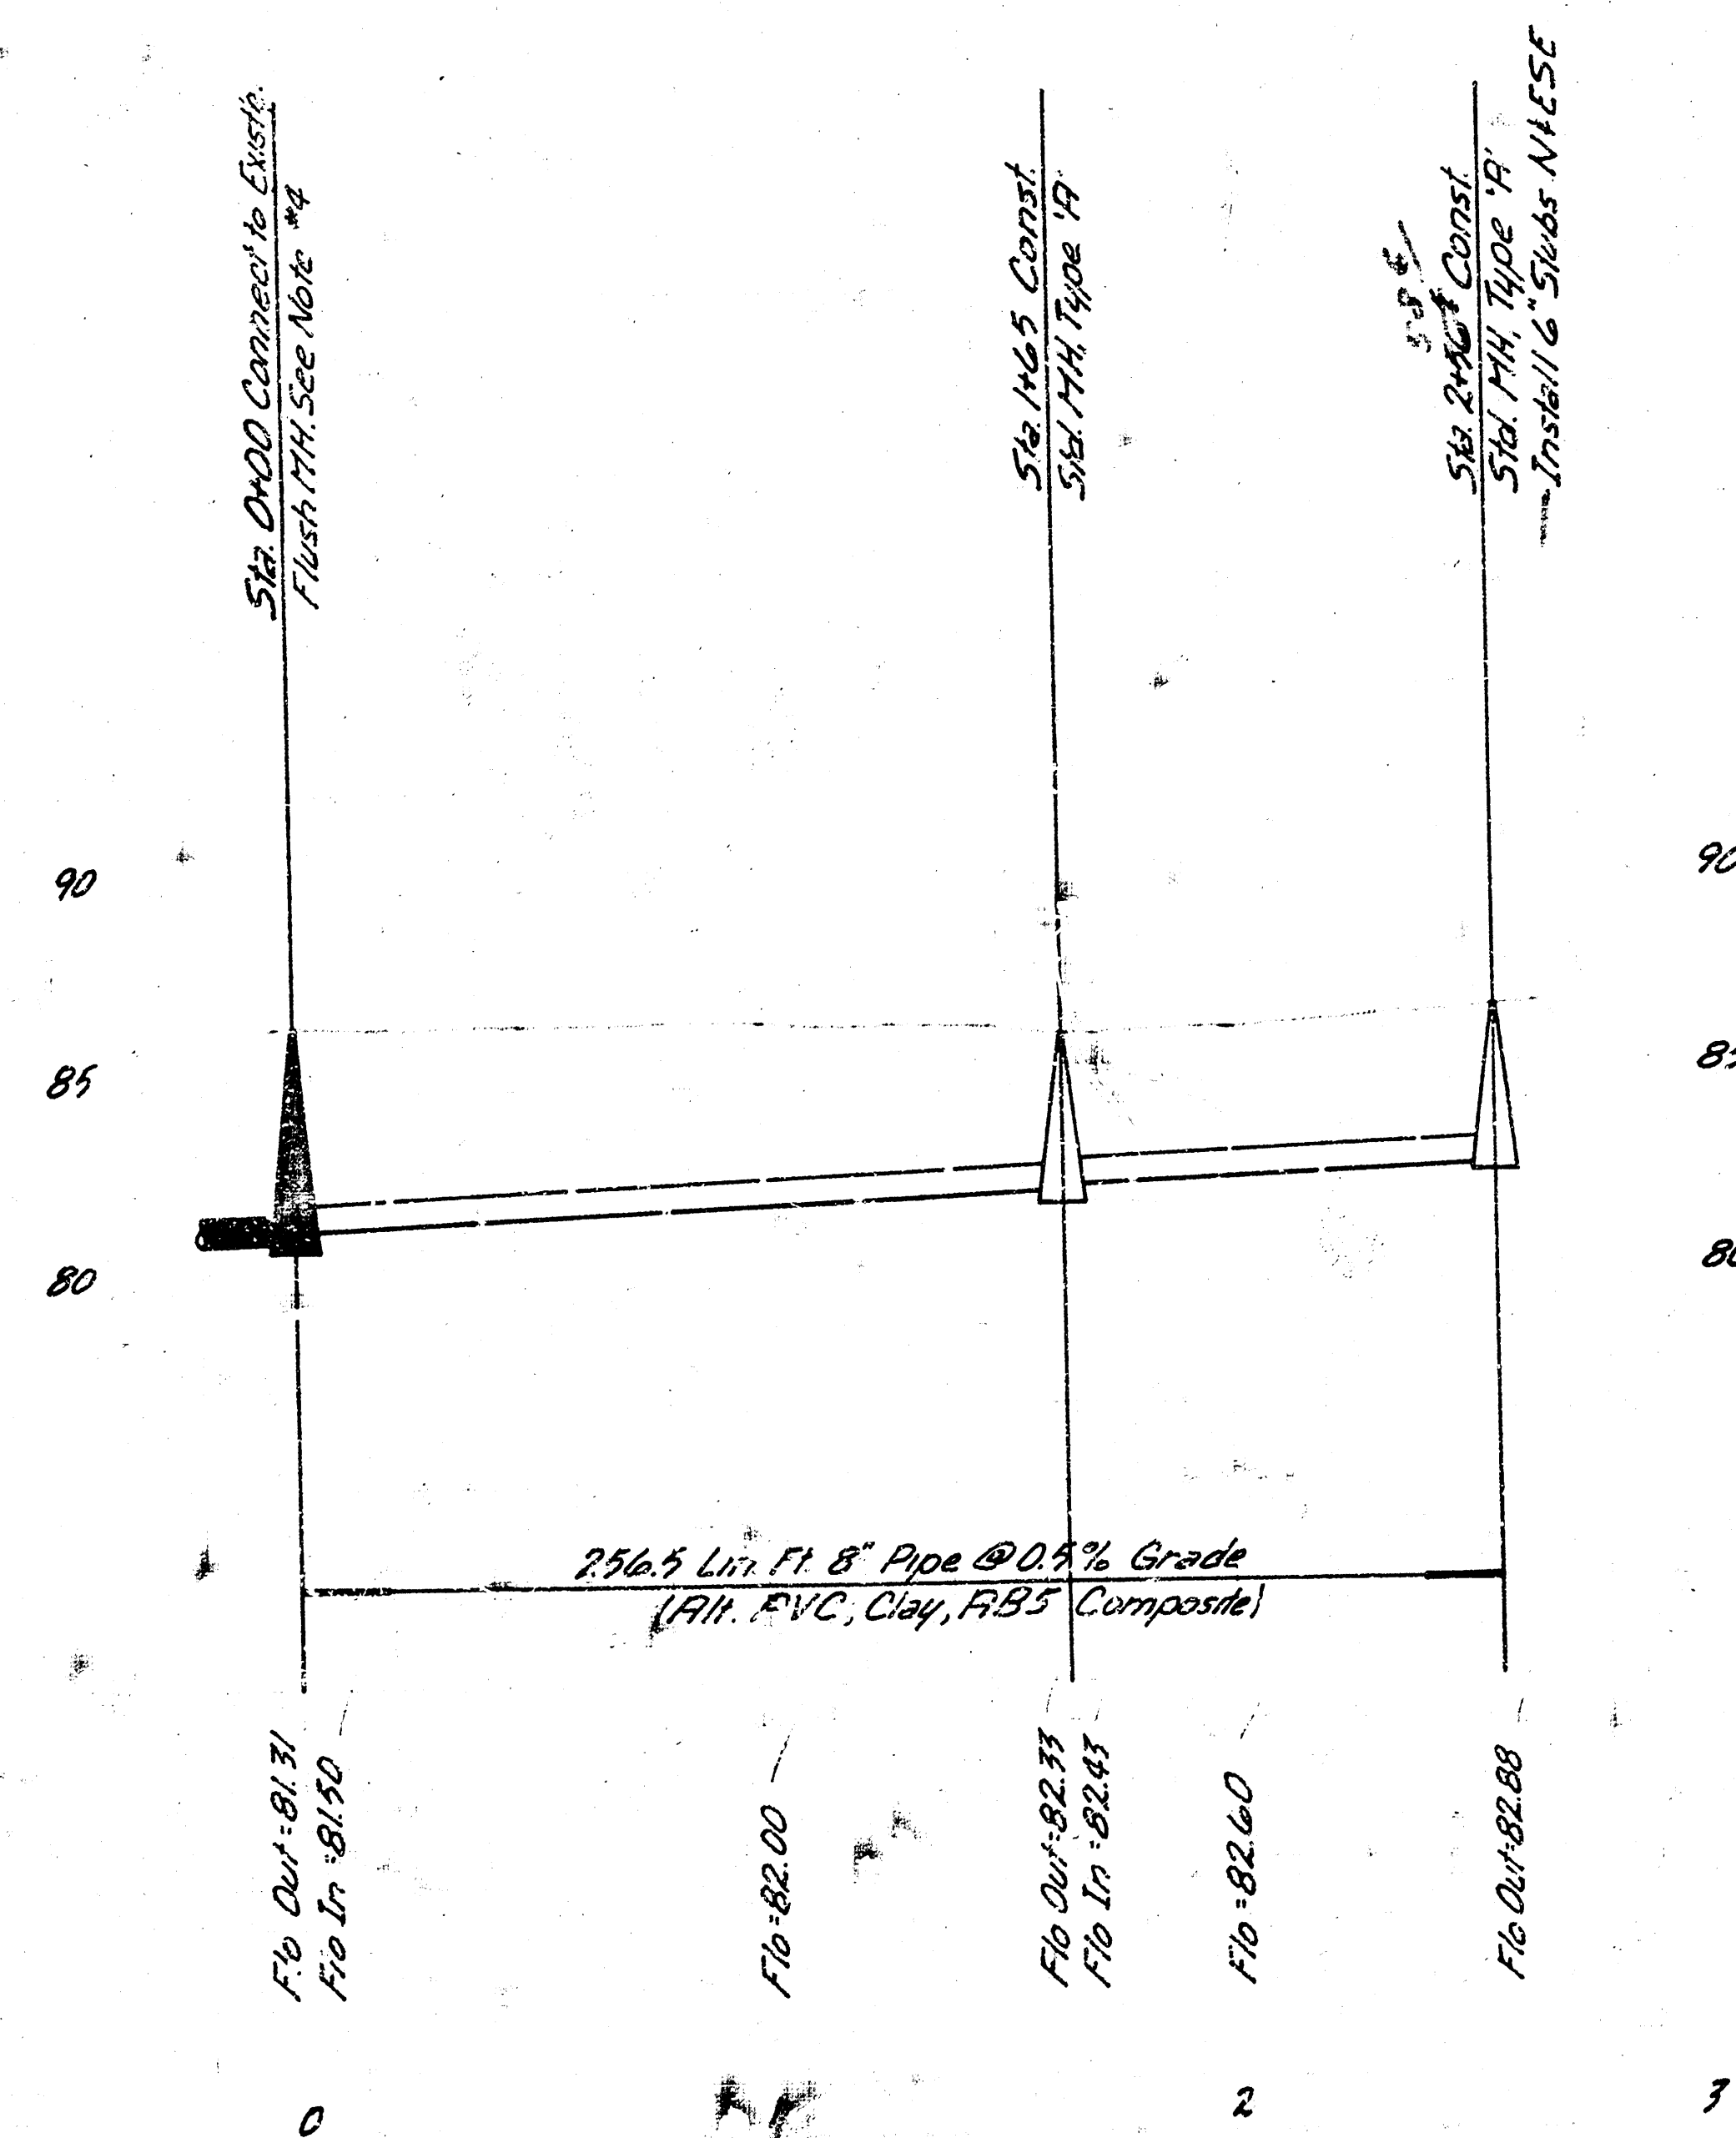

Lat 32, Main & SWI  
468-76-245-80708-000-000-001  
City of Wichita, Kansas  
Dept. of Public Works - Eng. Div.  
Dean S. Sellers - Acting City Engineer