



LATERAL 42, MAIN 3, SOUTHWEST INTERCEPTOR SEWER

PROJECT NO. 468-76-245-81620-000-000-001

CITY OF WICHITA, KANSAS


MICHAEL E. LINDEBAK, CITY ENGINEER

FEBRUARY, 1987

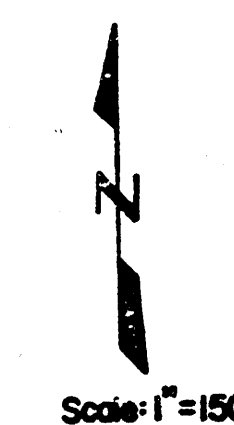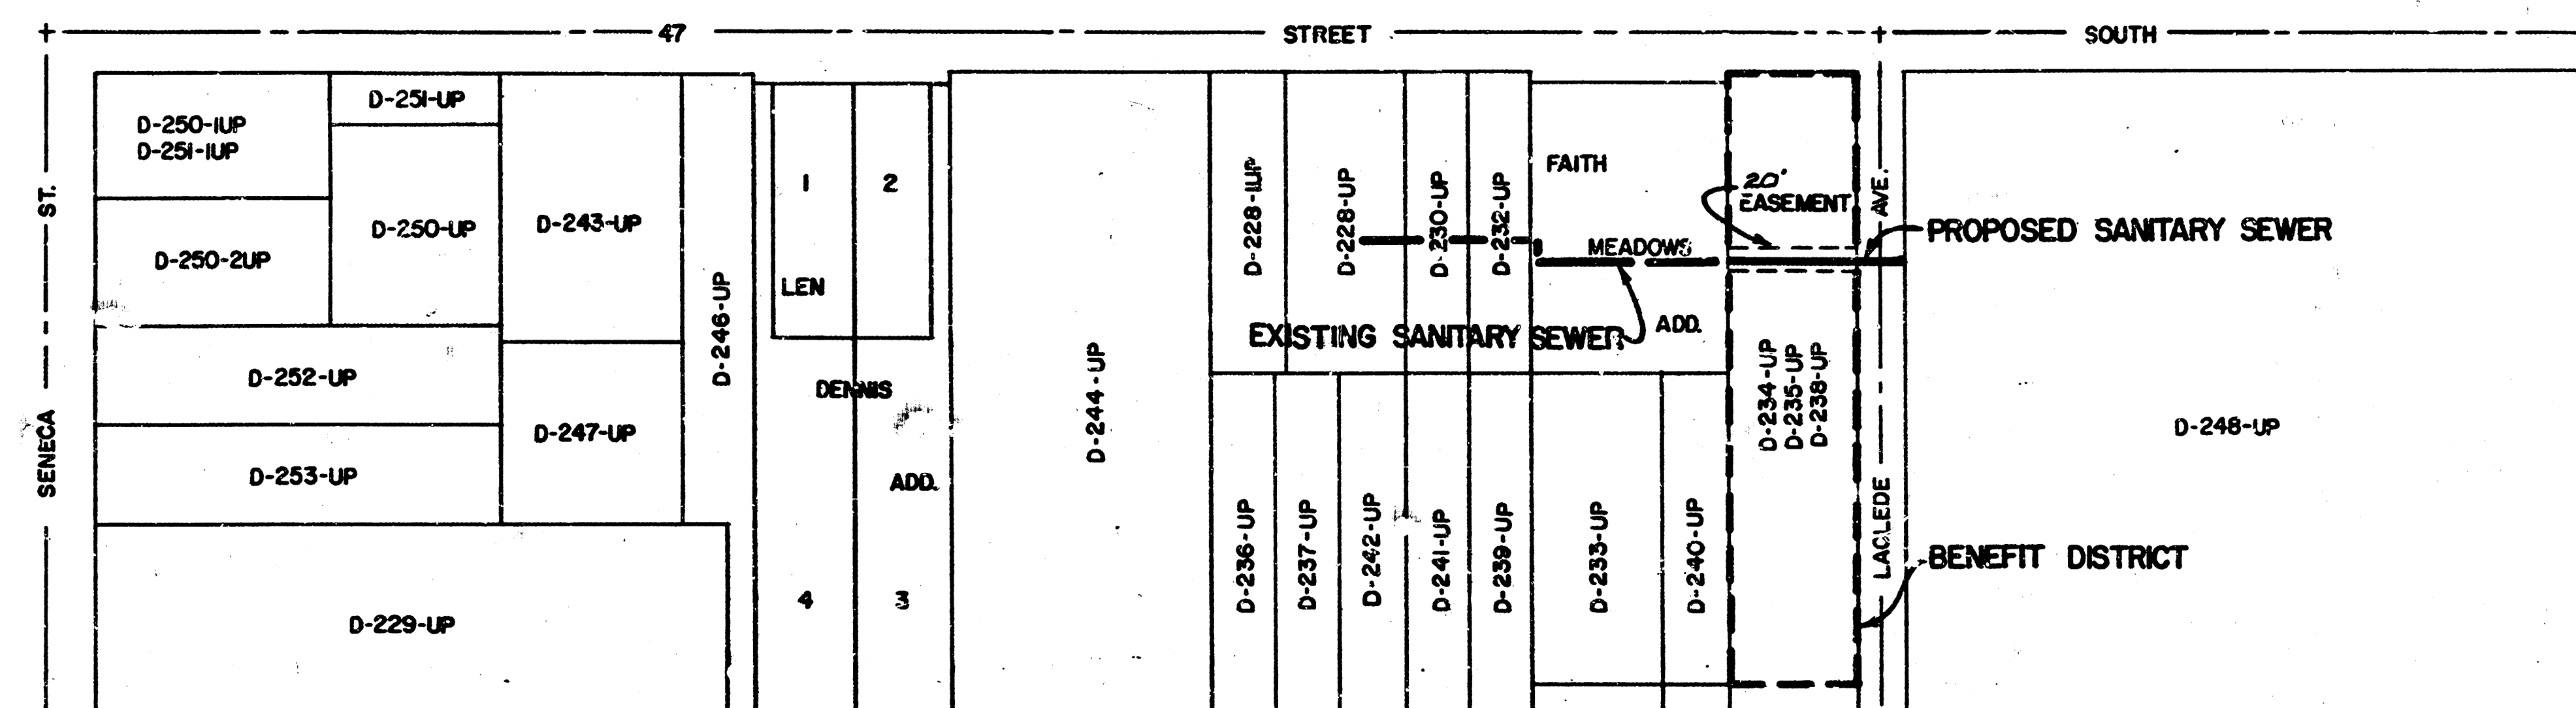

NOTE:
The City of Wichita will air test
and release the new line prior
to acceptance.


AS BUILT
RNL
5-26-87

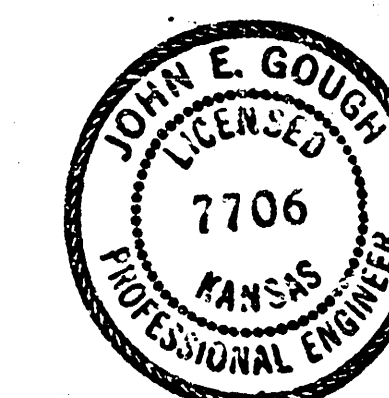

WICHITA, KANSAS SANITARY SEWER EXTENSIONS			
LAT. 42, MAIN 3, SOUTHWEST INTERCEPTOR SEWER MAP AND BENEFIT DISTRICT			
CASTLE & ASSOCIATES ENGINEERS WICHITA, KANSAS	DR. JMM CH	DWG FILE NO 8653-D-60,037	REV
DATE February 1987	APP	SHEET NO 1 OF 2	REV 1/2

FILMED FROM THE BEST
AVAILABLE COPY.....

PLAN	DATE	
	BY	
	REVIEWED	
	NOTED	

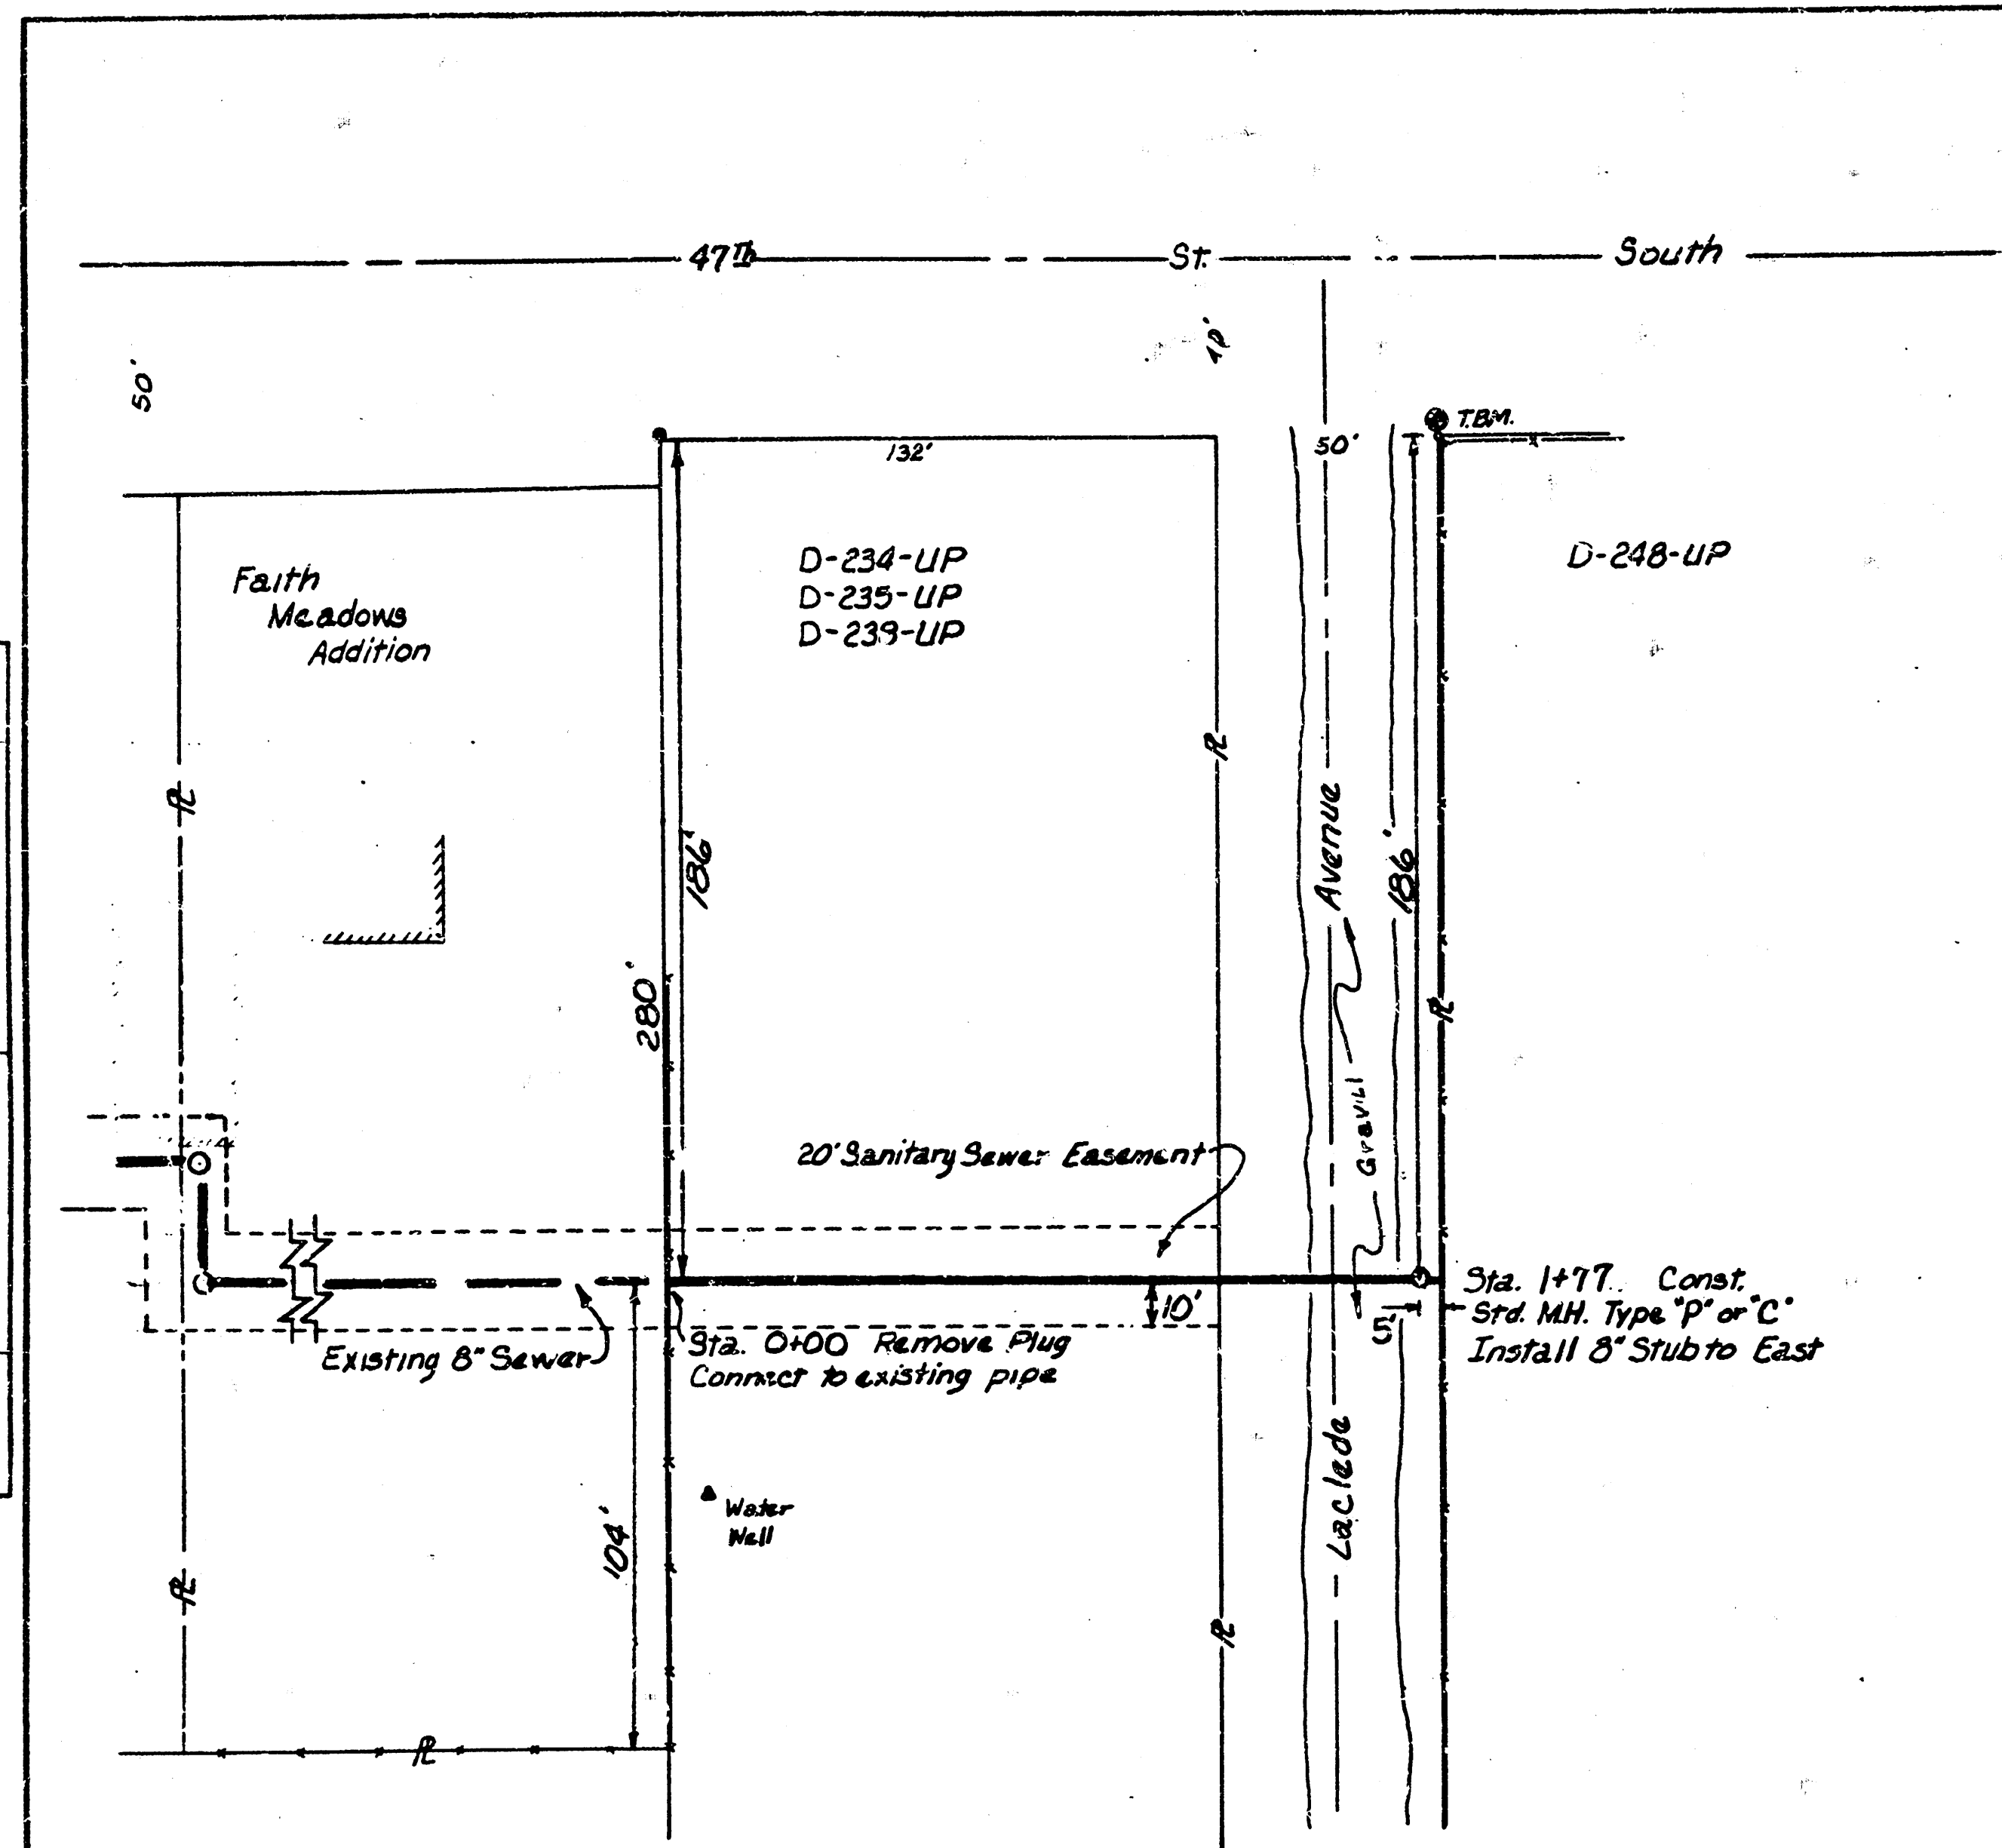

Scale: Plan 1" = 40'
Profile 1" = 40' Horiz.
1" = 5' Vert.

B.M. City of Wichita Bench Mark Disc,
48' east and 42.8' south of the
centerlines of both Seneca and
47th Street South. Elev. 87.34

TBM. R.R. spike in N.W. face power pole
@ S.E. corner 47th Street South
and Laclede Avenue. Elev. 88.51

PROFILE	DATE	
	BY	
	REVIEWED	
	NOTED	

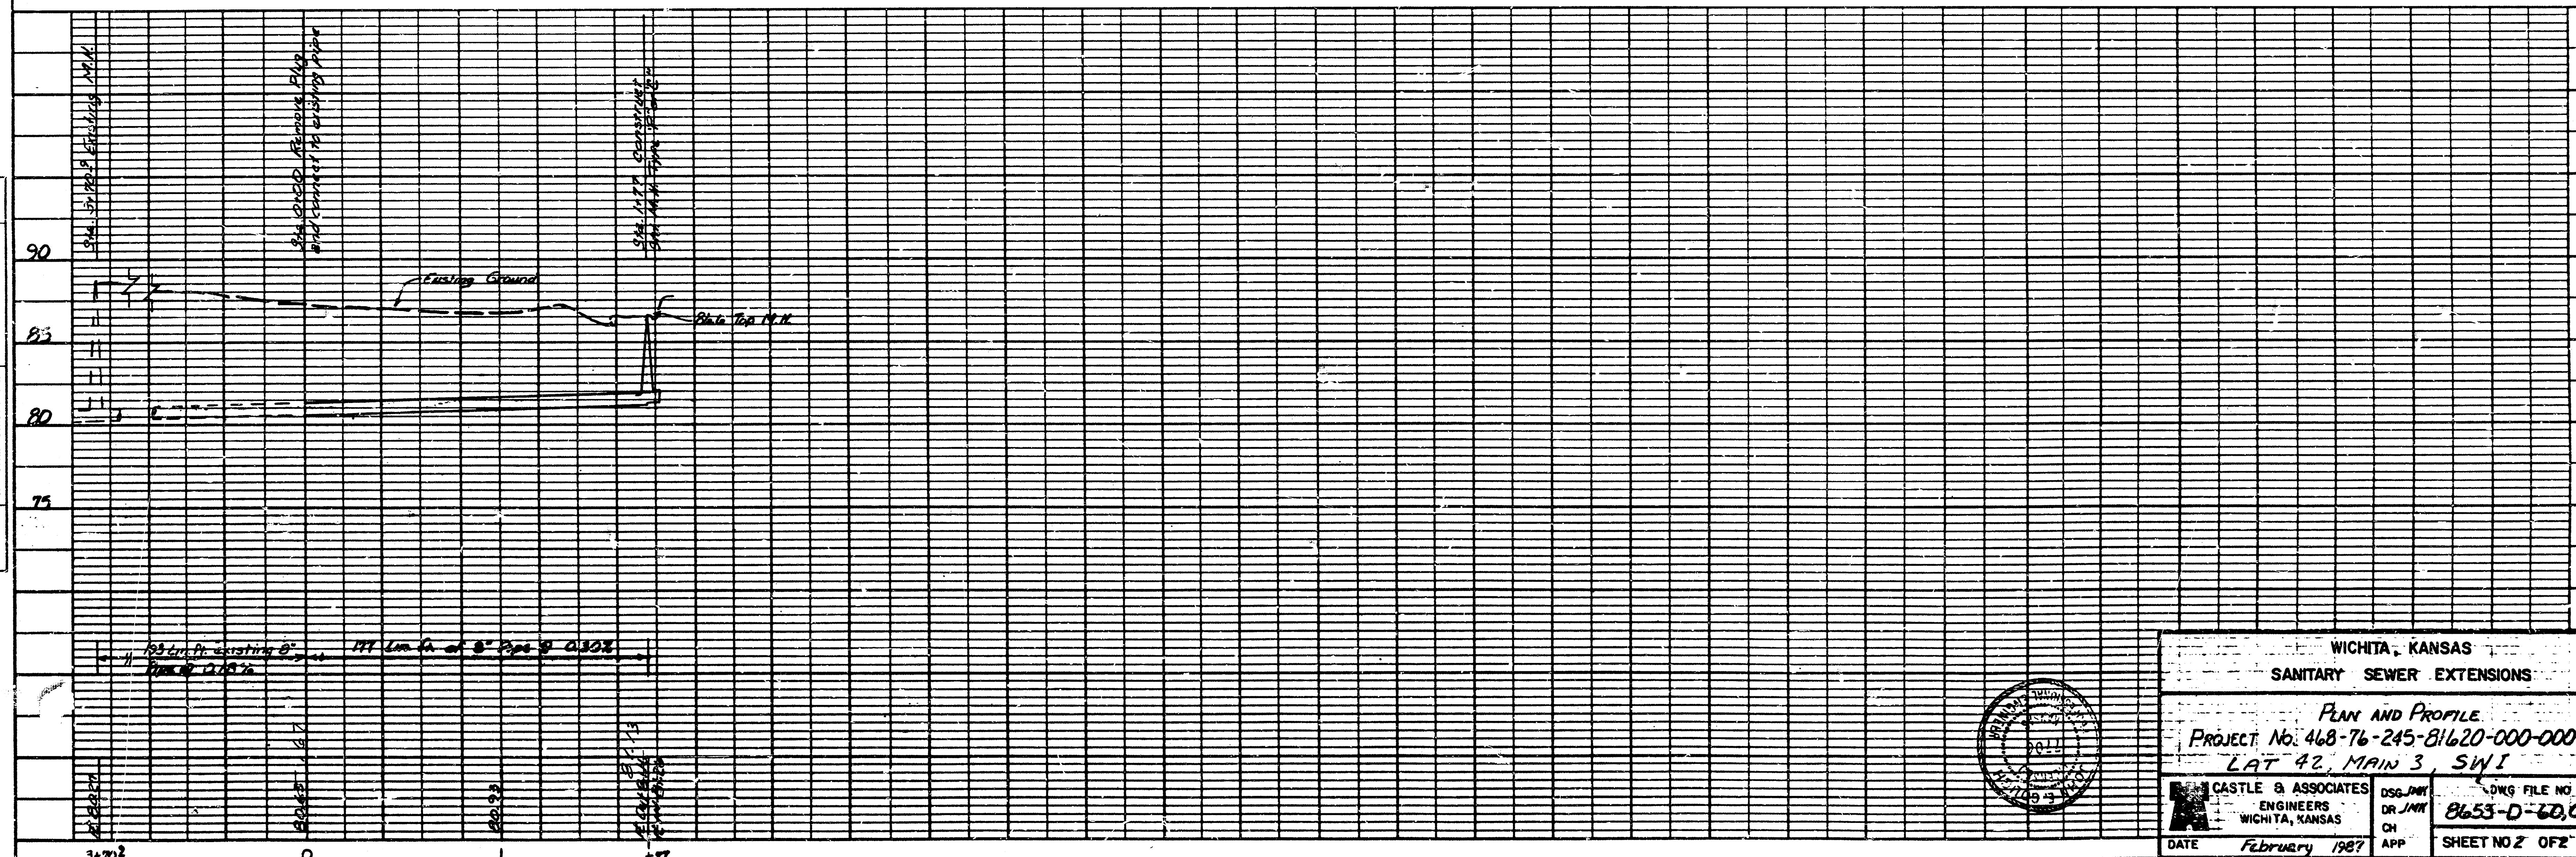


PLATE 1 - PLAN - PROFILE - P.A.S.
CLEARPRINT PAPER CO. & P. CO.
NO. 1000-1



WICHITA, KANSAS	
SANITARY SEWER EXTENSIONS	
PLAN AND PROFILE	
PROJECT NO. 468-76-245-81620-000-001	
LAT 42, MAIN 3, SW 1	
CASTLE & ASSOCIATES ENGINEERS WICHITA, KANSAS	DATE February 1987
DR. JAW CH APP	DWG FILE NO. 8653-D-60,036
SHEET NO 2 OF 2	REV

FILMED FROM THE BEST
AVAILABLE COPY