


B. M. 130.58 R. R. Spk. S.- Side P.P. on N. E. cor. Taft & Ralstin.


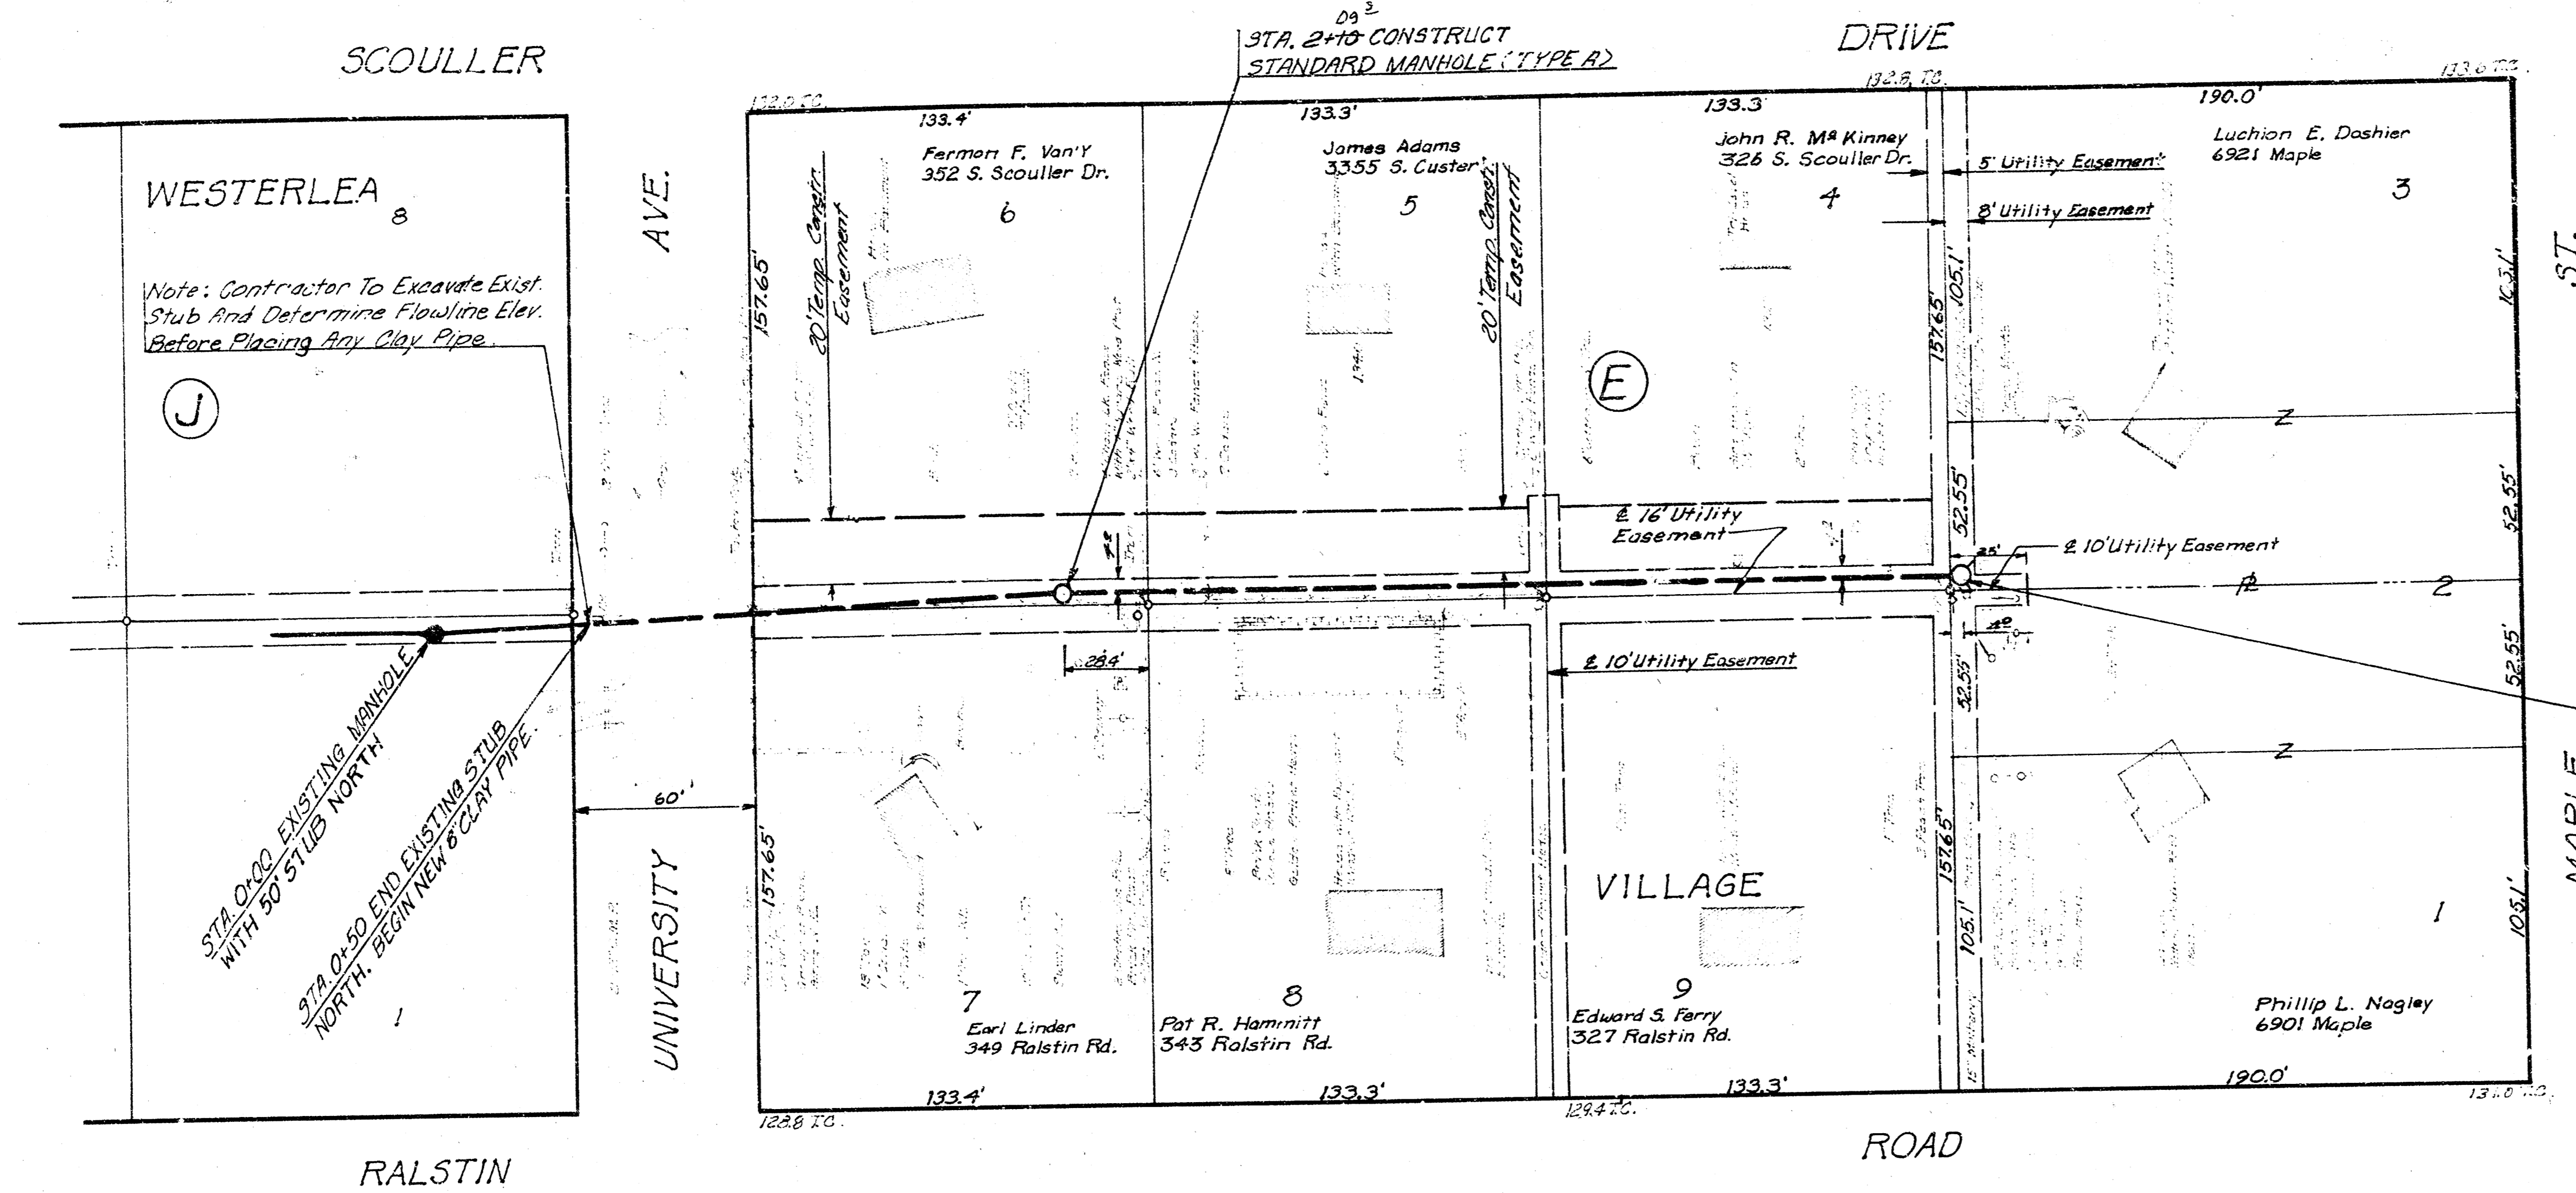


Note: Contractor To Excavate Exist. Stub And Determine Flowline Elev. Before Placing Any Clay Pipe.

Note: All Property Irons That May Be Disturbed Shall Have Tags Taken To Them Where They May Be Replaced If Disturbed.

STA 5+09 CONSTRUCT STANDARD MANHOLE (TYPE A). INSTALL STUBS N.E. & N.W.

PLAN SCALE : 1"=40'  
PROFILE SCALE : 1"=40' HORIZ.  
1"=5' VERT.

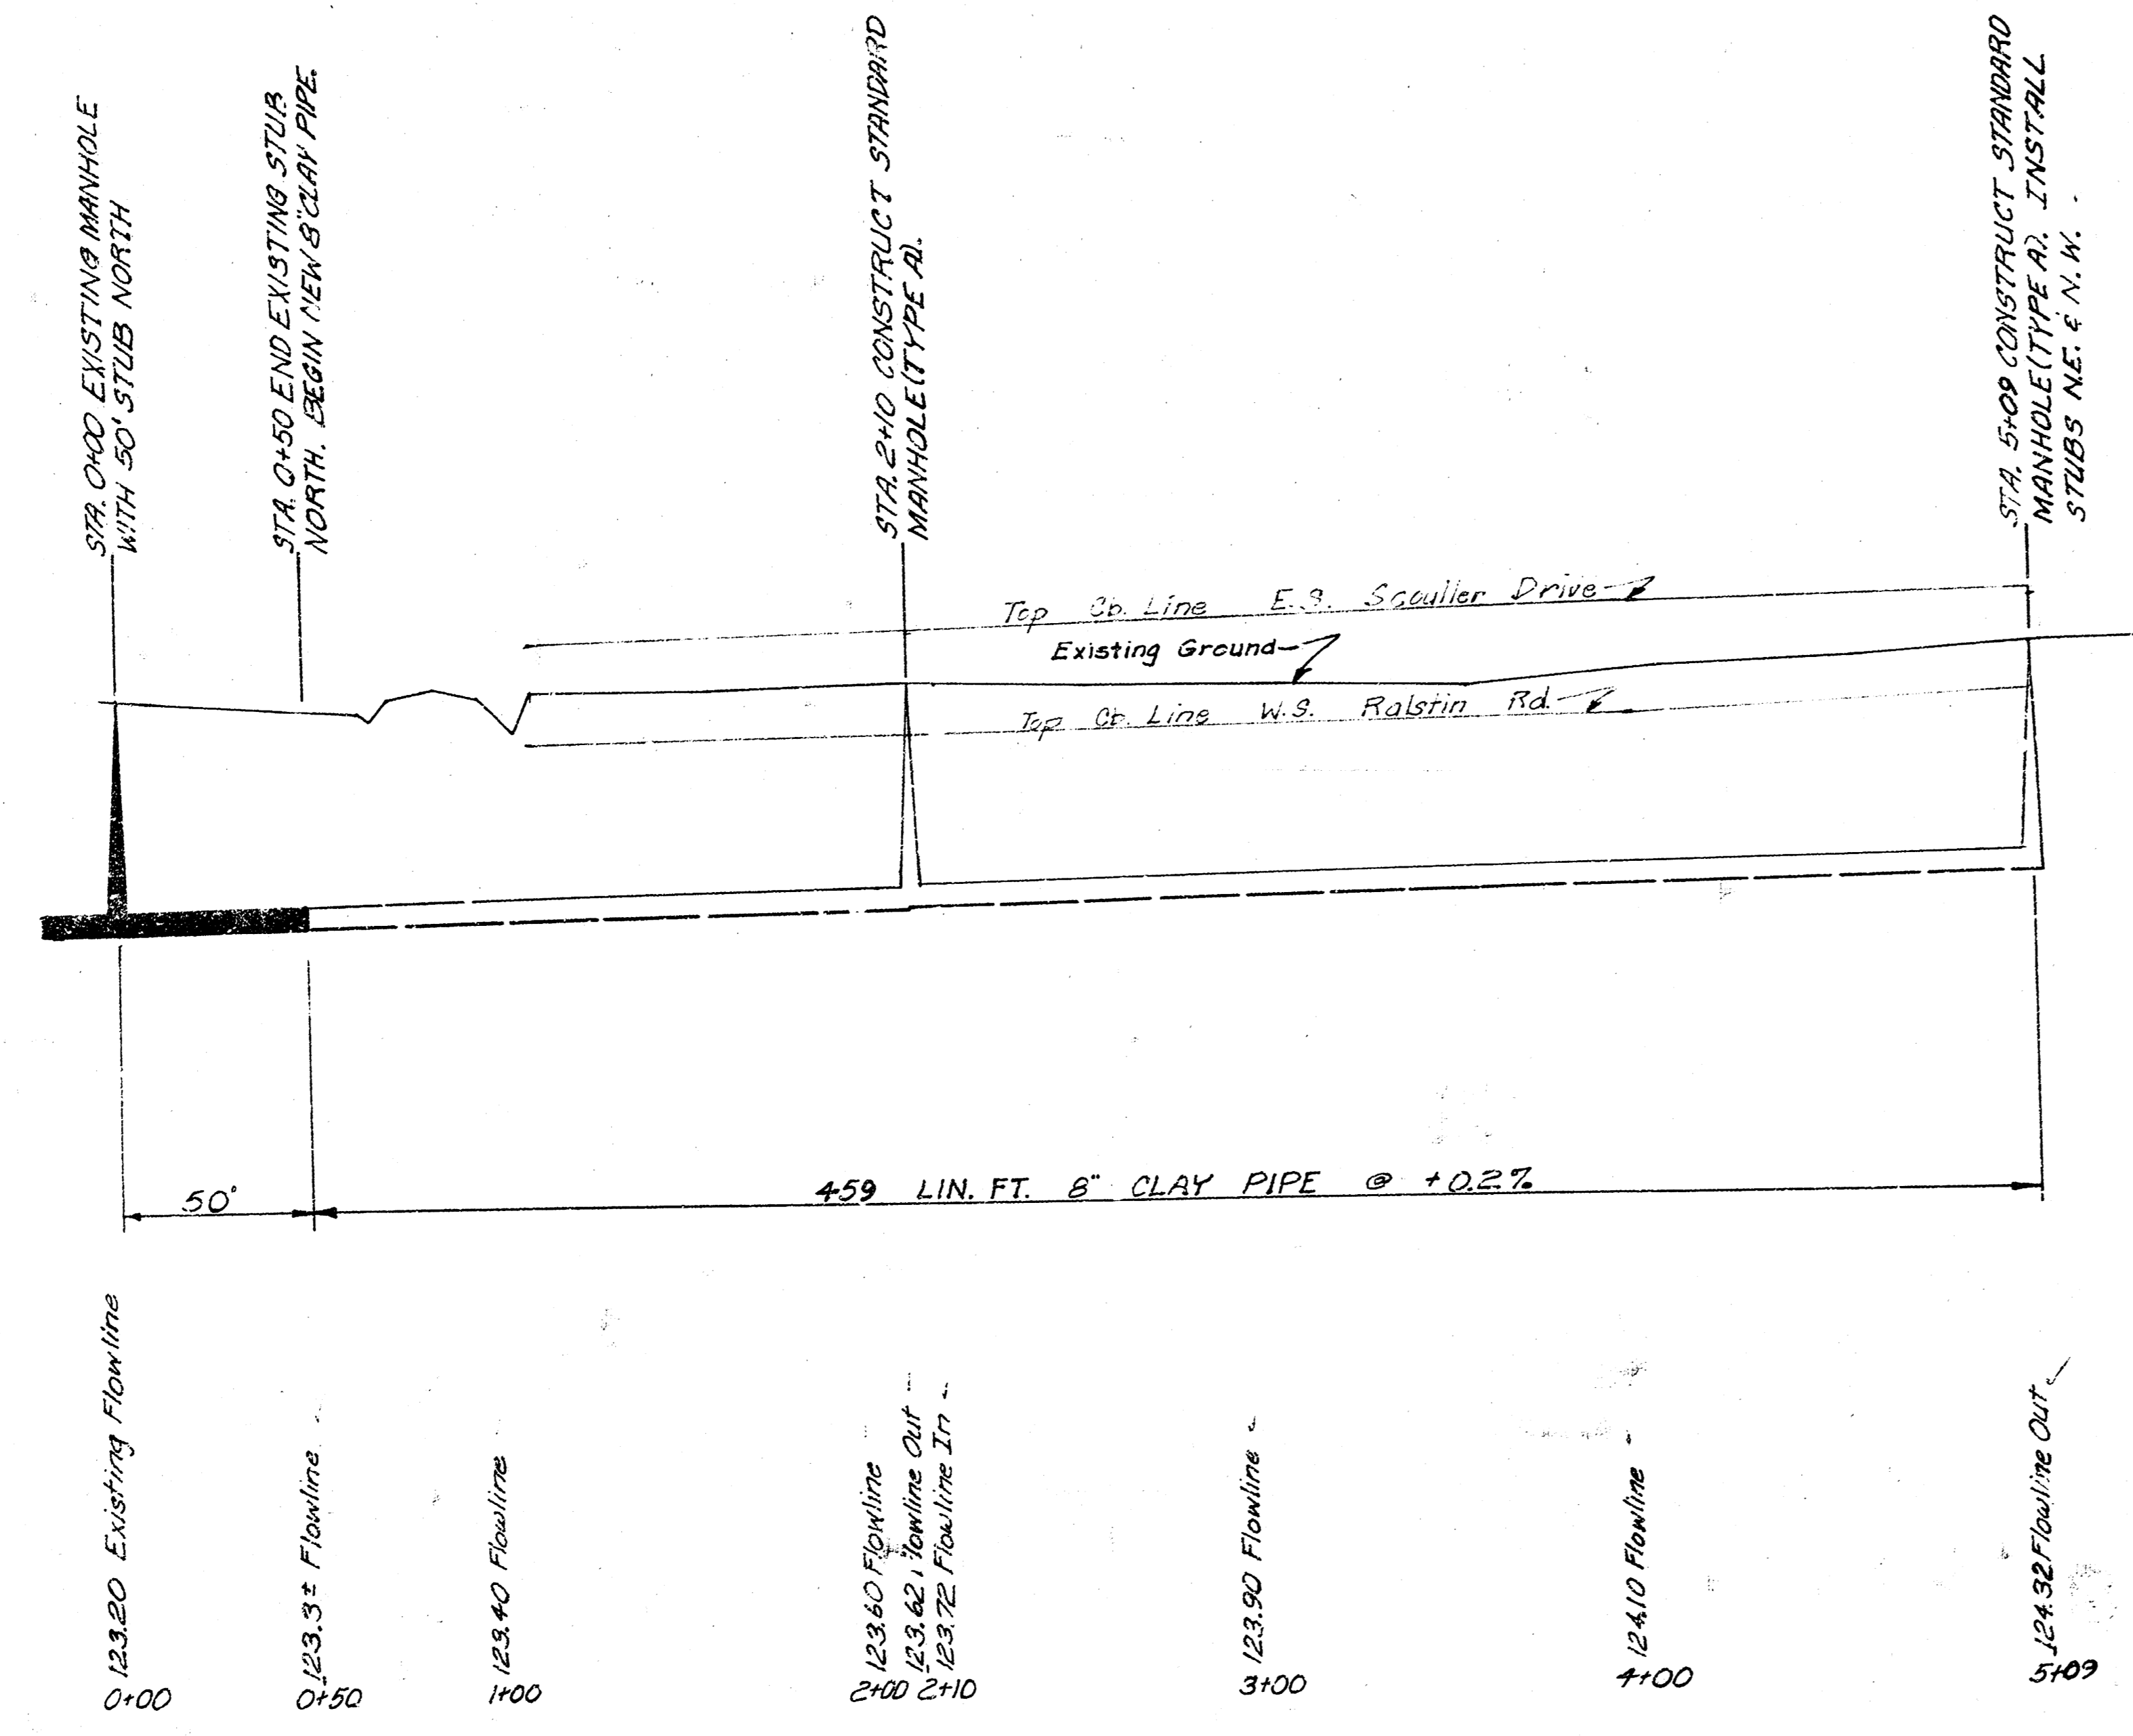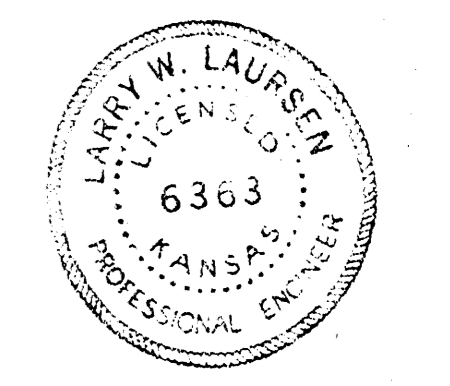

"As Built" Final Measurements M-103

LAT. 5, MAIN 4, S. W. INTERCEPT SEWER  
 CITY OF WICHITA, KANSAS  
 R. W. LINN — CITY ENGINEER  
 SEPT. 1972 PROJECT NO. DBKL 571028

42  
 116 CRES. 1/2" DIA. 10'  
 115 1/2" DIA. 10'  
 114 1/2" DIA. 10'  
 1/2" DIA. 10'